


4597-WW PLAN

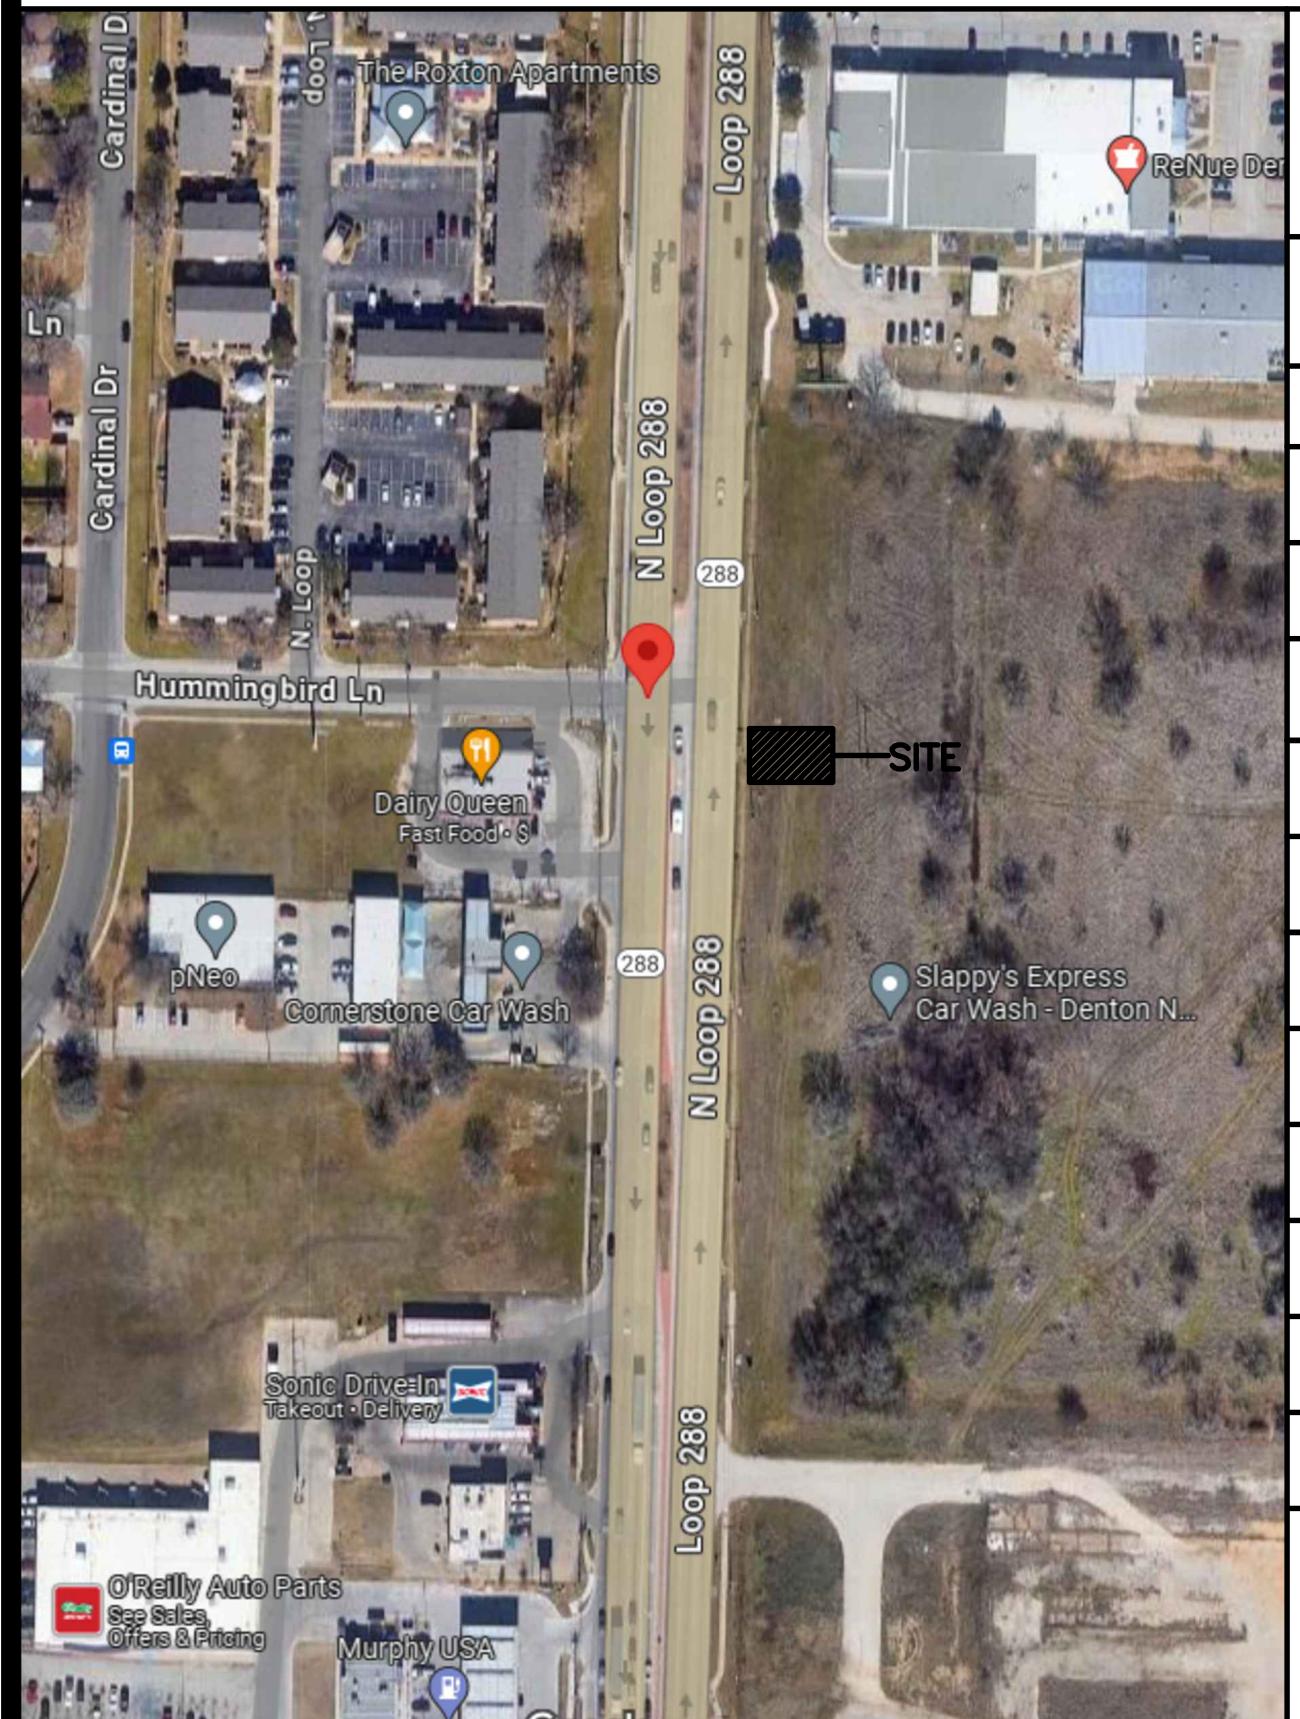

64 SEATS (4 ACCESSIBLE SEATS)



OCCUPANCY ALLOWANCE:

INTERNATIONAL BUILDING CODE 2021

TABLE 1004.5
MAXIMUM FLOOR AREA ALLOWANCES PER OCCUPANT

FUNCTION OF SPACE	ALLOWANCE	AREA	OCCUPANTS
ACCESSORY STORAGE AREAS, MECHANICAL EQUIPMENT ROOM	300 GROSS	600 SF	2
ASSEMBLY WITH FIXED SEATS	SEE PLAN	—	64
ASSEMBLY W/OUT FIXED SEATS STANDING SPACE	5 NET	125 SF	25
BUSINESS AREAS	150 GROSS	64 SF	1
KITCHEN, COMMERCIAL (OCCUPANT LOAD FOR FULL STAFF)	200 GROSS	1,400 SF	7
—	—	—	—
—	—	—	—
—	—	—	—
—	—	—	—
—	—	—	—
TOTAL OCCUPANCY ALLOWANCE	99		

2023 4597-WW BUILDING BB20

DALLAS FIELD OFFICE

BUILDING INFORMATION:

ADDRESS:

STATE SITE CODE: 042-3271
STREET ADDRESS: SEC OF S.H. LOOP 288 & HUMMINGBIRD LANE
CITY: DENTON
COUNTY: DENTON
STATE: TEXAS

STRUCTURE:

WOOD LOAD BEARING WALLS, WOOD ROOF FRAMING

UTILITIES:

ELECTRIC GRILLS & ELECTRIC FRYERS
GAS HVAC & GAS WATER HEATER

BUILDING CODE:

BUILDING CODE EDITION: 2021 INTERNATIONAL BUILDING CODE
MECHANICAL CODE EDITION: 2021 INTERNATIONAL MECHANICAL CODE
ELECTRICAL CODE EDITION: 2020 NFPA 70 NATIONAL ELECTRICAL CODE
PLUMBING CODE EDITION: 2021 INTERNATIONAL PLUMBING CODE
ENERGY CODE EDITION: 2021 INTERNATIONAL ENERGY CONSERVATION CODE
FIRE/LIFE SAFETY CODE EDITION: 2021 NFPA 101 LIFE SAFETY CODE
FUEL/GAS CODE EDITION: 2021 INTERNATIONAL FUEL GAS CODE
HEALTH CODE EDITION: DENTON COUNTY HEALTH CODE
ACCESSIBILITY CODE EDITION: 2012 TEXAS ACCESSIBILITY STANDARDS

BUILDING DATA:

OCCUPANCY: USE GROUP A2
CONSTRUCTION TYPE: VB
NUMBER OF STORIES: 1
BUILDING HEIGHT: 18'-9 1/2" (MAIN BLDG. PARAPET)

GROSS BUILDING AREA: 4,421 GROSS S.F.
BUILDING AREA: 4,117 NET S.F.

DESIGN LOADS:

GROUND SNOW LOAD: REFERENCE SHEET S4.0
WIND SPEED: REFERENCE SHEET S4.0
SEISMIC DESIGN CATEGORY: REFERENCE SHEET S4.0
SOIL BEARING CAPACITIES: REFERENCE SHEET S4.0

LIFE SAFETY SYSTEM:

EMERGENCY LIGHTING:	X	YES	NO
EXIT SIGNS:	X	YES	NO
FIRE ALARM:	X	YES	NO
DUCT SMOKE DETECTORS W/ AUDIBLE/VISIBLE DEVICE:	X	YES	NO
FIRE SPRINKLERS:	X	YES	NO
SPRINKLER FLOW/TAMPER SWITCH W/ AUDIBLE/VISIBLE DEVICE:	X	YES	NO
CO2 DETECTION SYSTEM W/ AUDIBLE/VISIBLE DEVICE:	X	YES	NO
PANIC HARDWARE:	X	YES	NO

DESIGNER OF RECORD:

DISCIPLINE:	NAME:	ADDRESS:	LICENSE #:
ARCHITECT:	JAW Architects Inc	jeramy@jaw-arch.com	21926
STRUCTURAL:	Rubix Consultants	Contact Architect	101398
MECHANICAL:	Robert D Anderson Inc.	Contact Architect	44987
PLUMBING:	Robert D Anderson Inc.	Contact Architect	44987
ELECTRICAL:	Robert D Anderson Inc.	Contact Architect	44987

CONSTRUCTION PROJECT MANAGER:

NAME: EMAIL:
MANAGER: Lee Morris lee.morris@us.mcd.com

DRAWING INDEX

REVISIONS
1 2 3 4 5 6

GN1.0 Cover Sheet
GN1.1 General Notes

REFERENCE DRAWINGS

D1.0 Drive-Thru Plan & Details
R1.0 Square Footage Calculations
R1.1 Occupancy Count Plan
R1.2 Exiting/Egress Plan
R1.3 Seating Plan

ARCHITECTURAL

A1.0 Floor Plan – Dimensioned
A1.1 Floor Plan – Noted
A1.2 Reflected Ceiling Plan
A1.3 Roof Plan
A2.0 Elevations
A2.1 Elevations
A3.1 Enlarged Front Counter Plan & Details
A4.0 Enlarged Restroom Plan & Details
A4.1 Enlarged Plan Details
A5.0 Wall Sections & Details
A5.1 Wall Sections & Details
A5.2 Wall Sections & Details
A5.3 Wall Sections & Details
A6.0 Door, Hardware Schedules & Details
A6.1 Finish Schedules & Details
A7.0 Dumpster Enclosure Plans
A7.1 Dumpster Enclosure Details

STRUCTURAL

S1.0 Foundation Plan
S1.2 Roof Framing Plan
S2.0 Foundation Sections
S2.1 Foundation Details
S3.0 Framing Sections
S3.1 Steel Details
S3.2 Framing Details
S3.3 Site Structural Details
S3.4 Site Structural Details
S3.5 Trash Enclosure Structural Details
S4.0 General Notes

MECHANICAL

M1.0 Mechanical Roof Plan
M1.2 Ductwork Plan
M1.4 Refrigerant & Gas Piping Plan
M2.0 Exhaust Hoods
M3.0 Mechanical Details
M4.0 General Mechanical Notes
M4.1 Mechanical Schedules

PLUMBING

P1.0 Domestic Water Piping
P1.2 Waste Vent & Storm Piping Plan
P1.3 Underground Plumbing
P1.4 Underground Rough-in
P1.6 Overhead Rough-in
P2.0 Domestic Water Isometric
P2.1 Waste & Vent Isometric
P2.2 Storm Isometric
P3.0 Details
P4.0 General Notes
P4.1 Schedules

ELECTRICAL

E1.0 POS Electrical Riser Diagram
E1.1 Rough In Floor Plan
E2.0 Lighting Plan & Schedule
E2.1 Electrical Roof Plan
E3.0 Electrical Schedule
E3.1 Electrical & Lighting Notes
E3.2 Interlock Diagrams
E4.0 Wiring Details
E4.1 Lighting Controls
E4.2 Utilities Distribution

KITCHEN EQUIPMENT

K1.0 Kitchen Cover Sheet
K2.0 Kitchen Equipment Plan
K2.1 Kitchen Equipment Schedule

PREPARED BY:		DRAWN BY:	
		JAW Architects, Inc.	
		PREPARED FOR:	
		McDonald's USA, LLC	
		These drawings and specifications are the confidential and proprietary property of McDonald's USA, LLC and shall not be copied or reproduced without the express written consent of McDonald's USA, LLC. These drawings and specifications are intended for use on the specific site in connection with the project for which they were issued. They are not suitable for use on a different site or at a later time. Use of these drawings for reference or example on another project requires the services of properly licensed architects and engineers. Reproduction of the content of these documents for other projects is not authorized.	
SHEET NO. 042-3271		TITLE 2023 STANDARD BUILDING - BB20	
DESCRIPTION 4597-WW/WOOD		STD ISSUE DATE 2023	
DESCRIPTION WOOD BEARING WALLS W/4" BRICK VENEER		REVIEWED BY JAW	
DESCRIPTION STUCCO/BATEN/BRICK/NETAL PANEL EXTERIOR FINISHES		DATE ISSUED 03/08/24	
SITE ADDRESS 24-0014		BY JAWA 24-0014	
COVER		GN1.0	

GENERAL NOTES

- ALL WORK SHALL BE IN COMPLIANCE WITH APPLICABLE FEDERAL, STATE AND LOCAL BUILDING CODES, REGULATIONS, ORDINANCES AND STANDARDS INCLUDING ADA AND OR OTHER HANDICAP ACCESSIBILITY CODES.
- GENERAL CONTRACTOR IS RESPONSIBLE FOR COORDINATING WITH THE OWNER'S VENDORS REGARDING SCHEDULING ON SITE DURING CONSTRUCTION AND SEQUENCING OF THE WORK.
- THE CONSTRUCTION NOTES AND DRAWINGS ARE SUPPLIED TO ILLUSTRATE THE DESIGN INTENT AND GENERAL TYPE OF CONSTRUCTION DESIRED AND ARE INTENDED TO IMPLY THE FINEST QUALITY OF CONSTRUCTION, MATERIAL AND WORKMANSHIP THROUGHOUT.
- THE DRAWINGS ARE NOT TO BE SCALED. FOR INFORMATION CONCERNING EXISTING CONDITIONS, ETC., VERIFICATION MUST BE DONE IN THE FIELD. LARGE SCALE DRAWINGS HAVE PRECEDENCE OVER SMALL SCALE DRAWINGS.
- PRIOR TO COMMENCEMENT OF ANY CONSTRUCTION, CONTRACTOR SHALL VERIFY EXISTENCE AND LOCATION OF ALL EXISTING ABOVE AND BELOW GRADE, UTILITIES, INCLUDING SANITARY SEWER, STORM SEWER, WATER, GAS, ELECTRICAL, TELEPHONE, ETC. ANY DISCREPANCIES IN UTILITY LOCATIONS SHALL BE BROUGHT TO THE IMMEDIATE ATTENTION OF THE ARCHITECT.
- GENERAL CONTRACTOR SHALL BE RESPONSIBLE FOR VERIFICATION OF ALL BUILDING DIMENSIONS PRIOR TO BEGINNING CONSTRUCTION AND SHALL IMMEDIATELY NOTIFY THE ARCHITECT OF ANY VARIANCE OR DISCREPANCY AFFECTING NEW CONSTRUCTION PRIOR TO PROCEEDING WITH WORK.
- CONTRACTOR SHALL PROVIDE ALL NECESSARY BLOCKING IN WALLS FOR SUPPORT OF ALL EQUIPMENT, SHELVING, ACCESSORIES, SIGNAGE, AND OTHER DEVICES REQUIRED.
- ALL PENETRATIONS SHALL RECEIVE CAULKING TO SEAL ANY TYPE OF ENERGY LOSS.
- THE CONTRACTOR SHALL VERIFY AND COORDINATE ALL APPLICABLE DIMENSIONS OF FIXTURES AND EQUIPMENT SUPPLIED AND/OR INSTALLED BY OTHERS.
- UPON COMPLETION OF PROJECT, G.C. TO OBTAIN ALL FINAL INSPECTIONS AS REQUIRED BY LOCAL JURISDICTIONS AND FURNISH OWNER WITH EVIDENCE OF ALL SUCH INSPECTIONS AND CERTIFICATES OF OCCUPANCY.
- SIGNS, UNLESS NOTED OTHERWISE, ARE PROVIDED BY OWNER'S SIGN CONTRACTOR. OWNER'S SIGN VENDOR WILL PROVIDE MONUMENT SIGN BASE (CONCRETE, STONE, BRICK, ETC.) IF PROJECT REQUIRES DECORATIVE BASE. SEE SHEET L-1 TO VERIFY IF REQUIRED. GENERAL CONTRACTOR TO PROVIDE ROUGH-IN & FINAL CONNECTION AND BRAILLE EXIT SIGN.
- GENERAL CONTRACTOR TO PROVIDE FOUR (4) 30 YARD DUMPSTERS DURING McDONALD RETAIL MOVE-IN.
- GENERAL CONTRACTOR SHALL PROVIDE ONE SKILLED LABORER FOR ONE WEEK DURING McDONALD RETAIL MOVE-IN. (40 HOURS)
- GENERAL CONTRACTOR SHALL BE RESPONSIBLE FOR SET-UP AND COORDINATION OF ALL THE UTILITY SERVICES FOR THE PROJECT.
- ALL EXTERIOR FLOOR PLAN DIMENSIONS ARE TO EXTERIOR FACE OF MASONRY UNLESS OTHERWISE NOTED. ALL INTERIOR FLOOR PLAN DIMENSIONS ARE TO FACE OF FINISH UNLESS OTHERWISE NOTED.
- FINAL KEYING TO BE COORDINATED WITH McDONALD FACILITY MANAGER AND PAID FOR BY McDONALD.
- REFER TO "PROJECT MANUAL" FOR ALL OTHER INSTRUCTIONS & DIRECTIVES NOT SHOWN IN DRAWINGS. IF THERE IS A CONFLICT BETWEEN THE DRAWINGS AND PROJECT MANUAL, NOTIFY THE AREA CONSTRUCTION MANAGER FOR RESOLUTION.

ABBREVIATIONS


GENERAL ABBREVIATIONS

A	ANNEALED	INSUL.	INSULATION
AC	AIR CONDITIONING	MAX	MAXIMUM
ACT	ACOUSTIC CEILING TILE	MECH	MECHANICAL
AFF	ABOVE FINISH FLOOR	MFR	MANUFACTURER
AHU	AIR HANDLING UNIT	MIN	MINIMUM
AL	ALUMINUM	MO	MASONRY OPENING
ASPH	ASPHALT	MR	MOISTURE RESISTANT
CJ	CONTROL JOINT	MTL	METAL
CLNG	CEILING	NA	NOT APPLICABLE
CMU	CONCRETE MASONRY UNIT	NIC	NOT IN CONTRACT
COL	COLUMN	NOM	NOMINAL
CONC	CONCRETE	NTS	NOT TO SCALE
CONT	CONTINUOUS	OC	ON CENTER
CP	CONCRETE PAD	OPP	OPPOSITE
CT	CERAMIC TILE	OPT	OPTIONAL
CL	CENTERLINE	PAR	PARTIAL
DBL	DOUBLE	PF	PRE-FABRICATED
DF	DRINKING FOUNTAIN	PSF	POUNDS PER SQUARE FOOT
DIA	DIAMETER	PT	PRESSURE TREATED
DIM	DIMENSION	PTD	PAINTED
DN	DOWN	QT	QUARRY TILE
DS	DOWNSPOUT	R	RADIUS
EA	EACH	REBAR	REINFORCING BAR
EJ	EXPANSION JOINT	REF	REFERENCE
ELEC	ELECTRICAL	REQD.	REQUIRED
ELEV	ELEVATION	RO	ROUGH OPENING
EQ	EQUAL	SB	SPLASHBLOCK
EXIST	EXISTING	SIM	SIMILAR
FD	FLOOR DRAIN	SPEC	SPECIFICATION
FE	FIRE EXTINGUISHER	SS	STAINLESS STEEL
FEC	FIRE EXTINGUISHER CABINET	STL	STEEL
FF	FINISH FLOOR	STOR	STORAGE
FR	FIRE RATED	SUSP	SUSPENDED
FRP	FIBERGLASS REINFORCED PLASTIC	TYP	TYPICAL
GALV	GALVANIZED	UNO	UNLESS NOTED OTHERWISE
GYP BD	GYPSUM BOARD	VCT	VINYL COMPOSITION TILE
HD	HANDICAP	VERT	VERTICAL
HDW	HARDWARE	WD	WOOD
HM	HOLLOW METAL	WP	WATERPROOF
HT	HEIGHT	WWF	WELDED WIRE FABRIC
HVAC	HEATING, VENTILATION, AIR CONDITIONING		

MCDONALD'S ABBREVIATIONS

AP	ALPOLIC METAL PANEL	L	LIGHT FIXTURE
BM	BRAKE METAL	LAM	LAMINATE
C	ALUMINUM CANOPY	LE	ACCENT LIGHTING
CG	CORNER GUARD	LP	LOW POINT
CT	WALL TILE	LL	LEVEL LANDING
DE	DECOR ELEMENT	MACHINE	MACHINE
DF	DECOR FINISH	MANAGER	MANAGER
DEVICE		MF	METAL FASCIA
DMB	DIGITAL MENU BOARD	MS	MOP SINK
DS	DROP SOFFIT	PB	PIPE BOLLARD
D/T	DRIVE-THRU	PT	RMHC COIN COLLECTOR
FB	FILL BOX	RL	ROOF LADDER
F/C	FREEZER/COOLER	ROOM	
GC	GENERAL CONTRACTOR	S	McDONALD'S SIGNAGE
HP	HIGH POINT	SCH	SCHLUTER
KIOSK		UN	ALUMINUM CANOPY underscore

SYMBOL LEGEND:

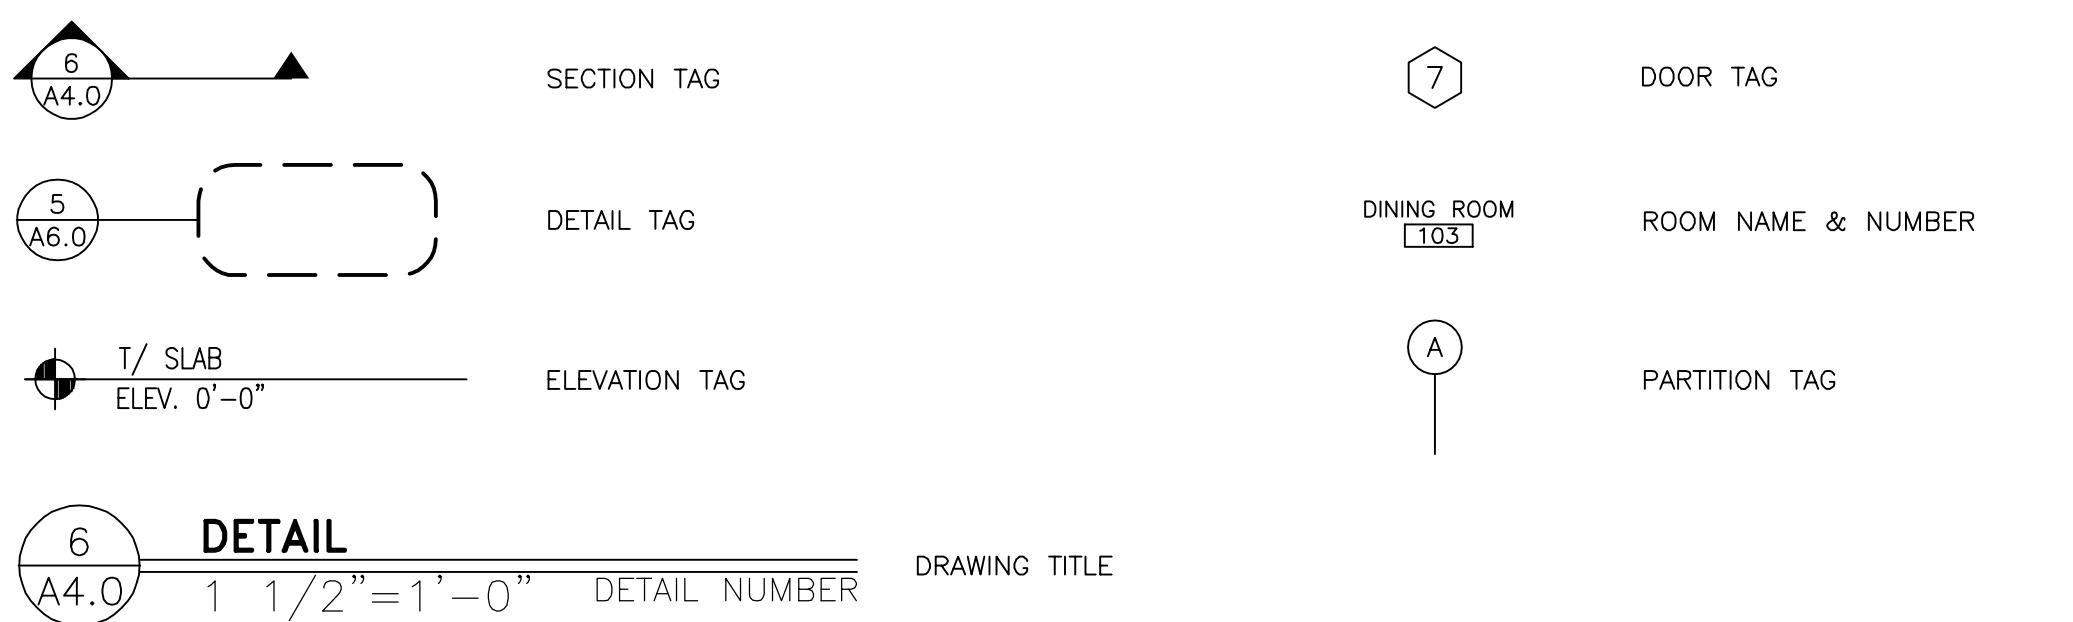


DRAWN BY:		PREPARED BY:	
McDonald's USA, LLC		@ 2023 McDonald's USA, LLC	
JAW		JAW	
STD ISSUE DATE 2023		STD ISSUE DATE 2023	
REVIEWED BY: JAW		REVIEWED BY: JAW	
DATE ISSUED 03/08/24		DATE ISSUED 03/08/24	
SHEET NO. 042-3271		SHEET NO. 042-3271	
TITLE 2023 STANDARD BUILDING - BB20 4597-WOOD/WOOD		TITLE 2023 STANDARD BUILDING - BB20 4597-WOOD/WOOD	
DESCRIPTION WOOD BEARING WALLS W/4" BRICK VENEER		DESCRIPTION WOOD BEARING WALLS W/4" BRICK VENEER	
STUCCO/BATEN/BRICK/METAL PANEL EXTERIOR FINISHES		STUCCO/BATEN/BRICK/METAL PANEL EXTERIOR FINISHES	
SITE ADDRESS S.H. LOOP 288 & HUMMINGBIRD LANE, DENTON, TEXAS		SITE ADDRESS S.H. LOOP 288 & HUMMINGBIRD LANE, DENTON, TEXAS	
REV. DATE		REV. DATE	
BY		BY	

JAW

REGISTERED ARCHITECT
JAMES WILLIAMSON, AIA, NCARB
STATE OF TEXAS
#1926
Phone: 817-705-3387
Email: jwilliamson@jaw.com

GENERAL NOTES

THE LAYOUT OF THE DRIVE-THRU LANES SHOWN IN THIS DETAIL ILLUSTRATES DRIVE-THRU DESIGN PRINCIPLES.

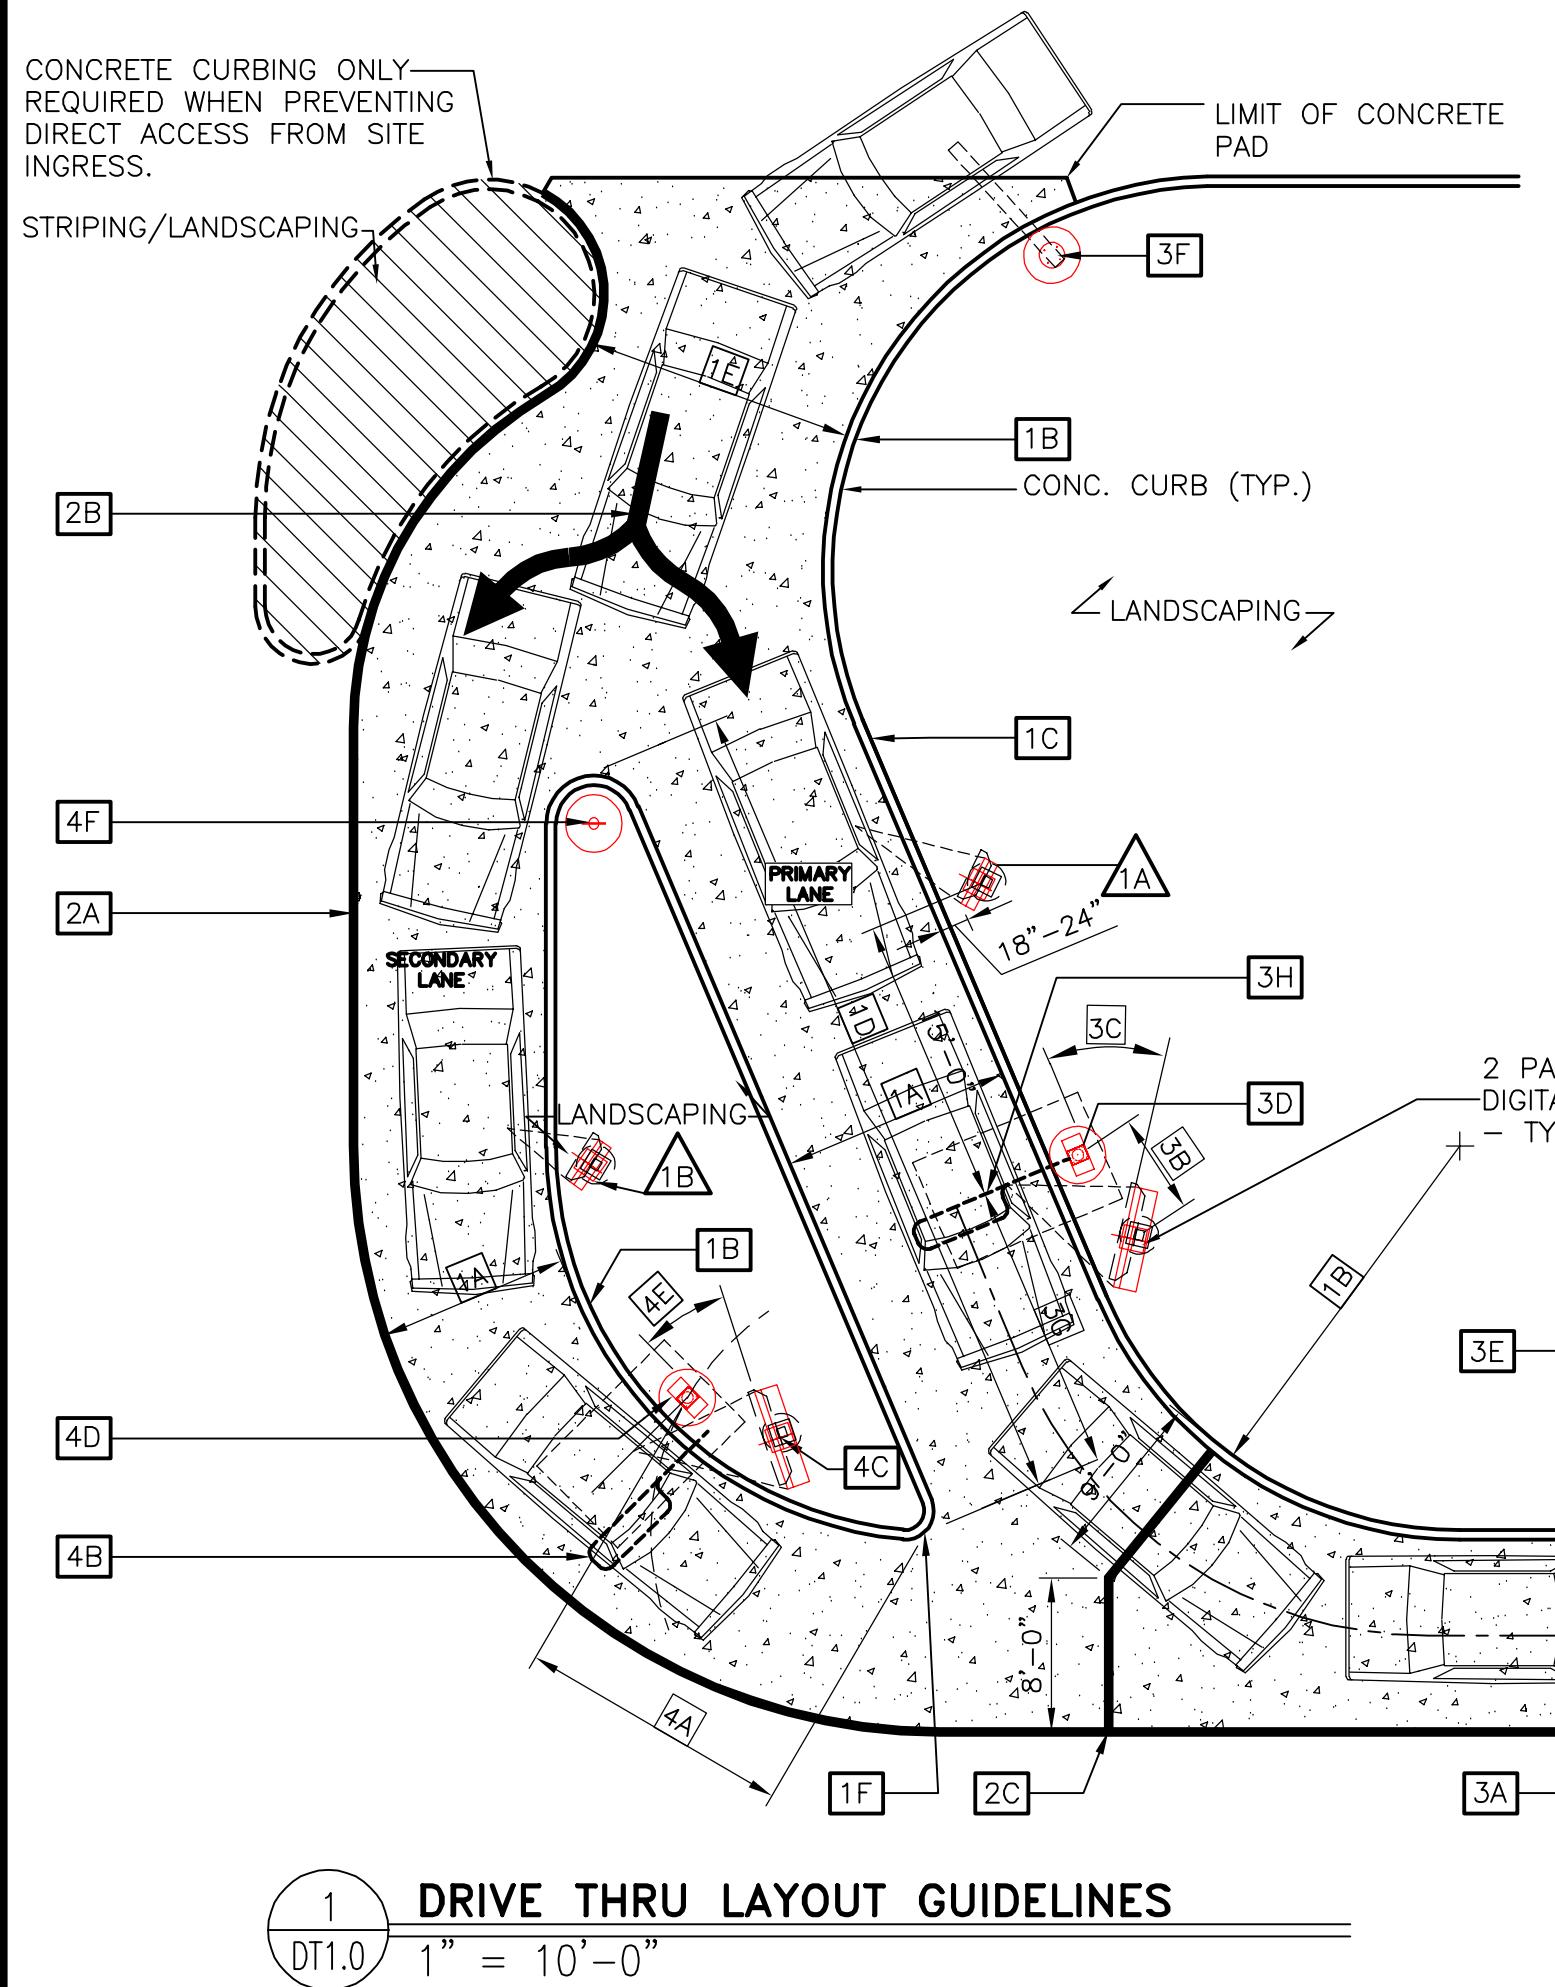


1 DRIVE THRU LAYOUT GUIDELINES
DT1.0 1" = 10'-0"

NOTES

- VERIFY CONDUIT SIZES AND LAYOUT WITH DETECTOR LOOP MANUFACTURER.
- CENTER VEHICLE DETECTOR LOOP IN DRIVE THRU LANE. INSTALL PER MFR. RECOMMENDATIONS.
- NO STEEL (REBAR OR ELECTRICAL WIRE) SHALL BE USED WITHIN 2' OF LOOP.
- DETECTOR LOOP MANUFACTURERS:
DETECTOR LOOPS MAY BE BY ONE OF THE FOLLOWING COMPANIES OR EQUAL.
3M: 1-800-328-0033
HME: 1-800-848-4468
- DETECTOR LOOP MATERIAL:
PVC TUBING 1/2" I.D. 100 PSI LOOP MADE FROM ONE LENGTH OF THIN FOURTEEN GAUGE STRANDED WIRE. LEAD-IN IS PRE-TWISTED AT FACTORY.
- DETECTOR LOOP CONSTRUCTION:
FORMED WITH ONE CONTINUOUS LENGTH OF PVC WITH NO SHARP CORNERS AS DETAILED. WIRE LOOPED, FORMED, & PIGTAILED AS DETAILED.

2 DETECTOR LOOP DETAILS
DT1.0 NOT TO SCALE

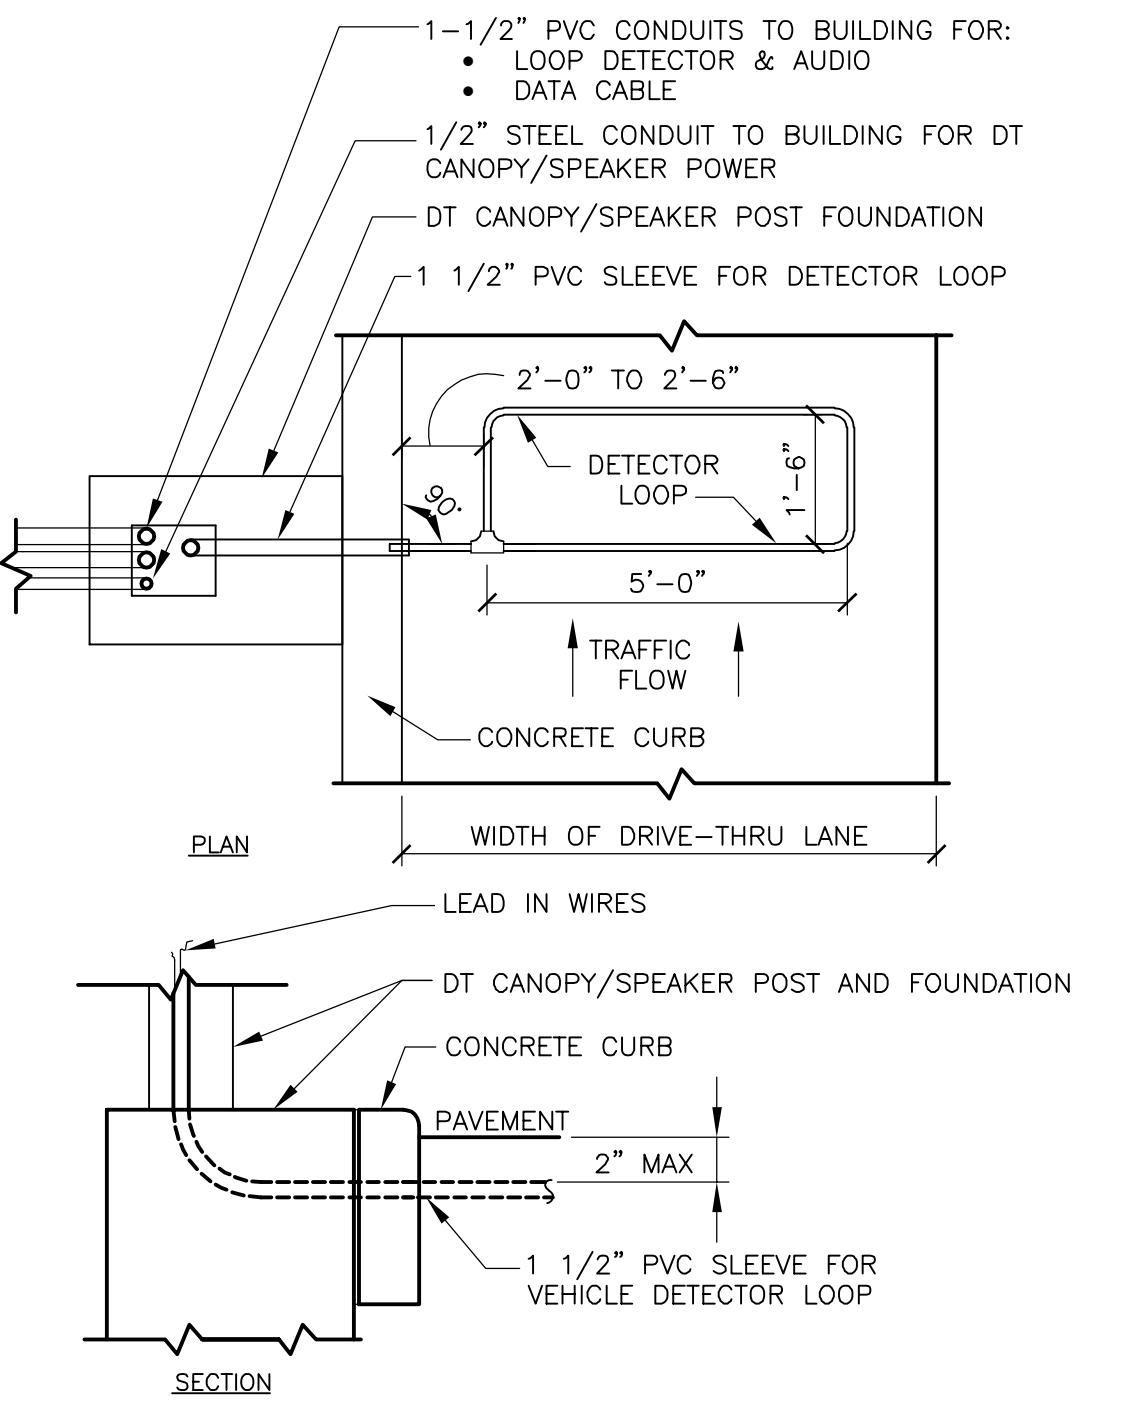

A - DT CANOPY/SPEAKER DETECTOR LOOP

B - DT WINDOW DETECTOR LOOP

SIDE BY SIDE DRIVE-THRU STANDARD 1.0

1. SIDE BY SIDE DRIVE-THRU STANDARD 1.0 CURBING DETAILS:

- [1A] DRIVE-THRU LANES BOUND BY CURB ON BOTH SIDES ARE TO BE 12'-0". LANES BOUND BY CURB ON ONE SIDE AND PAINTED STRIPING ON THE OTHER SIDE ARE TO BE A MIN. OF 10'-0".
- [1B] THE MIN. RADIUS FOR ALL INSIDE/DRIVER'S SIDE DRIVE-THRU CURBING IS 20'-0".
- [1C] PRIMARY LANE CURBING SHOULD BE AS STRAIGHT AS POSSIBLE. (LESS CURVING, THE BETTER).
- [1D] THE OVERALL LENGTH OF THE CURBED ISLAND SHOULD BE 35'-45'. THE LENGTH OF THE ISLAND FROM THE DT CANOPY/SPEAKER ALLOWS FOR THREE CARS IN THE SECONDARY LANE, TWO IN THE PRIMARY LANE AND ONE AT THE COMMITMENT POINT.
- [1E] ENTRANCE LANE ENTERING THE SIDE BY SIDE DRIVE-THRU IS TO BE 14'-0" MIN.
- [1F] THE RADIUS FOR THE ISLAND TIP SHALL BE 1'-6".

2. SIDE BY SIDE DRIVE-THRU STANDARD 1.0 PAVEMENT MARKINGS:

- [2A] 6" WIDE YELLOW PAINT STRIPE TO SPAN OUTER EDGE OF THE ENTIRE DRIVE-THRU LANE. LANE STARTS AT DRIVE-THRU ENTRANCE WHERE "McDONALD'S GATEWAY" SIGN IS LOCATED.
- [2B] DOUBLE-HEADED ARROW PAVEMENT MARKING. STANDARD STRIPING MARKINGS ARE 7"-0" SHAFT, 7'-0" ARROW STEM AND 3'-0" FOR THE ARROW HEAD. TIP OF ARROW HEAD TO BE LOCATED AT CENTER OF EACH LANE.
- [2C] MERGE POINT IS LOCATED WHERE TWO VEHICLES LEAVING EACH DT CANOPY/SPEAKER SIMULTANEOUSLY MEET. THE MERGE POINT STRIPE IS TO BE LOCATED BY OFFSETTING THE INNER PRIMARY LANE BACK OF CURB 9'-0" AND OFFSETTING THE OUTER LANE STRIPE 8'-0". AT THE INTERSECTION OF THESE OFFSETS, A 6" YELLOW STRIPE IS TO BE MARKED PERPENDICULAR TO THE OUTER LANE AS WELL AS THE INNER PRIMARY LANE.
- [2D] THE WORDS "THANK YOU" ARE TO BE PLACED 8" FROM THE EDGE OF THE YELLOW STRIPE TO THE BOTTOM OF THE WORD "YOU".
- [2E] THE 8" YELLOW STRIPE IS TO BE PLACED 40'-0" FROM THE CENTER LINE OF THE OPEN PRESENT WINDOW AND IS FOR PARKING CARS THAT ARE WAITING FOR ORDERS.
- [2F] A CIRCLE DIRECTIONAL ARROW CENTERED ABOVE THE WORD "DRIVE THRU" USED TO INDICATE THE DRIVE THRU ENTRY POINT.

3. SIDE BY SIDE DRIVE-THRU STANDARD 1.0 EQUIPMENT POSITIONING FOR PRIMARY LANE:

- [3A] MIN. 60'-0" (+5', 60'-65') LINEAR DISTANCE BETWEEN THE CENTER LINE OF THE DT CANOPY/SPEAKER FACE AND THE CENTER LINE OF THE OPEN ORDER BOOTH WINDOW AS MEASURED ALONG THE CENTER LINE OF THE LANE. THIS MAY ONLY BE INCREASED IN 20'-0" INCREMENTS (+5' FOR 80', 100', AND 120') TO A MAX OF 120'. 100'-0" IS OPTIMAL.
- [3B] THE CENTER OF THE PRIMARY MENU BOARD FOUNDATION IS TO BE 5'-9" (5'-6" MIN. AND 6'-0" MAX.) FROM THE CENTER OF THE DT CANOPY/SPEAKER FOUNDATION WITH THE END CAP OF THE PRIMARY MENU BOARD 15" PREFERRED BUT NOT LESS THAN 12" FROM THE FACE OF CURB.
- [3C] THE PRIMARY MENU BOARD SHOULD BE AT AN ANGLE OF APPROXIMATELY 25° TO 35° ANGLE (35° PREFERRED) FROM A CAR POSITIONED AT THE DT CANOPY/SPEAKER AND WITH 100% VISIBILITY.
- [3D] AUGER "McDONALD'S ORDER HERE CANOPY" CANOPY FOUNDATION TIGHT AGAINST BACK OF CURB. SEE MANUFACTURER/LOCAL SPECIFICATIONS FOR DETAILS.
- [3E] A SINGLE BOLLARD SHOULD BE POSITIONED AT THE CORNER OF THE BUILDING ON THE DRIVE-THRU SIDE. IT SHOULD BE FLUSH AGAINST THE BUILDING AND FACE OF THE BOLLARD SHOULD BE TIGHT AGAINST THE BACK OF THE CURB.
- [3F] AUGER "McDONALD'S GATEWAY" SIGN FOUNDATION TIGHT AGAINST BACK OF CURB. SEE MANUFACTURER/LOCAL SPECIFICATIONS FOR DETAILS.
- [3G] THE DISTANCE BETWEEN THE TIP OF THE CURBED ISLAND AND THE CENTER LINE OF THE PRIMARY DT CANOPY/SPEAKER MUST BE 15'-0". THIS MEASUREMENT IS TAKEN PARALLEL TO THE INSIDE CURB FACE OF THE PRIMARY LANE.
- [3H] THE PRIMARY LANE DETECTOR LOOP SHOULD BE PERPENDICULAR TO THE CENTER OF THE PRIMARY DT CANOPY/SPEAKER.

4. SIDE BY SIDE DRIVE-THRU STANDARD 1.0 EQUIPMENT POSITIONING FOR SECONDARY LANE:

- [4A] TO POSITION THE SECONDARY DT CANOPY/SPEAKER, DRAW AN ARC WITH A 14' RADIUS THAT IS CENTERED FROM THE MIDPOINT OF THE ISLAND TIP. THEN OFFSET THE FACE OF THE CURB BY 24" TO DETERMINE THE LOCATION OF CENTER OF FOUNDATION OF THE SECONDARY DT CANOPY/SPEAKER.
- [4B] WHEN THE SECONDARY DT CANOPY/SPEAKER IS LOCATED AT 14'-0" FROM THE TIP OF THE CURBED ISLAND, THE LOOP DETECTOR IS TO BE 2'-0" FORWARD OF THE DT CANOPY/SPEAKER CENTER LINE WITH THE LOOP FACING FORWARD AND THE DETECTOR LOOP PERPENDICULAR TO THE SECONDARY DT CANOPY/SPEAKER WHEN POSSIBLE.
- [4C] THE CENTER OF THE SECONDARY MENU BOARD FOUNDATION SHALL BE 5'-9" (5'-6" MIN. AND 6'-0" MAX.) FROM CENTER OF THE DT CANOPY/SPEAKER FOUNDATION WITH THE END CAP OF THE SECONDARY MENU BOARD 15" PREFERRED BUT NOT LESS THAN 12" FROM FACE OF CURB.
- [4D] AUGER "McDONALD'S ORDER HERE" DT CANOPY/SPEAKER FOUNDATION TIGHT AGAINST BACK OF CURB. SEE MANUFACTURER/LOCAL SPECIFICATIONS FOR DETAILS.
- [4E] THE SECONDARY MENU BOARD SHOULD BE AT AN ANGLE OF APPROXIMATELY 25° FROM A VEHICLE POSITIONED AT THE DT CANOPY/SPEAKER AND WITH 100% VISIBILITY.
- [4F] "ANY LANE, ANY TIME" BOLLARD SIGN MUST BE A MIN. OF 1'-6" FROM FACE OF CURB AT THE BEGINNING OF THE LANDSCAPE ISLAND. BOLLARD SIGN IS TO BE ORIENTED AT AN ANGLE OF 90° FROM THE CURB.

5. SIDE BY SIDE DRIVE-THRU STANDARD 1.0 DETECTOR LOOP:

- [5A] DETECTOR LOOPS SHALL BE LOCATED AT THE CENTER OF THE OPENING WINDOW AT THE CASH AND PRESENTER BOOTHS.

SIDE BY SIDE DRIVE-THRU STANDARD 1.0 FEATURES:

1. SIDE BY SIDE DRIVE-THRU STANDARD 1.0 EQUIPMENT:

- [1A] PRE-BROWSE BOARD MUST BE 18"-24" FROM FACE OF CURB. THE DISTANCE BETWEEN THE PRIMARY DT CANOPY/SPEAKER AND PRE-BROWSE BOARD IS TO BE 15' AS MEASURED ALONG THE FACE OF CURB. THIS IS MEASURED FROM THE CENTER OF THE PRE-BROWSE BOARD FOUNDATION TO THE CENTER OF THE DT CANOPY/SPEAKER FOUNDATION. THE ANGLE (APPROXIMATELY 50°) OF THE PRE-BROWSE BOARD SHOULD MAXIMIZE VISIBILITY TO THE SECOND CAR FROM DT CANOPY/SPEAKER.

- [1B] PRE-BROWSE BOARD MUST BE MIN. 12" FROM FACE OF CURB. THE DISTANCE BETWEEN THE SECONDARY DT CANOPY/SPEAKER AND PRE-BROWSE BOARD IS TO BE 15' AS MEASURED ALONG FACE OF CURB. THIS IS MEASURED FROM THE POINT PERPENDICULAR TO THE CENTER OF THE PRE-BROWSE BOARD FOUNDATION TO THE POINT PERPENDICULAR TO THE CENTER OF THE DT CANOPY/SPEAKER FOUNDATION. THE ANGLE OF THE PRE-BROWSE BOARD SHOULD MAXIMIZE VISIBILITY TO THE SECOND CAR FROM DT CANOPY/SPEAKER (PREFERRED 35°).

GENERAL NOTES

- 1. DRIVE-THRU ELEMENTS:**
DT CANOPY/SPEAKER DRIVE-THRU PYLON/CLEARANCE POLE AND BOLLARD SIGN SHALL BE CONSISTENT WITH THE STANDARD BUILDING DESIGN DRIVE-THRU ELEMENTS.
OTHER DESIGNS MAY NOT BE USED.
- CONTRACTOR SHALL COORDINATE WITH APPLICABLE PLANS, McDONALD'S AREA CONSTRUCTION MANAGER, CONTENT SUPPLIER AND SIGNAGE SUPPLIER TO DETERMINE EXACT LOCATION, ORIENTATION, MOUNTING HEIGHTS, AND NUMBER OF BOARDS AND OTHER DRIVE-THRU ELEMENTS TO BE INSTALLED AT THIS SITE. ALL WORK TO BE COORDINATED WITH OTHER TRADES.
- CONTACT McDONALD'S AREA CONSTRUCTION MANAGER FOR DRIVE-THRU ELEMENT FOOTING AND WIRING REQUIREMENTS NOT SHOWN. (INFORMATION ALSO AVAILABLE THROUGH VENDOR WEBSITES) SIGNAGE MANUFACTURER TO PROVIDE FOOTING ANCHORS & TEMPLATES TO G.C. PRIOR TO FOUNDATION POURING.
- SEE DETAIL 2/DT1.0 FOR DETECTOR LOOP INFORMATION, ELECTRICAL SHEETS FOR LOW VOLTAGE CONDUIT DIAGRAM AND FOR DRIVE THRU POWER DIAGRAM; VENDOR'S SPECIFICATIONS SHALL COVER UPON ANY DISCREPANCIES.
- CONTRACTOR TO COORDINATE THE RESPONSIBILITIES OF THE ELECTRICAL CONTRACTOR, CONTENT SUPPLIER AND THE SIGN SUPPLIER.
- CONTRACTOR TO INSTALL PRE-FORMED, PRE-WIRED VEHICLE DETECTOR LOOP.
- CONTRACTOR SHALL VERIFY CONDUIT SIZES REQUIRED BY VEHICLE LOOP DETECTOR SUPPLIER.

© 2023 McDonald's USA, LLC

McDonald's USA, LLC

These drawings and specifications are the confidential and proprietary property of McDonald's USA, LLC and shall not be copied or reproduced without the express written consent of McDonald's USA, LLC. The contractor shall not copy or reproduce these drawings and specifications for any purpose other than the specific project for which they were prepared. These drawings and specifications are to be used only for the construction of the project for which they were prepared and shall not be used for any other purpose. Use of these drawings and specifications for any other purpose is unauthorized and is prohibited. These drawings and specifications are the property of McDonald's USA, LLC and shall not be loaned or otherwise transferred to another party. Any unauthorized use, copying, or reproduction of these drawings and specifications is a violation of federal law.

PREPARED BY:

JAW

2023

STD ISSUE DATE

2023

DRAWN BY:

JAW

REVIEWED BY:

JAW

DATE ISSUED:

03/08/24

SITE ADDRESS:

STUCCO/BATEN/BRICK/METAL PANEL EXTERIOR FINISHES

SITE ID:

402-3271


SEC OF:

S.H. LOOP 288 & HUMMINGBIRD LANE, DENTON, TEXAS

SHEET NO.

DT1.0

DRIVE-THRU DETAILS

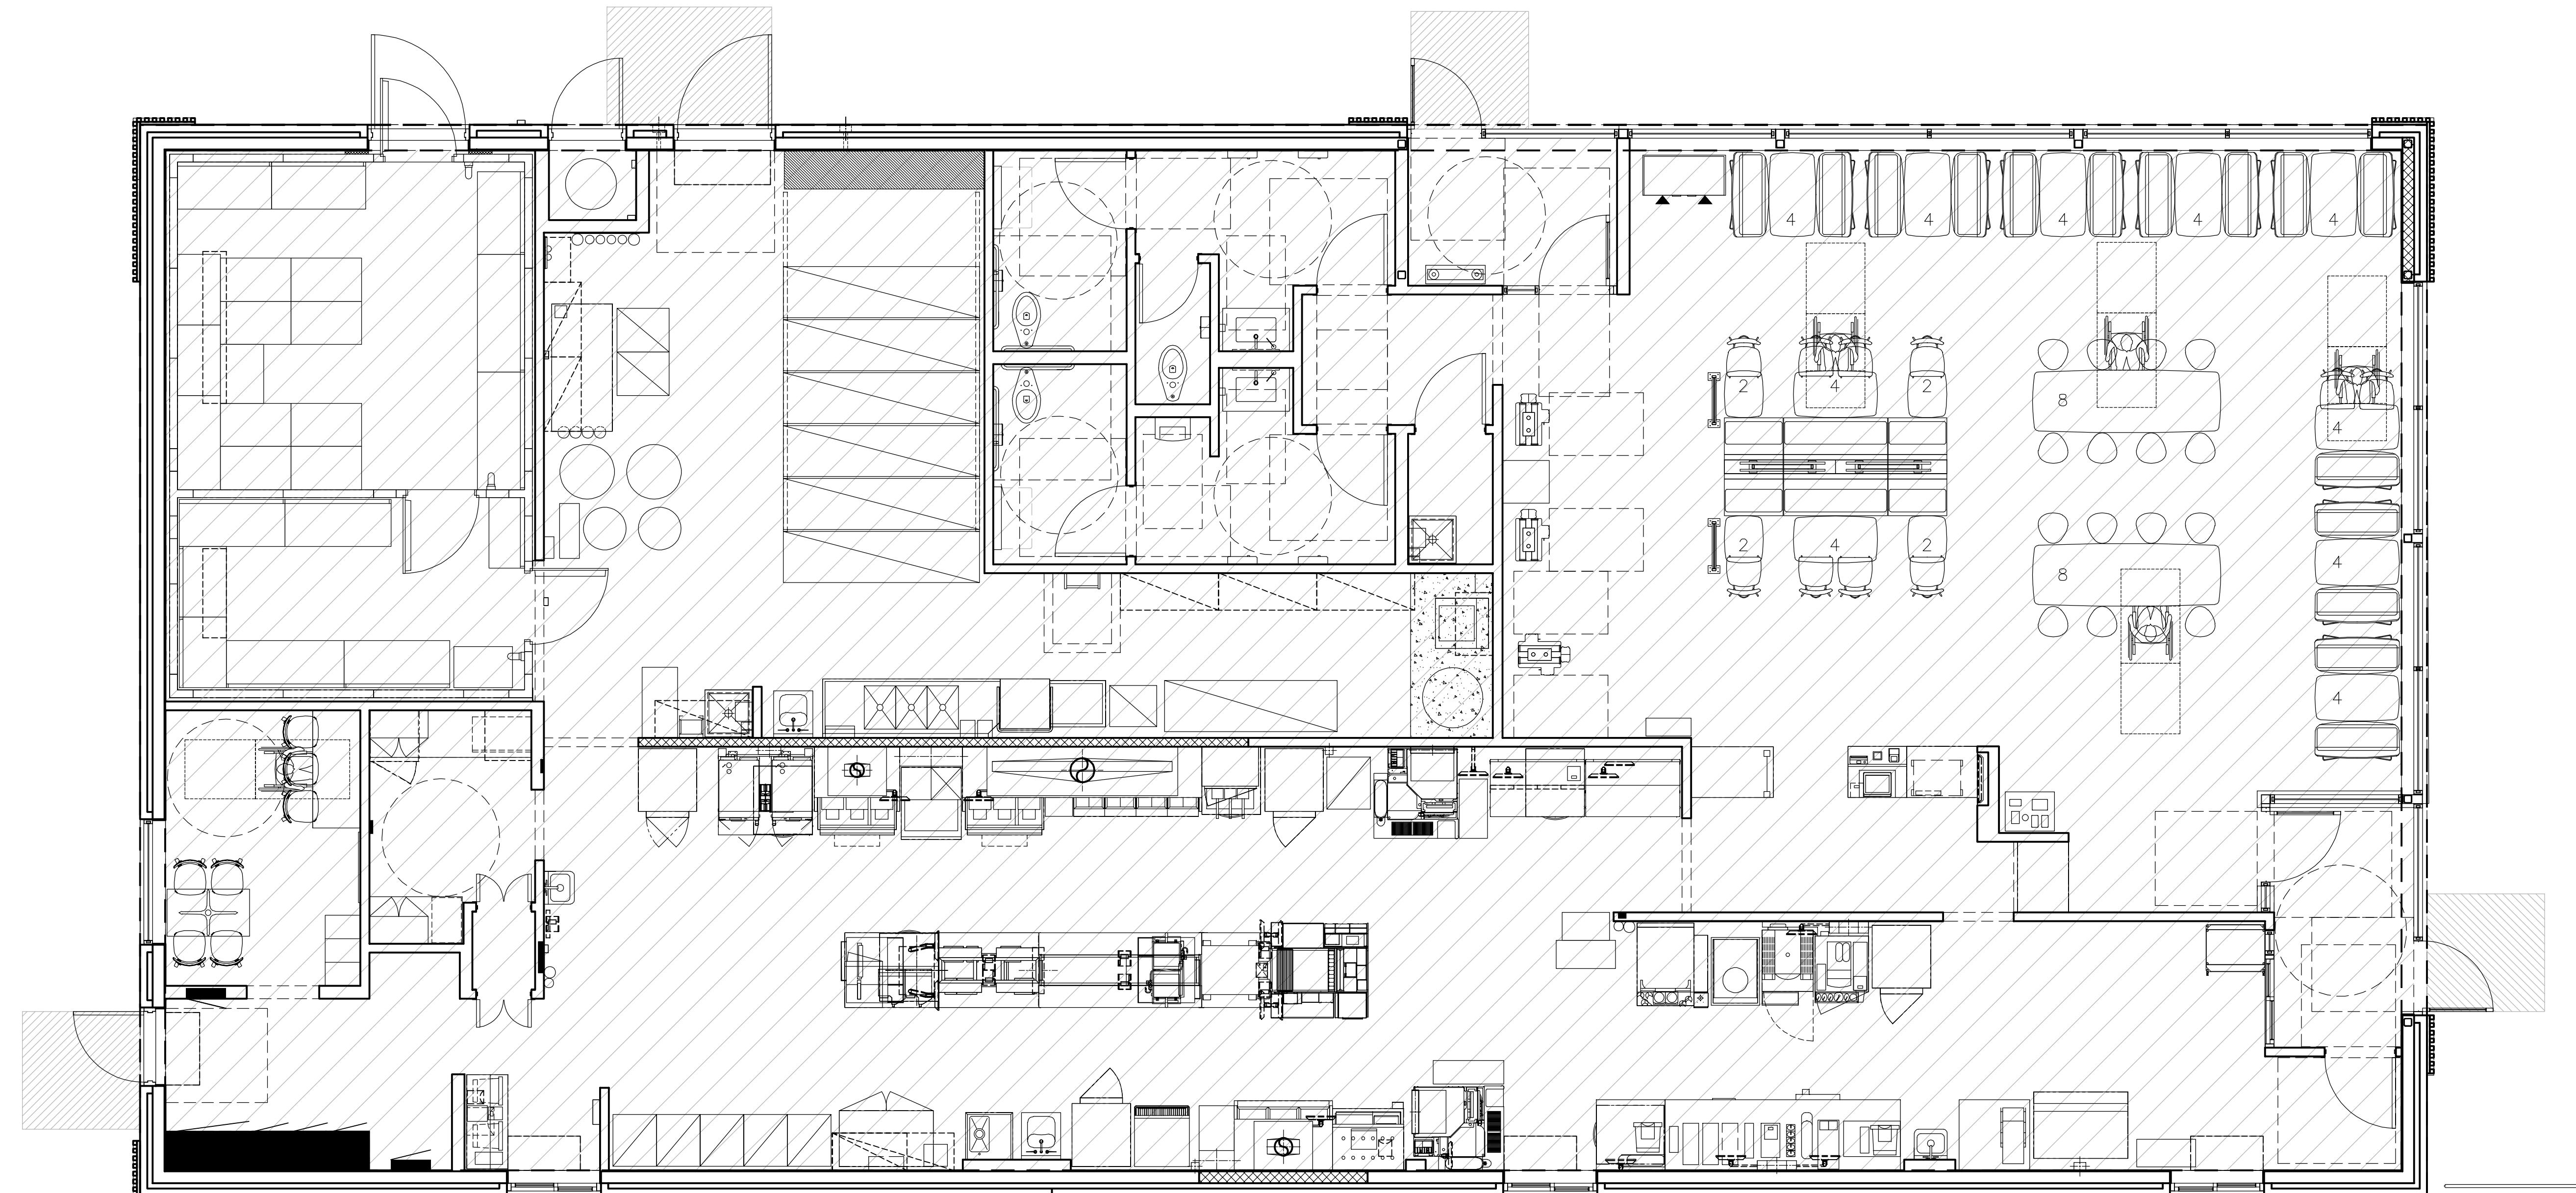


BASE BUILDING: 4,421 GROSS S.F.
 4,117 NET S.F.



SQUARE FOOTAGE PLAN

1
R1.0 $\frac{1}{4}'' = 1'-0''$

2023 STANDARD BUILDING – BB20		STD ISSUE DATE 2023	REVIEWED BY JAW	DATE ISSUED 03/08/24	REV BY
4597-WOOD/WOOD		DESCRIPTION	WOOD BEARING WALLS W/4" BRICK VENEER	WOOD ROOF TRUSS FRAMING	McDonald's USA, LLC
			STUCCO/BATTEN/BRICK/METAL PANEL EXTERIOR FINISHES		DESCRIPTION
SITE ID 042-3271	SITE ADDRESS SEC OF S.H. LOOP 288 & HUMMINGBIRD LANE, DENTON TEXAS				
R 1.0		SQUARE FOOTAGE	JAWA 24-0014	JAW	JAW Architects, Inc. Jeremy Williams, Architect
					Phone: 817-705-3387 Email: jeremy@jawaarch.com
					REGISTERED ARCHITECT JEREMY WILLIAMS SINCE 1926 STATE OF TEXAS
					© JAW ARCHITECTURE & DESIGN
					These drawings and specifications are the confidential and proprietary property of McDonald's USA, LLC and shall not be copied or reproduced without written authorization. The contract documents were prepared for use on this specific site in conjunction with its issue date and are not suitable for use on a different site or at a later time. Use of these drawings for reference or example on another project requires the services of properly licensed architects and engineers. Reproduction of the contract documents for reuse on another project is not authorized.

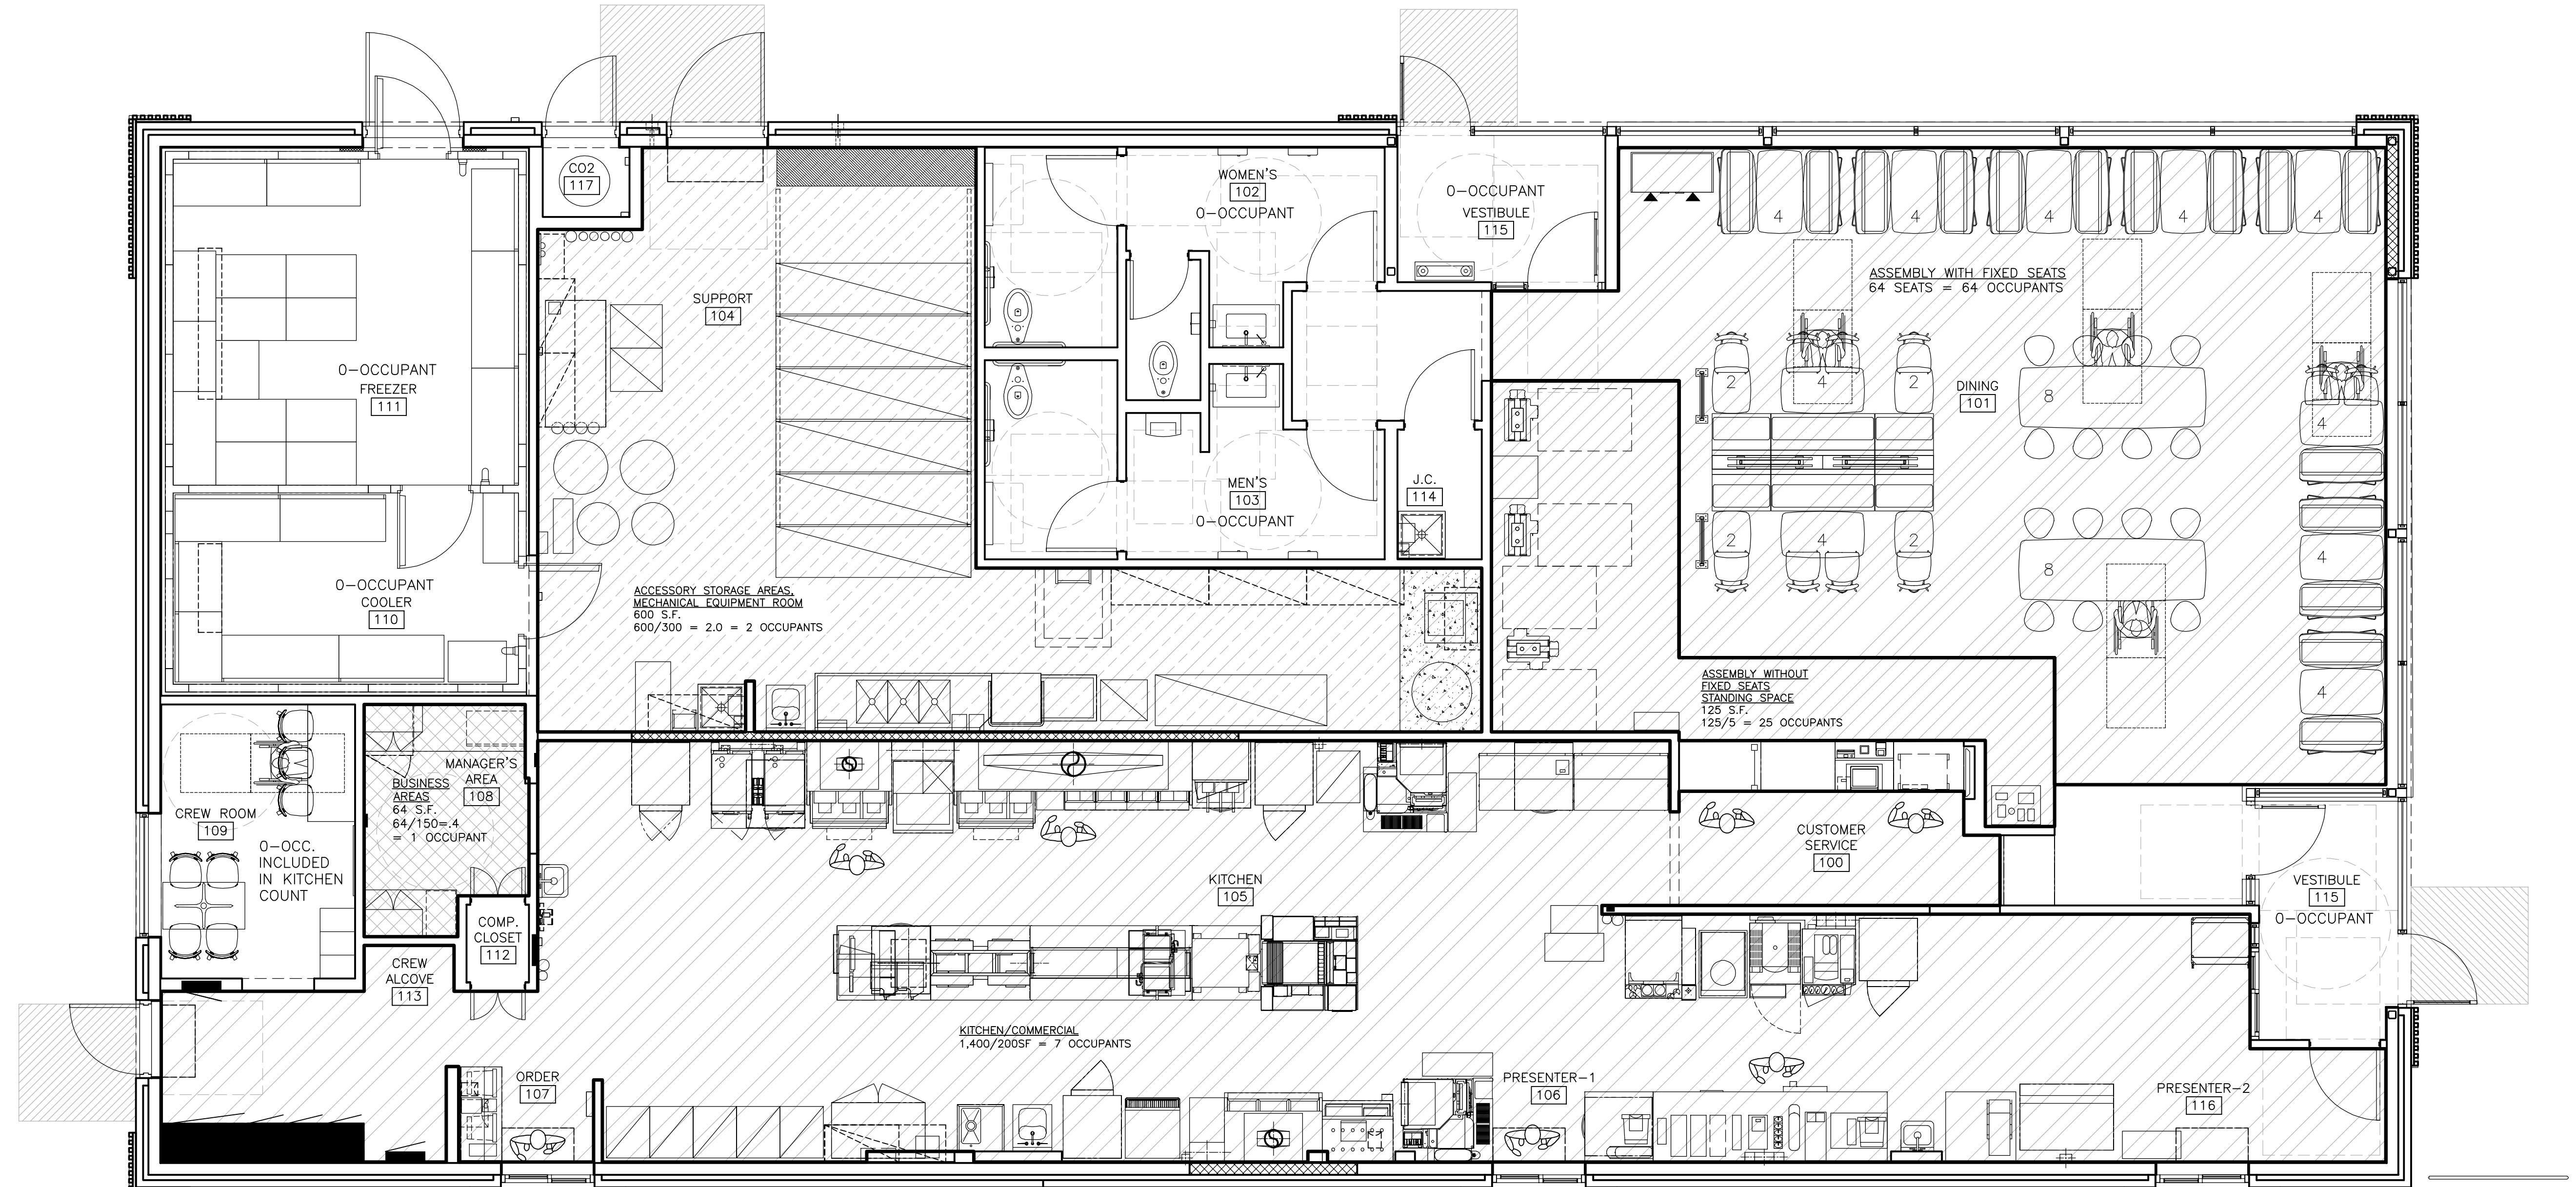

OCCUPANCY COUNT PLAN

R1.1
1/4" = 1'-0"

OCCUPANCY ALLOWANCE:

INTERNATIONAL BUILDING CODE 2021

TABLE 1004.5
MAXIMUM FLOOR AREA ALLOWANCES PER OCCUPANT


FUNCTION OF SPACE	ALLOWANCE	AREA	OCCUPANTS	
ACCESSORY STORAGE AREAS, MECHANICAL EQUIPMENT ROOM	300 GROSS	600 SF	2	
ASSEMBLY WITH FIXED SEATS	SEE PLAN	-	64	
ASSEMBLY W/OUT FIXED SEATS STANDING SPACE	5 NET	125 SF	25	
BUSINESS AREAS	150 GROSS	64 SF	1	
KITCHENS, COMMERCIAL	200 GROSS	1,400 SF	7	
TOTAL OCCUPANCY ALLOWANCE		99		

McDonald's USA, LLC

@ 2023 McDonald's USA, LLC

These drawings and specifications are the confidential and proprietary
property of McDonald's USA, LLC and shall not be copied or reproduced
without authorization. The printed drawings were prepared
for the project identified above. They are issued for construction
and are not suitable for use on a different site or at a later time. Use of
these drawings for reference or example on another project requires
the services of properly licensed architects and engineers. Reproduction of
the contract documents for reuse on another project is not authorized.

DRAWN BY: JAW	STD ISSUE DATE: 2023
REVIEWED BY: JAW	DATE ISSUED: 03/08/24
DESCRIPTION: WOOD BEARING WALLS W/4" BRICK VENEER STUCCO/BATEN/BRICK/METAL PANEL EXTERIOR FINISHES	
SHEET NO. R1.1	TITLE 2023 STANDARD BUILDING - BB20 4597-WOOD/WOOD
SITE ID 042-3271	ADDRESS SEC OF S.H. LOOP 288 & HUMMINGBIRD LANE, DENTON TEXAS

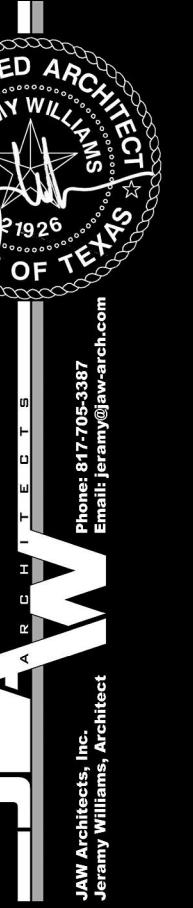


Phone 817-705-3387


REV	DATE	DESCRIPTION

BY

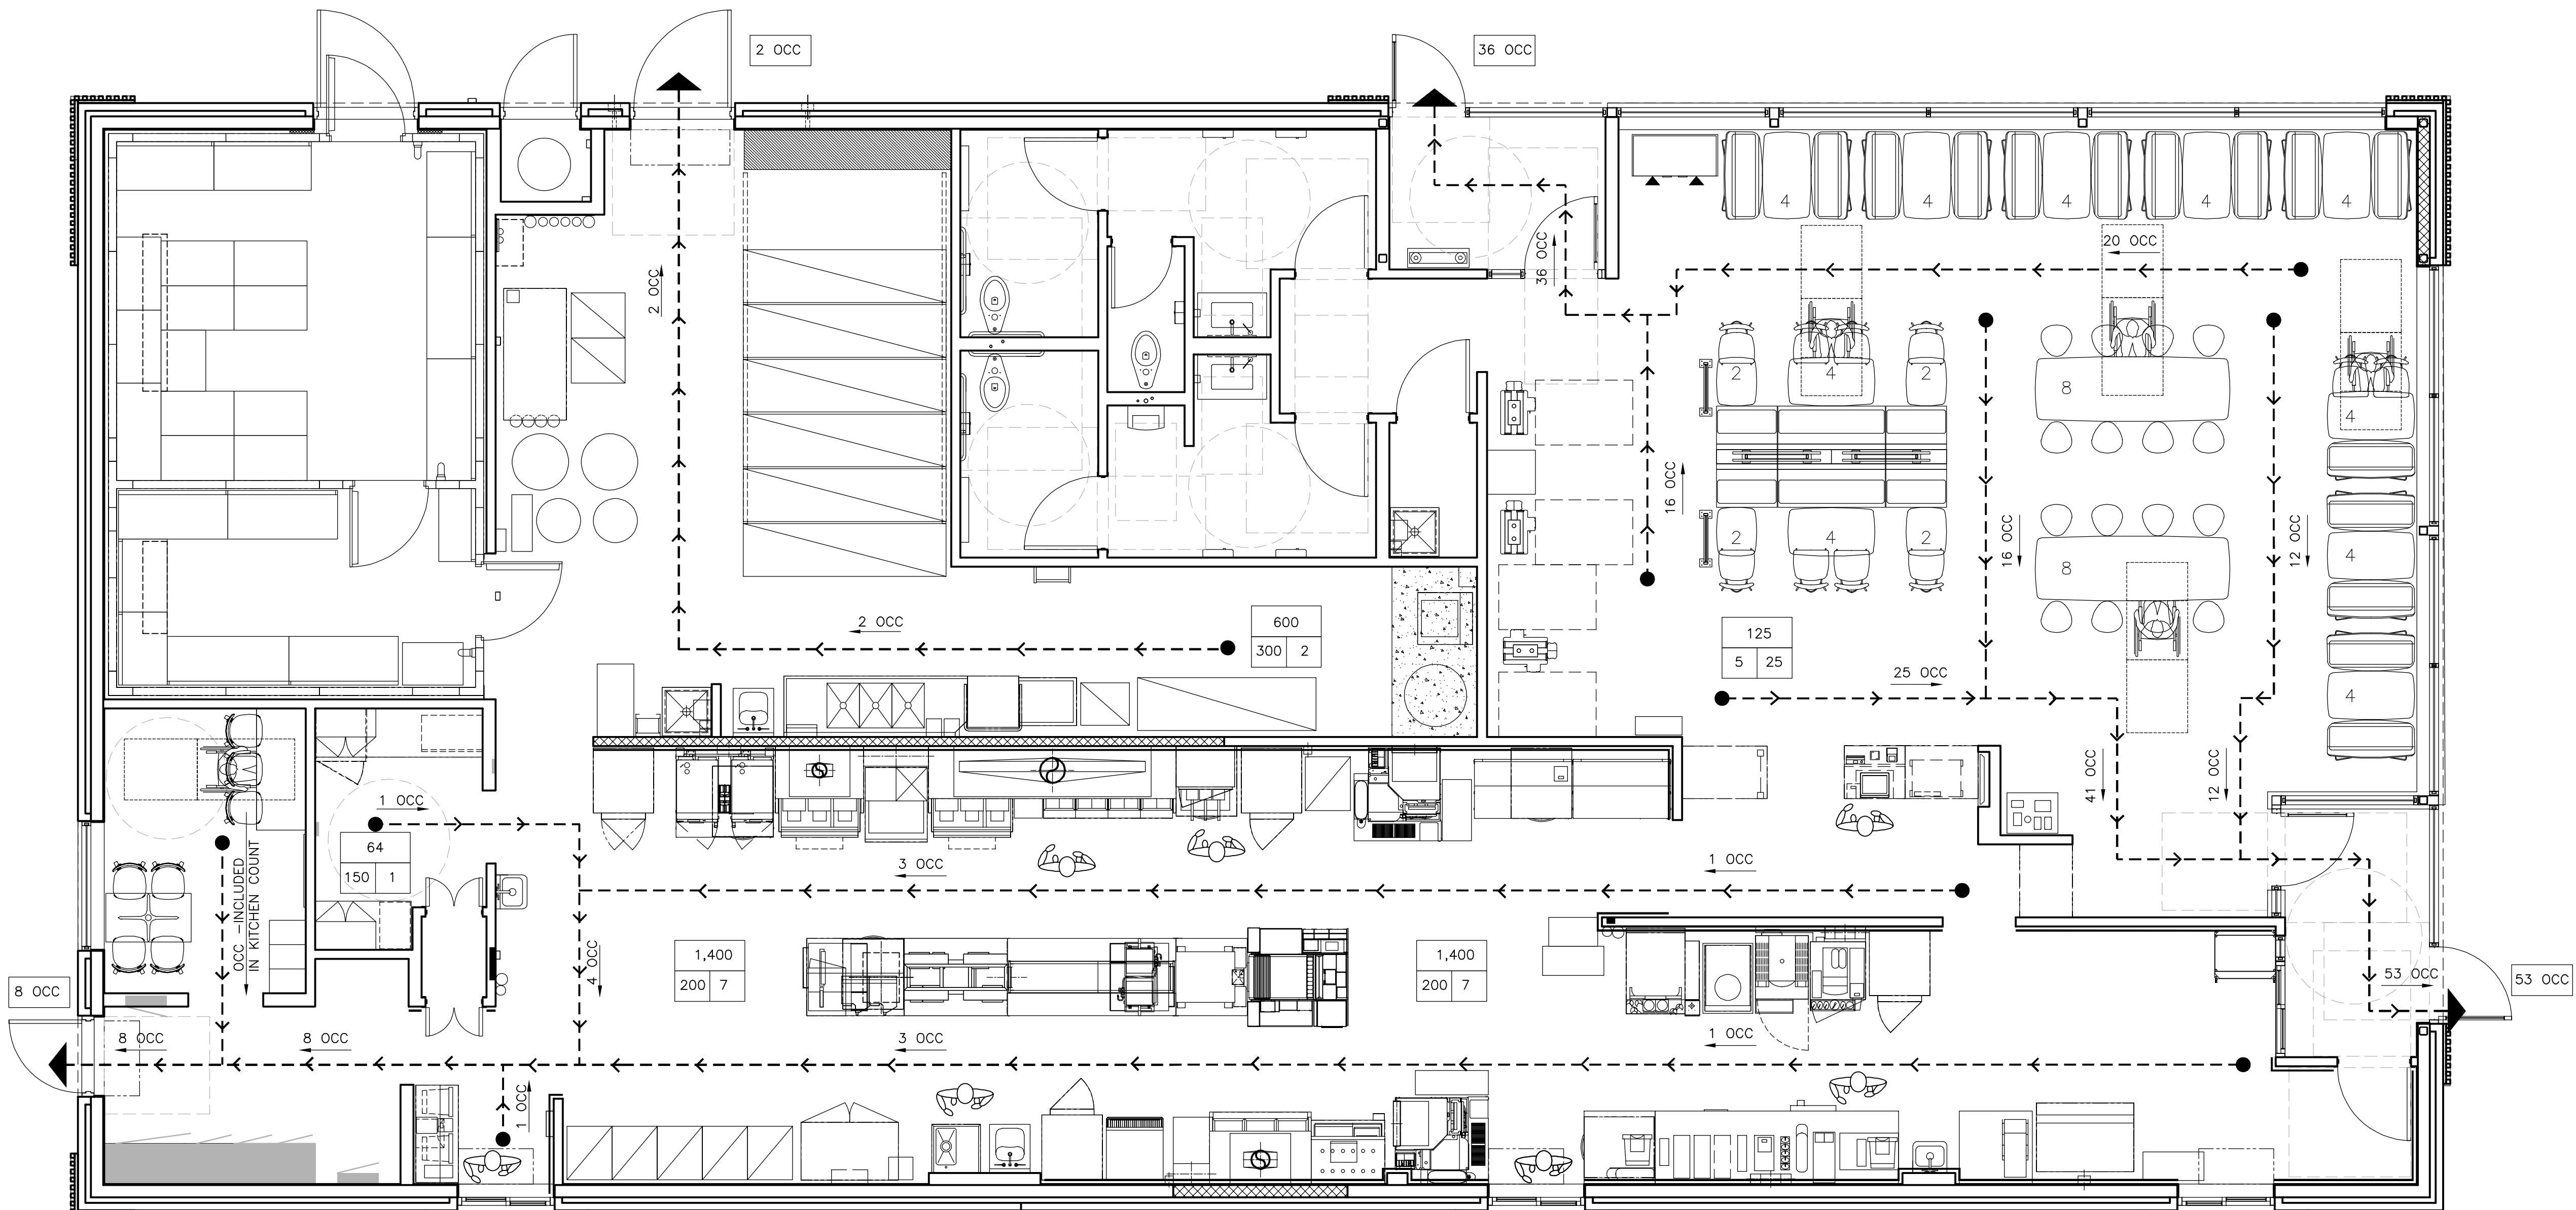

EXITING PLAN

OCCUPANCY ALLOWANCE:

INTERNATIONAL BUILDING CODE 2021

TABLE 1004.5
MAXIMUM FLOOR AREA ALLOWANCES PER OCCUPANT

FUNCTION OF SPACE	ALLOWANCE	AREA	OCCUPANTS
ACCESSORY STORAGE AREAS, MECHANICAL EQUIPMENT ROOM	300 GROSS	600 SF	2
ASSEMBLY WITH FIXED SEATS	SEE PLAN	—	64
ASSEMBLY W/OUT FIXED SEATS STANDING SPACE	5 NET	125 SF	25
BUSINESS AREAS	150 GROSS	64 SF	1
KITCHENS, COMMERCIAL	200 GROSS	1,400 SF	7
TOTAL OCCUPANCY ALLOWANCE			99


SHEET NO.	TITLE	PREPARED FOR:	PREPARED BY:	
R1.2	2023 STANDARD BUILDING – BB20 4597-WOOD/WOOD	 McDonald's USA, LLC	JAW	@ 2023 McDonald's USA, LLC
	DESCRIPTION	DRAWN BY JAW	STD ISSUE DATE 2023	
	WOOD BEARING WALLS W/4" BRICK VENEER WOOD ROOF TRUSS FRAMING STUCCO/BATTEN/BRICK/METAL PANEL EXTERIOR FINISHES	REVIEWED BY JAW	DATE ISSUED 03/08/24	
042-3271	SITE ADDRESS SEC OF S.H. LOOP 288 & HUMMINGBIRD LANE, DENTON TEXAS	REV	DATE	DESCRIPTION
BY				

R1.2 EXITING PLAN JAWA 24-0014



JAW Architects, Inc.
Jeremy Williams, Architect
Phone: 817-705-3387
Email: jeremy@jaw-arch.com

These drawings and specifications are the confidential and proprietary property of McDonald's USA, LLC and shall not be copied or reproduced without written authorization. The contract documents were prepared for use on this specific site in conjunction with its issue date and are not suitable for use on a different site or at a later time. Use of these drawings for reference or example on another project requires the services of properly licensed architects and engineers. Reproduction of the contract documents for reuse on another project is not authorized.

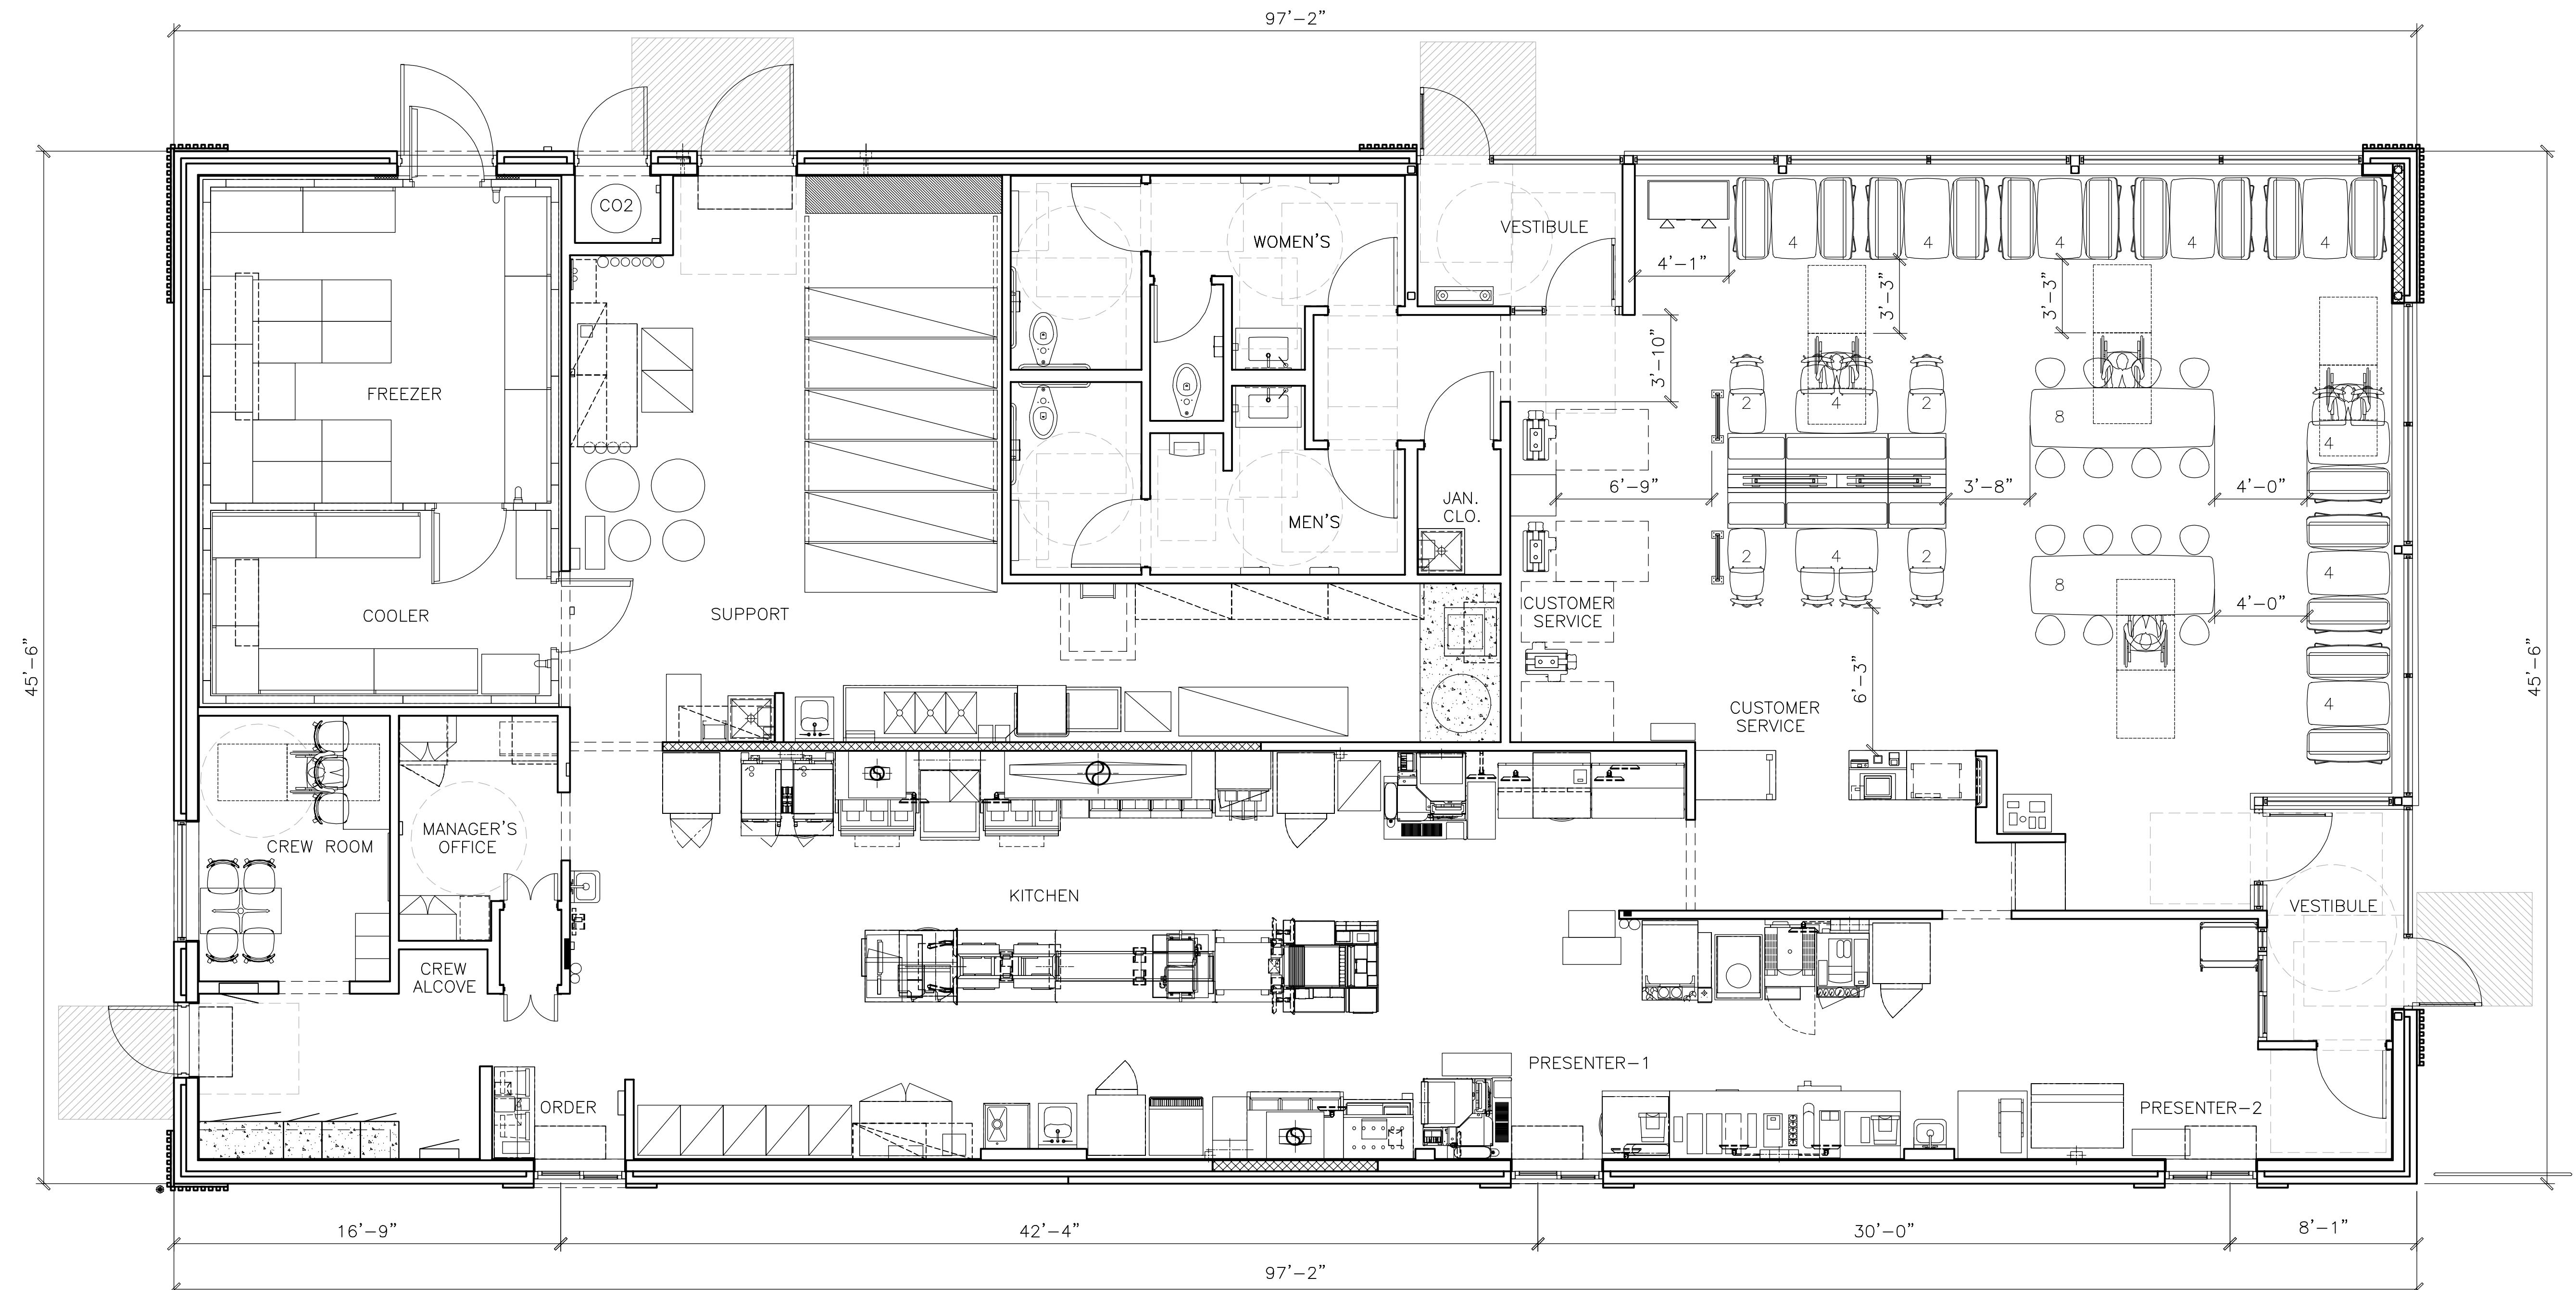


**4597 - WW BRICK VENEER PLAN
4,421 GROSS SQ. FT. / 4,117 NET SQ. FT.
64 SEATS (4 ACCESSIBLE SEATS)**

**THIS DRAWING IS
FOR REFERENCE ONLY
NOT FOR CONSTRUCTION**

SEATING LAYOUT IS SCHEMATIC, THE FINAL
SEATING LAYOUT TO BE PROVIDED BY OTHERS.

SHEET NO.	R1		
TITLE	2023 STANDARD BUILDING – BB20 4597-WOOD/WOOD		
DESCRIPTION	WOOD BEARING WALLS W/4" BRICK VENEER WOOD ROOF TRUSS FRAMING STUCCO/BATTEN/BRICK/METAL PANEL EXTERIOR FINISHES		
DRAWN BY	JAW	PREPARED FOR:	McDonald's USA, LLC PREPARED BY: JAW
STD ISSUE DATE	2023	REVIEWED BY	JAW
DATE ISSUED	03/08/24	REV	PREPARED BY: JAW
SITE ID	SITE ADDRESS	SEC OF S.H. LOOP 288 & HUMMINGBIRD LANE, DENTON TEXAS	
@ 2023 McDonald's USA, LLC			
<p>These drawings and specifications are the confidential and proprietary property of McDonald's USA, LLC and shall not be copied or reproduced without written authorization. The contract documents were prepared for use on this specific site in conjunction with its issue date and are not suitable for use on a different site or at a later time. Use of these drawings for reference or example on another project requires the services of properly licensed architects and engineers. Reproduction of the contract documents for reuse on another project is not authorized.</p> 			
 <p>JEREMY WILLIAMS REGISTERED ARCHITECT #1926 OF TEXAS</p> <p>JAW ARCHITECTS Phone: 817-705-3387 Email: jeremy@jaw-arch.com</p>			

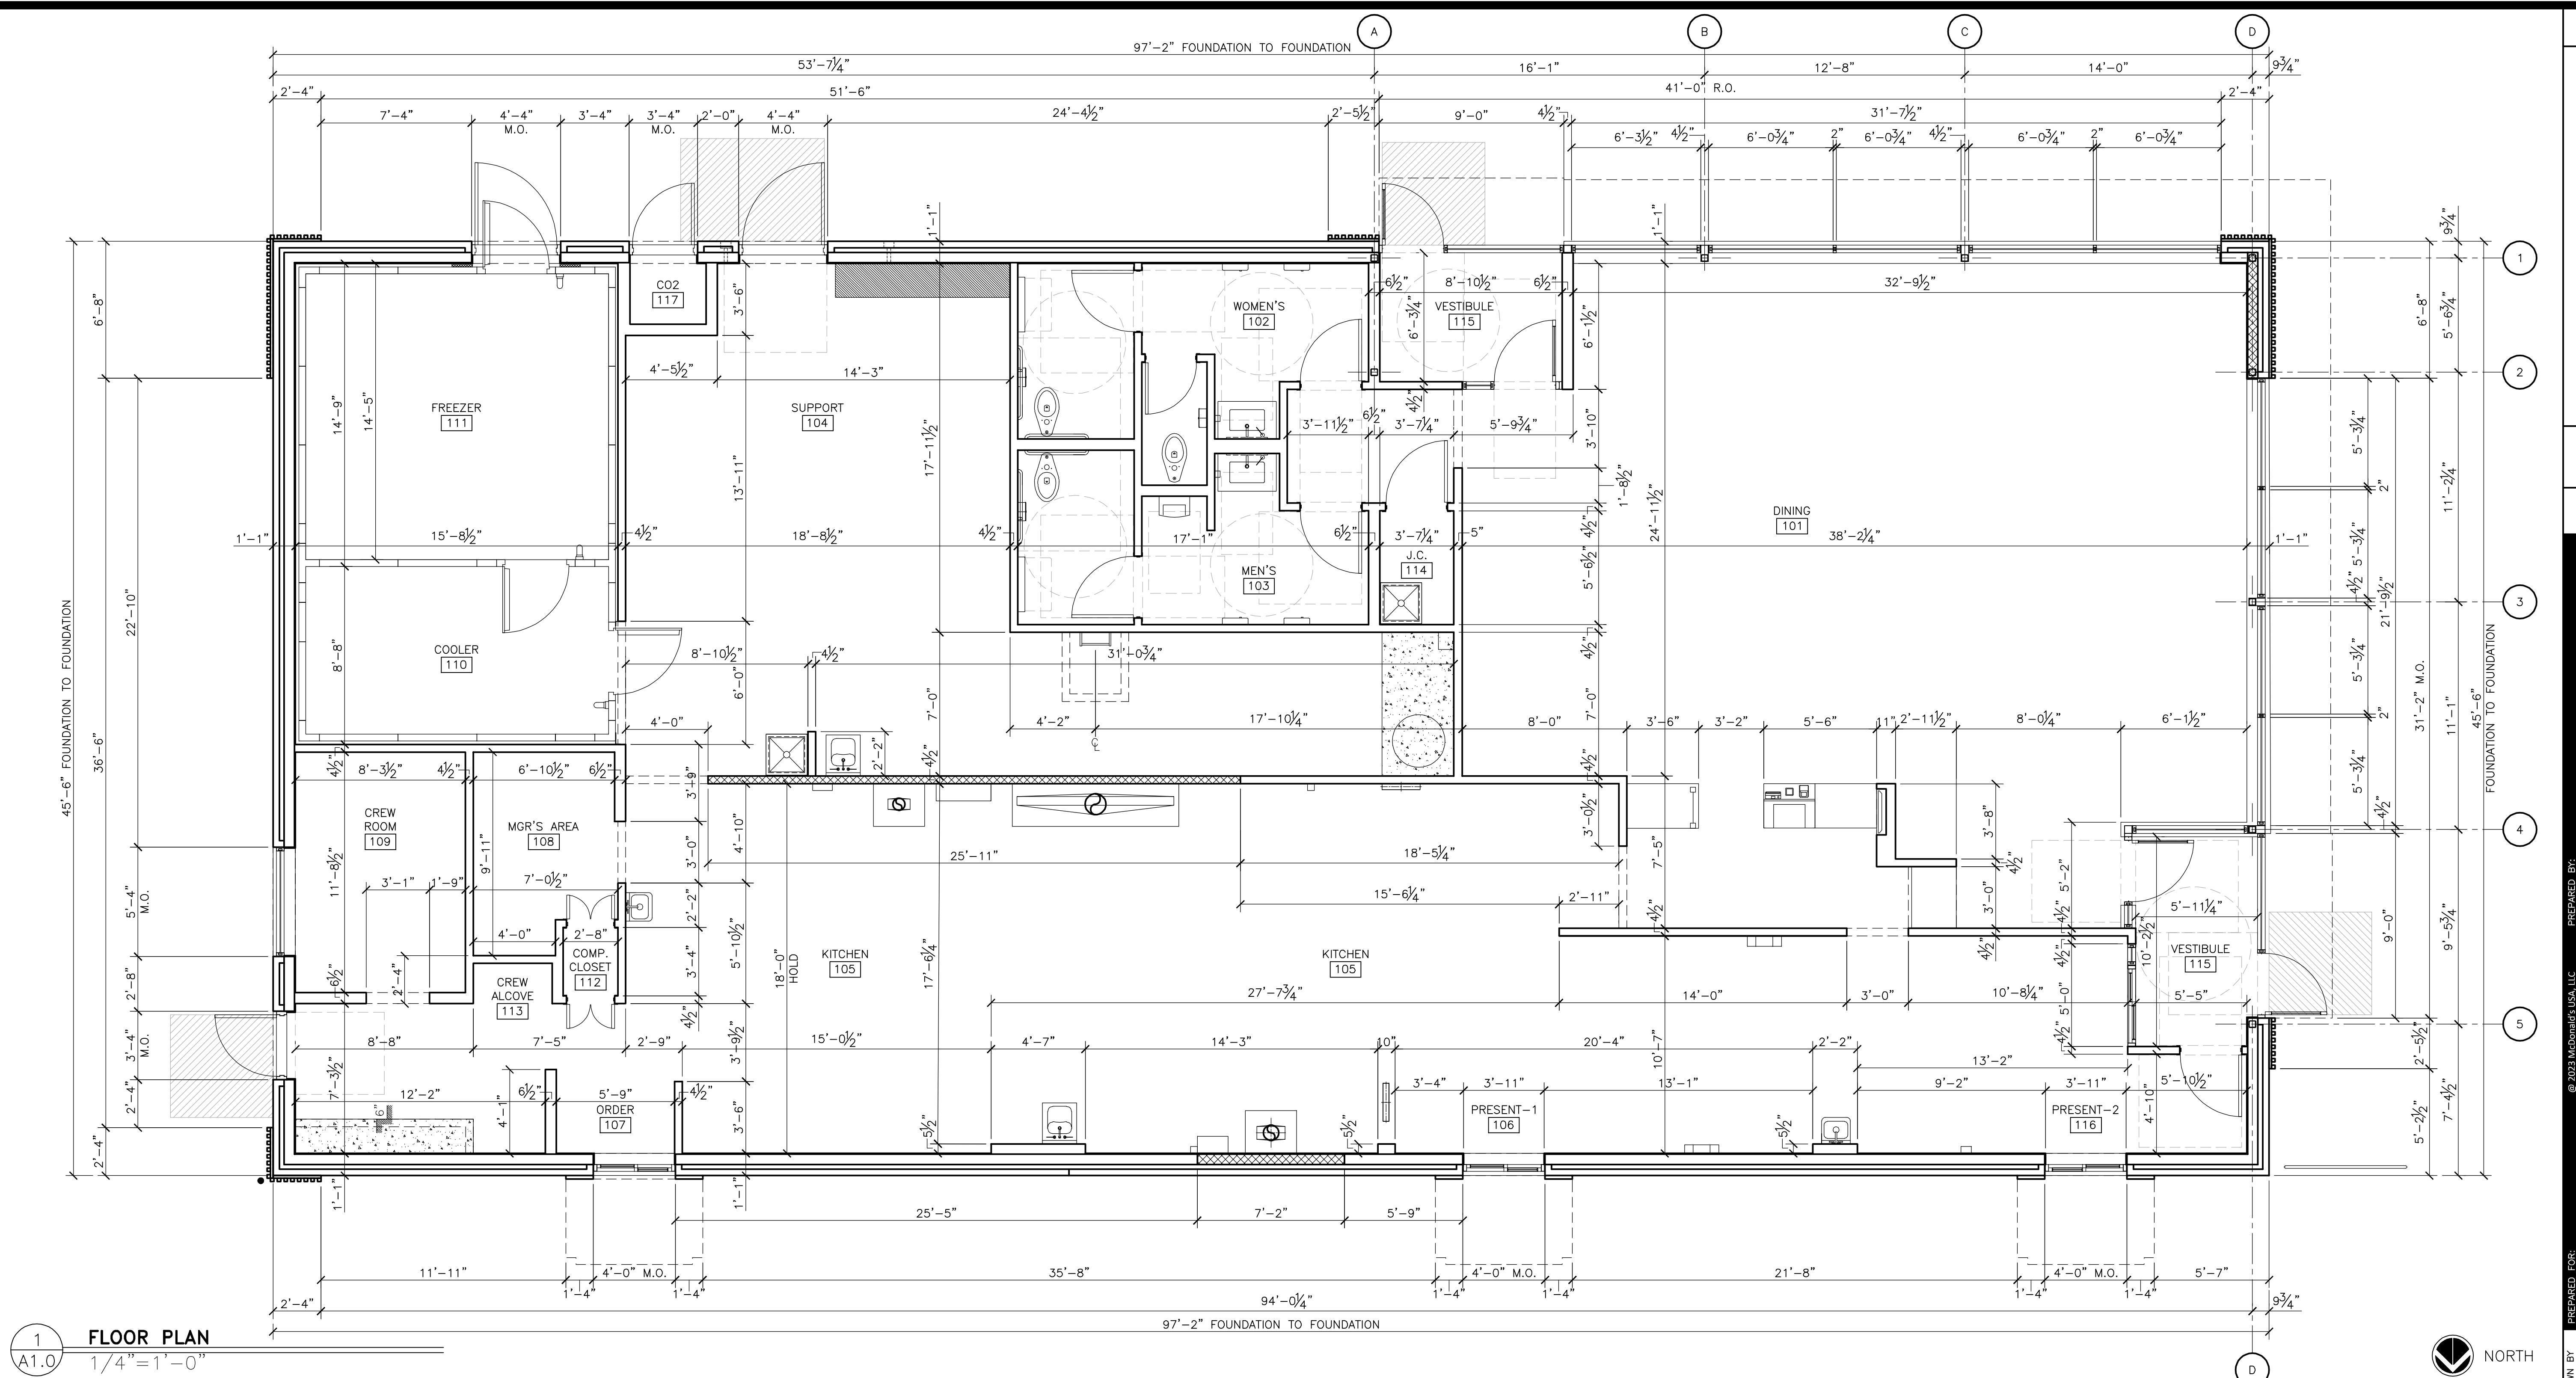

1 FLOOR PLAN

A1.0 $1/4'' = 1' - 0''$

KEY NOTES

- C ALUMINUM CANOPY SYSTEM ABOVE – SEE 4/A5.0 FOR NOTES – SEE ROOF PLAN FOR DIMENSIONS, SEE ELEVATION FOR COLORS AND FASCIA LOCATIONS
 - CG G.C. TO PROVIDE 4"x4"x5'-0" HIGH STAINLESS STEEL CORNER GUARDS AT ALL EXPOSED LOCATIONS IN KITCHEN/SUPPORT AREA. CORNER GUARDS TO START AT FINISH FLOOR. ATTACH WITH WOOD SCREWS INTO WOOD BLOCKING BULLNOSE COVE BASE WHERE TILE MEETS STAINLESS STEEL CORNER
 - CP CONCRETE EQMT PAD – SEE STRUCTURAL
 - CT WALL TILE: CROSSVILLE – COLOR BY NUMBERS
COLOR: AFTERNOON SPRAY, SIZE: 4"x12", PATTERN: RUNNING BOND
^B GROUT: MAPEI 02 PEWTER – JOINT TO BE $\frac{1}{6}$ " MAX.
USE THIS TILE WHEN HIGH LRV IS REQUIRED
COORDINATE WITH McDONALD'S AREA CONSTRUCTION MANAGER
 - DF DECOR FINISH TO BE ORDERED/INSTALLED BY GC AND
MANUFACTURED BY DECOR; REFER TO PORTFOLIO.
 - DS DROPPED SOFFIT ABOVE – SEE REFLECTED CEILING PLAN
 - FB CO2 FILL BOX (EQUIPMENT SCHEDULE ITEM 49.00)
CO2
 - FB OPTIONAL BULK OIL FILL BOX (EQPM SCHEDULE ITEM 700.18)
CONFIRM USE WITH McDONALD'S AREA CONSTRUCTION MANAGER
BO

- FL** FLOOR LINE – CHANGE IN MATERIAL – SEE DECOR DRAWINGS
 - FP** FIBERGLASS REINFORCED PLASTIC (FRP) – PANOLAM,
GRAY SMOOTH, CLASS A, .075. REFER TO ROOM FINISH
SCHEDULE SHEET A6.1 FOR INSTALLATION LOCATIONS.
FOR ORDERING, CONTACT KIMBERLY LAWSON
Kimberly_Lawson@panolam.com 1-866-925-4377
 - LL** LEVEL LANDING @ EXT. DOOR W/ MAX. 2% RUNNING/CROSS SLOPE
AWAY FROM BUILDING
5'x5'
SIZE OF LANDING
 - MS** MOP SINK – SEE DETAIL 8/A6.1 AND PLUMBING DRAWINGS.
 - RL** ROOF ACCESS LADDER W/HATCH ABOVE SEE
STRUCTURAL FRAMING PLAN FOR LOCATING DIMENSIONS
 - WW** LATE NIGHT WINDOW BY READYACCESS,
MANUAL OPEN/SELF CLOSE
(OPTIONAL FOR HIGH DELIVERY RESTAURANTS)
 - AL** ALUMINUM BATTEN SYSTEM, REFERENCE DETAIL 16/A4.1

SYMBOL LEGEND


- A PARTITION TYPE TAG SEE 2/A1.1
7 DOOR TAG - SEE DOOR SCHEDULE ON A6.0

X KEY NOTE
GENERAL NOTES


- GENERAL NOTES**

 1. EXTERIOR DIMENSIONS ARE TO COLUMN REFERENCE LINES AND EXTERIOR FACE OF MASONRY UNLESS OTHERWISE NOTED. INTERIOR DIMENSIONS ARE TO FACE OF INTERIOR WALL BOARD
 2. SEE 4/A5.0 FOR EXTERIOR WALL ASSEMBLY TYPES. SEE 2/A1.1 FOR INTERIOR PARTITION TYPES. INTERIOR PARTITIONS ARE TYPE 'A' UNLESS NOTED OTHERWISE.
 3. SEE EXTERIOR ELEVATIONS FOR WINDOW TYPES
 4. SEE SHEET A6.0 FOR DOOR AND ROOM FINISH SCHEDULES
 5. SEE SITE PLAN FOR SIDEWALKS, RAMPS, ETC.
 6. GC TO PROVIDE ADA SIGNAGE PACKAGE AND INSTALL SIGNS AT LOCATIONS AND POSITIONS INDICATED IN PACKAGE OR AS REQUIRED BY LOCAL CODES. SIGNAGE PACKAGE SUPPLIED BY: FRANKE/S2K
1-800-423-5247 www.frankesupply.com
email: fs-frankesupply.us@franke.com
 7. MAXIMUM OCCUPANCY SIGN TO BE POSTED PER LOCAL CODE. SIGN FURNISHED AND INSTALLED BY GENERAL CONTRACTOR.
 8. ALL HANDSINK LOCATIONS SHALL HAVE CEMENT BOARD BACKING 48" IN HEIGHT A.F.F.
 9. GC TO COORDINATE ALL REQUIRED BLOCKING FOR WALL HUNG EQUIPMENT, SHELVES, ETC. FOR PROPER INSTALLATION HEIGHTS.
 10. KNOX BOX TO BE INSTALLED PER LOCAL CODE AS REQUIRED. MODEL AND LOCATION TO BE COORDINATED WITH FIRE MARSHALL.

TITLE		2023 STANDARD BUILDING - BB20	
SHEET NO.		JAWA 24-0014	
4597-WOOD/WOOD		STD ISSUE DATE	JAW 2023
DESCRIPTION		REVIEWED BY	JAW
WOOD BEARING WALLS W/4" BRICK VENEER		DATE ISSUED	03/08/24
WOOD ROOF TRUSS FRAMING			
STUCCO/BATTEN/BRICK/METAL PANEL EXTERIOR FINISHES			
SITE ID	SITE ADDRESS		
042-3271	SEC OF S.H. LOOP 288 & HUMMINGBIRD LANE, DENTON TEXAS		

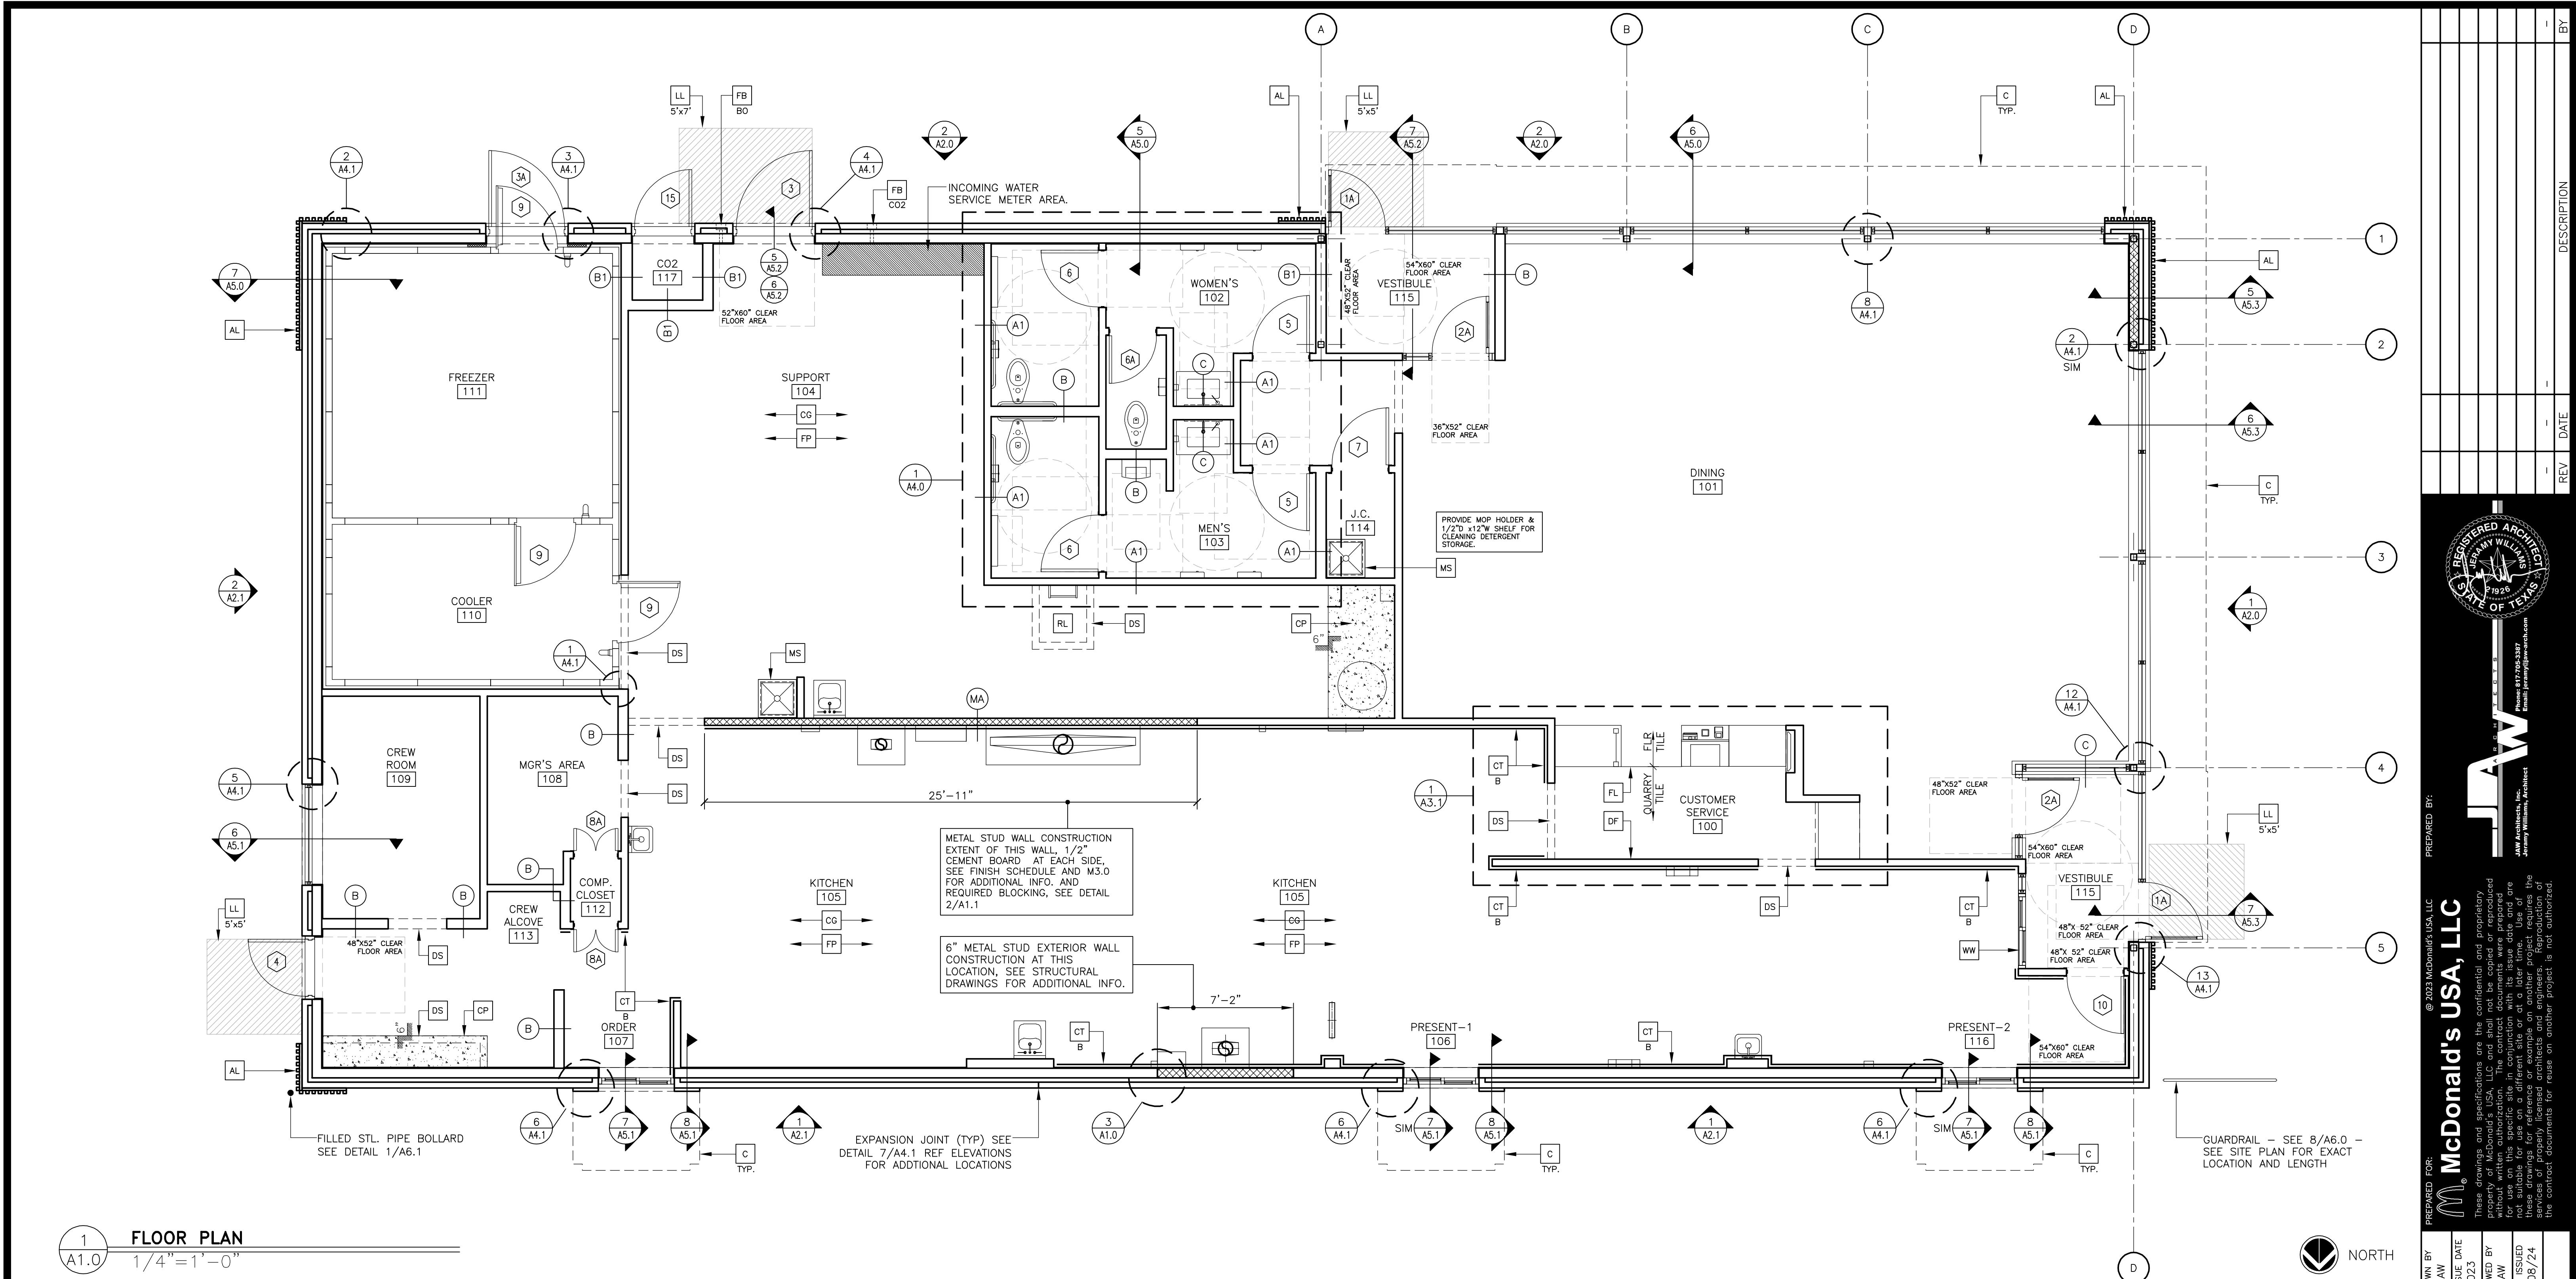

SHEET NO.	TITLE	DRAWN BY	STD ISSUE DATE	STD ISSUE DATE
A1.1	2023 STANDARD BUILDING - BB20 4597-WOOD/WOOD	JAW	2023	2023
DESCRIPTION: WOOD BEARING WALLS W/4" BRICK VENEER STUCCO/BATEN/BRICK/METAL PANEL EXTERIOR FINISHES SITE ADDRESS: 042-3271 SEC OF S.H. LOOP 288 & HUMMINGBIRD LANE, DENTON, TEXAS				
DRAWN BY: JAW STD ISSUE DATE: 03/08/2023 REVIEWED BY: JAW DATE ISSUED: 03/08/2023				
KEY NOTES				
<p>(1) LAYER OF CEMENT BOARD TILE BEHIND HOODS STUD FRAMING STRUCT. MEMBER OR STUD SPANNING LATERAL BRACING TO STRUCT. ABOVE CONT. 2X FIRESTOPPING AT EXTENT OF BACKUP (TYP.) METAL STUD PARTITION TYPE: "MA" = 3 5/8" SPACING: 16" O.C. STUD GUAGE: LOAD BEARING: 18 NON-LOAD BEARING: 20</p> <p>STRUCT. MEMBER OR STUD SPANNING BOTTOM CHORD @ 4"-0" O.C. CONT. 2X FIRESTOPPING AT EXTENT OF BACKUP (TYP.) METAL STUD PARTITION TYPE: "MA" = 3 5/8" SPACING: 16" O.C. STUD GUAGE: LOAD BEARING: 18 NON-LOAD BEARING: 20</p> <p>WOOD STUD PARTITION TYPE: ALL PARTITIONS TYPE 'A' UNLESS NOTED OTHERWISE</p> <p>"A" = 2x4 "A1" = 2x4 W/ SOUND BATT INS. "B" = 2x6 "B1" = 2x6 W/ SOUND BATT INS. "C" = 2x8 "C1" = 2x8 W/ SOUND BATT INS. "D1" = SEE DETAIL 3/A1.0</p> <p>STUD SPACING: 16" O.C.</p>				
<p>EXTERIOR WALL ASSEMBLY 1 (SEE ASSEMBLY NOTES A5.0)</p> <p>EXTERIOR GYP. BOARD AT METAL STUD FRAMING</p> <p>STRUCTURE MEMBER OR STUD SPANNING BOTTOM CHORD @ 4"-0" O.C. CONT. 2X FIRESTOPPING AT EXTENT OF BACKUP (TYP.) METAL STUD PARTITION TYPE: "MA" = 3 5/8" SPACING: 16" O.C. STUD GUAGE: LOAD BEARING: 18 NON-LOAD BEARING: 20</p> <p>WOOD STUD PARTITION TYPE: ALL PARTITIONS TYPE 'A' UNLESS NOTED OTHERWISE</p> <p>"A" = 2x4 "A1" = 2x4 W/ SOUND BATT INS. "B" = 2x6 "B1" = 2x6 W/ SOUND BATT INS. "C" = 2x8 "C1" = 2x8 W/ SOUND BATT INS. "D1" = SEE DETAIL 3/A1.0</p> <p>STUD SPACING: 16" O.C.</p>				
<p>SYMBOL LEGEND</p> <ul style="list-style-type: none"> (A) PARTITION TYPE TAG SEE 2/A1.1 (7) DOOR TAG - SEE DOOR SCHEDULE ON A6.0 (X) KEY NOTE <p>GENERAL NOTES</p> <ol style="list-style-type: none"> EXTERIOR DIMENSIONS ARE TO COLUMN REFERENCE LINES AND EXTERIOR FACE OF MASONRY UNLESS OTHERWISE NOTED. INTERIOR DIMENSIONS ARE TO FACE OF INTERIOR WALL BOARD. SEE 4/A5.0 FOR EXTERIOR WALL ASSEMBLY TYPES. SEE 2/A1.1 FOR INTERIOR PARTITION TYPES. INTERIOR PARTITIONS ARE TYPE 'A' UNLESS NOTED OTHERWISE. SEE EXTERIOR ELEVATIONS FOR WINDOW TYPES SEE SHEET A6.0 FOR DOOR AND ROOM FINISH SCHEDULES SEE SITE PLAN FOR SIDEWALKS, RAMPS, ETC. GC TO PROVIDE ADA SIGNAGE PACKAGE AND INSTALL SIGNS AT LOCATIONS AND POSITIONS INDICATED IN PACKAGE OR AS REQUIRED BY LOCAL CODES. SIGNAGE PACKAGE SUPPLIED BY: FRANKE/S2K 1-800-423-5247 www.frankeSupply.com email: fs-frankesupply.us@franke.com MAXIMUM OCCUPANCY SIGN TO BE POSTED PER LOCAL CODE. SIGN FURNISHED AND INSTALLED BY GENERAL CONTRACTOR. ALL HANDSINK LOCATIONS SHALL HAVE CEMENT BOARD BACKING 48" IN HEIGHT A.F.F. GC TO COORDINATE ALL REQUIRED BLOCKING FOR WALL HUNG EQUIPMENT, SHELVES, ETC. FOR PROPER INSTALLATION HEIGHTS. KNOX BOX TO BE INSTALLED PER LOCAL CODE AS REQUIRED. MODEL AND LOCATION TO BE COORDINATED WITH FIRE MARSHALL. 				

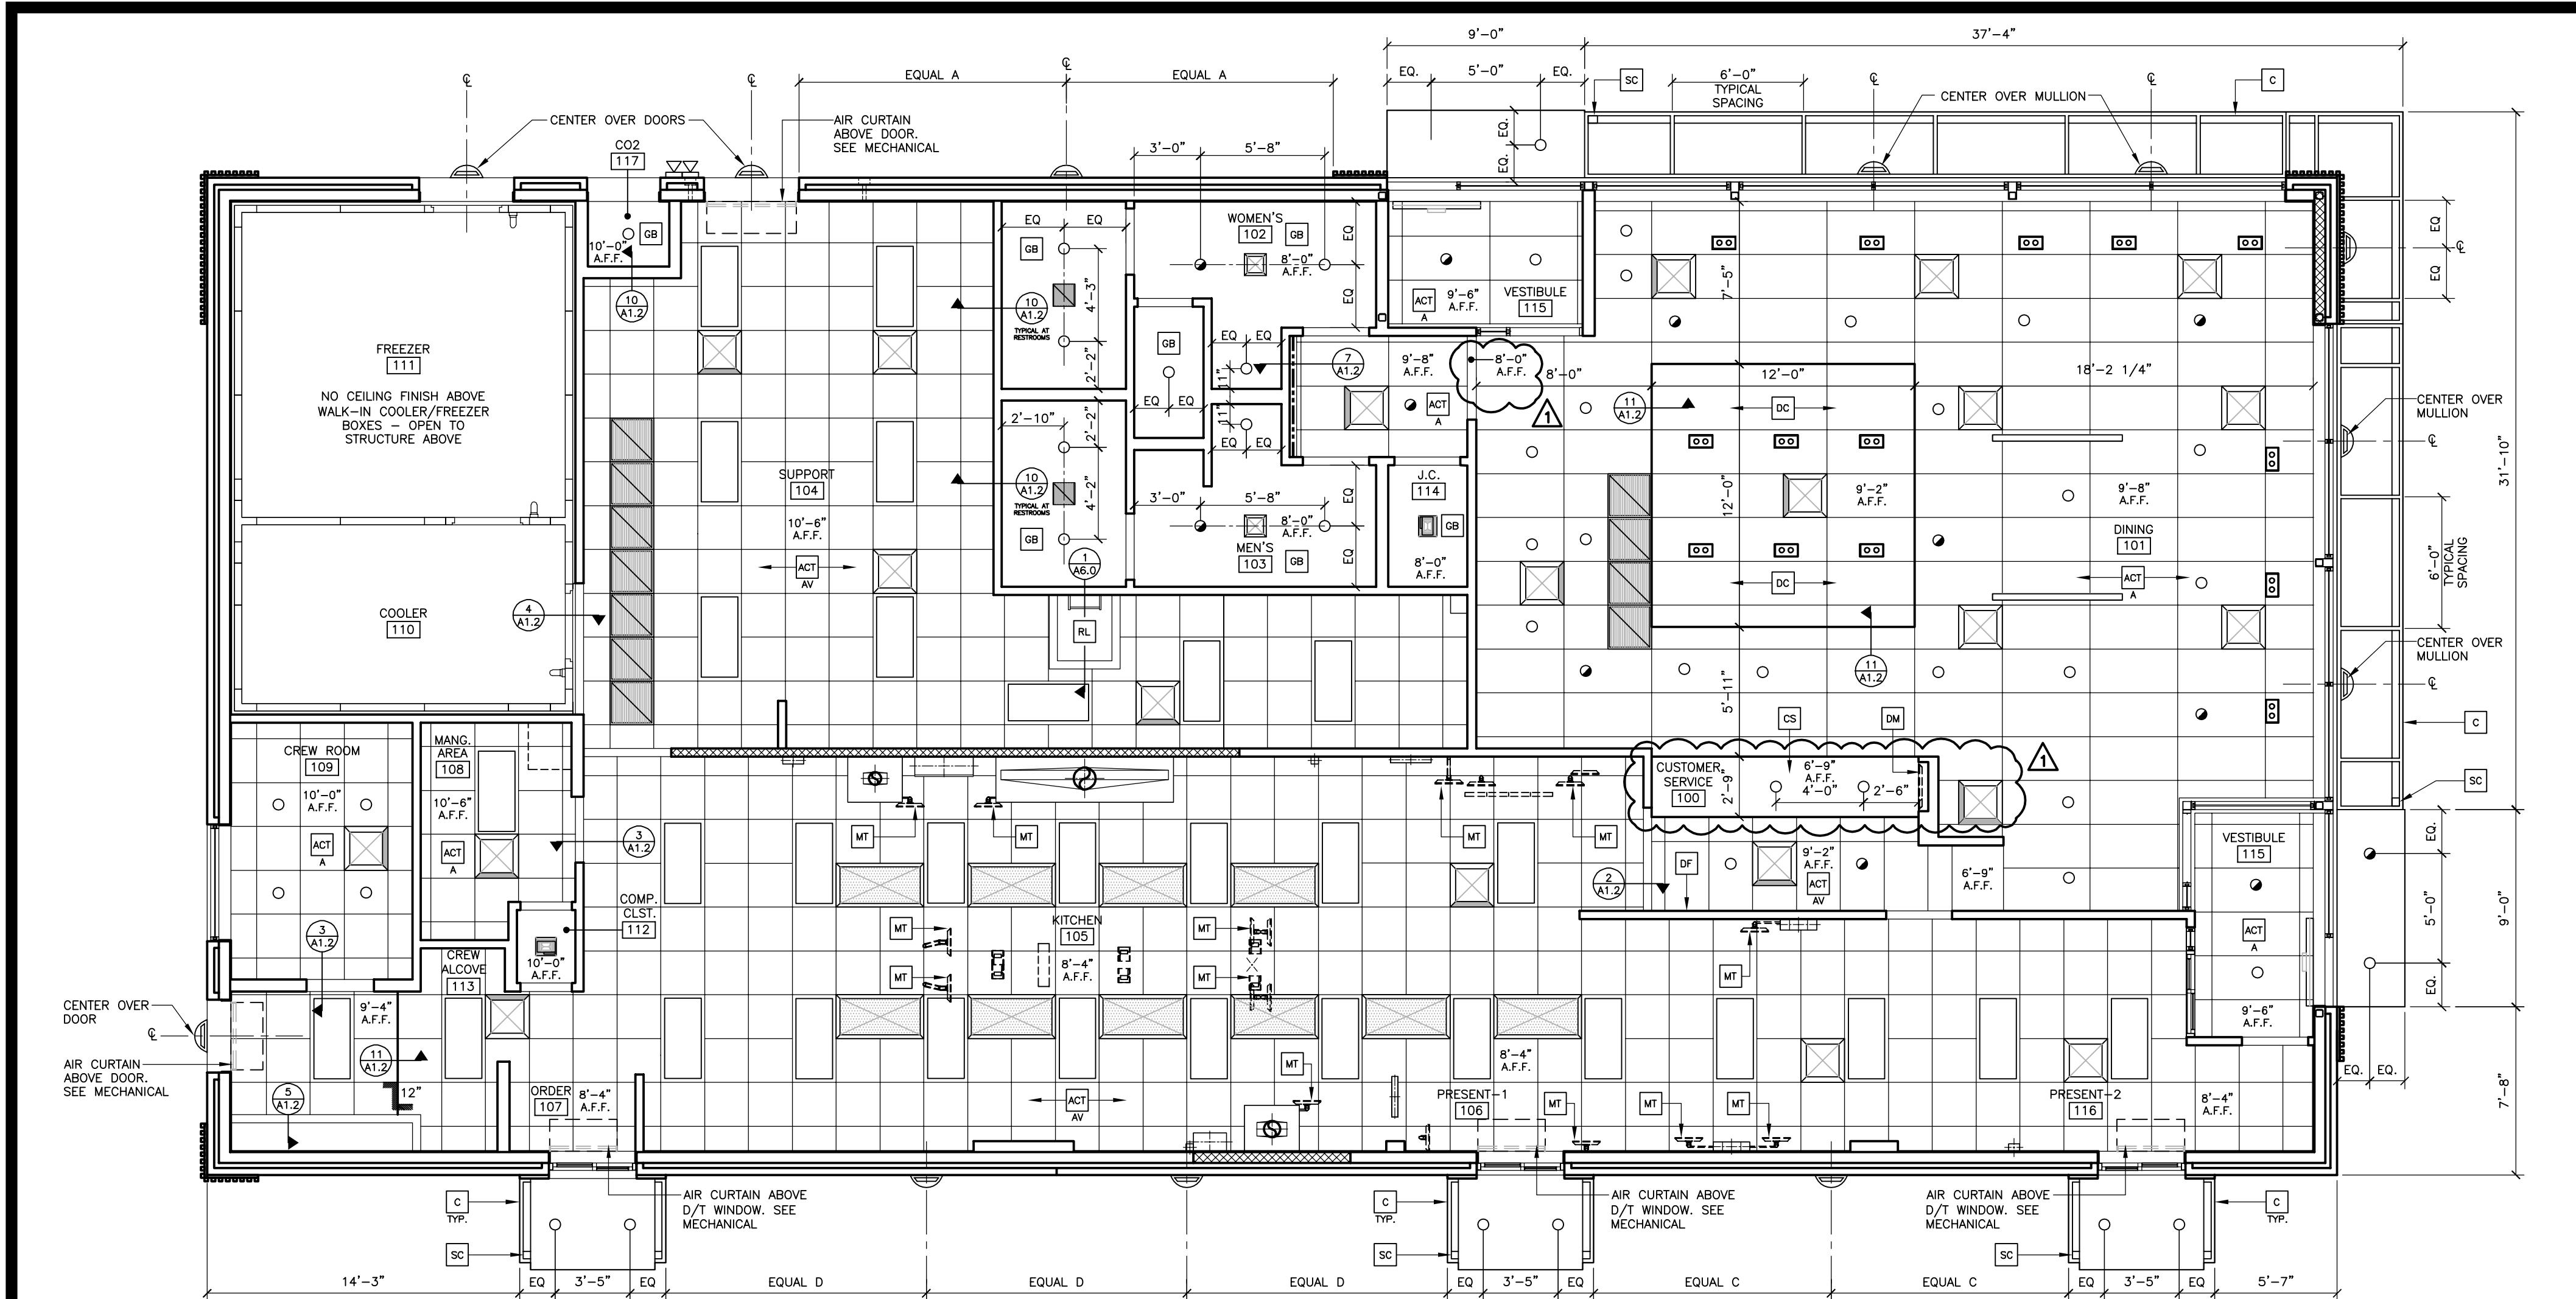










KEY NOTES

- [ACT A] ACOUSTICAL CEILING TILE - 24"X48". VERIFY FINISHES WITH DECOR COMPANY
- [ACT AV] ACOUSTICAL CEILING TILE: VINYL FACED USG 24"X24" CLEAN ROOM CLIMA-PLUS UNPERFORATED. SMOOTH TEXTURE COLOR: WHITE GRID:USG 15/16" DX/DXL COLOR: WHITE
- [C] ALUMINUM CANOPY WITH INTEGRAL GUTTER AND SCUPPER - SEE 4/A.5.O FOR NOTES - SEE ROOF PLAN FOR DIMENSIONS - SEE ELEVATION FOR COLOR AND FASCIA LOCATIONS
- [DC] SUSPENDED DECORATIVE CEILING TREATMENT - SEE DECOR DRAWINGS FOR ADDITIONAL INFORMATION
- [DM] DIGITAL MERCHANDISER
- [DF] DECOR FINISH TO BE ORDERED/INSTALLED BY GC AND MANUFACTURED BY DECOR; REFER TO PORTFOLIO.
- [GB] GYPSUM BOARD CEILING FINISH. SEE DECOR.
- [MT] CEILING MOUNTED MONITOR: A) VERIFY MONITOR LOCATIONS WITH MCDONALD'S PROJECT MANAGER PRIOR TO INSTALLATION. B) SEE DETAIL 6/A.1.2 FOR INSTALLATION METHOD
- [RL] ROOF LADDER OPENING
- [SC] INTERGRAL GUTTER SCUPPER
- [CS] GC BUILD SOFFIT OVER FRONT COUNTER PROVIDE FINISHES PER DECOR DRAWINGS



GENERAL NOTES

- SEE SHT A.6.1 FOR CEILING FINISHES.
- SEE SHT A.1.0 FOR MENU BOARD DROPPED SOFFIT LOCATION DIMENSIONS
- GENERAL CONTRACTOR SHALL COORDINATE HVAC DIFFUSER LOCATION WITH DECOR & MECHANICAL PLANS AND REPORT ANY DISCREPANCIES TO ARCHITECT.
- REFERENCE MECHANICAL AND ELECTRICAL DRAWINGS FOR DIFFUSER AND LIGHTING INFORMATION.
- PROVIDE USG V15 CEILING TILE RETENTION CLIPS IN ALL VESTIBULE AREAS

REFLECTED CEILING PLAN
A1.2 3/16"=1'-0"

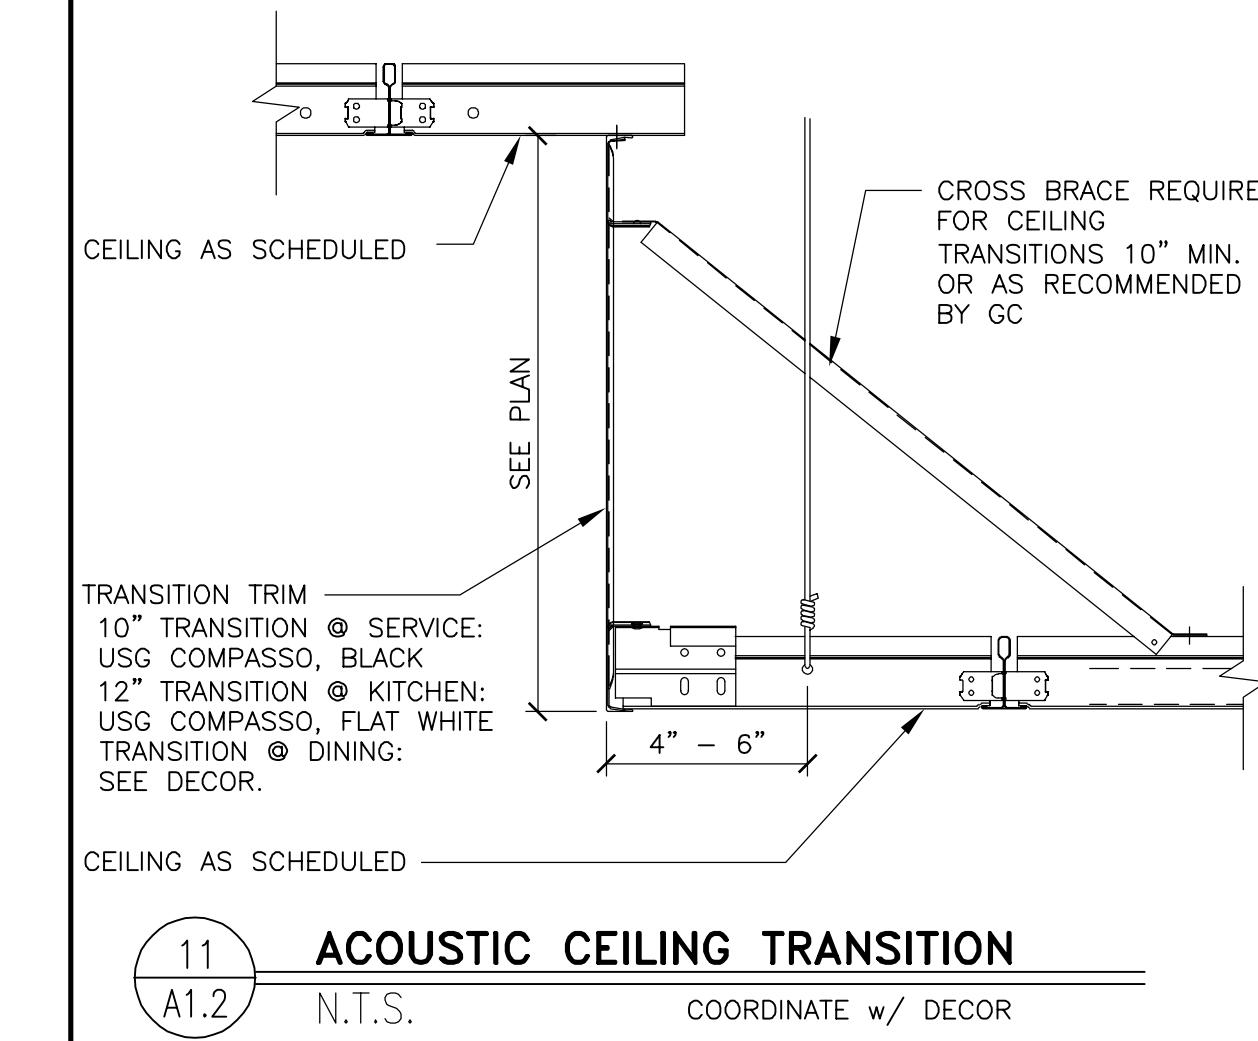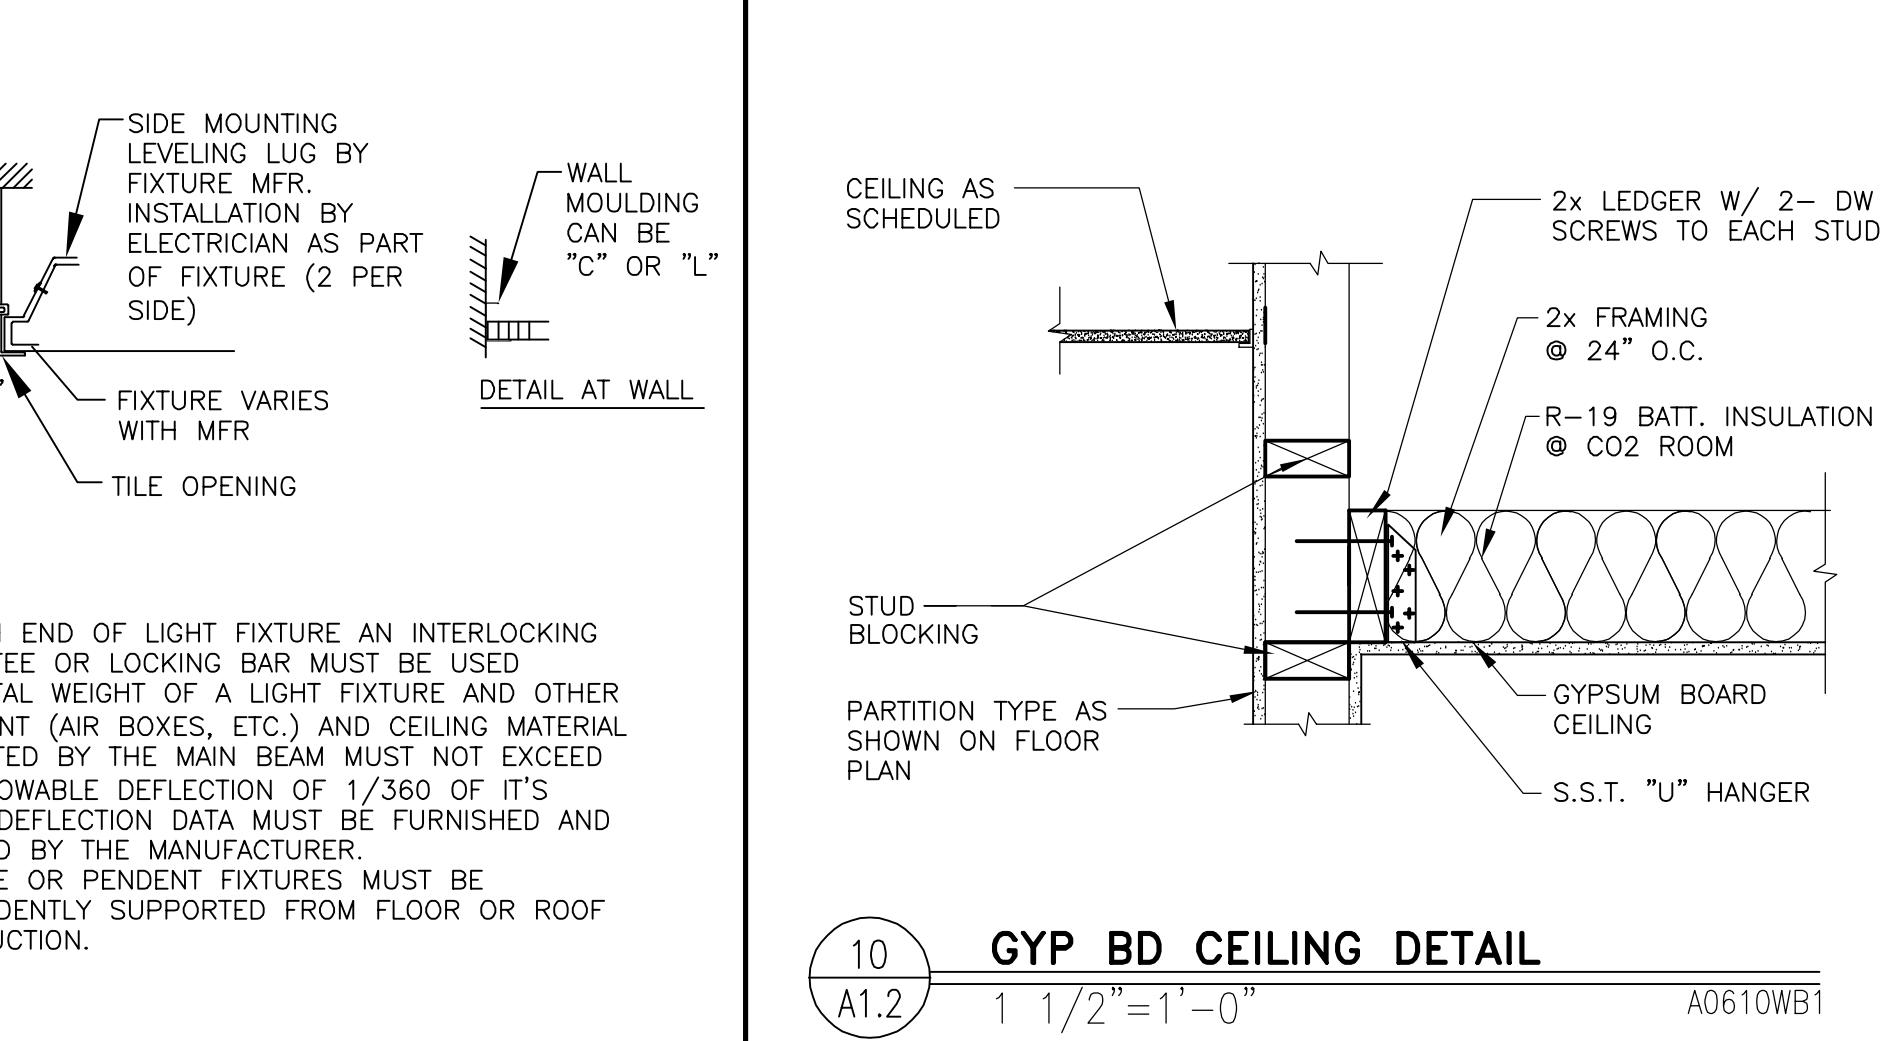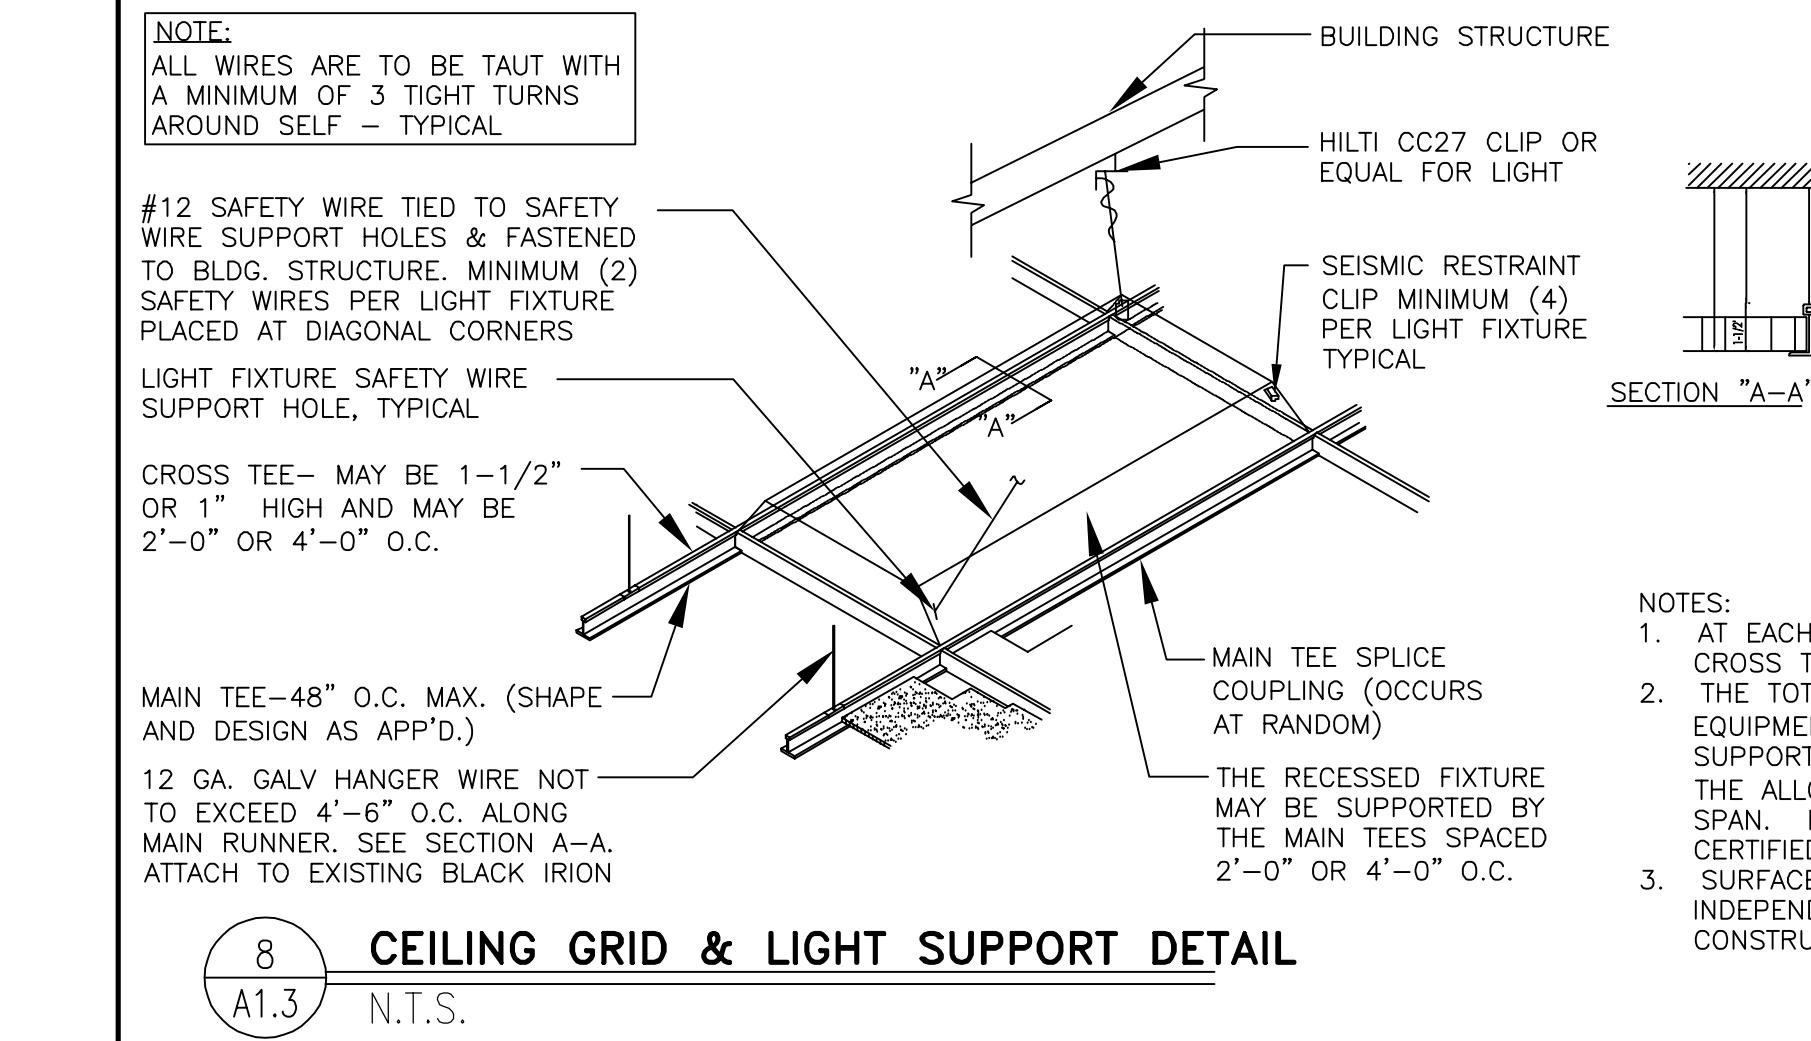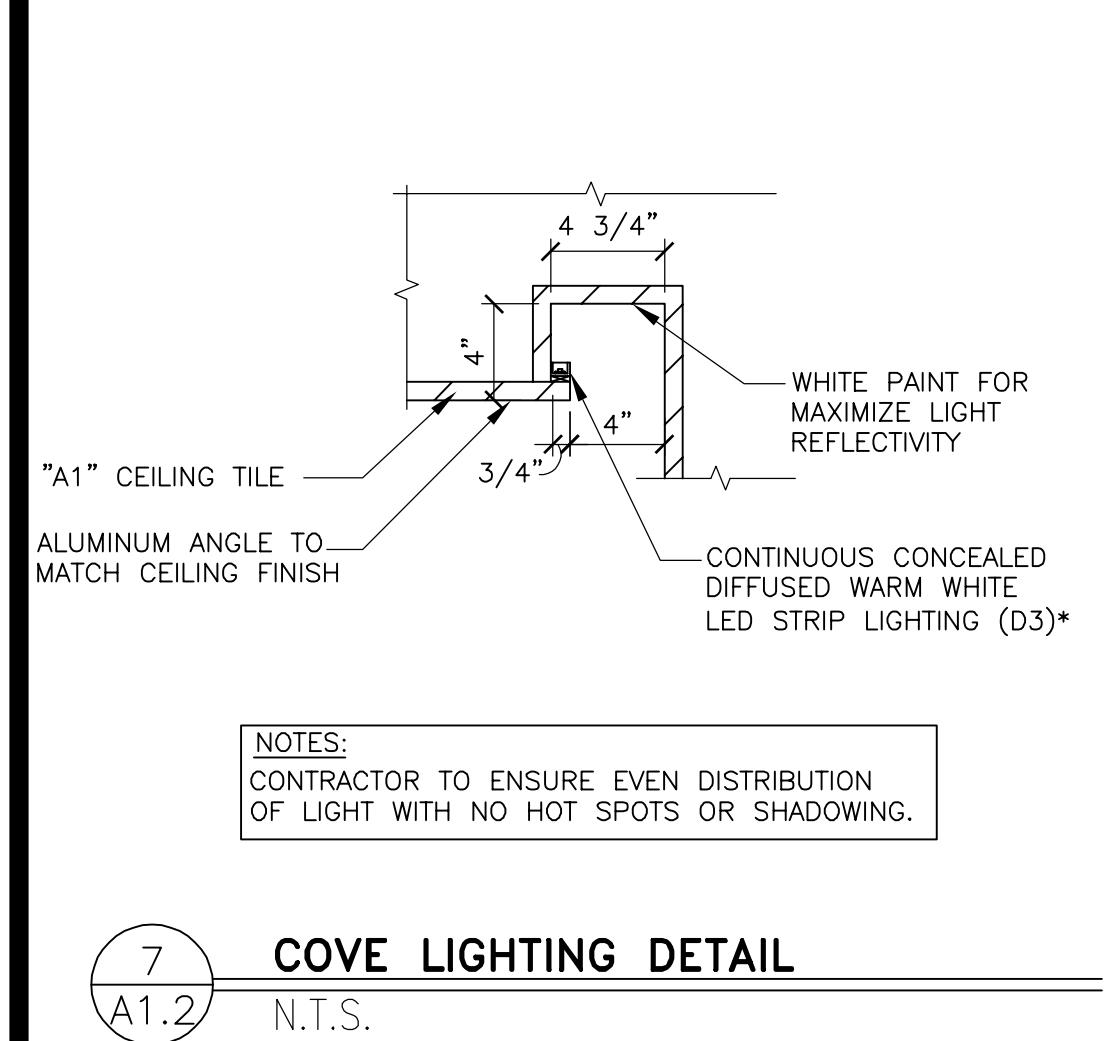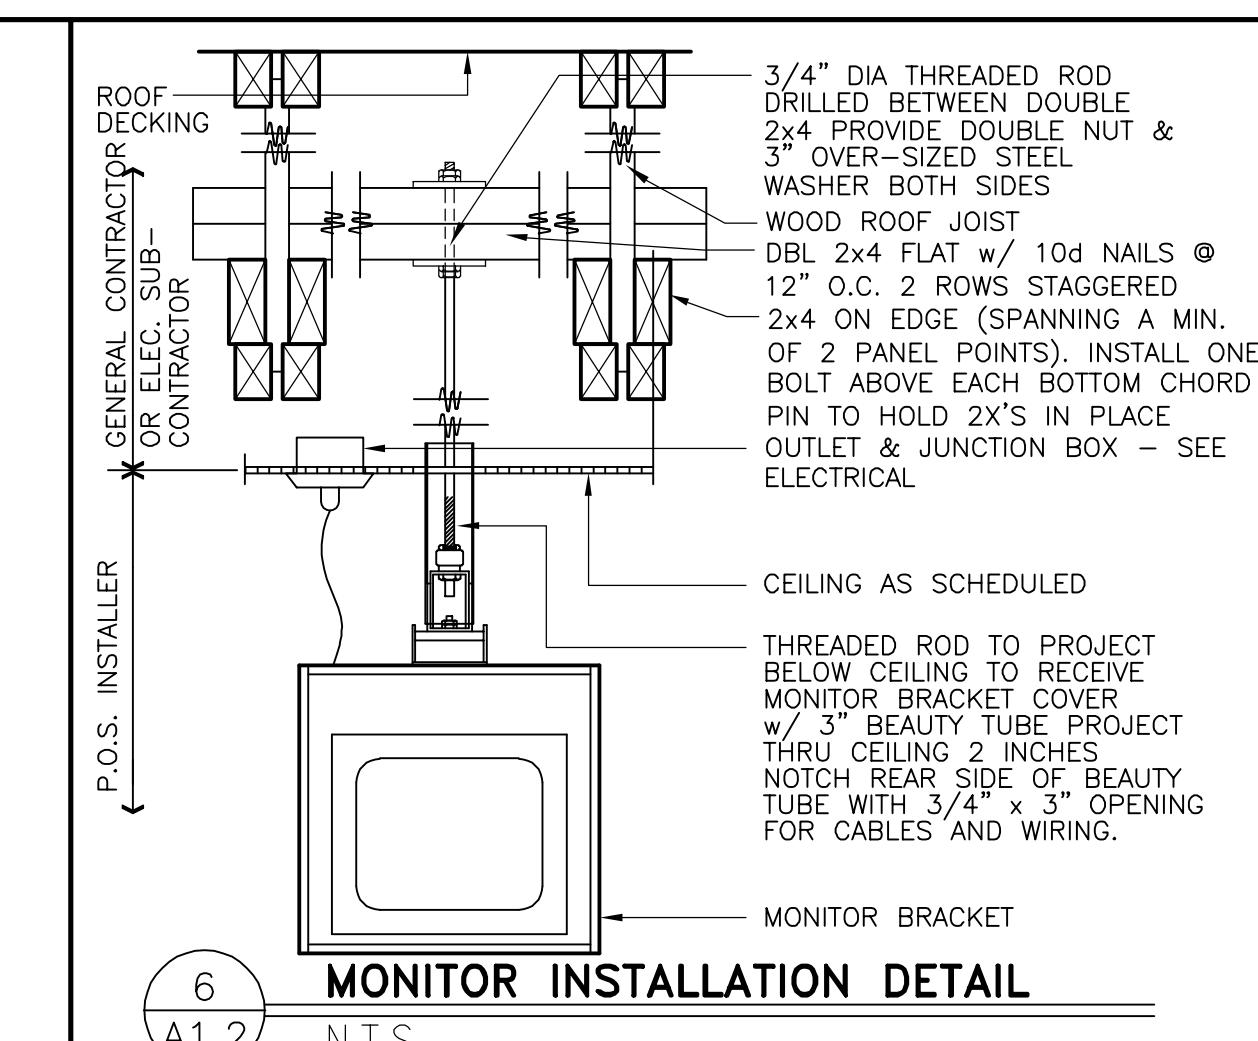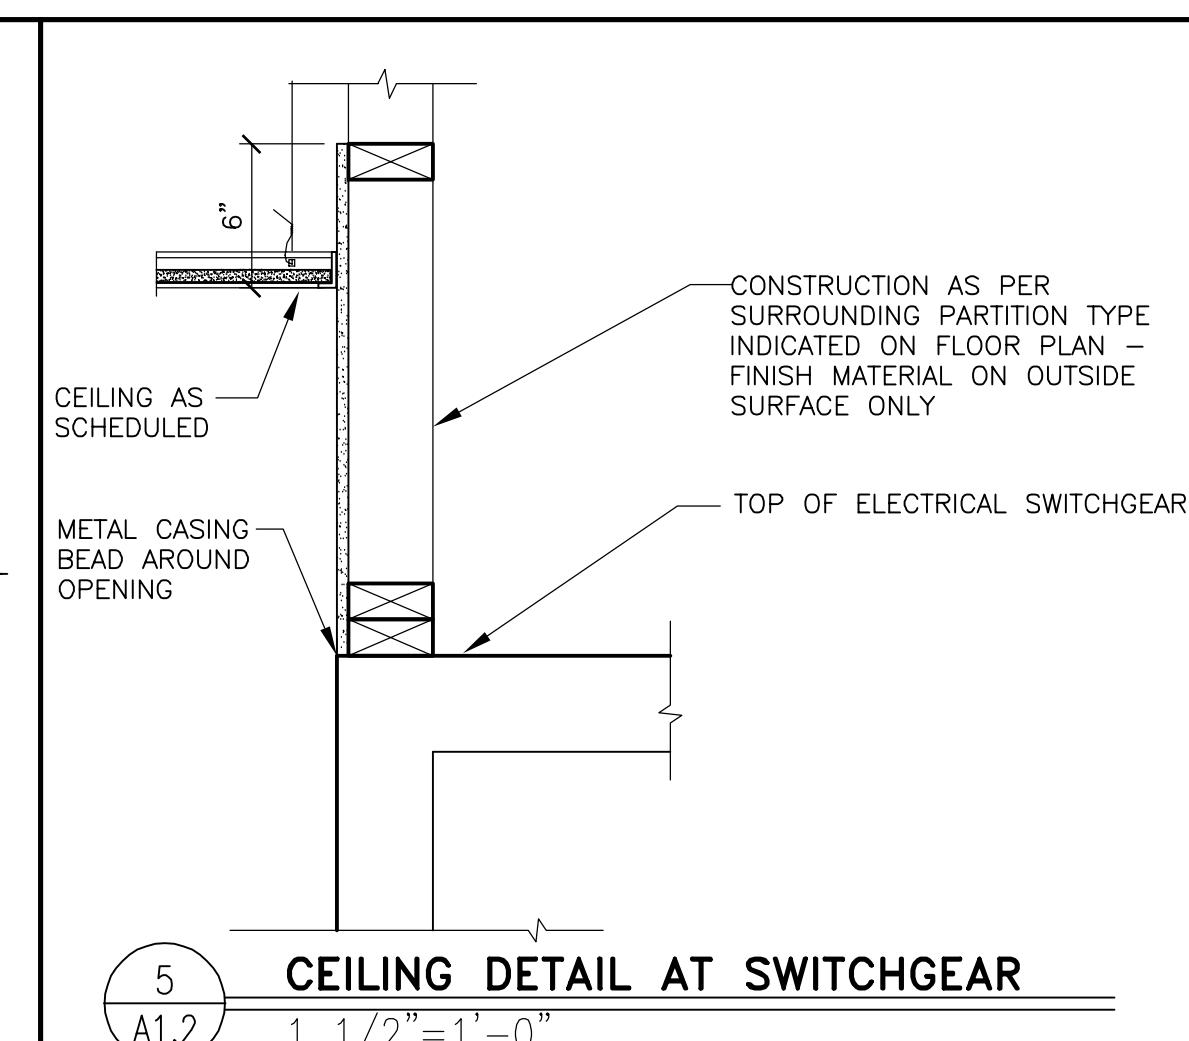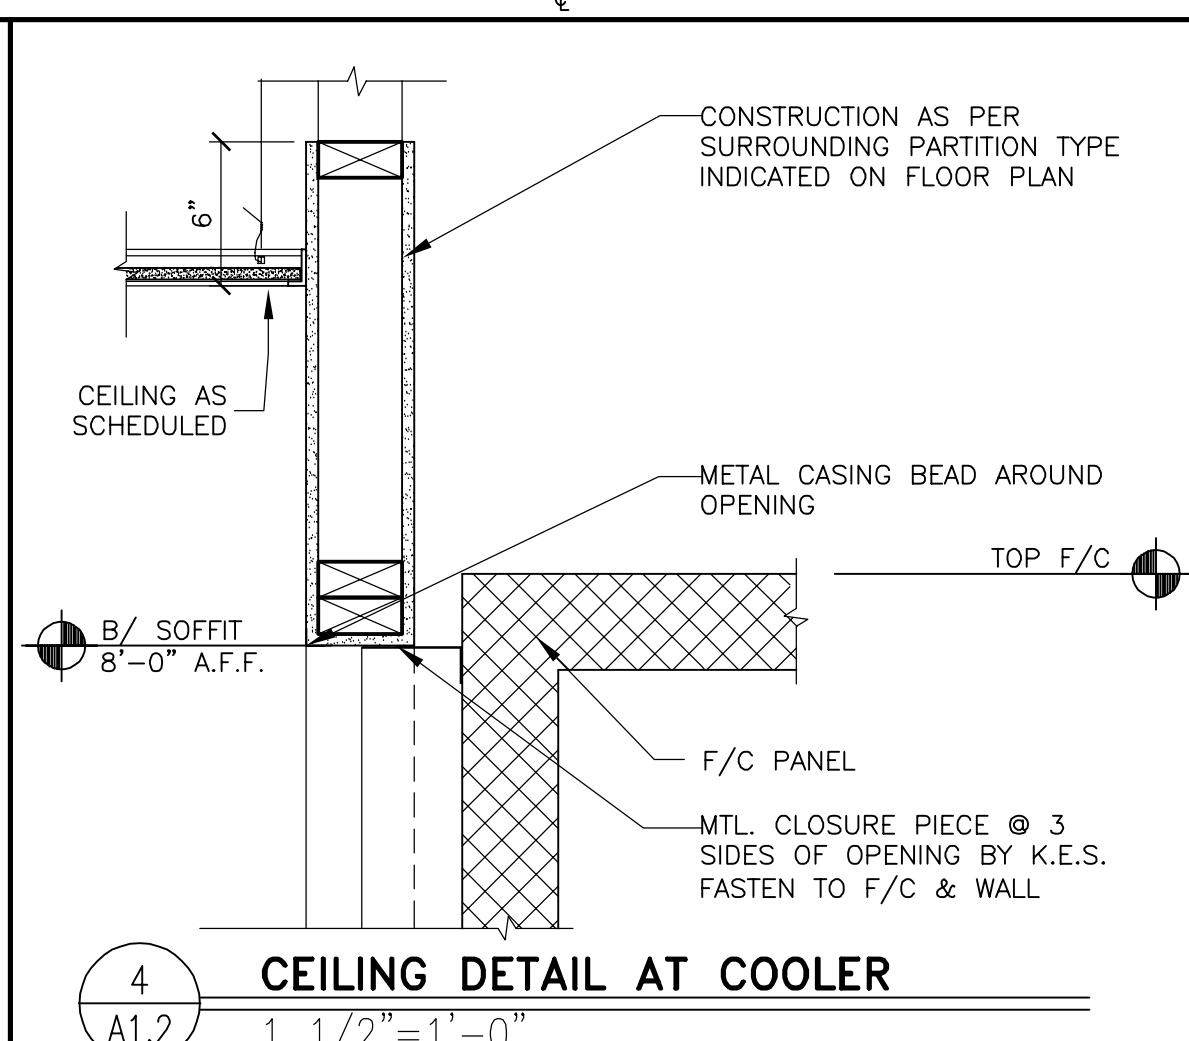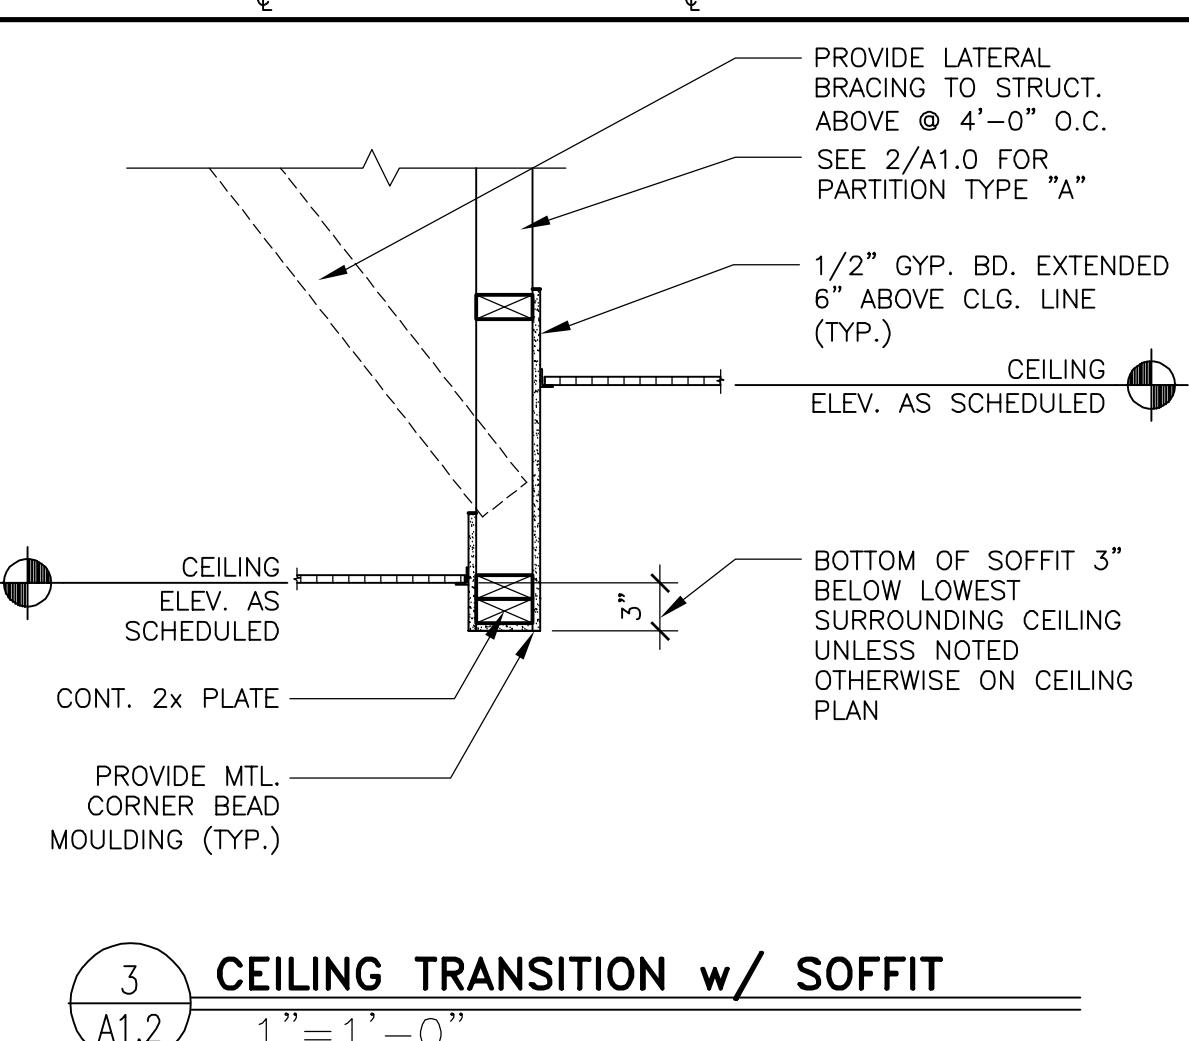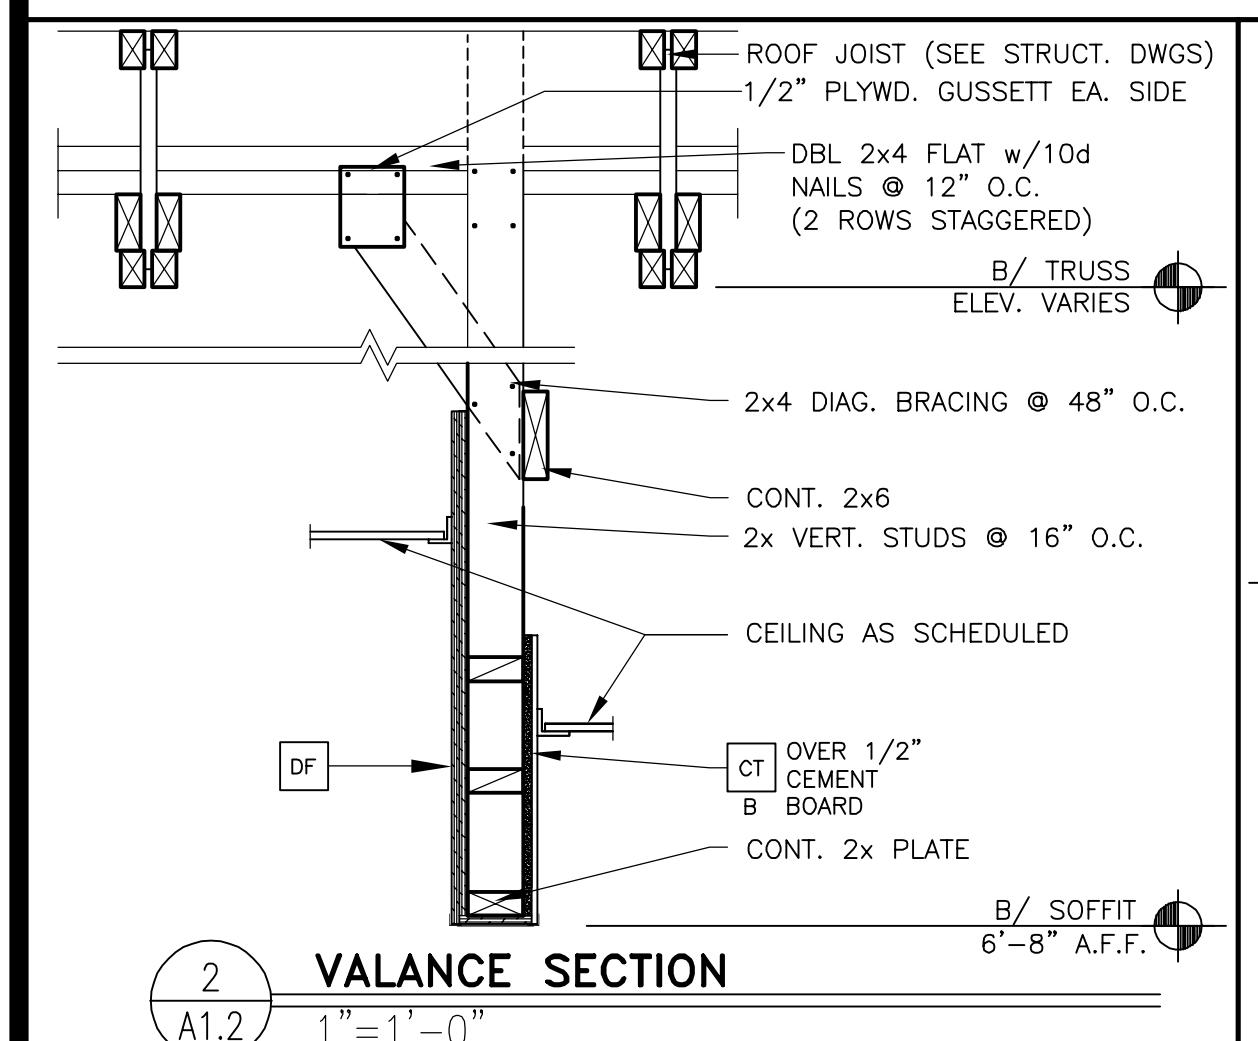

PREPARED BY:	JAW Architects, Inc. James Williams, Architect
@ A023 McDonald's USA, LLC	These drawings and specifications are the confidential and proprietary property of McDonald's USA, LLC and shall not be copied or reproduced without the written permission of McDonald's USA, LLC. The contractor shall not copy or reproduce these drawings and specifications, in whole or in part, for another project or for use on a different site or at a later time. Use of these drawings for reference or example on another project requires the services of properly licensed architects and engineers. Reproduction of the contract documents for other projects is not authorized.
DRAWN BY:	JAW
STD ISSUE DATE:	2023
REVIEWED BY:	JAW
DATE ISSUED:	03/08/24
SITE ADDRESS:	SEC OF S.H. LOOP 288 & HUMMINGBIRD LANE, DENTON, TEXAS
SHEET NO.	A1.2
TITLE:	2023 STANDARD BUILDING - BB20
DESCRIPTION:	WOOD BEARING WALLS W/4" BRICK VENEER WOOD ROOF TRUSS FRAMING STUCCO/BATEN/BRICK/METAL PANEL EXTERIOR FINISHES
SITE ID:	042-3271
BY:	JAWA 24-0014

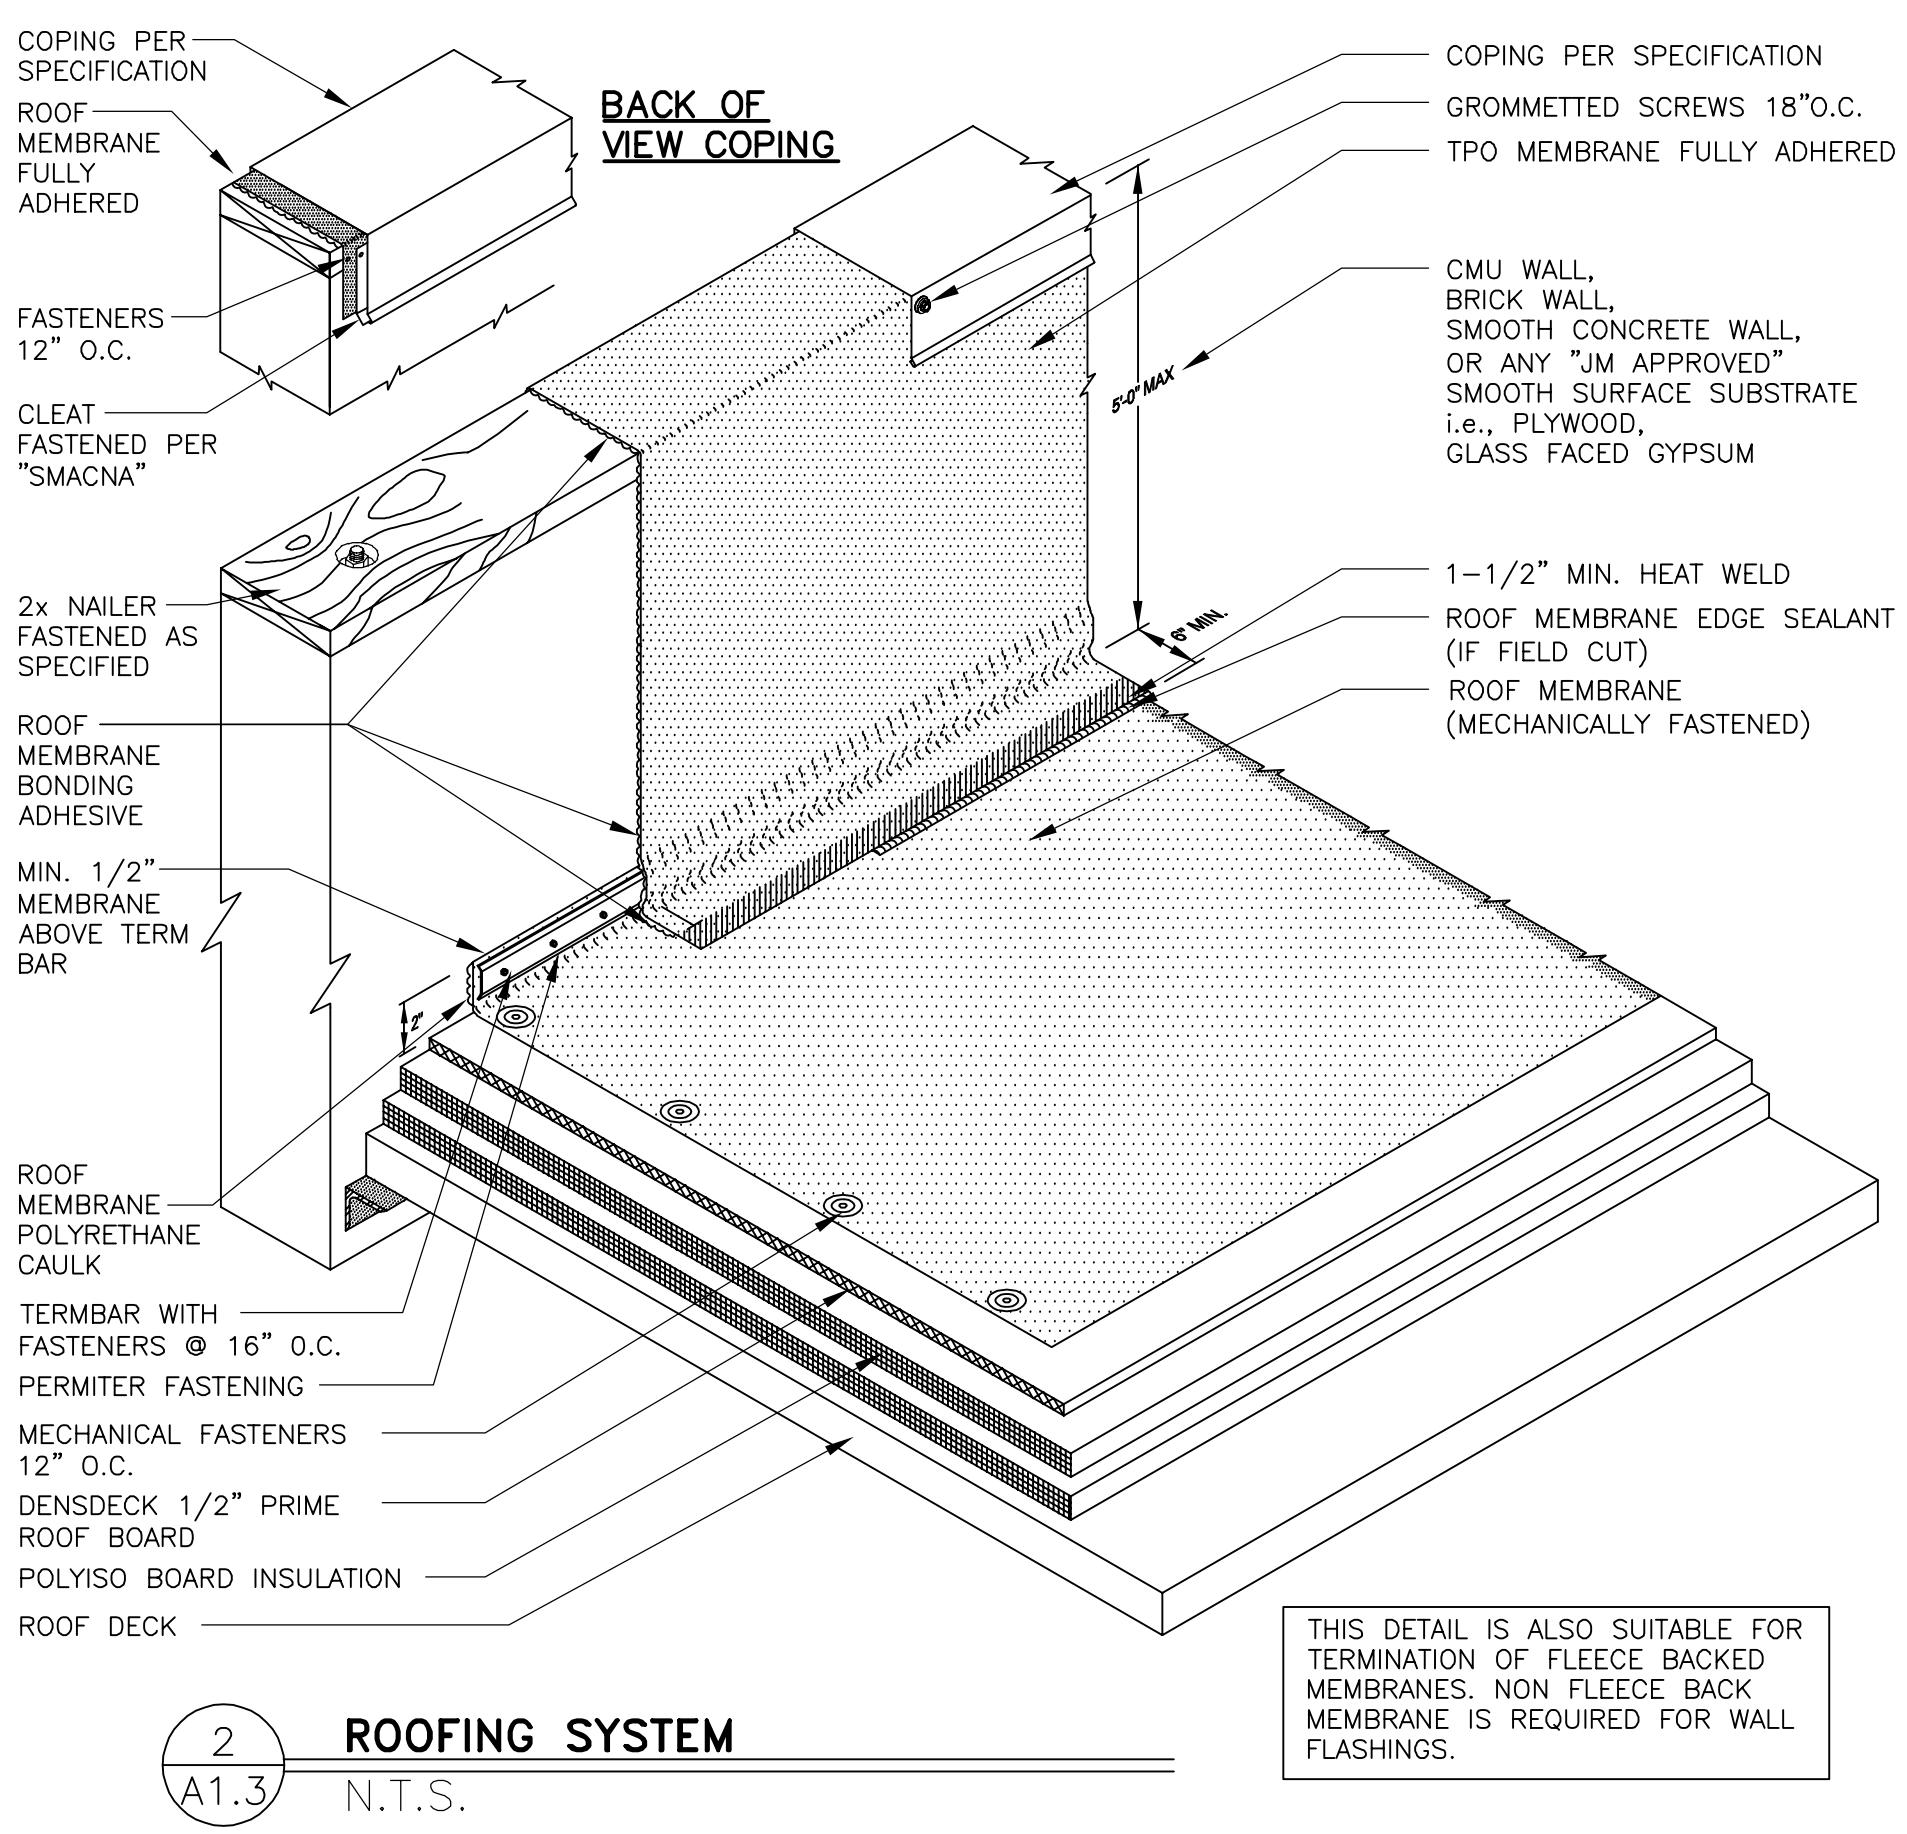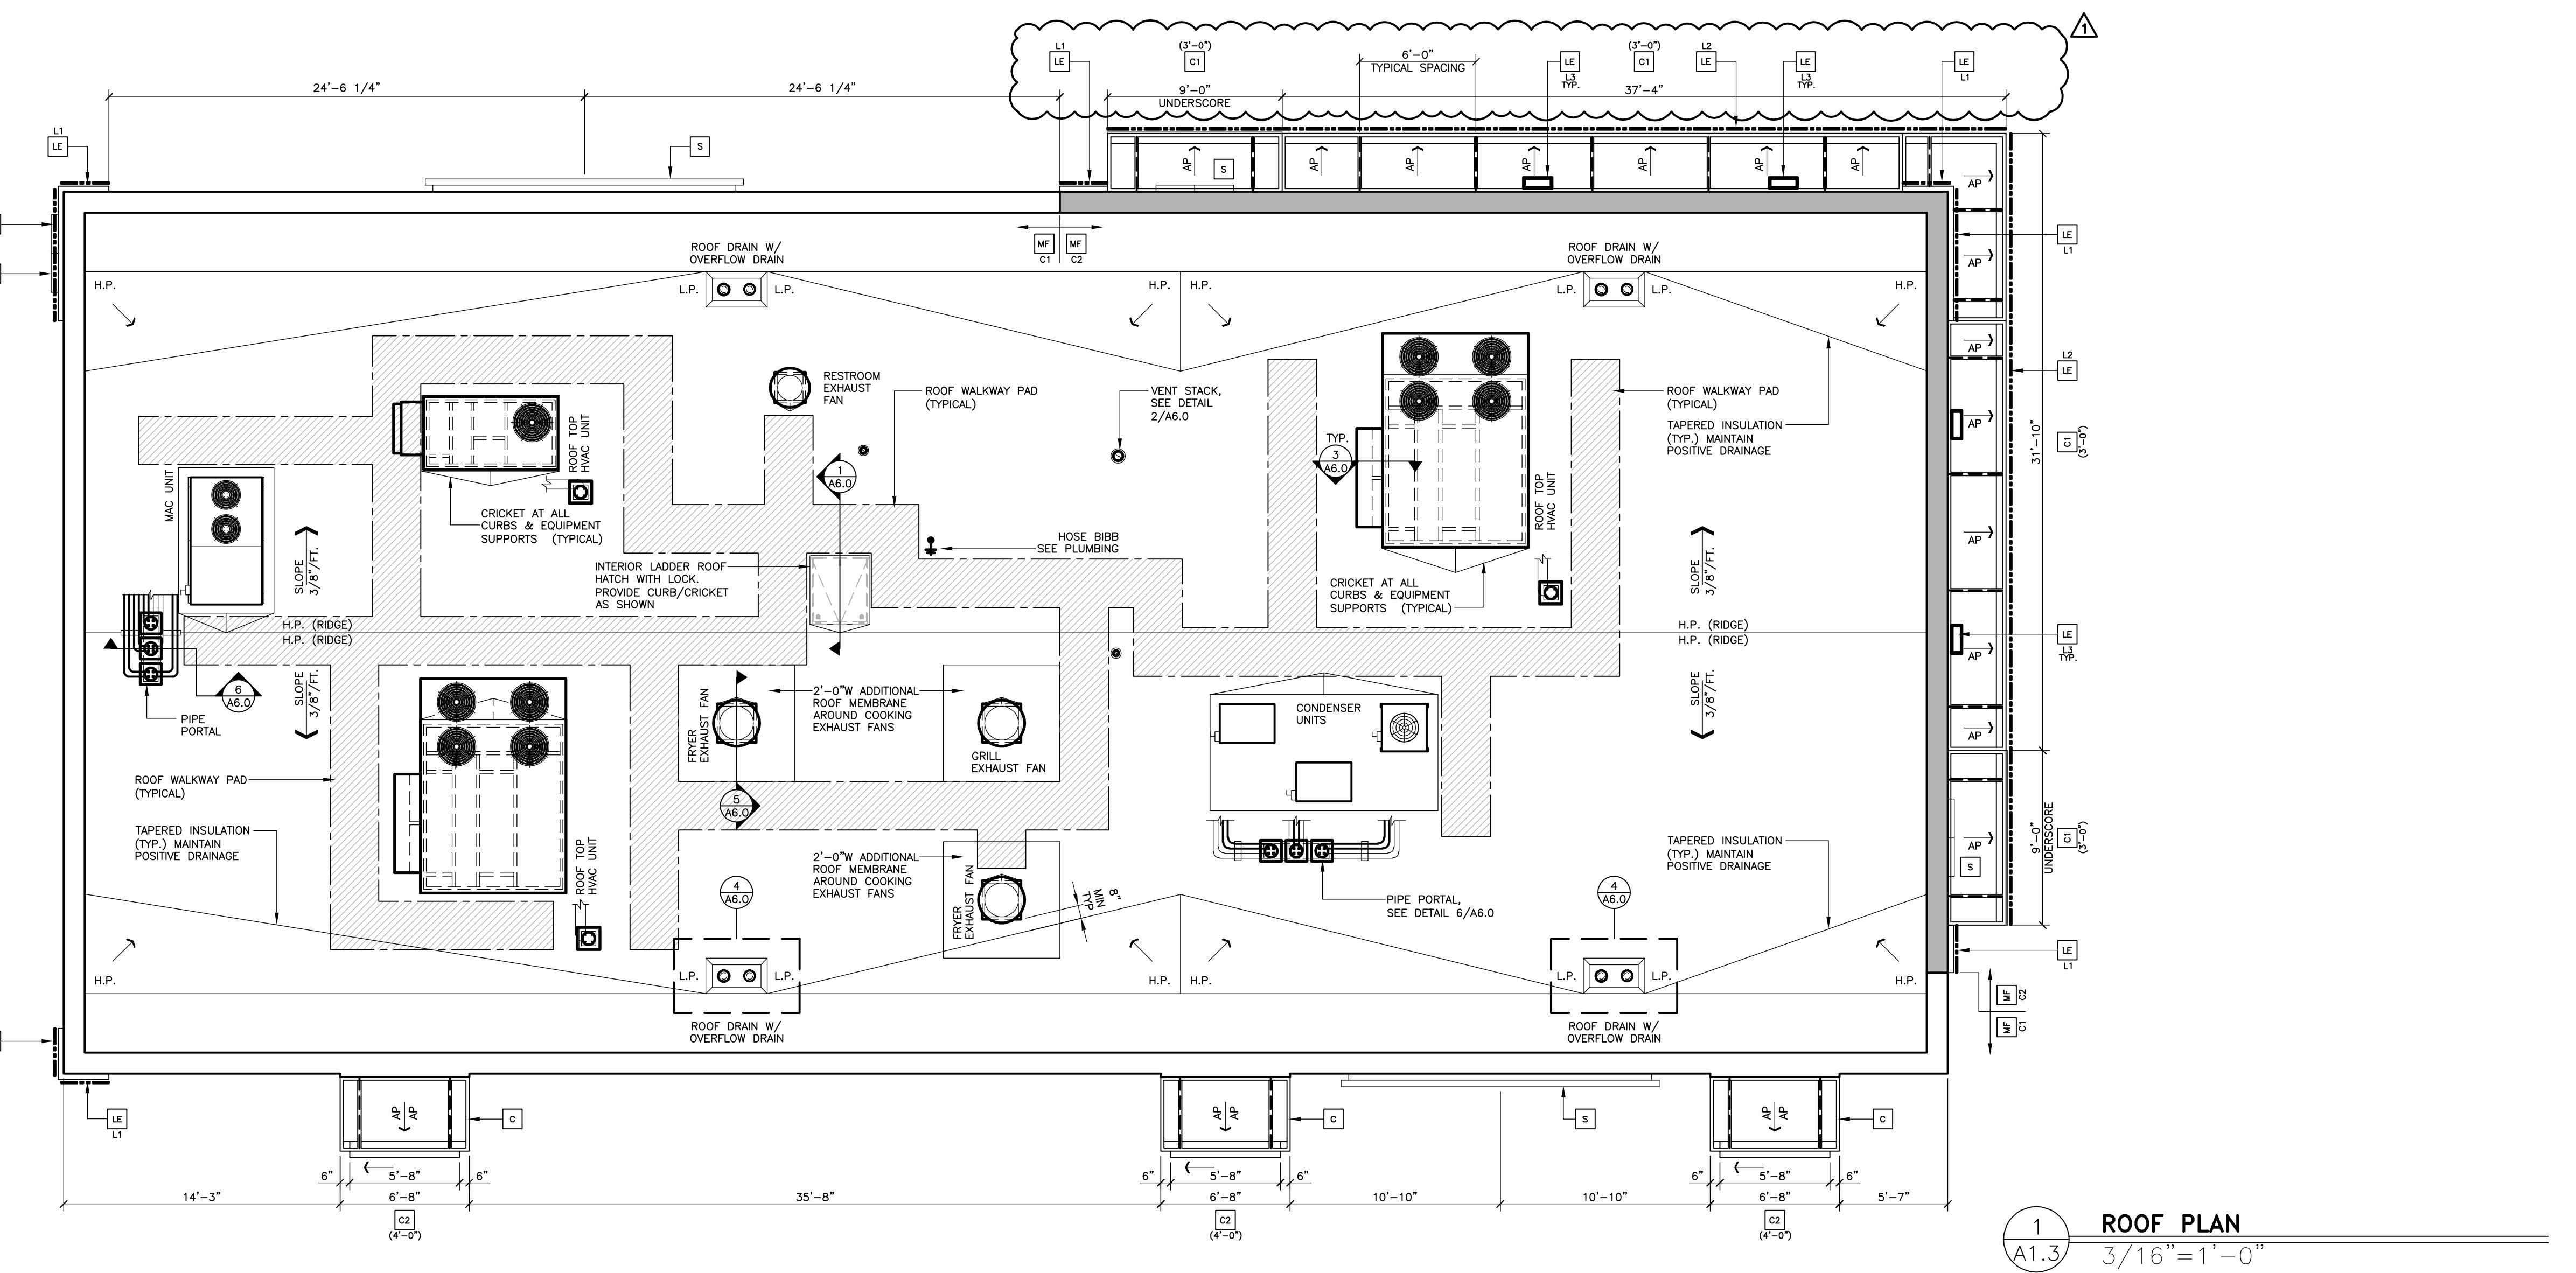

- ROOFING SYSTEM**
- MANUFACTURERS AND PRODUCTS:
 - DURO-LAST PVC ROOFING SYSTEM
 - JM-PVC REFER TO JOHNS MANVILLE WEBSITE (www.jm.com) FOR MOST UP-TO-DATE INFORMATION.
NO SUBSTITUTIONS ALLOWED
 - SPECIFIED ROOFING SYSTEMS (AS SHOWN):

HEAT-WELDABLE SINGLE-PLY 50 MIL PVC ROOFING SYSTEM, INSTALLED OVER RIGID INSULATION ON WOOD ROOF DECK HAVING A SLOPE OF 3/8"/FT. MATERIALS SHALL BE AS FOLLOWS:

 - SINGLE-PLY ROOFING SYSTEM AS MANUFACTURED BY MANUFACTURER LISTED ABOVE TO COMPLY WITH ASTM E 108 OR UL 790, ASTM D-6878, AND FMG I-90 FOR WIND UPLIFT.
 - FASTENERS: METAL FASTENERS AND PLATES AS PER MANUFACTURER.
 - ACCESSORIES: PRE-FABRICATED CURBS, FLASHING, CORNERS, TERMINATION BARS, PIPE FLASHING, VENT FLASHING ETC. AS PER MANUFACTURER.
 - PLEASE SEE SINGLE-PLY FLASHING SPECIFICATIONS FOR A FULL DESCRIPTION OF INSTALLATION INSTRUCTIONS AND REQUIREMENTS WHICH ARE CONSIDERED A PART OF THIS DETAIL.
 - ANY CARPENTRY OR METAL WORK SHOULD BE DESIGNED AND CONSTRUCTED IN ACCORDANCE WITH LOCAL CODE REQUIREMENTS AND/OR PROJECT SPECIFICATIONS. THESE COMPONENTS SHOULD BE REVIEWED AND APPROVED BY A LICENSED DESIGN PROFESSIONAL. CONTACT MANUFACTURER FOR METAL OPTIONS TO BE INCLUDED WITHIN THE MANUFACTURER'S GUARANTEE.
 - ROOF MEMBRANE EDGE SEALANT IS REQUIRED ON ALL CUT OR NON-ENCAPSULATED EDGES OF REINFORCED MEMBRANE. THIS INCLUDES FACTORY CUT MEMBRANE.
 - WALKWAYS:
 - 30" WIDE WALKWAY ROLL, HOT AIR WELDED TO MEMBRANE.
 - PROVIDE WALKWAY FROM ROOF LADDER EXIT TO ALL ROOF TOP EQUIPMENT AS PER ROOF PLAN ABOVE.
 - INSTALL WALKWAY ACCORDING TO WALKWAY PAD MANUFACTURER'S WRITTEN INSTRUCTION.
 - RIGID INSULATION:


PROVIDE REQUIRED LAYERS OF POLYISOCYANURATE INSULATION W/ 1/2" "DENDECK" COVER BOARD TO MEET A MINIMUM CONTINUOUS R-30 VALUE — THICKNESS AS REQUIRED. PROVIDE POSITIVE SLOPE TO ALL ROOF DRAINS. SEE ROOF PLAN. PROVIDE TOP LAYER PROTECTION MATERIAL AS PER MANUFACTURER'S RECOMMENDATIONS. BOTTOM LAYER OF INSULATION TO HAVE INTEGRAL THERMAL BARRIER OR APPROVED ROOFING MANUFACTURER'S THERMAL UNDERLAYMENT SHEET. ASSEMBLY SHALL COMPLY WITH UL 1256 OR FMG 4450 AND ASTM C 1289, TYPE I OR II.
 - TAPERED INSULATION:


PROVIDE TAPERED INSULATION AS REQUIRED FOR POSITIVE DRAINAGE TO ROOF DRAINS AS INDICATED PER ROOF PLAN ABOVE. $\frac{1}{4}$ " PER FOOT MIN. REQUIRED.
 - EXHAUST FANS:

















PROVIDE ADDITIONAL LAYER OF ROOF MEMBRANE AROUND EXHAUST FANS AS INDICATED PER ROOF PLAN ABOVE.



SHEET NO.	TITLE	DRAWN BY	STD ISSUE DATE	REVIEWED BY	DATE ISSUED	BY
1 A1.3	2023 STANDARD BUILDING - BB20 4597-WOOD/WOOD	JAW	2023	JAW	03/08/24	JAW
	DESCRIPTION					
	WOOD BEARING WALLS W/4" BRICK VENEER					
	STUCCO/BATEN/BRICK/METAL PANEL EXTERIOR FINISHES					
	SITE ADDRESS					
	SEC OF S.H. LOOP 288 & HUMMINGBIRD LANE, DENTON, TEXAS					
	042-3271					

A1.3
ROOF PLAN

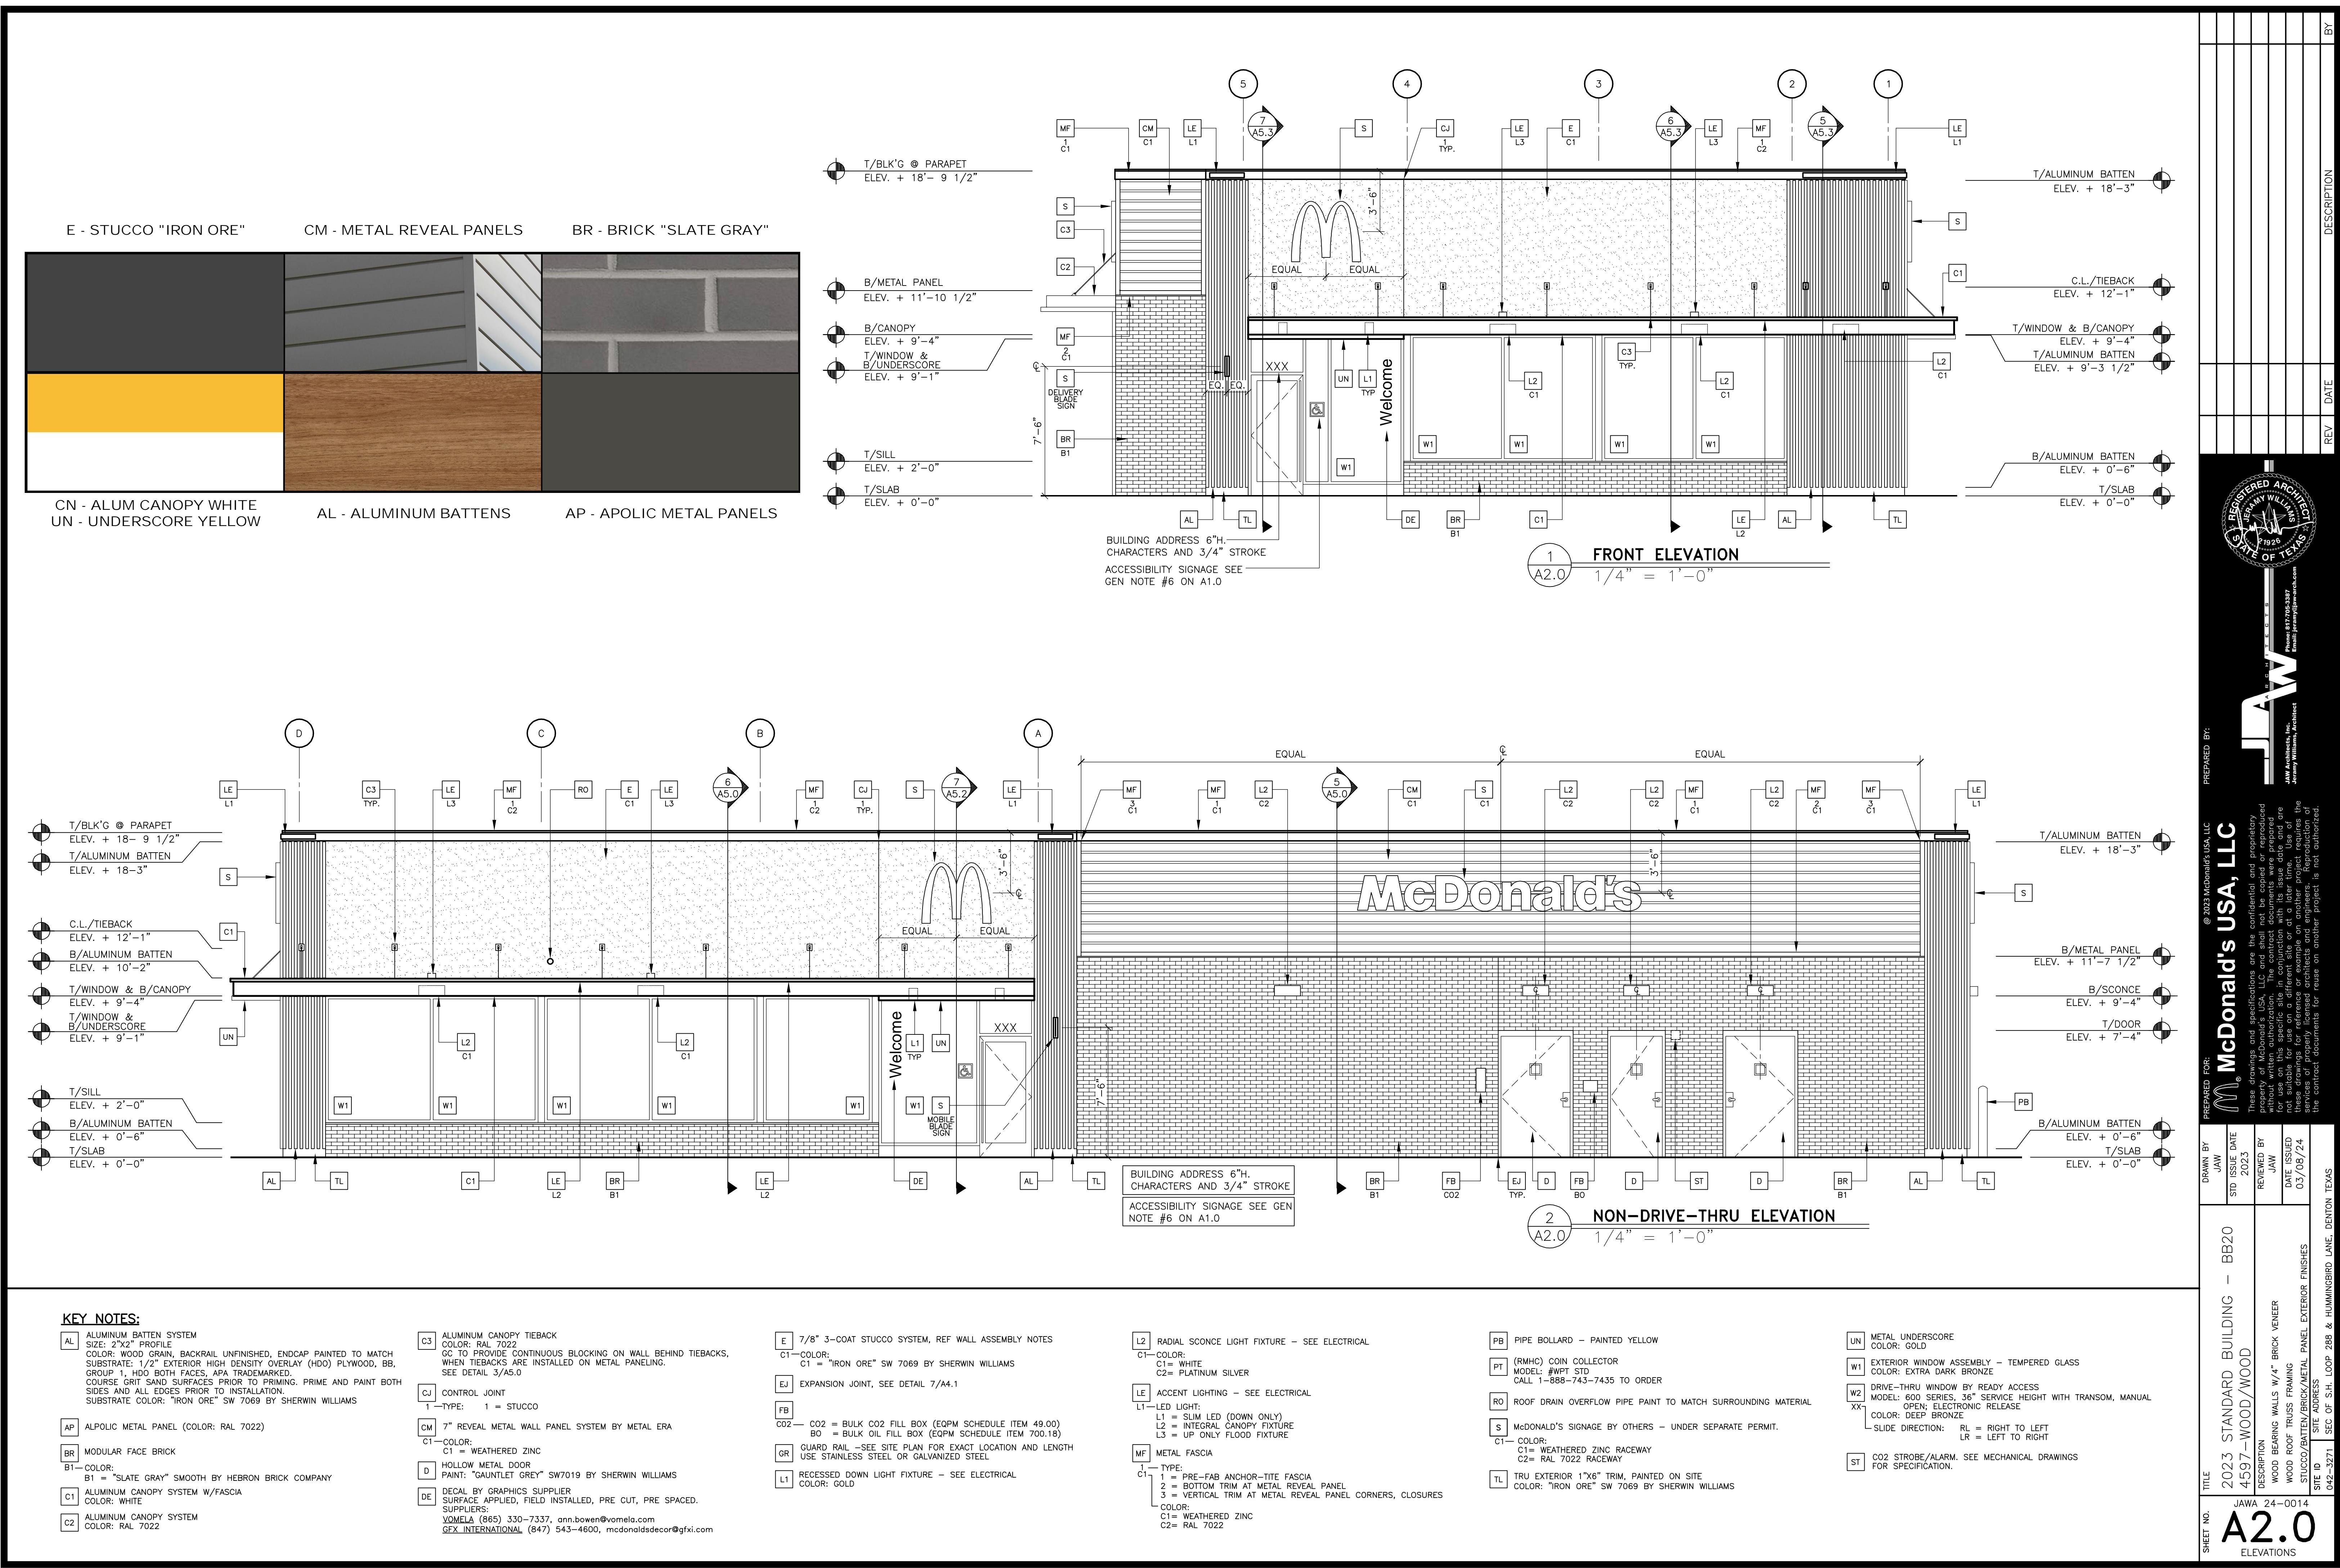


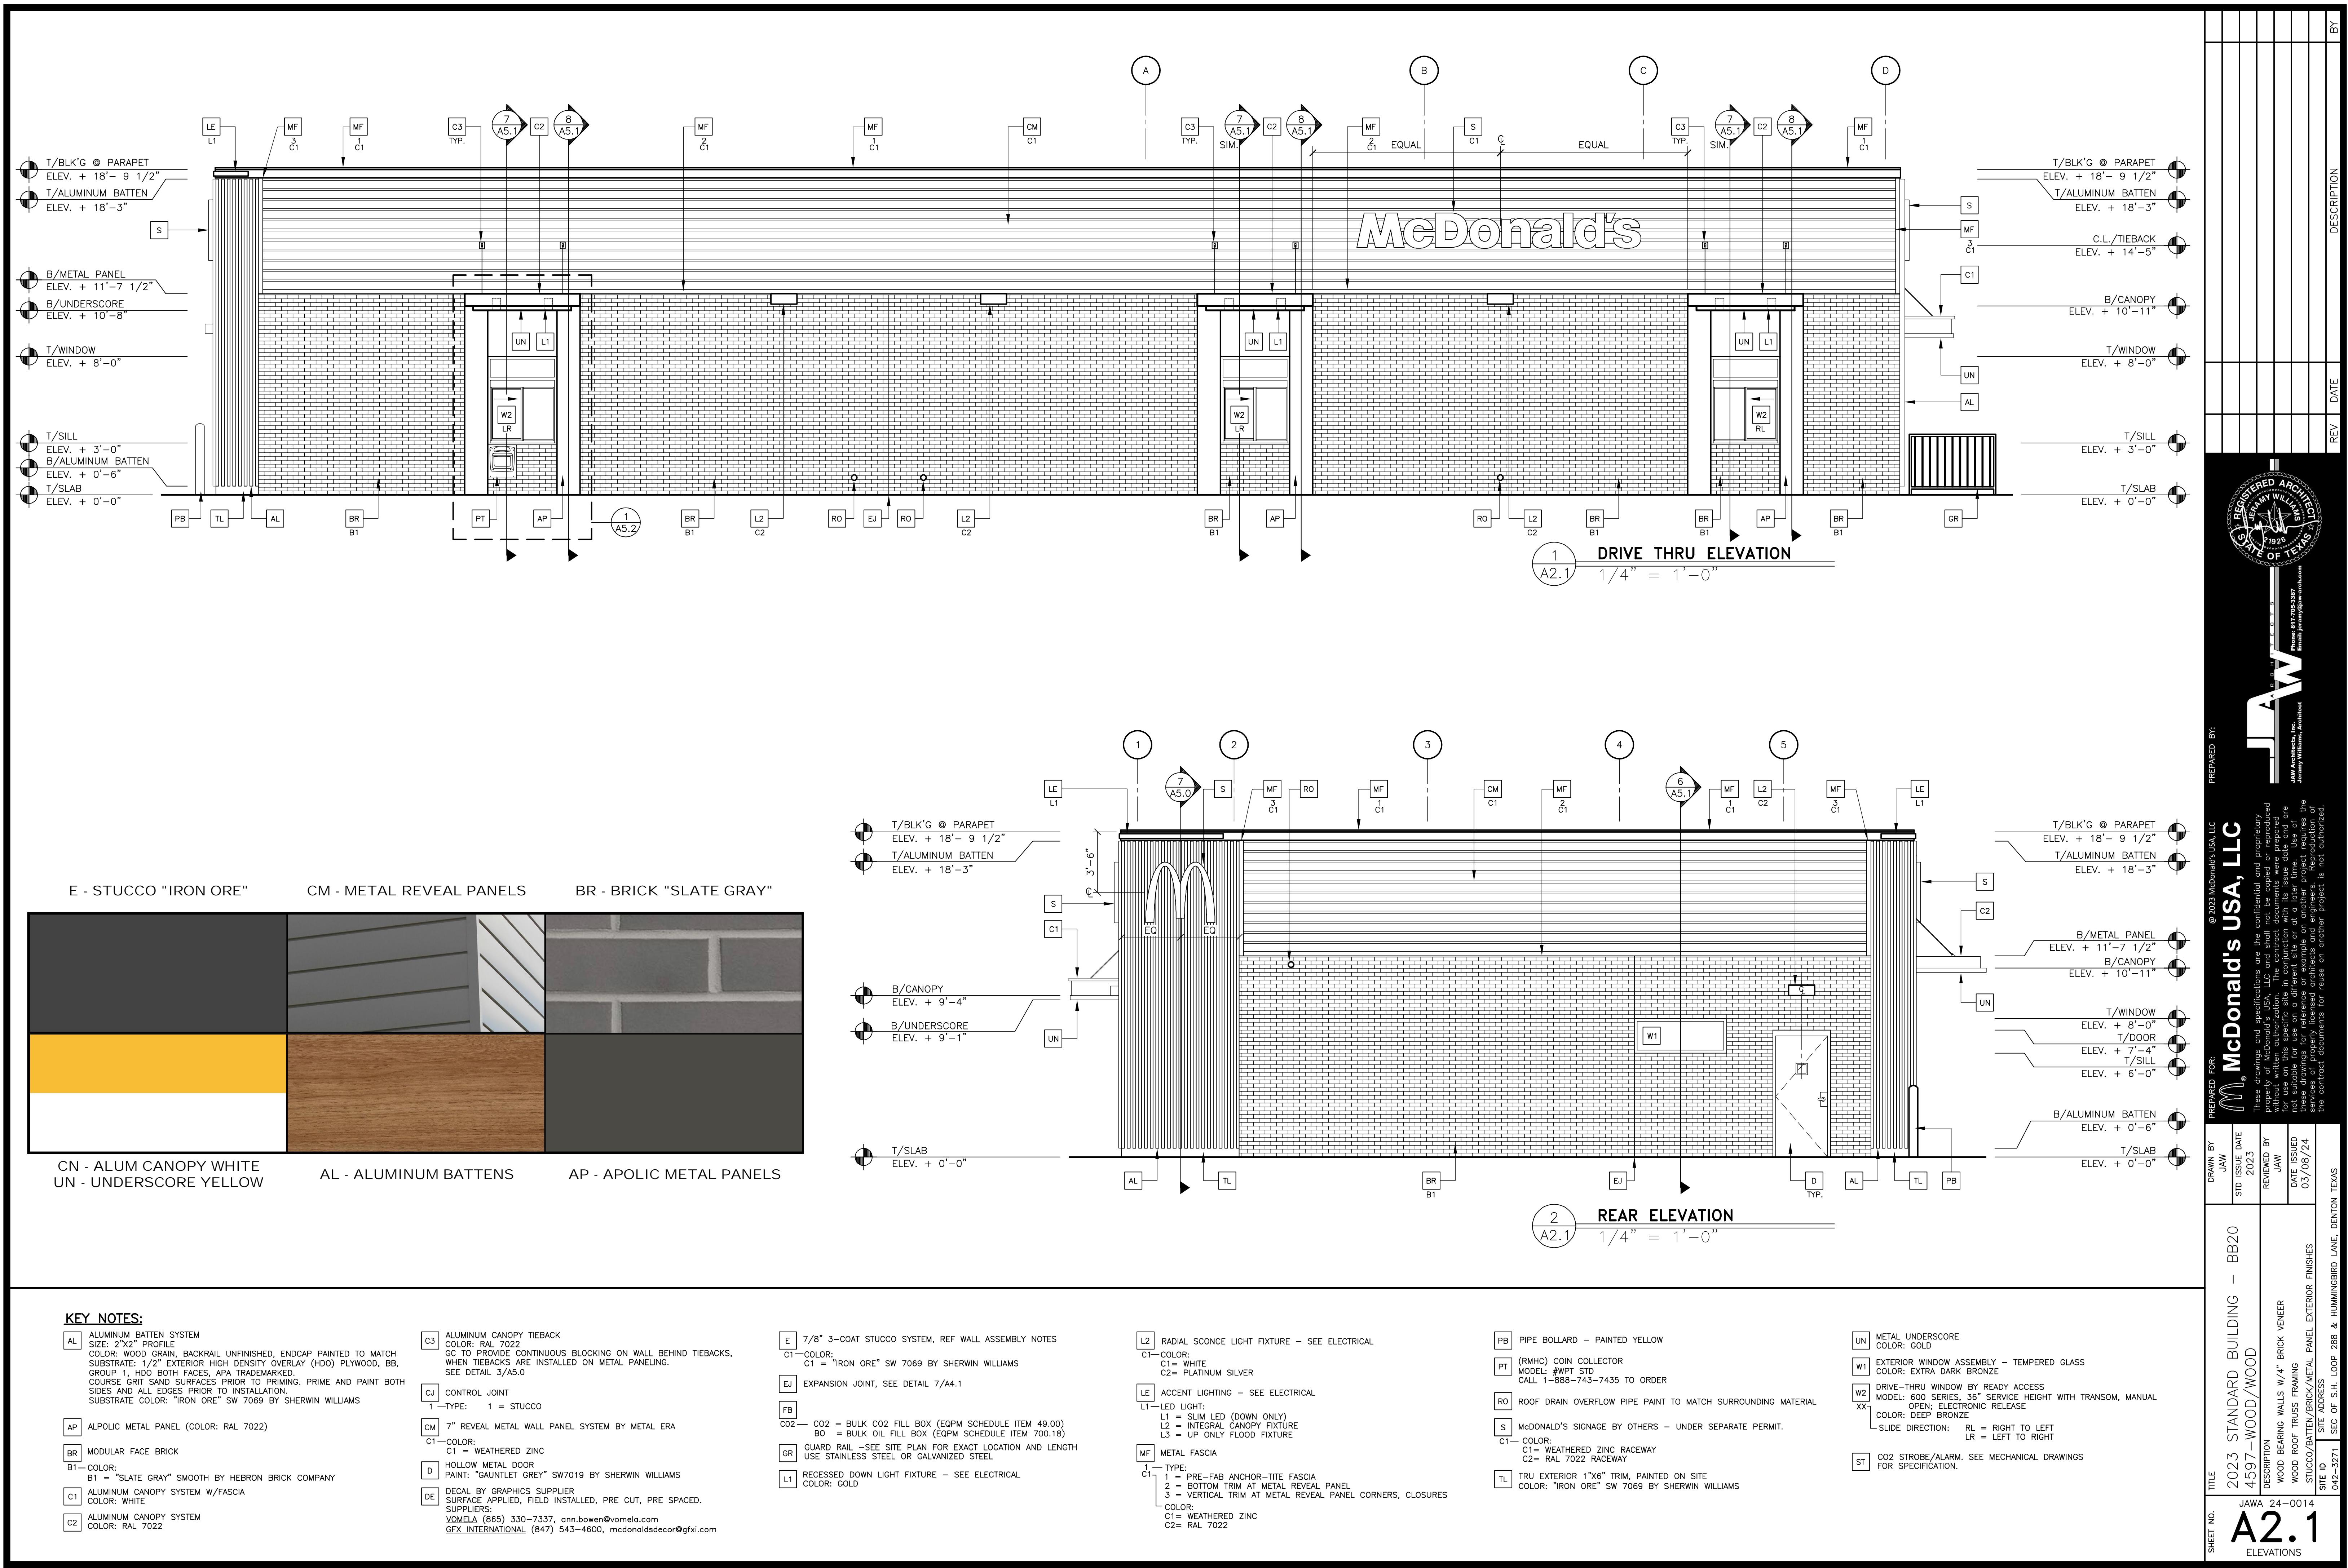

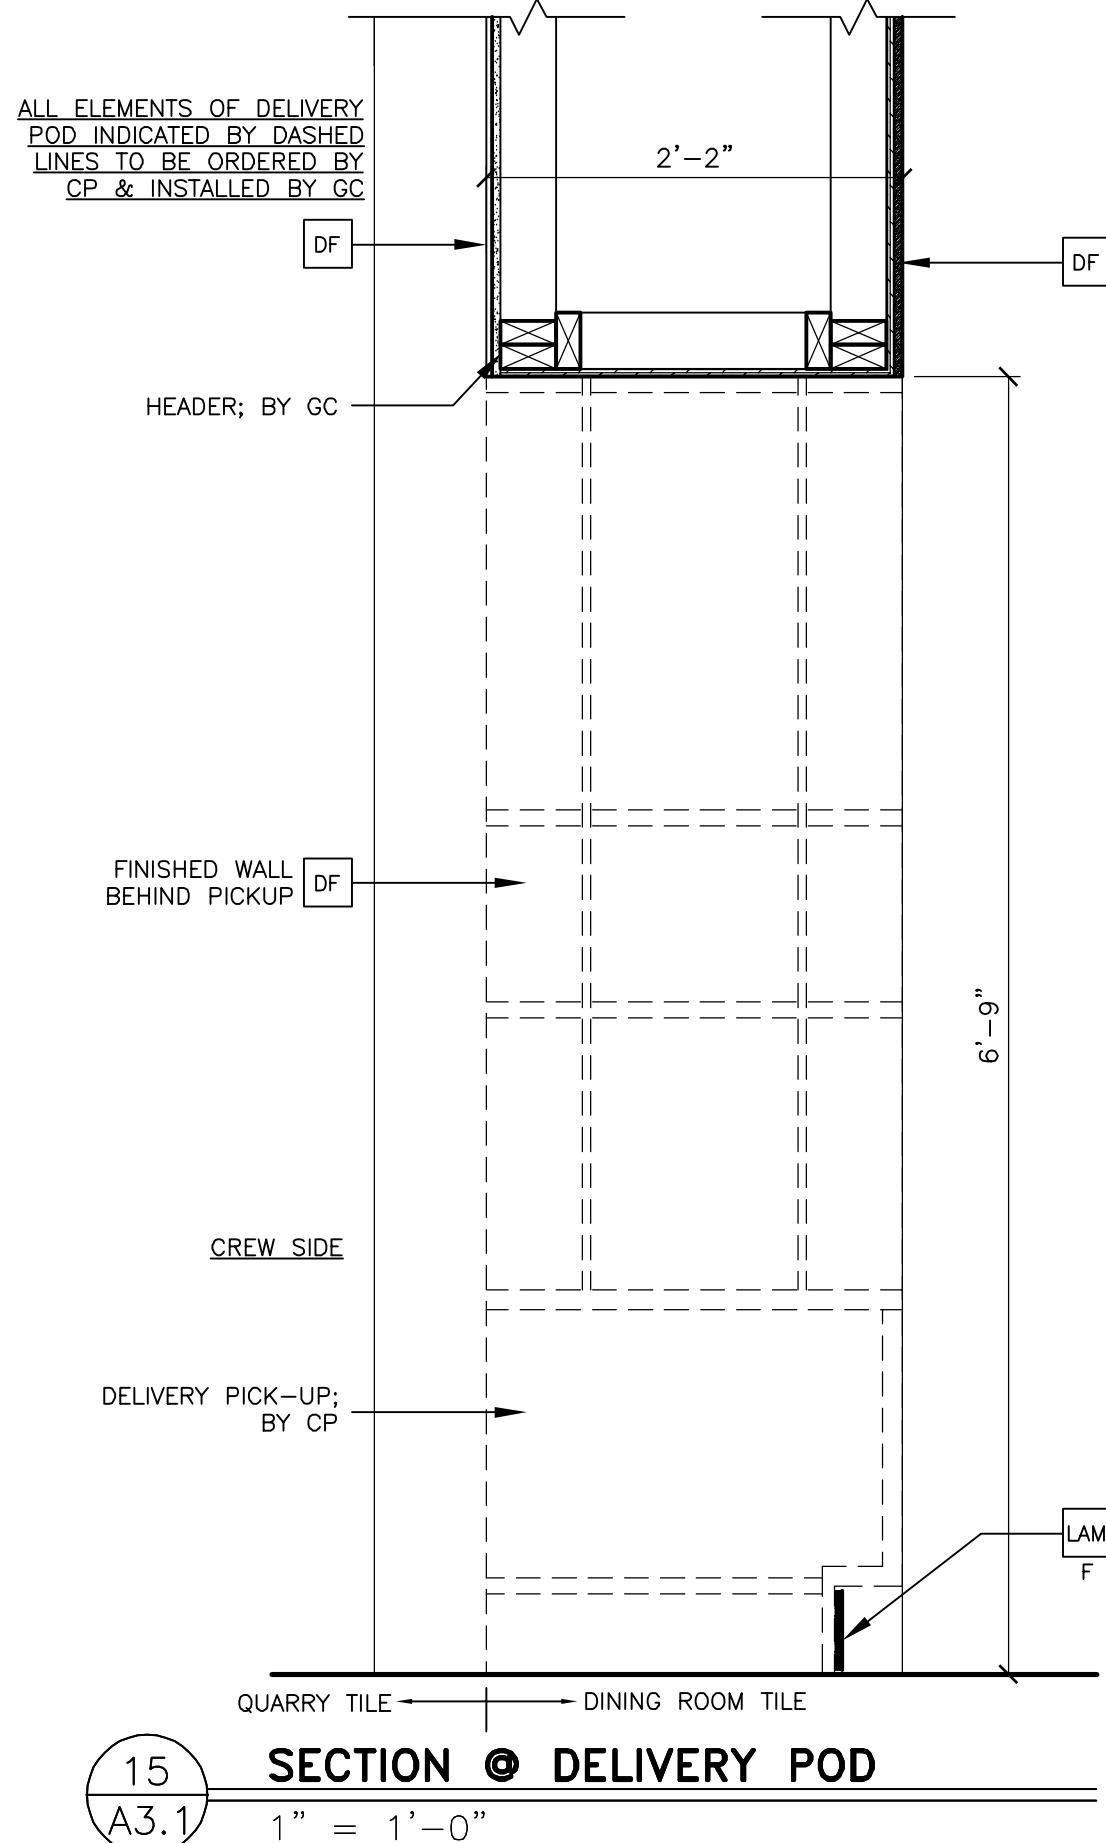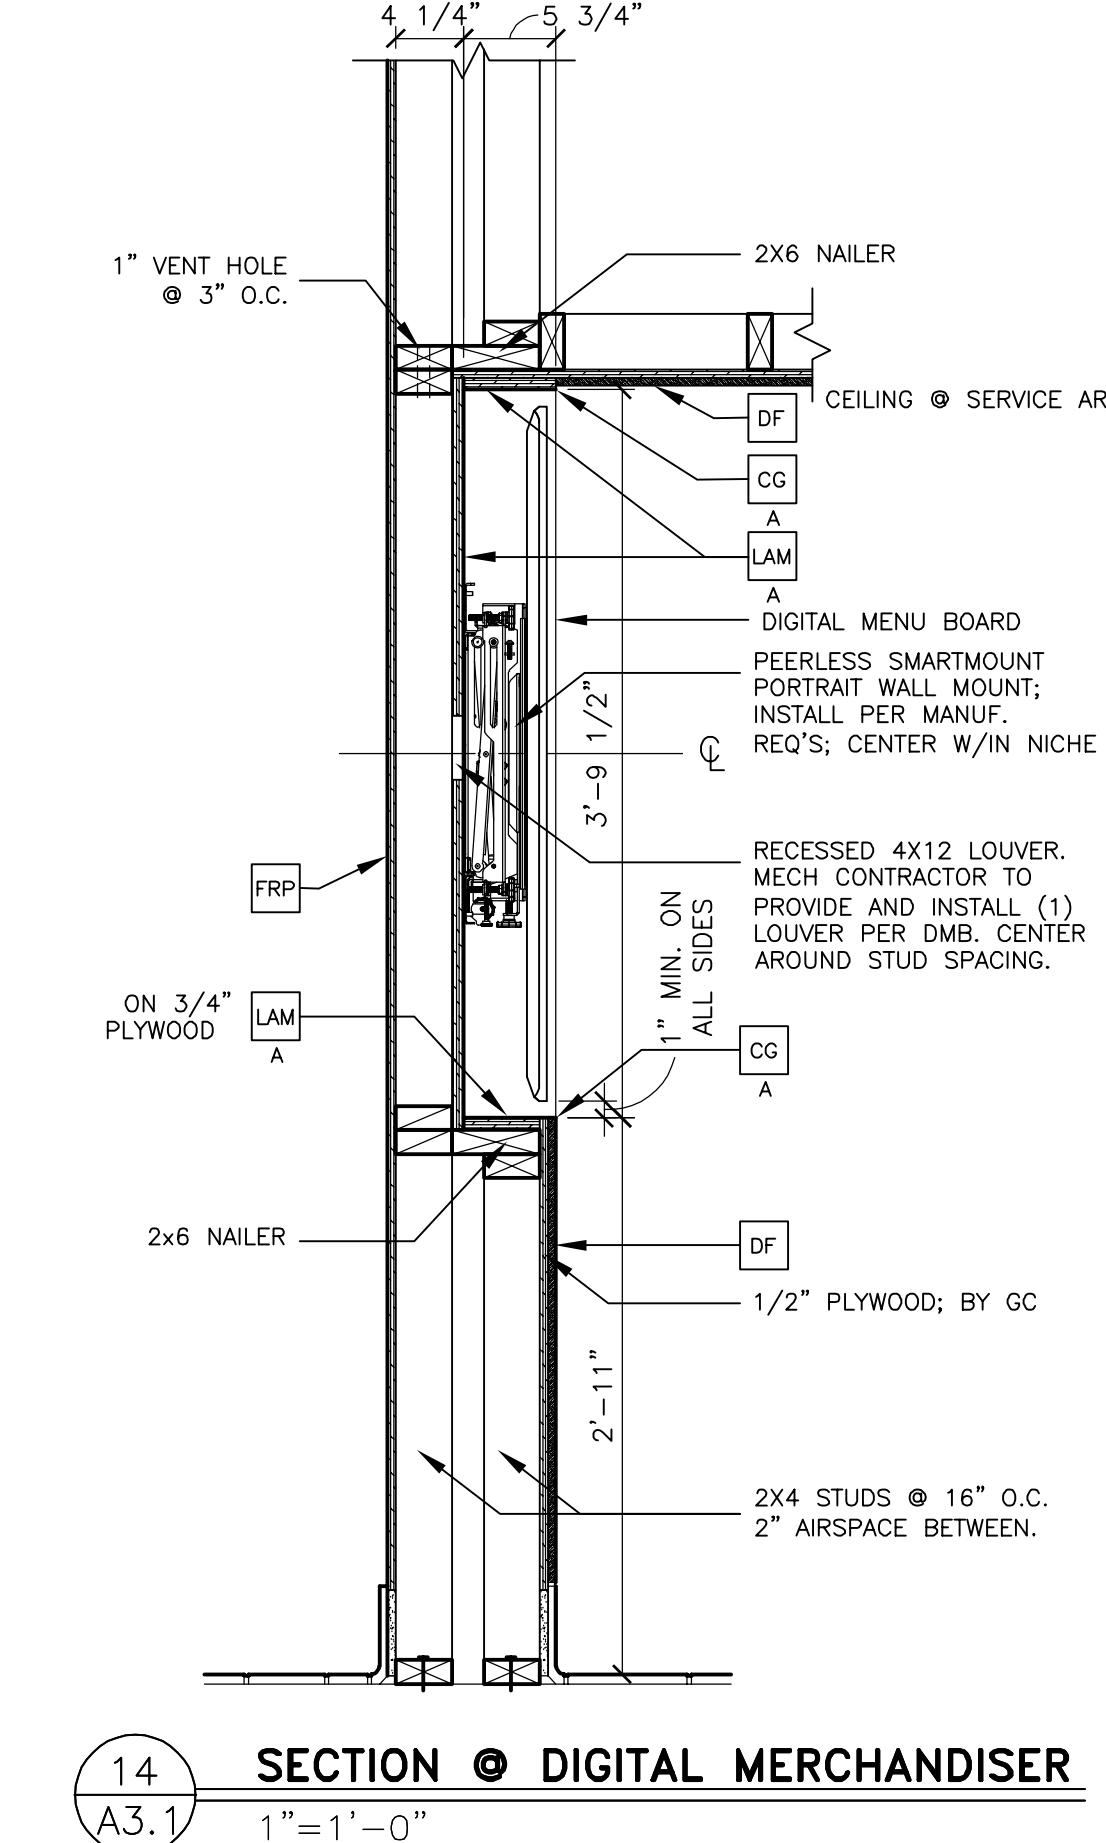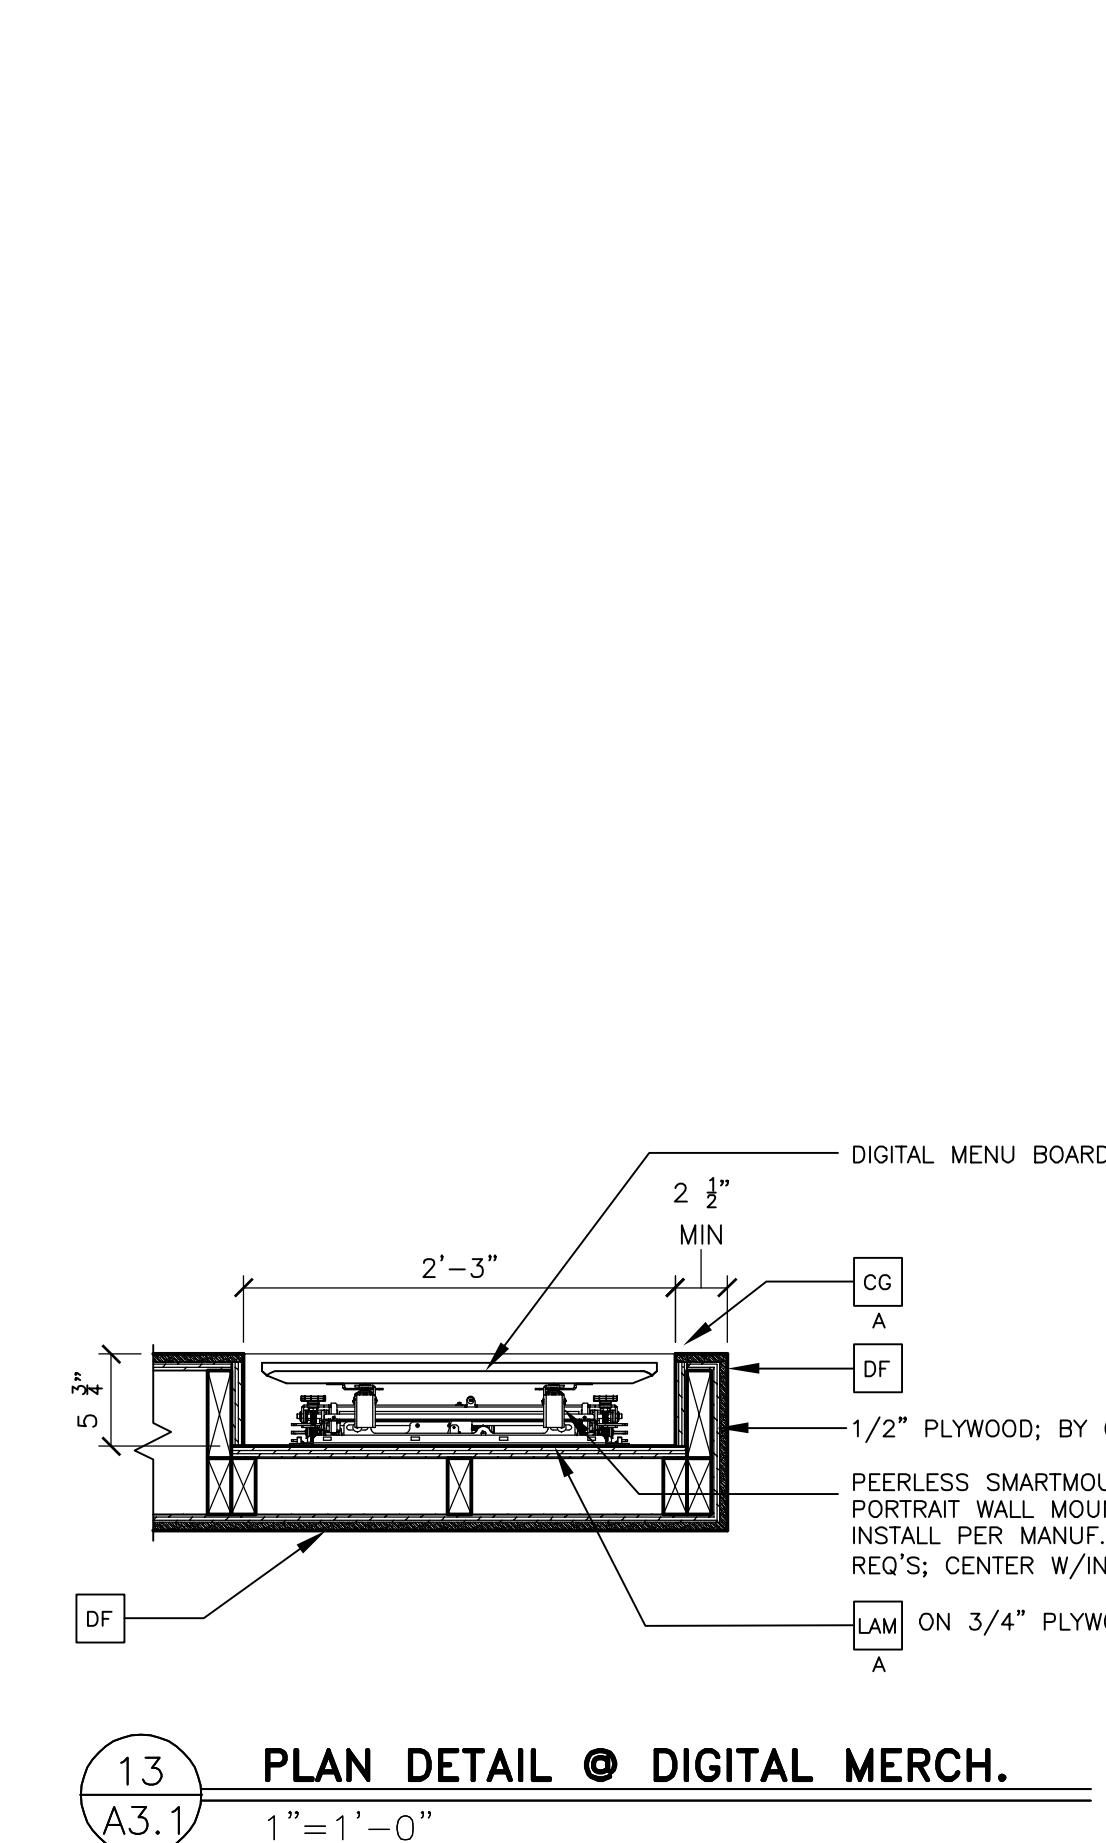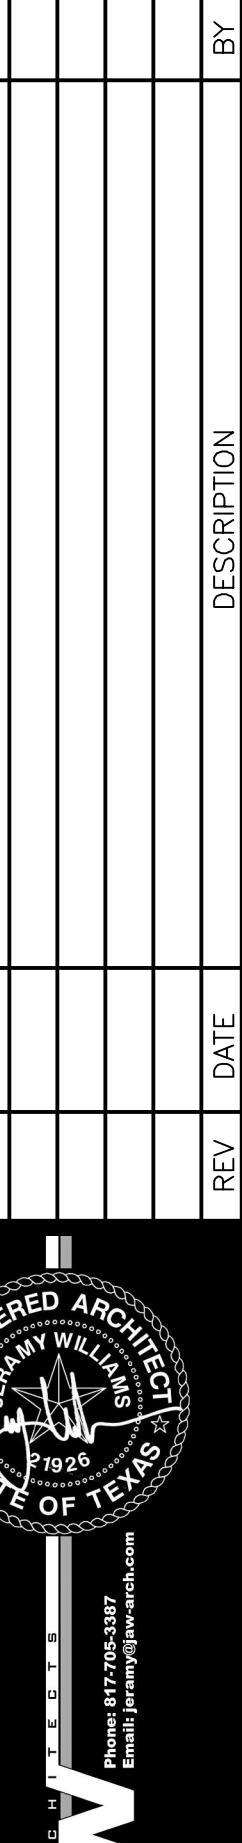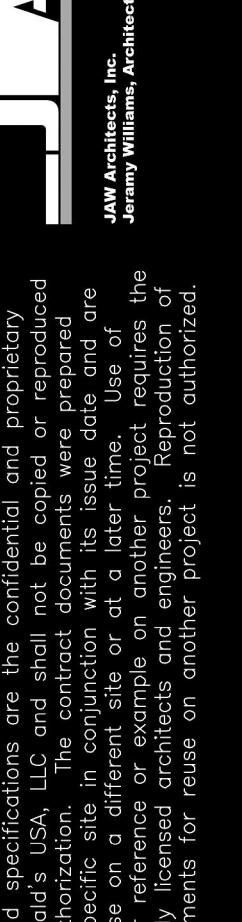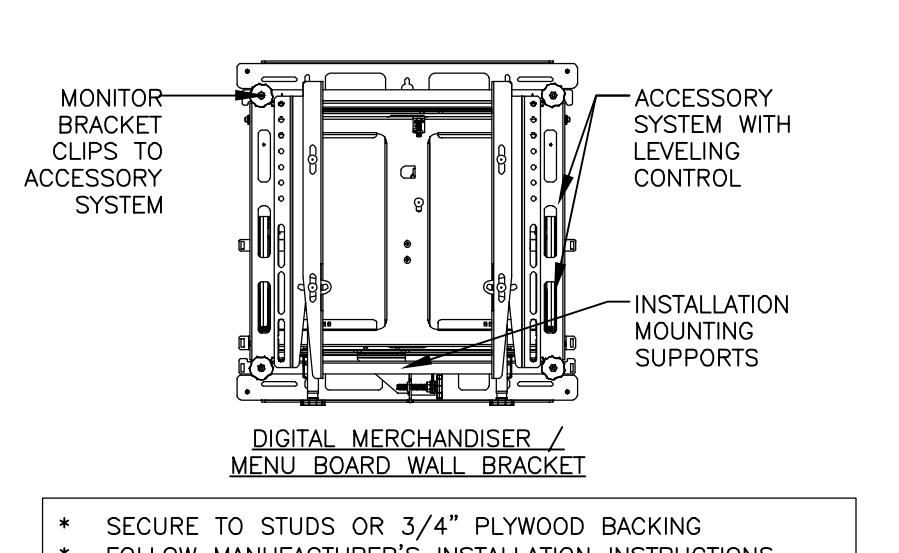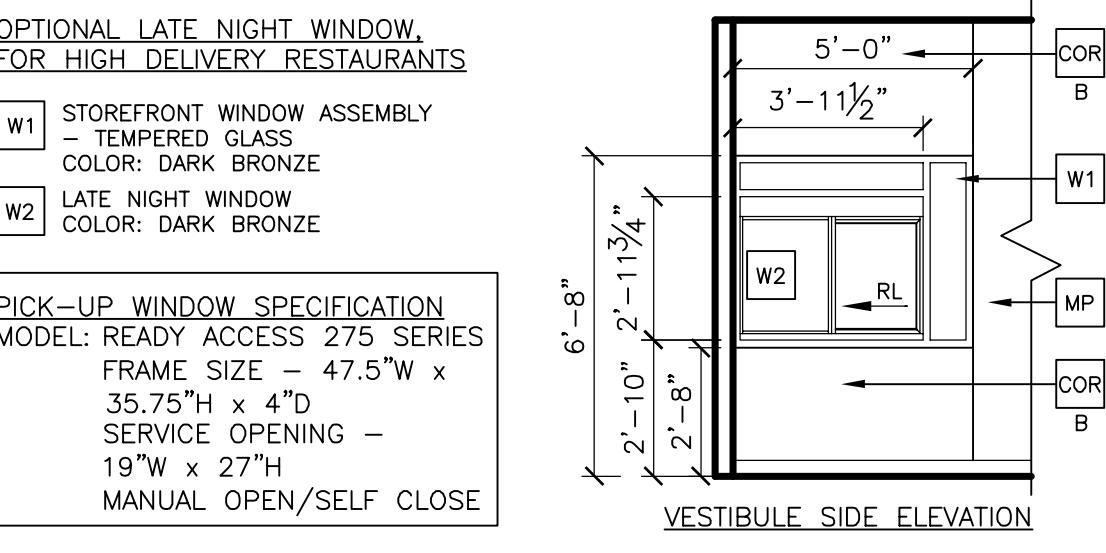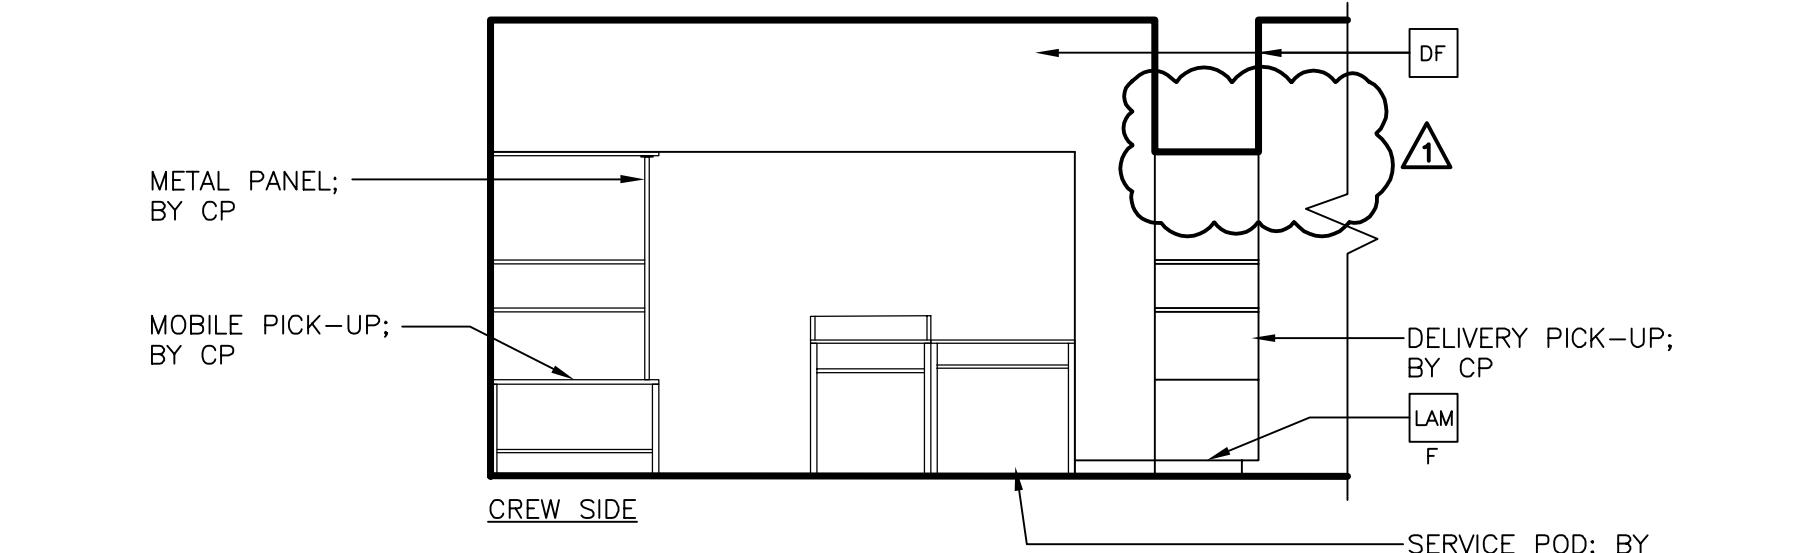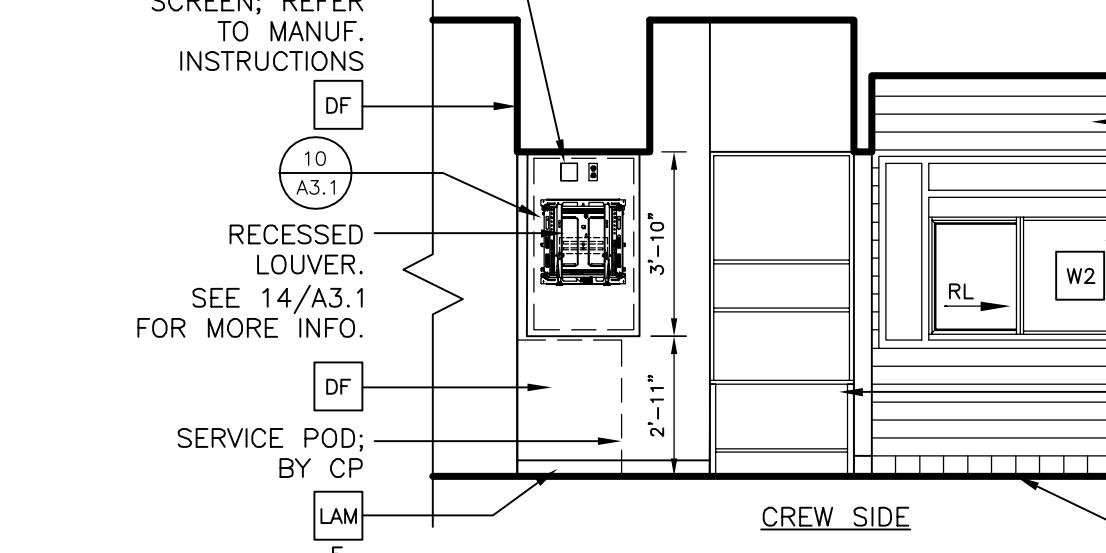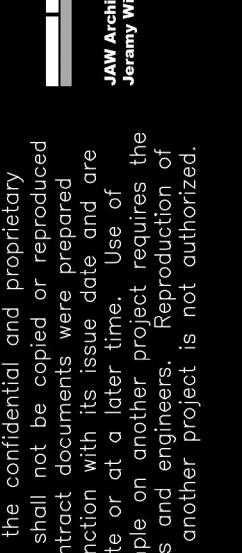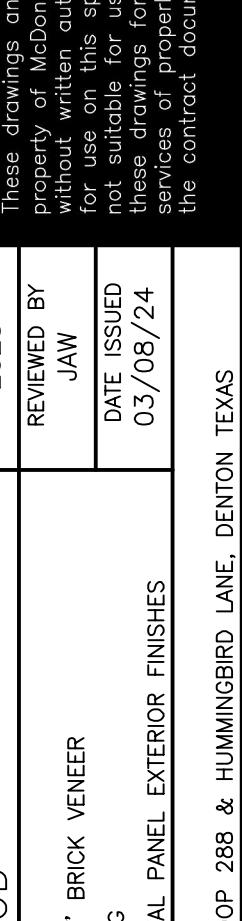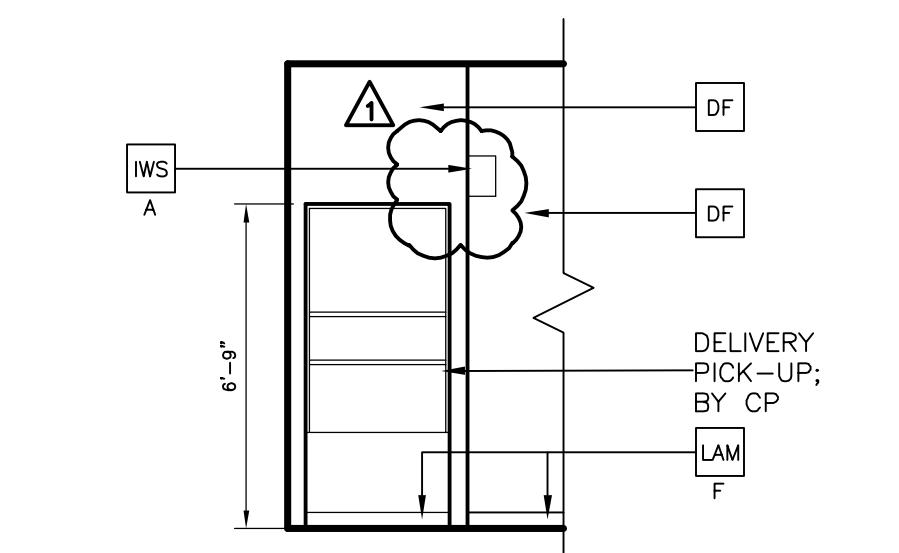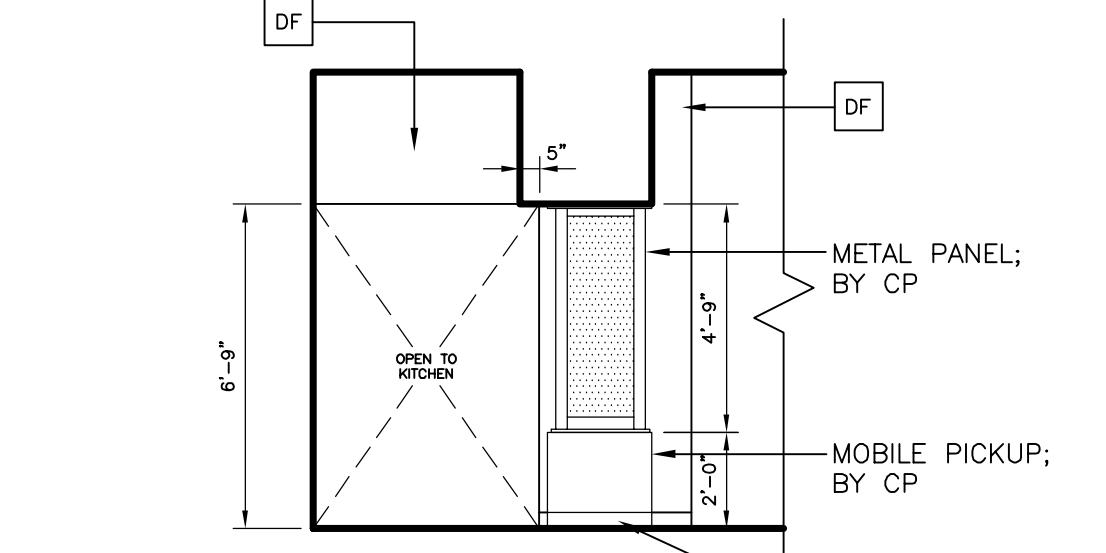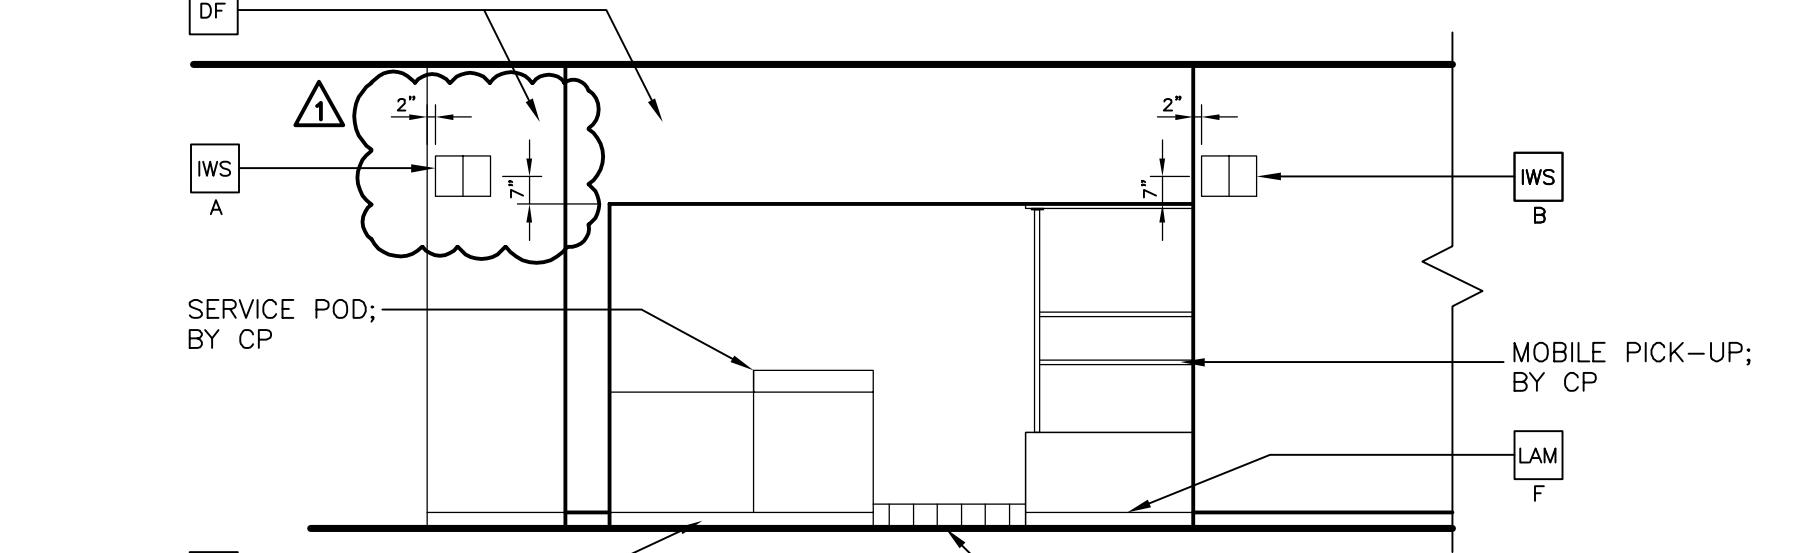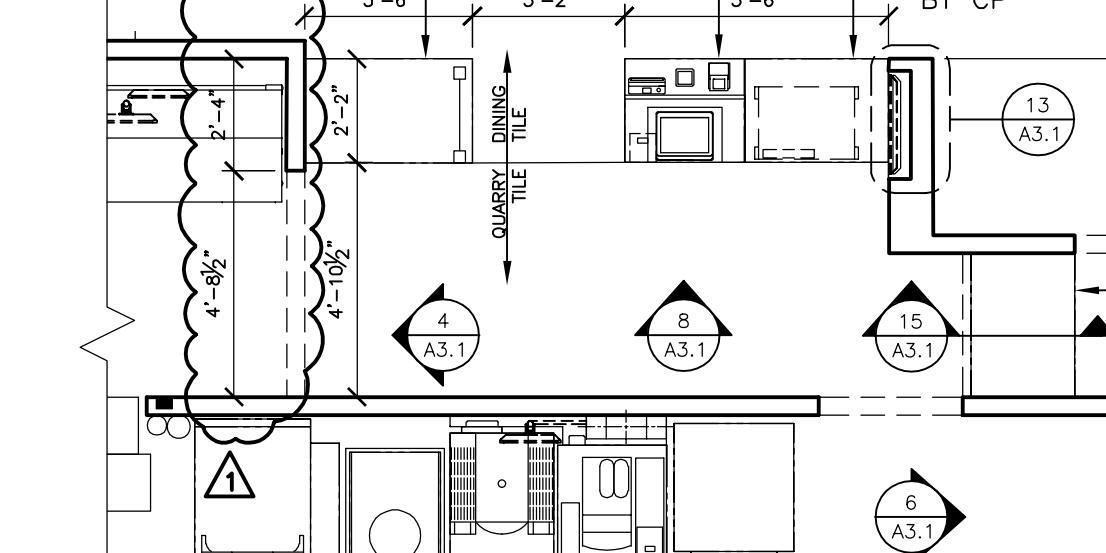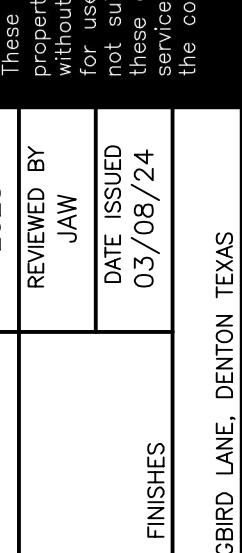SECTION @ DELIVERY POD		SECTION @ DIGITAL MERCHANTISER	PLAN DETAIL @ DIGITAL MERCH.	McDonald's USA, LLC	
15 A3.1	1" = 1'-0"	14 A3.1	1" = 1'-0"	13 A3.1	1" = 1'-0"
					
					
					
KEY NOTES				GENERAL NOTES	
<p>CG CORNER GUARD: 3/4" ANGLE BY DECOR X = BLACK</p> <p>COR CORIAN: X = 1/2" CORIAN CAMEO WHITE B = 1/2" CORIAN DEEP TITANIUM</p> <p>DF DECOR FINISH TO BE ORDERED/INSTALLED BY GC AND MANUFACTURED BY DECOR; REFER TO PORTFOLIO.</p> <p>FRP FIBERGLASS REINFORCED PLASTIC - PANOLAM, GRAY SMOOTH, CLASS C, .075. FOR ORDERING, CONTACT KIMBERLY LAWSON Kimberly_Lawson@panolam.com 1-866-925-4377</p>	<p>CT CERAMIC WALL TILE: CROSSVILLE - COLOR BY NUMBERS COLOR: AFTERNOON SPRAY, SIZE: 4"x12", PATTERN: RUNNING BOND GROUT: MAPEI O2 PEWTER - JOINT TO BE $\frac{1}{8}$" MAX. USE THIS TILE WHEN HIGH LRV IS REQUIRED COORDINATE WITH THE McDONALD'S AREA CONSTRUCTION MANAGER</p> <p>IWS INTERIOR WAYFINDING SIGNAGE A = McDELIVERY INTERIOR TRIANGULAR SIGN B = MOBILE ORDER INTERIOR TRIANGULAR SIGN C = ADA ASSISTANCE SIGNAGE</p> <p>KS KIOSK SIGNAGE BY GC; ORDER FROM AMANDA GUSTAFSON W/ ALTRUA X = "CREDIT ONLY" KIOSK SIGNAGE B = "CASH/CREDIT" KIOSK SIGNAGE</p>	<p>LAM LAMINATE: X = COLOR: A = IDMB / DIG. MERCH., SMOOTH BLACK PLASTIC LAMINATE BY GC B = TRASH/ COND., WHITE PLASTIC LAMINATE BY GC C = TRASH/ COND., LAMTECH GRAPHITE K MATTE FINISH D = SEE DECOR DRAWINGS, MFR BY DECOR, PURCHASE AND INSTALL BY GC E = McDELIVERY UNDERSCORE, LAMTECH GOLDEN F = BASE BOARD, FORMICA COMPACT LAMINATE MATTE BLACK BY GC</p> <p>MP METAL INFILL PANEL. MATCH DARK BRONZE WINDOW ASSEMBLY</p>	<ul style="list-style-type: none"> ALL WALL LAMINATE PANELING MANUFACTURED BY DECOR PURCHASE AND INSTALL BY GC, UNO. ALL ELEMENTS 'BY CP' TO BE ORDERED BY CENTRAL PURCHASING AND MANUFACTURED BY GC, UNO. A2E TO VERIFY LOCATION AND QUANTITY OF LIGHTS AND DIFFUSERS AFTER SERVICE AREA WALL ADDITION. 		

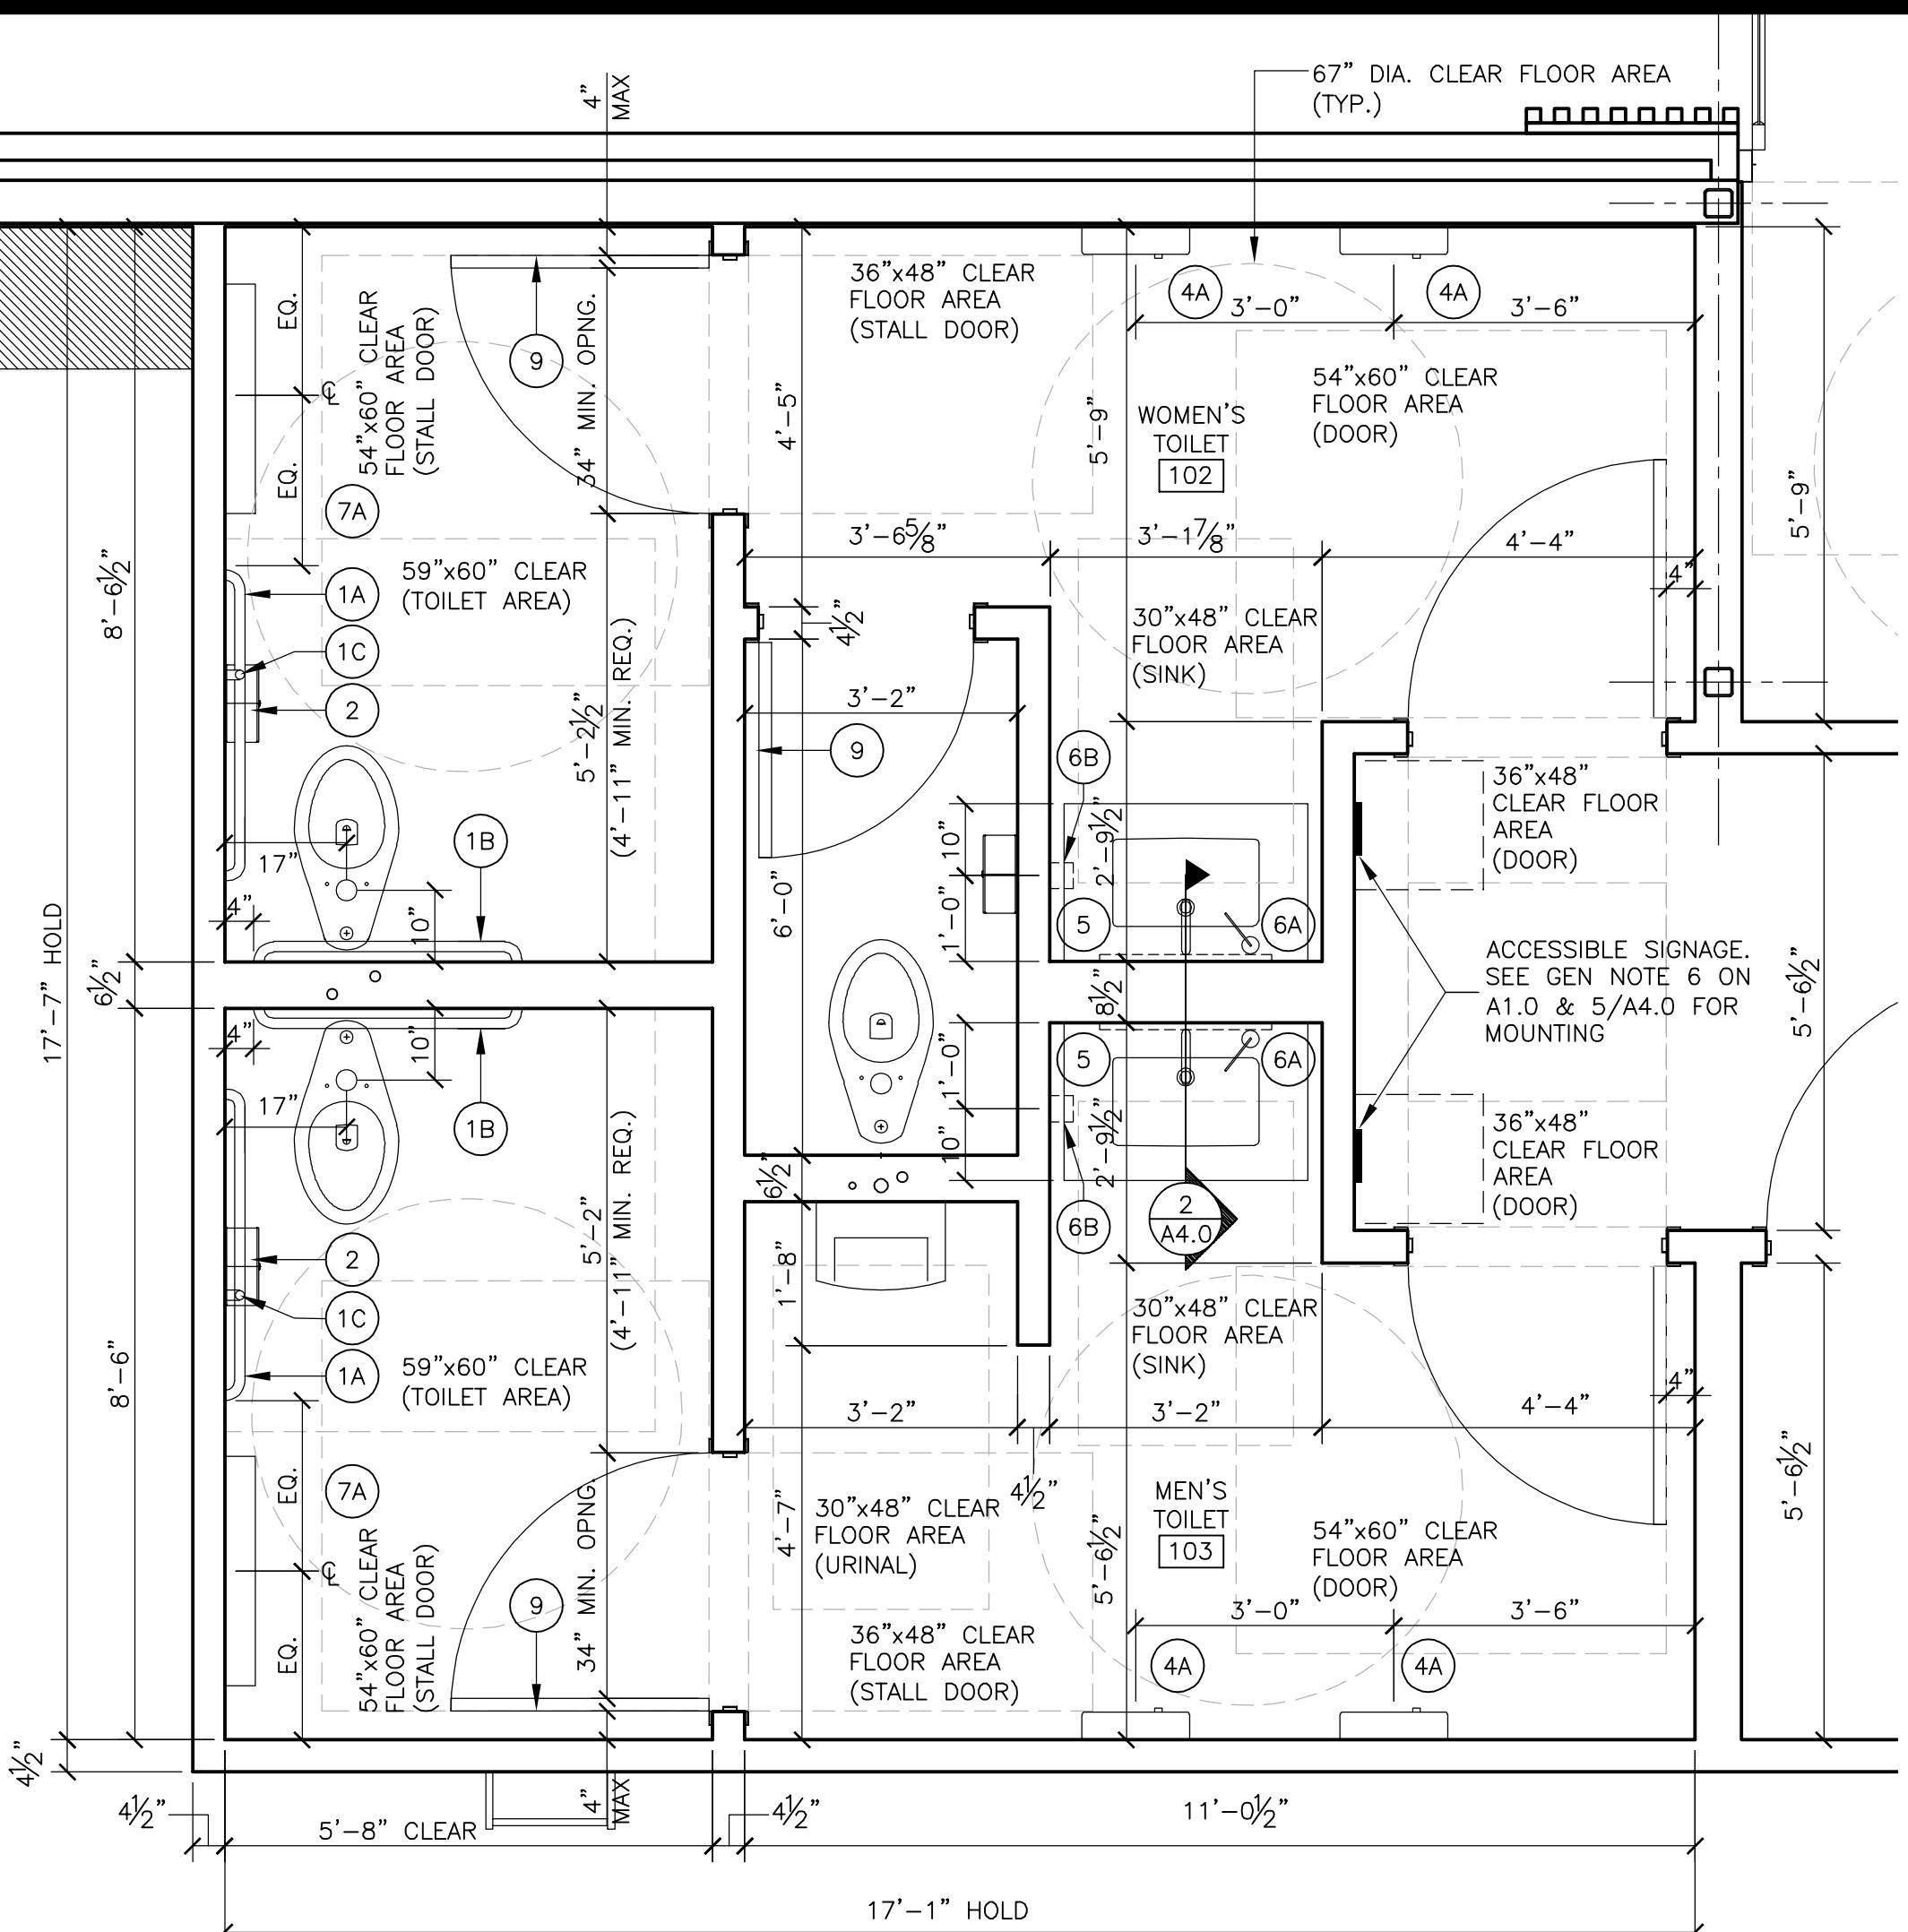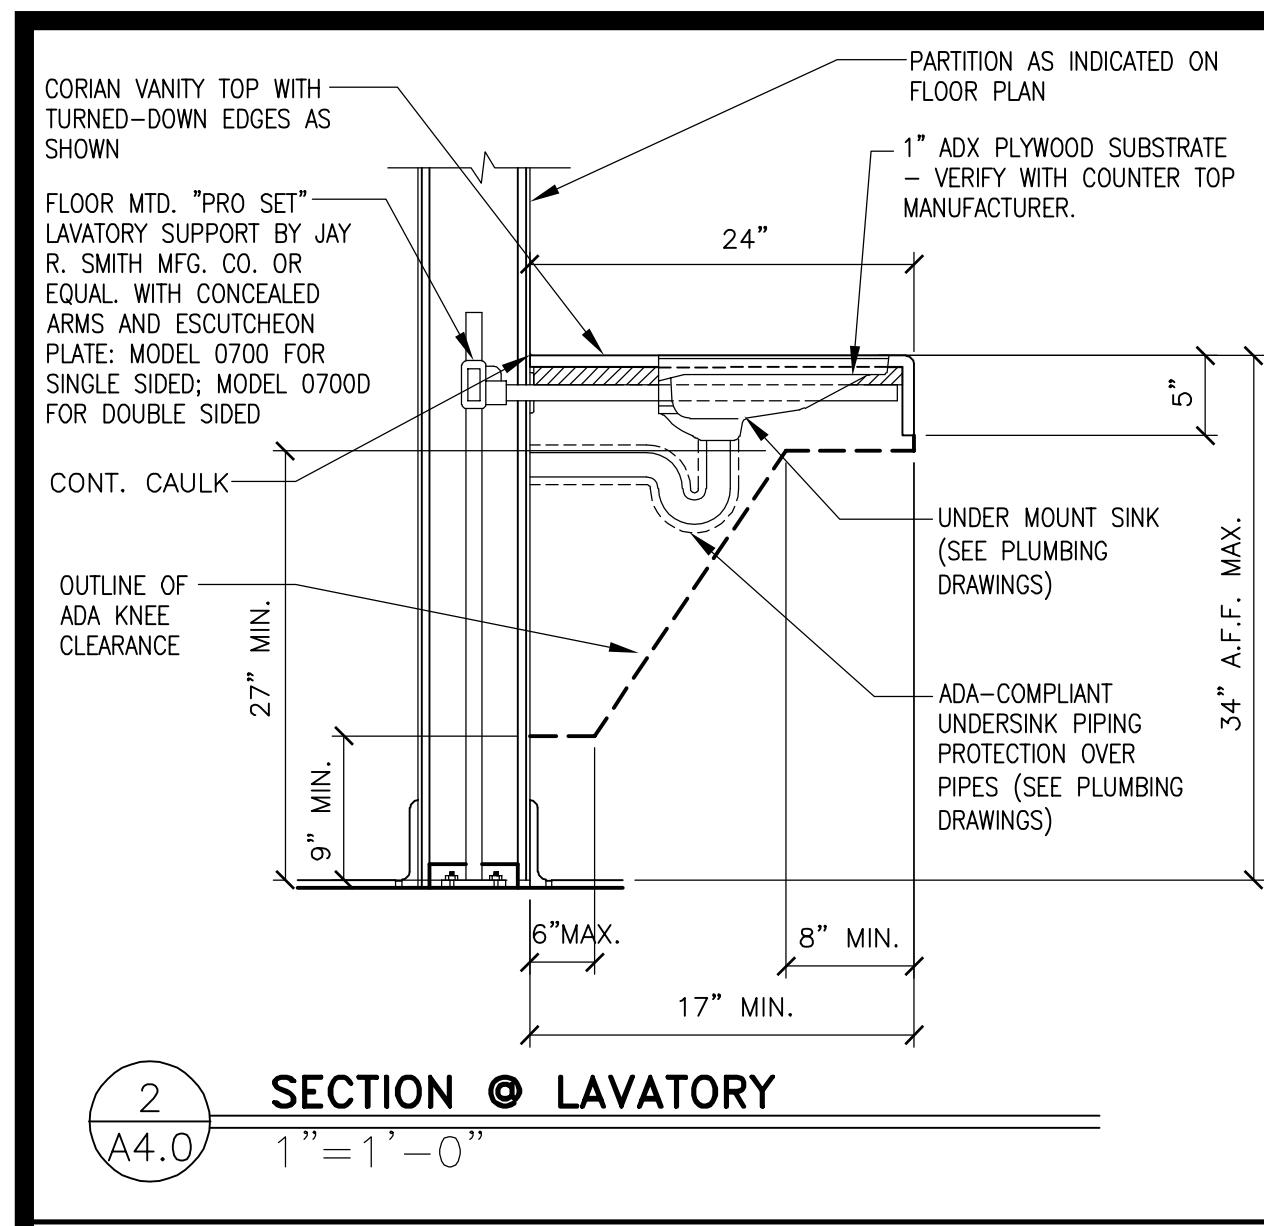

ENLARGED RESTROOM PLAN

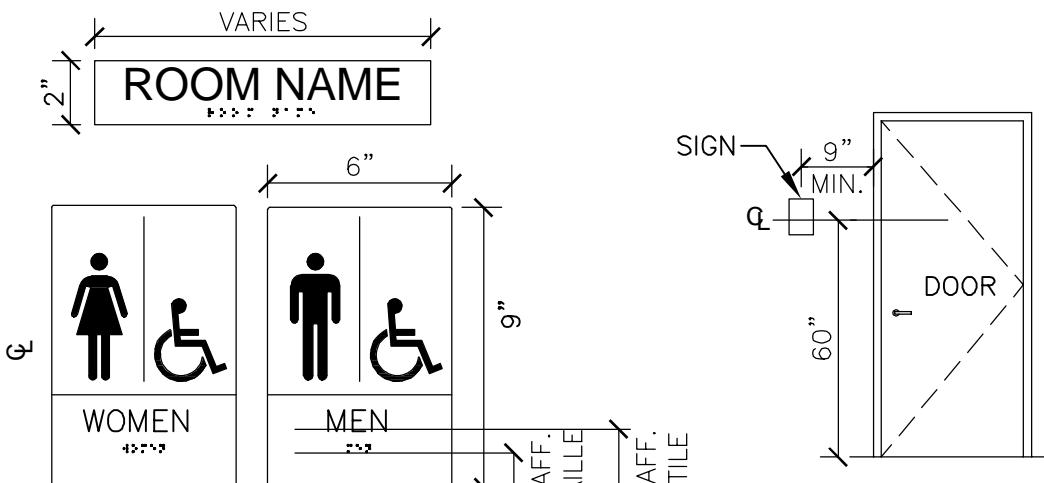

GRAPHICS SHOWN ARE FOR REFERENCE ONLY.

GC TO PROVIDE ADA SIGNAGE PACKAGE AND INSTALL SIGNS AT LOCATIONS AND POSITIONS INDICATED IN PACKAGE OR AS REQUIRED BY LOCAL CODES. SIGNAGE PACKAGE SUPPLIED BY:

FRANKE/S2K
1-800-423-5247
www.frankesupply.com
email: fs-frankesupply.us@franke.com



SIGNAGE NOTES:

1. EACH EXIT DOOR SHALL HAVE A TACTILE SIGN, INCLUDING RAISED LETTERS AND BRAILLE, STATING 'EXIT' AND SHALL COMPLY WITH CHAPTER 7. ALL SIGNAGE SHALL CONFORM WITH ACCESSIBILITY GUIDELINES AND LOCAL GUIDELINES INCLUDING BUT NOT LIMITED TO PROPORTION, COLOR CONTRAST AND RELIEF AND GRADE 2 BRAILLE REQUIREMENTS.
 2. WHEN PERMANENT IDENTIFICATION IS PROVIDED FOR ROOMS AND SPACES, RAISED LETTERS SHALL BE PROVIDED AND SHALL BE ACCCOMPANIED BY BRAILLE IN CONFORMANCE WITH CHAPTER 7. SIGNS SHALL BE INSTALLED ON THE WALL ADJACENT TO THE LATCH SIDE OF THE DOOR. WHERE THERE IS NO WALL SPACE ON THE LATCH SIDE, INCLUDING AT DOUBLE LEAF DOORS, SIGNS SHALL BE PLACED ON THE NEAREST ADJACENT WALL, PREFERABLY ON THE RIGHT. MOUNTING HEIGHT SHALL BE 60" ABOVE THE FINISHED FLOOR TO THE CENTERLINE OF THE SIGN. MOUNTING LOCATION SHALL BE DETERMINED SO THAT A PERSON MAY APPROACH WITHIN 3" OF SIGNAGE WITHOUT ENCOUNTERING PROTRUDING OBJECTS OR STANDING WITHIN THE SWING OF A DOOR.




ACCESSIBLE SIGNAGE

A4 0 N.T.C.

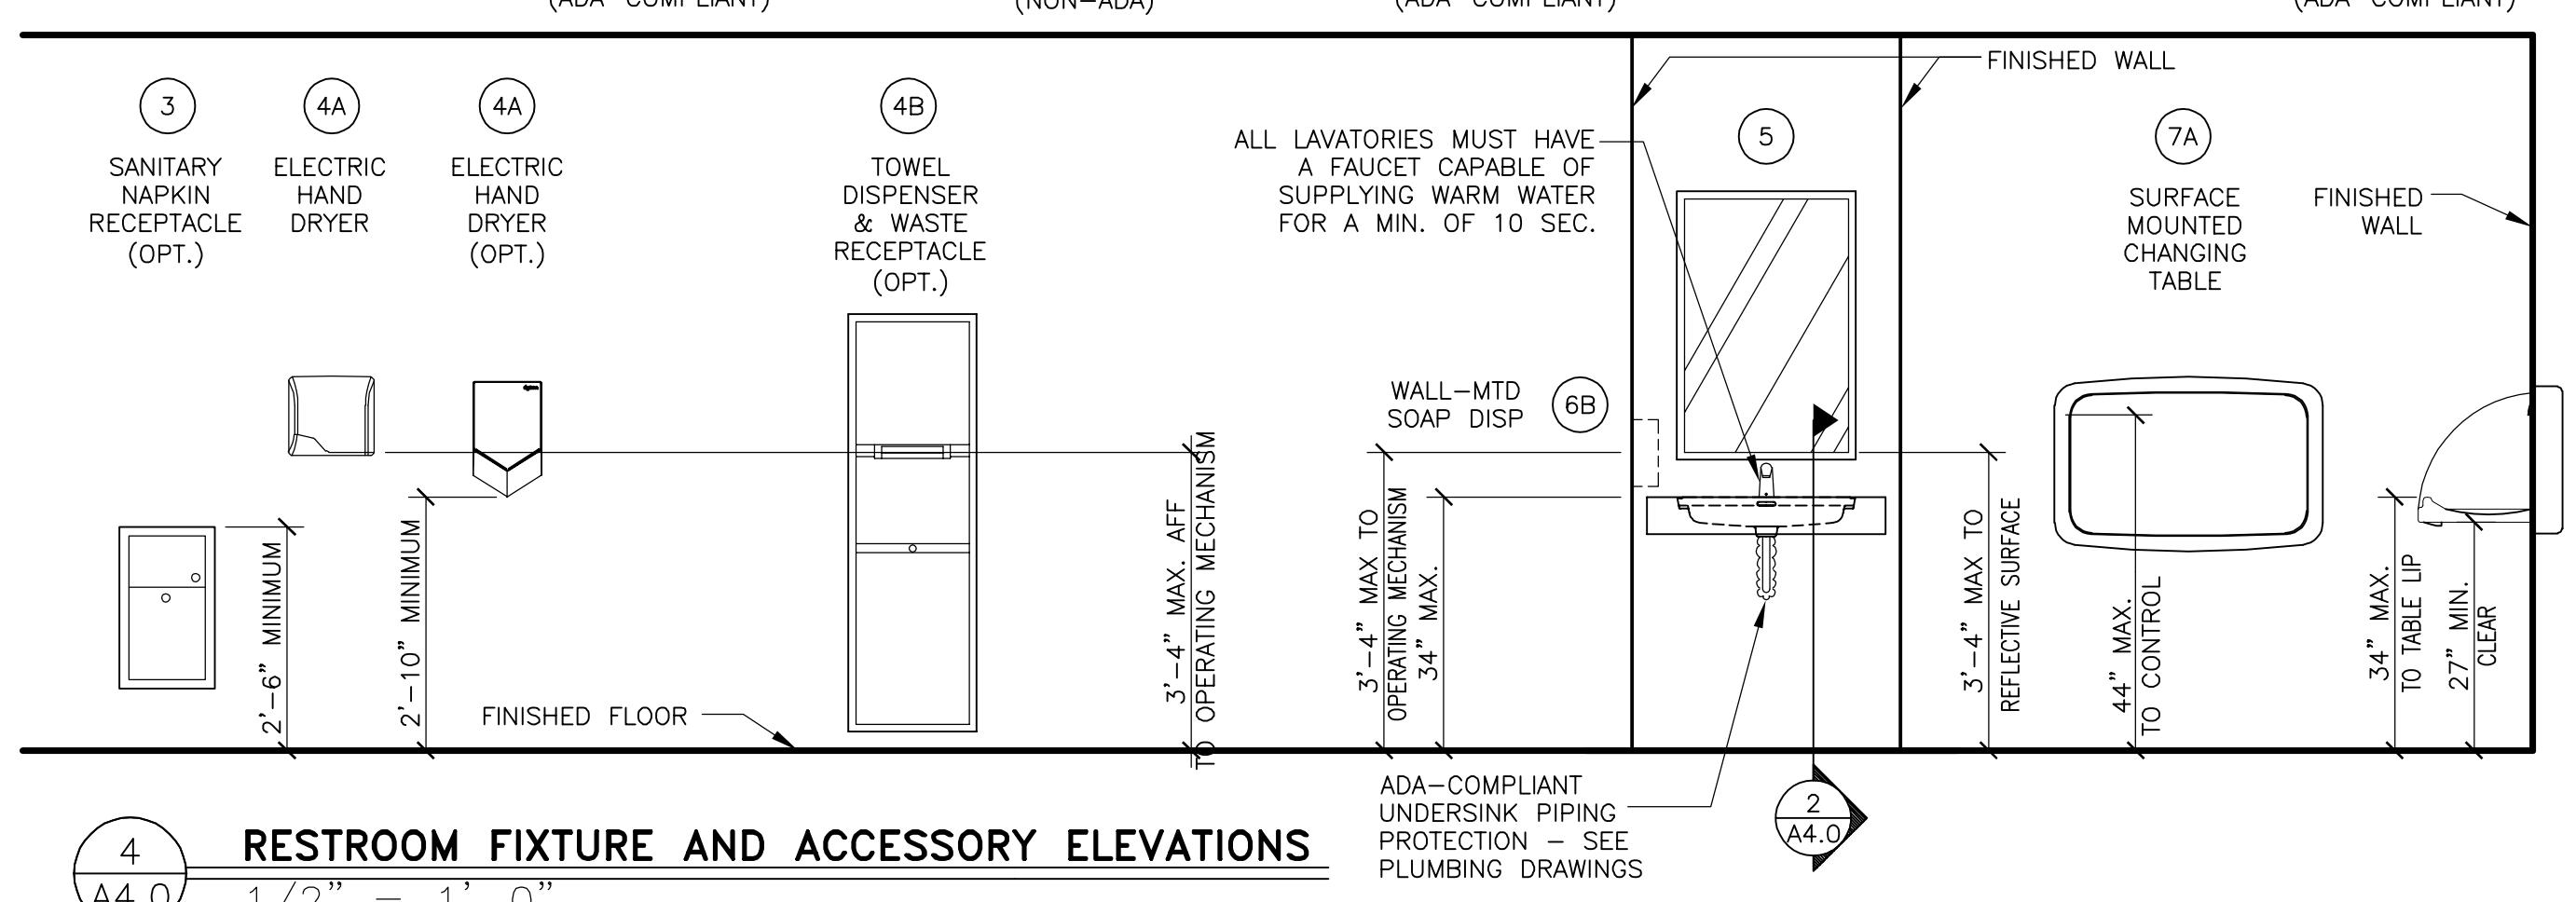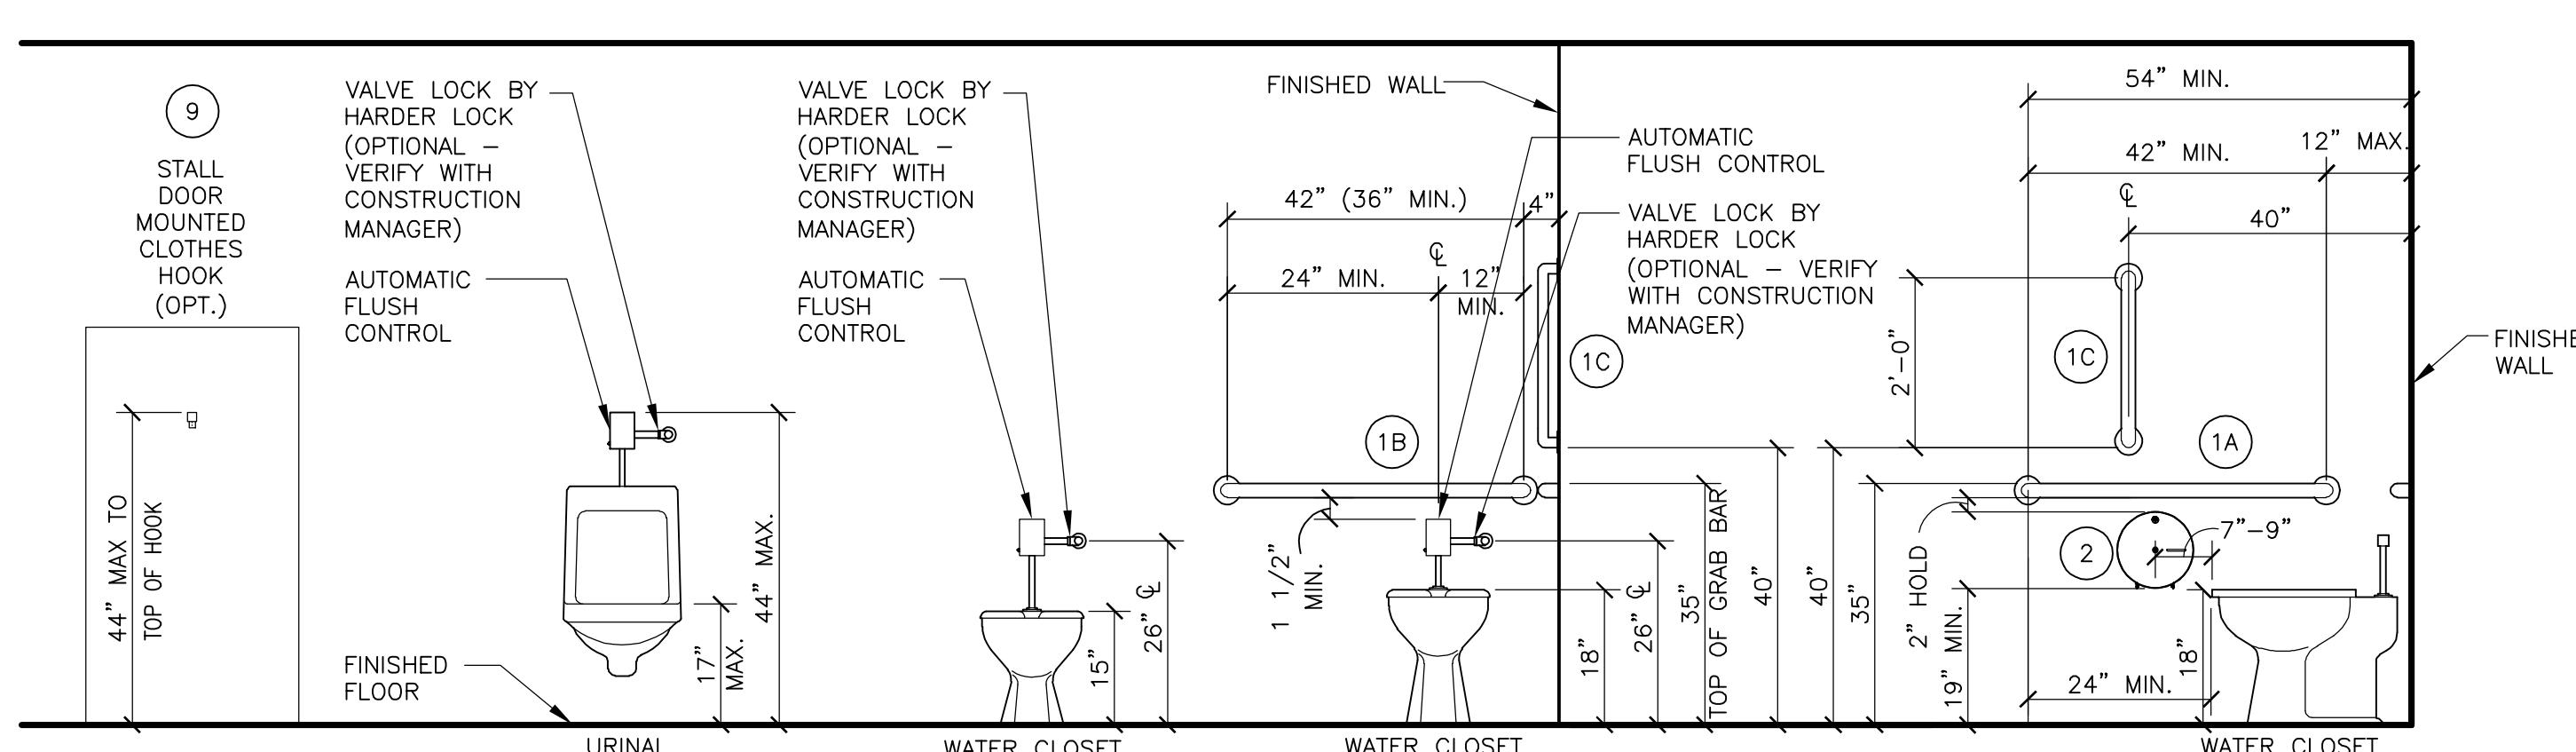



	ITEM (SEE NOTE 2)	MFR MODEL #	SUPPLIER	BACKUP SUPPORT (SEE NOTE 3)
1A	GRAB BAR 42"	BOBRICK B-6806X42	HUGHES SUPPLY (866) 310-3576 MCDCOORD@HAJOCACOM	(1)2x6 4'-0" LONG CENTER MOUNTED
1B	GRAB BAR 36"	B-6806X36		
1C	GRAB BAR 24"	B-6806X24		
2	TOILET TISSUE DISPENSER, JUMBO, SURFACE MOUNTED	BRADLEY 5424	HUGHES SUPPLY (866) 310-3576 MCDCOORD@HAJOCACOM	FRAME WALL OPENING PER MANUFACTURER'S RECOMMENDATIONS
3	SANITARY NAPKIN RECEPTACLE, RECESSED (OPTIONAL)	BOBRICK B-354	HUGHES SUPPLY (866) 310-3576 MCDCOORD@HAJOCACOM	
4A	HAND DRYER, ENERGY EFFICIENT MODEL, ADA, ALUMINUM BRUSHED	WORLD DRYER Q-973A2 VerdeDri	HUGHES SUPPLY (866) 310-3576 MCDCOORD@HAJOCACOM	FRAME WALL OPENING PER MANUFACTURER'S RECOMMENDATIONS
4A OPTION	HAND DRYER, ENERGY EFFICIENT MODEL ADA, SPRAYED NICKEL	DYSON AIRBLADE V	HUGHES SUPPLY (866) 310-3576 MCDCOORD@HAJOCACOM	
4B OPTION	TOWEL DISPENSER & WASTE RECEPTACLE, COMBINATION, RECESSED (OPTIONAL)	BOBRICK B-3974	HUGHES SUPPLY (866) 310-3576 MCDCOORD@HAJOCACOM	
5	MIRROR, CHANNEL FRAME	BOBRICK B-165 2436	HUGHES SUPPLY (866) 310-3576 MCDCOORD@HAJOCACOM	
6A	SOAP DISPENSER, COUNTER MOUNTED, 6" SPOUT (OPTIONAL)	BOBRICK B-82216	HUGHES SUPPLY (866) 310-3576 MCDCOORD@HAJOCACOM	
6B	SOAP DISPENSER, WALL-MOUNTED	BOBRICK B-2112	HUGHES SUPPLY (866) 310-3576 MCDCOORD@HAJOCACOM	
7	BABY CHANGING TABLE, HORIZONTAL, RECESSED, ADA COMPLIANT, STAINLESS STEEL	KOALA KARE KB310-SSRE	HUGHES SUPPLY (866) 310-3576 MCDCOORD@HAJOCACOM	INSTALL PER MANUFACTURER'S RECOMMENDATIONS
7 OPTION "A"	BABY CHANGING TABLE, HORIZONTAL, SURFACE MOUNT, ADA COMPLIANT, STAINLESS STEEL	KOALA KARE KB310-SSWM	HUGHES SUPPLY (866) 310-3576 MCDCOORD@HAJOCACOM	INSTALL PER MANUFACTURER'S RECOMMENDATIONS
8	DIAPER CONTAINER (OPTIONAL)	-	BY OWNER	
9	CLOTHES HOOK	BRADLEY 917	HUGHES SUPPLY (866) 310-3576 MCDCOORD@HAJOCACOM	



ES:
EE 4/A4.0 FOR ACCESSORY MOUNTING HEIGHTS
ELECT ONE ITEM FROM ITEM GROUPS 4 & 6, VERIFY WITH AREA CONSTRUC-
UT BACK-UP SUPPORTS BETWEEN STUDS SO FACE OF SUPPORT IS FLUSH

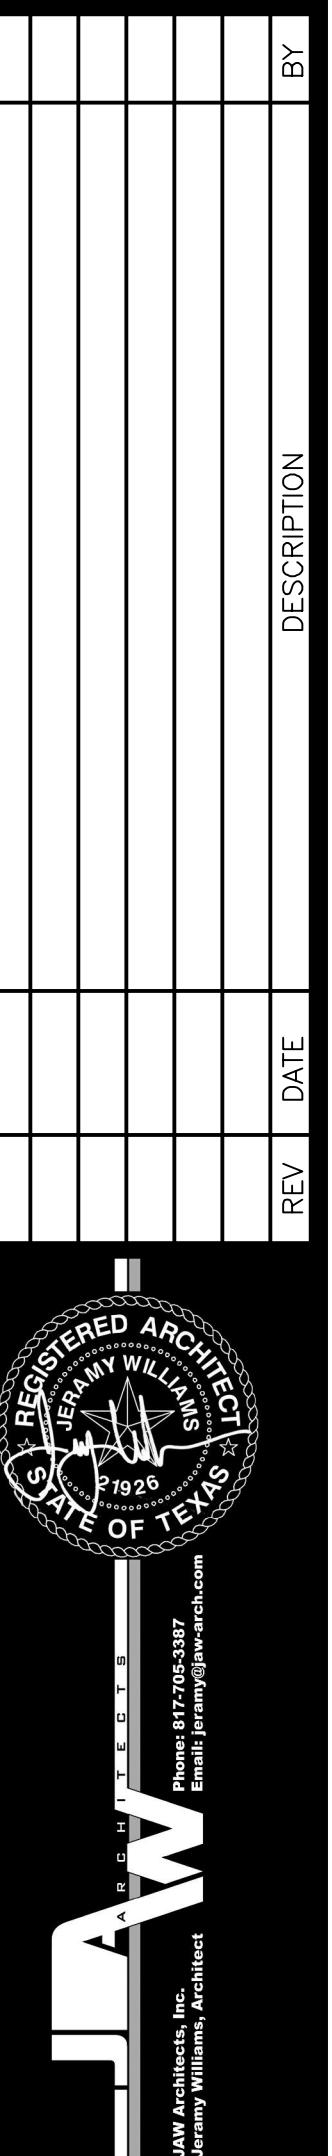




2023 STANDARD BUILDING - BB20		STD ISSUE DATE 2023	REVIEWED BY JAW
4597-WOOD/WOOD		DATE ISSUED 03/08/24	
<p>DESCRIPTION</p> <p>WOOD BEARING WALLS W/4" BRICK VENEER</p> <p>WOOD ROOF TRUSS FRAMING</p> <p>STUCCO/BATTEN/BRICK/METAL PANEL EXTERIOR FINISHES</p>			
SITE ID 042-3271	SITE ADDRESS SEC OF S.H. LOOP 288 & HUMMINGBIRD LANE, DENTON TEXAS		
JAWA 24-0014			

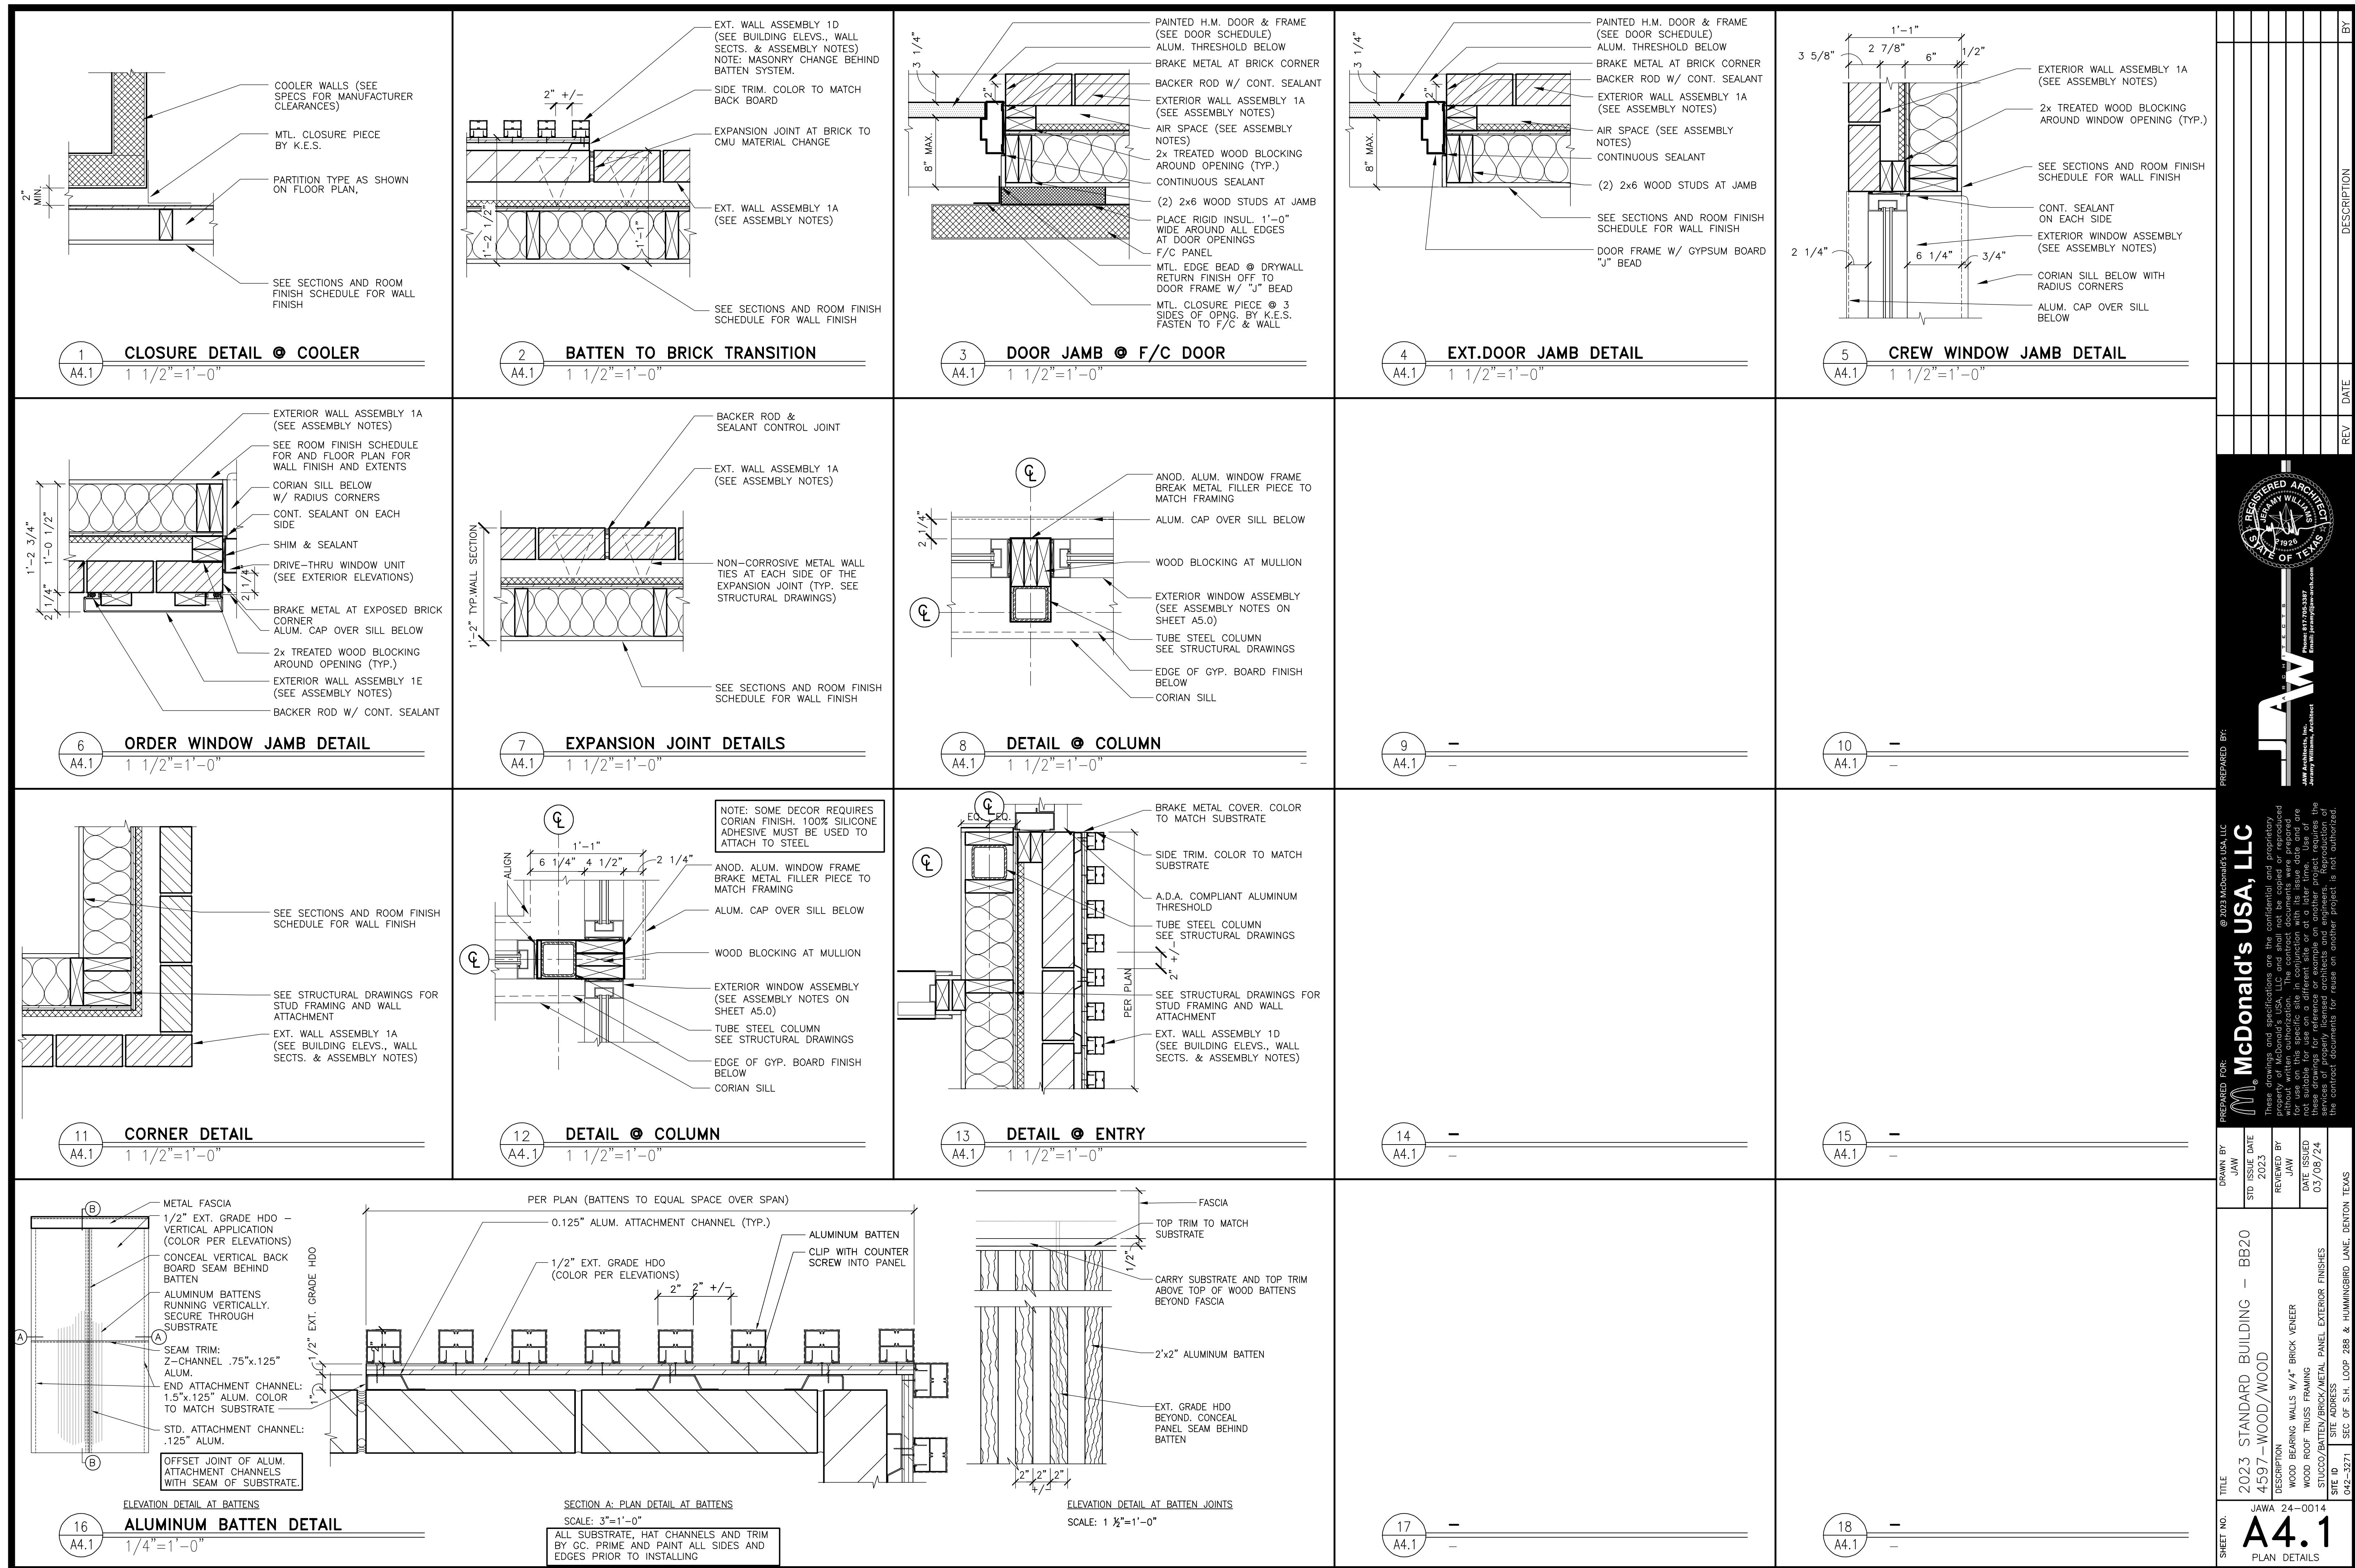


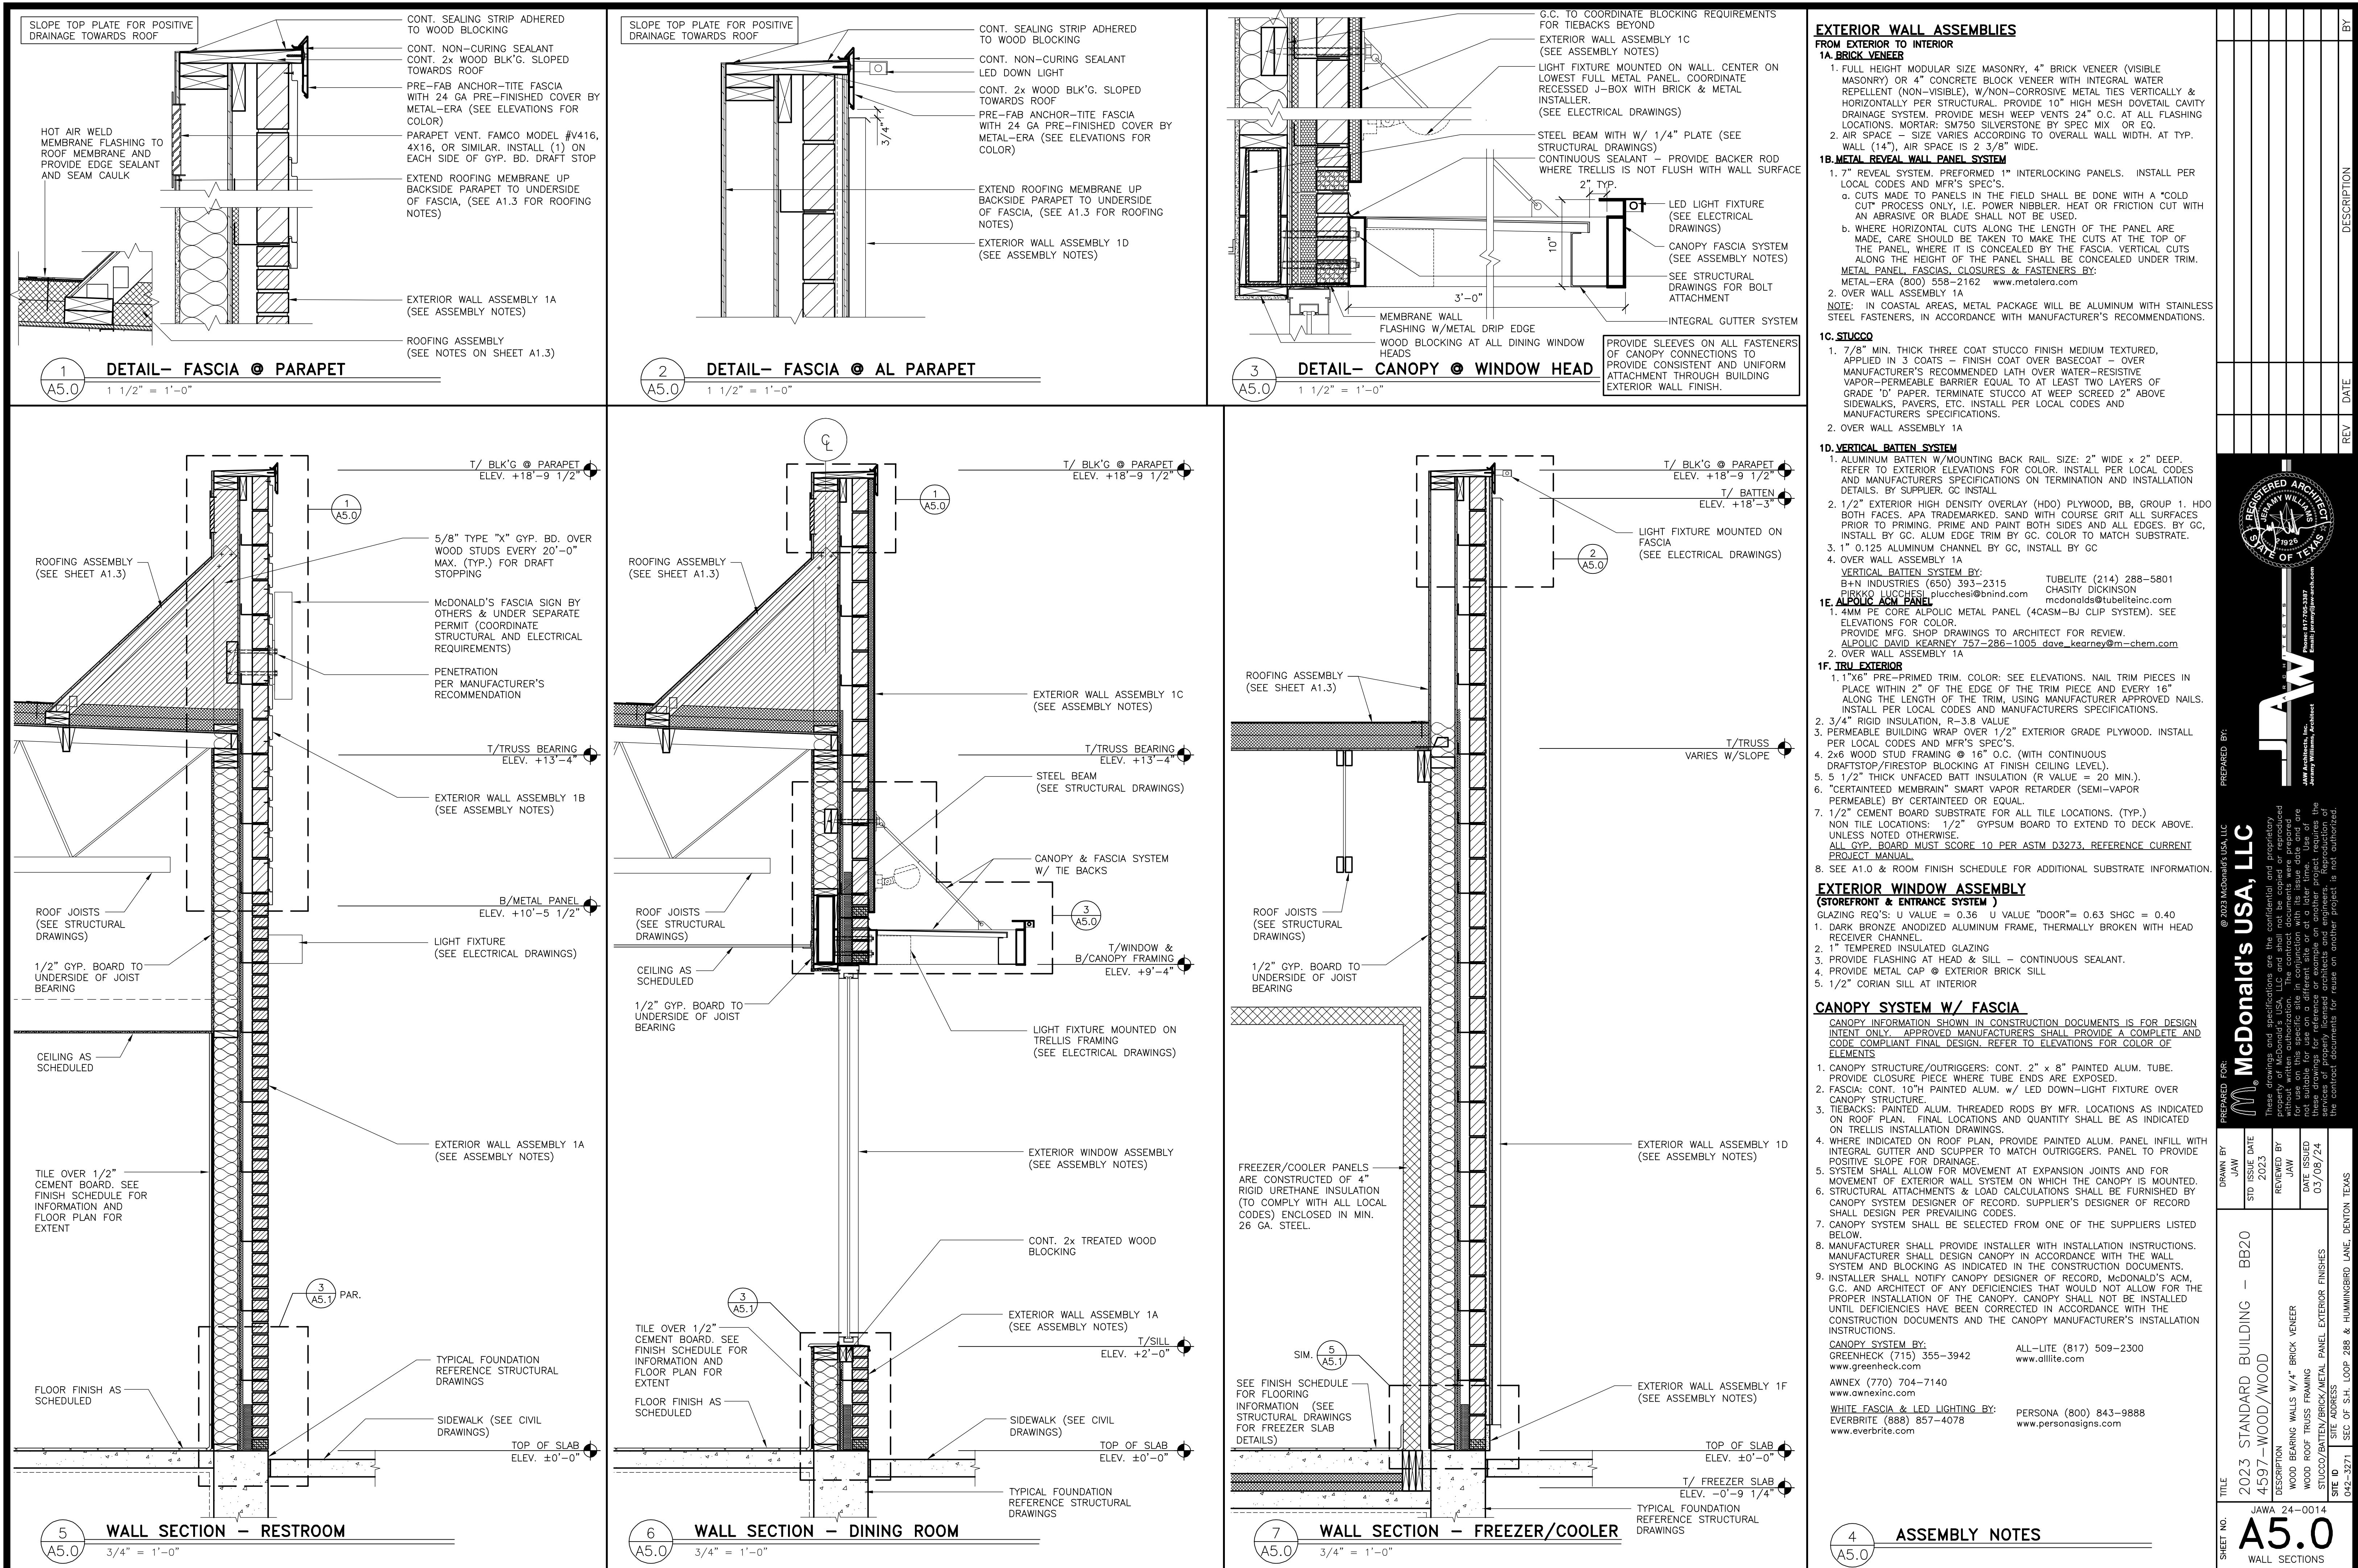


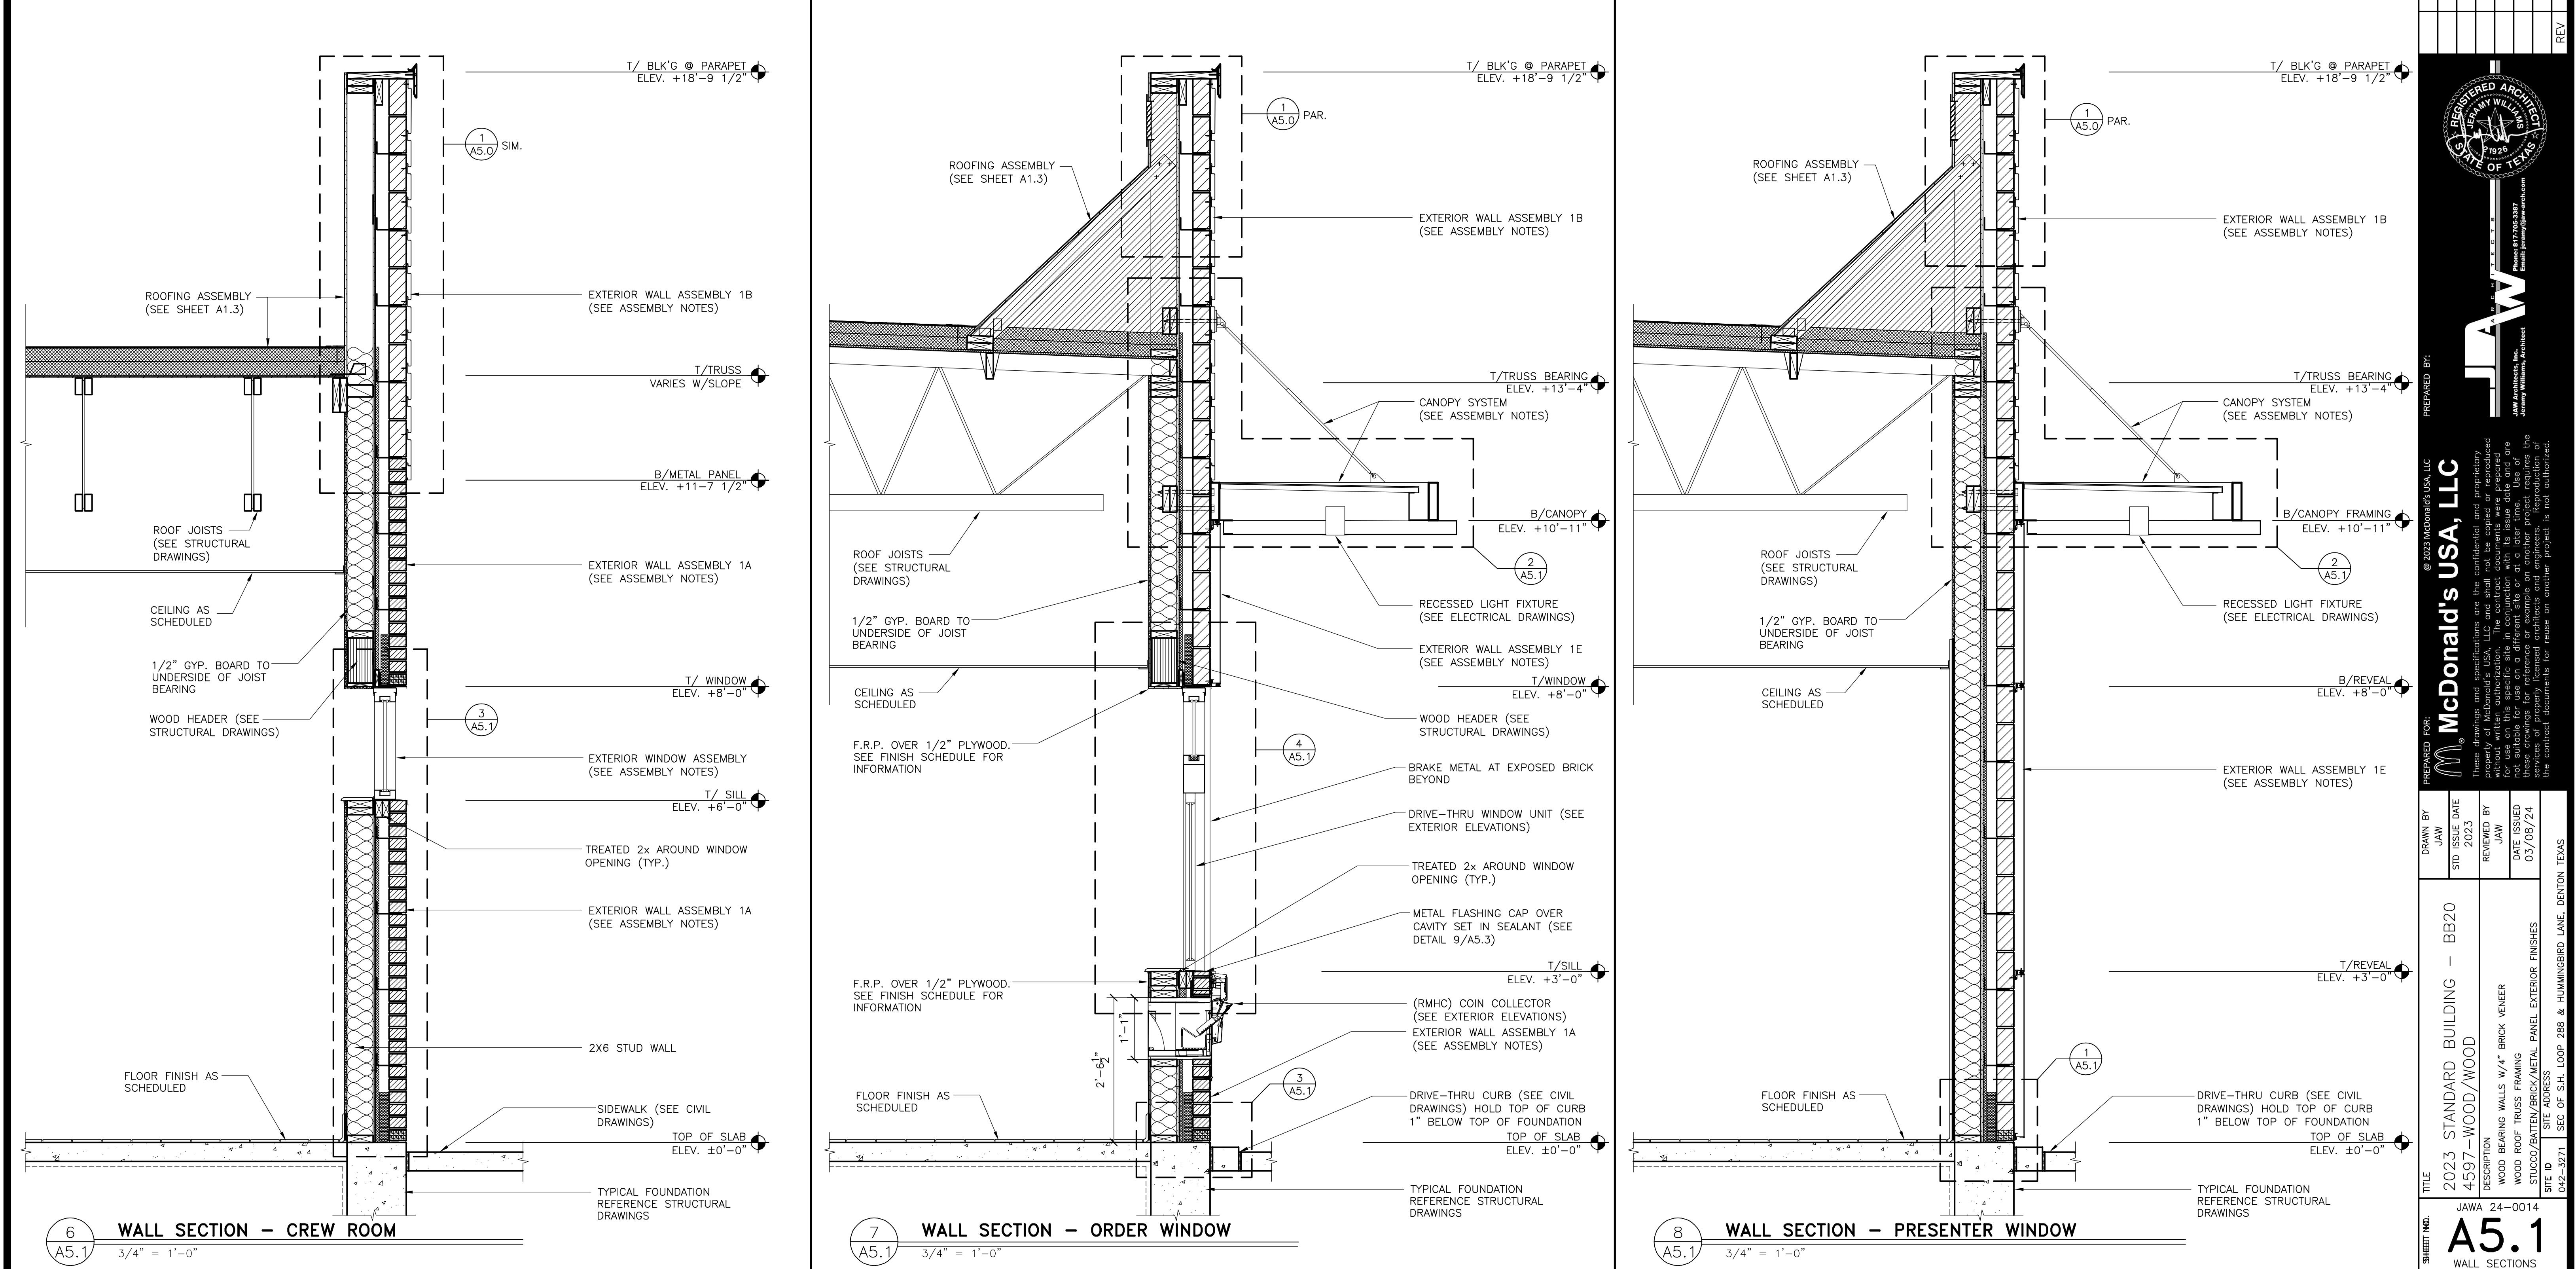
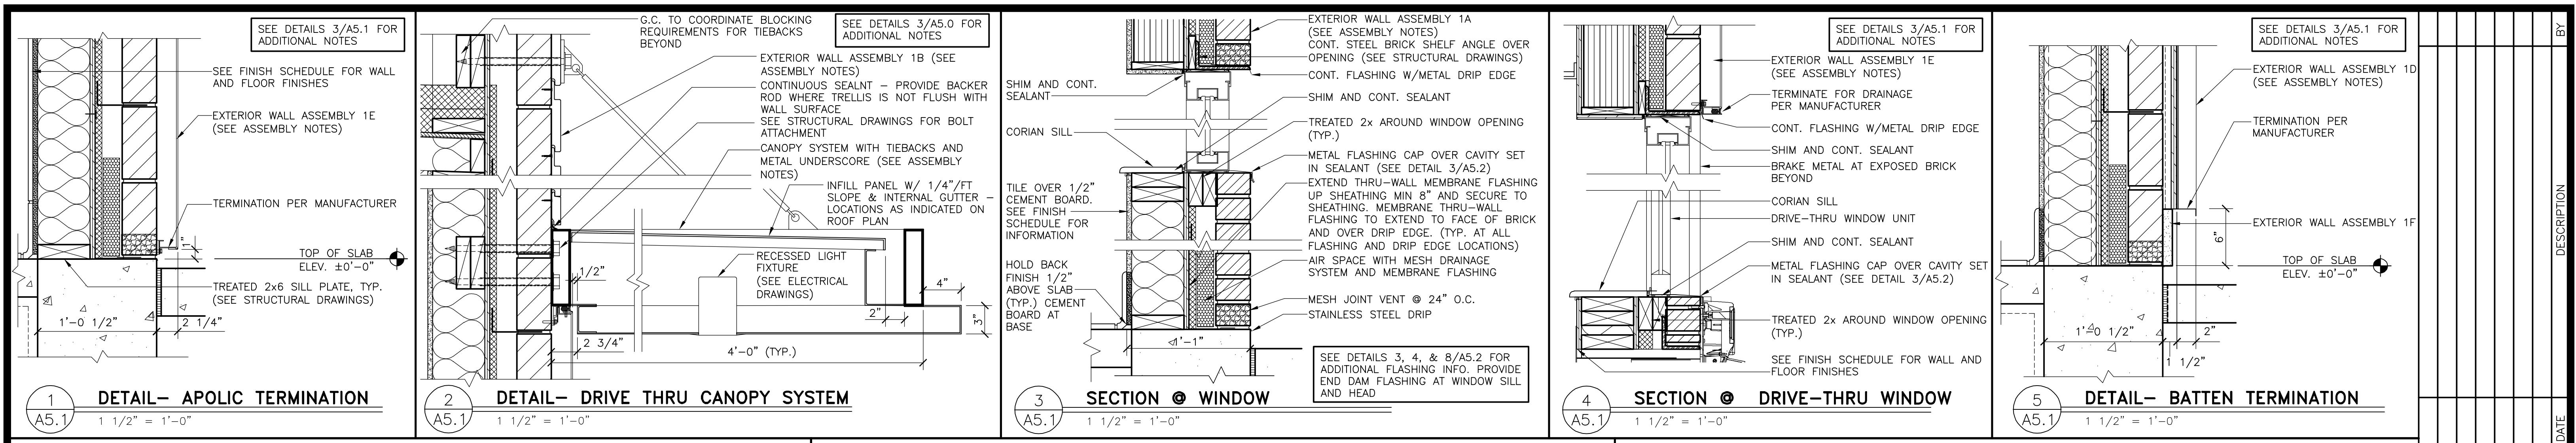


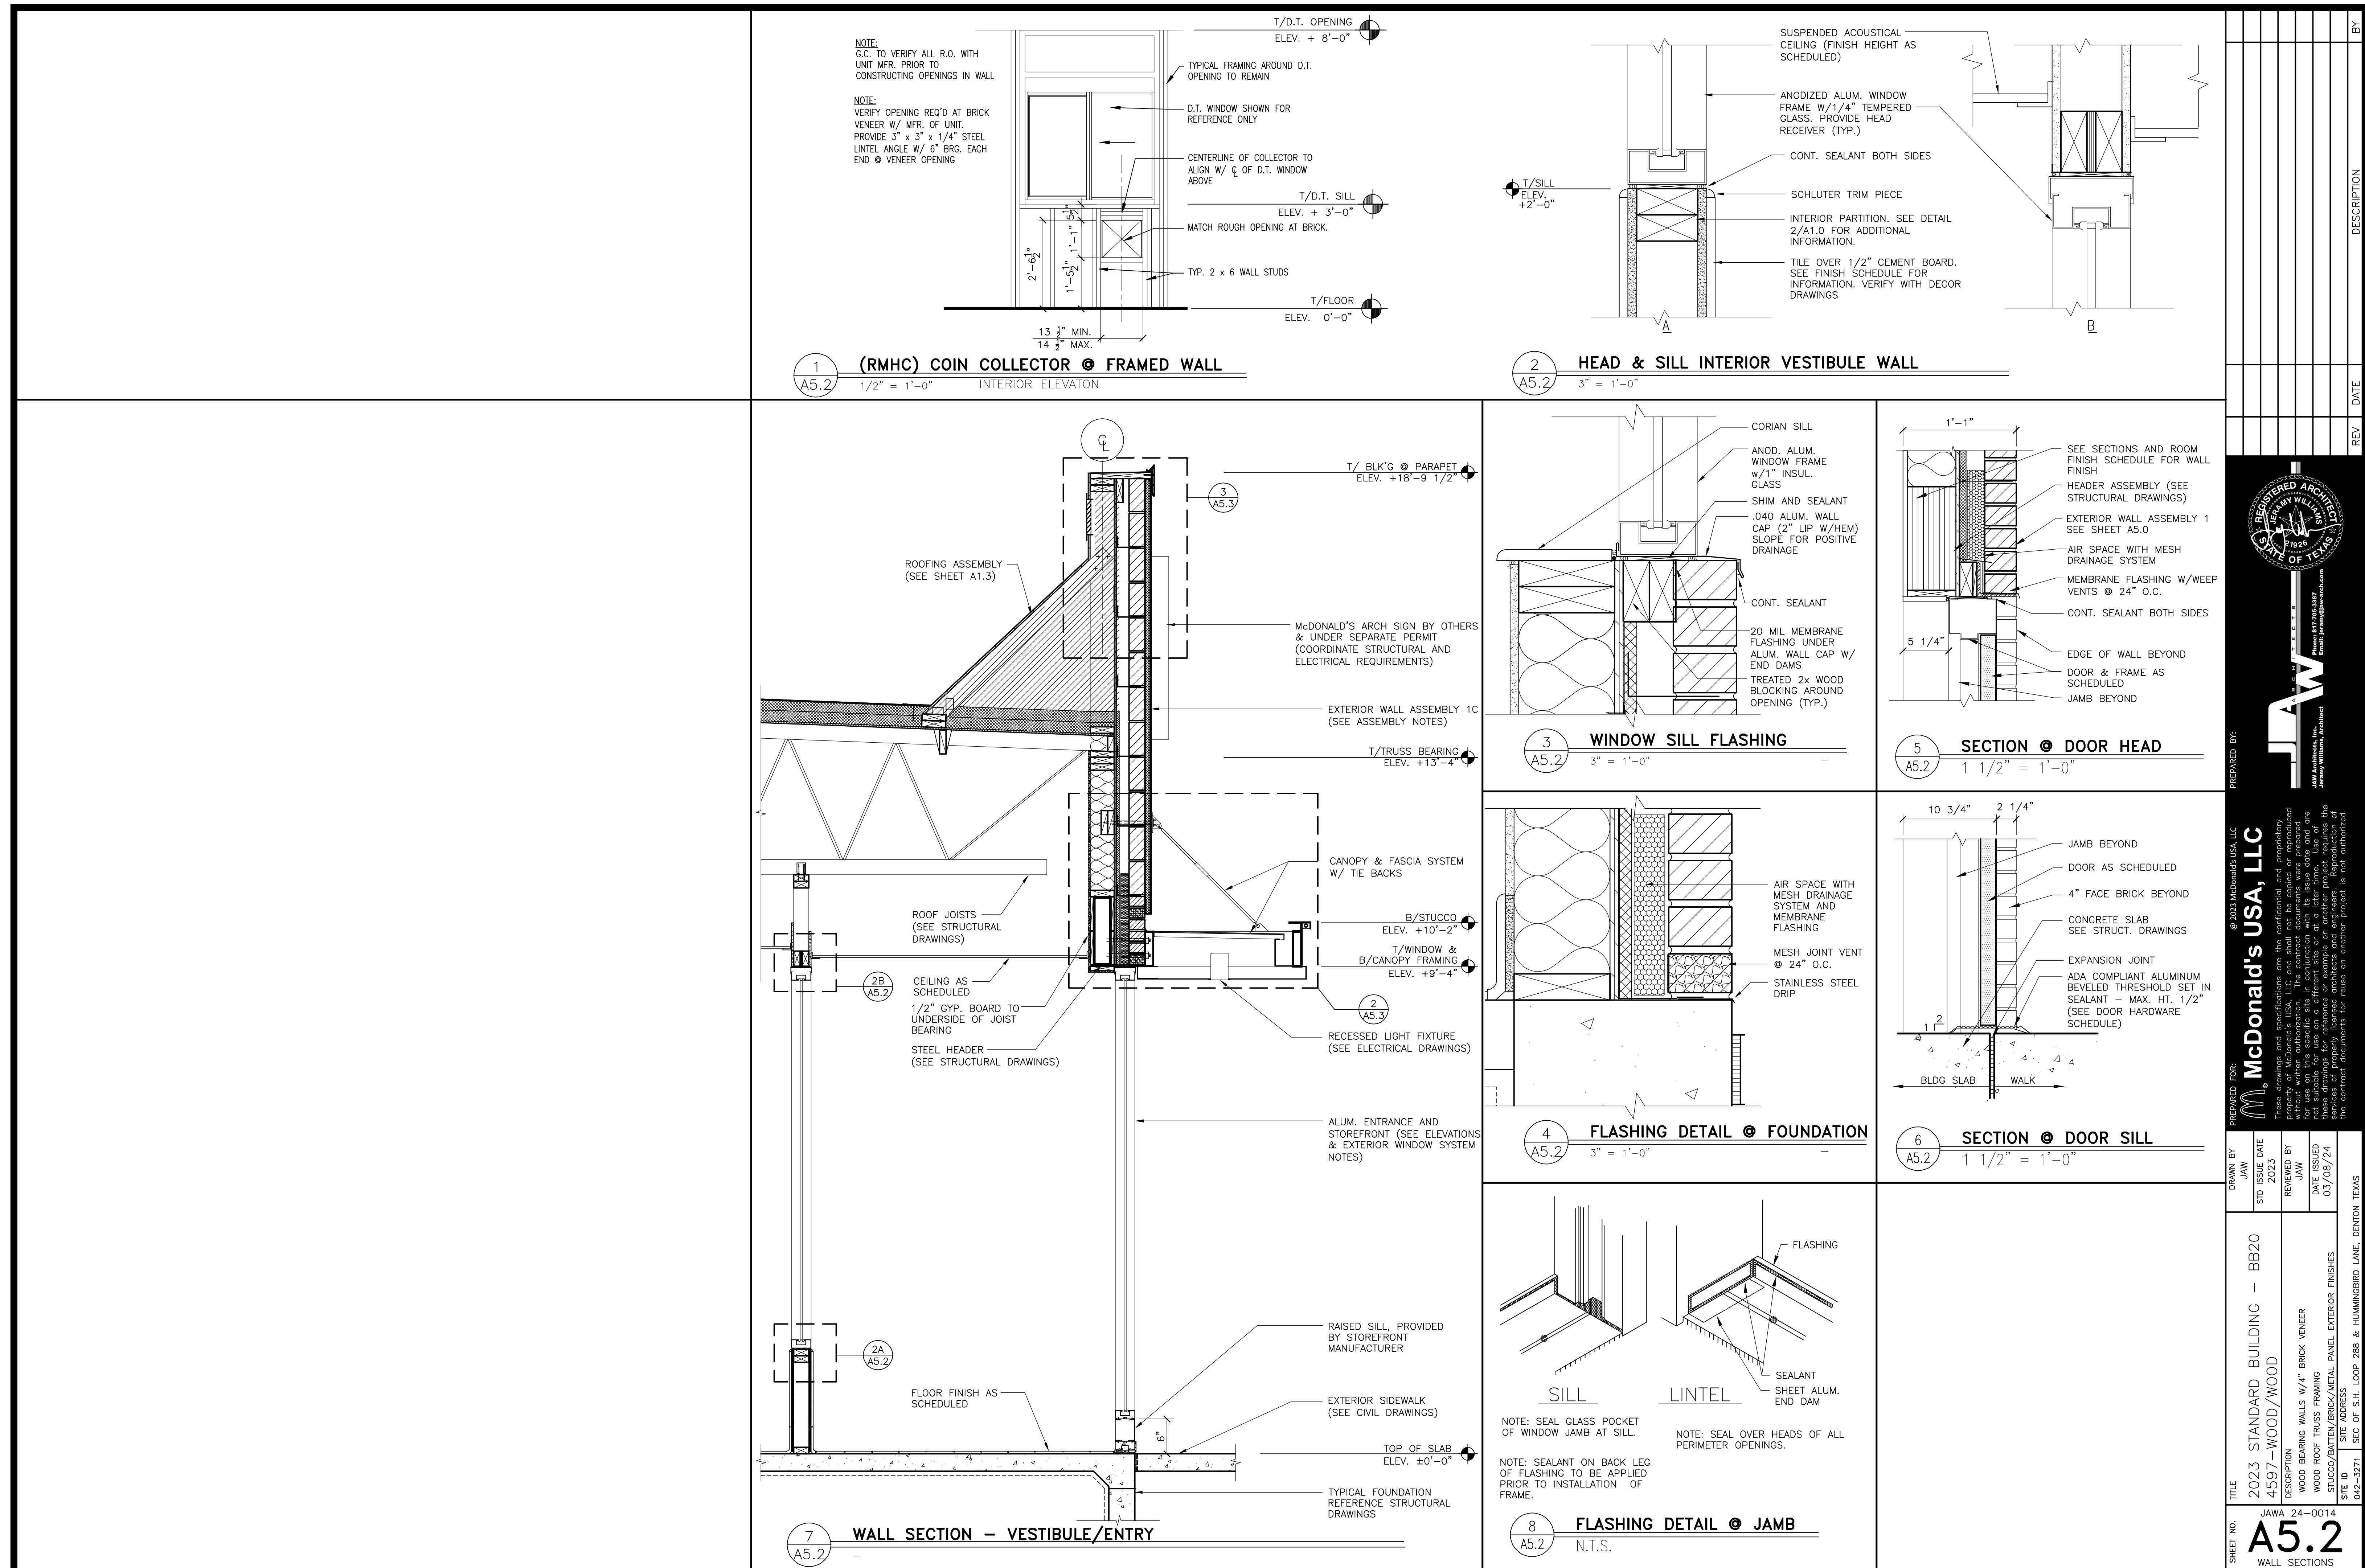


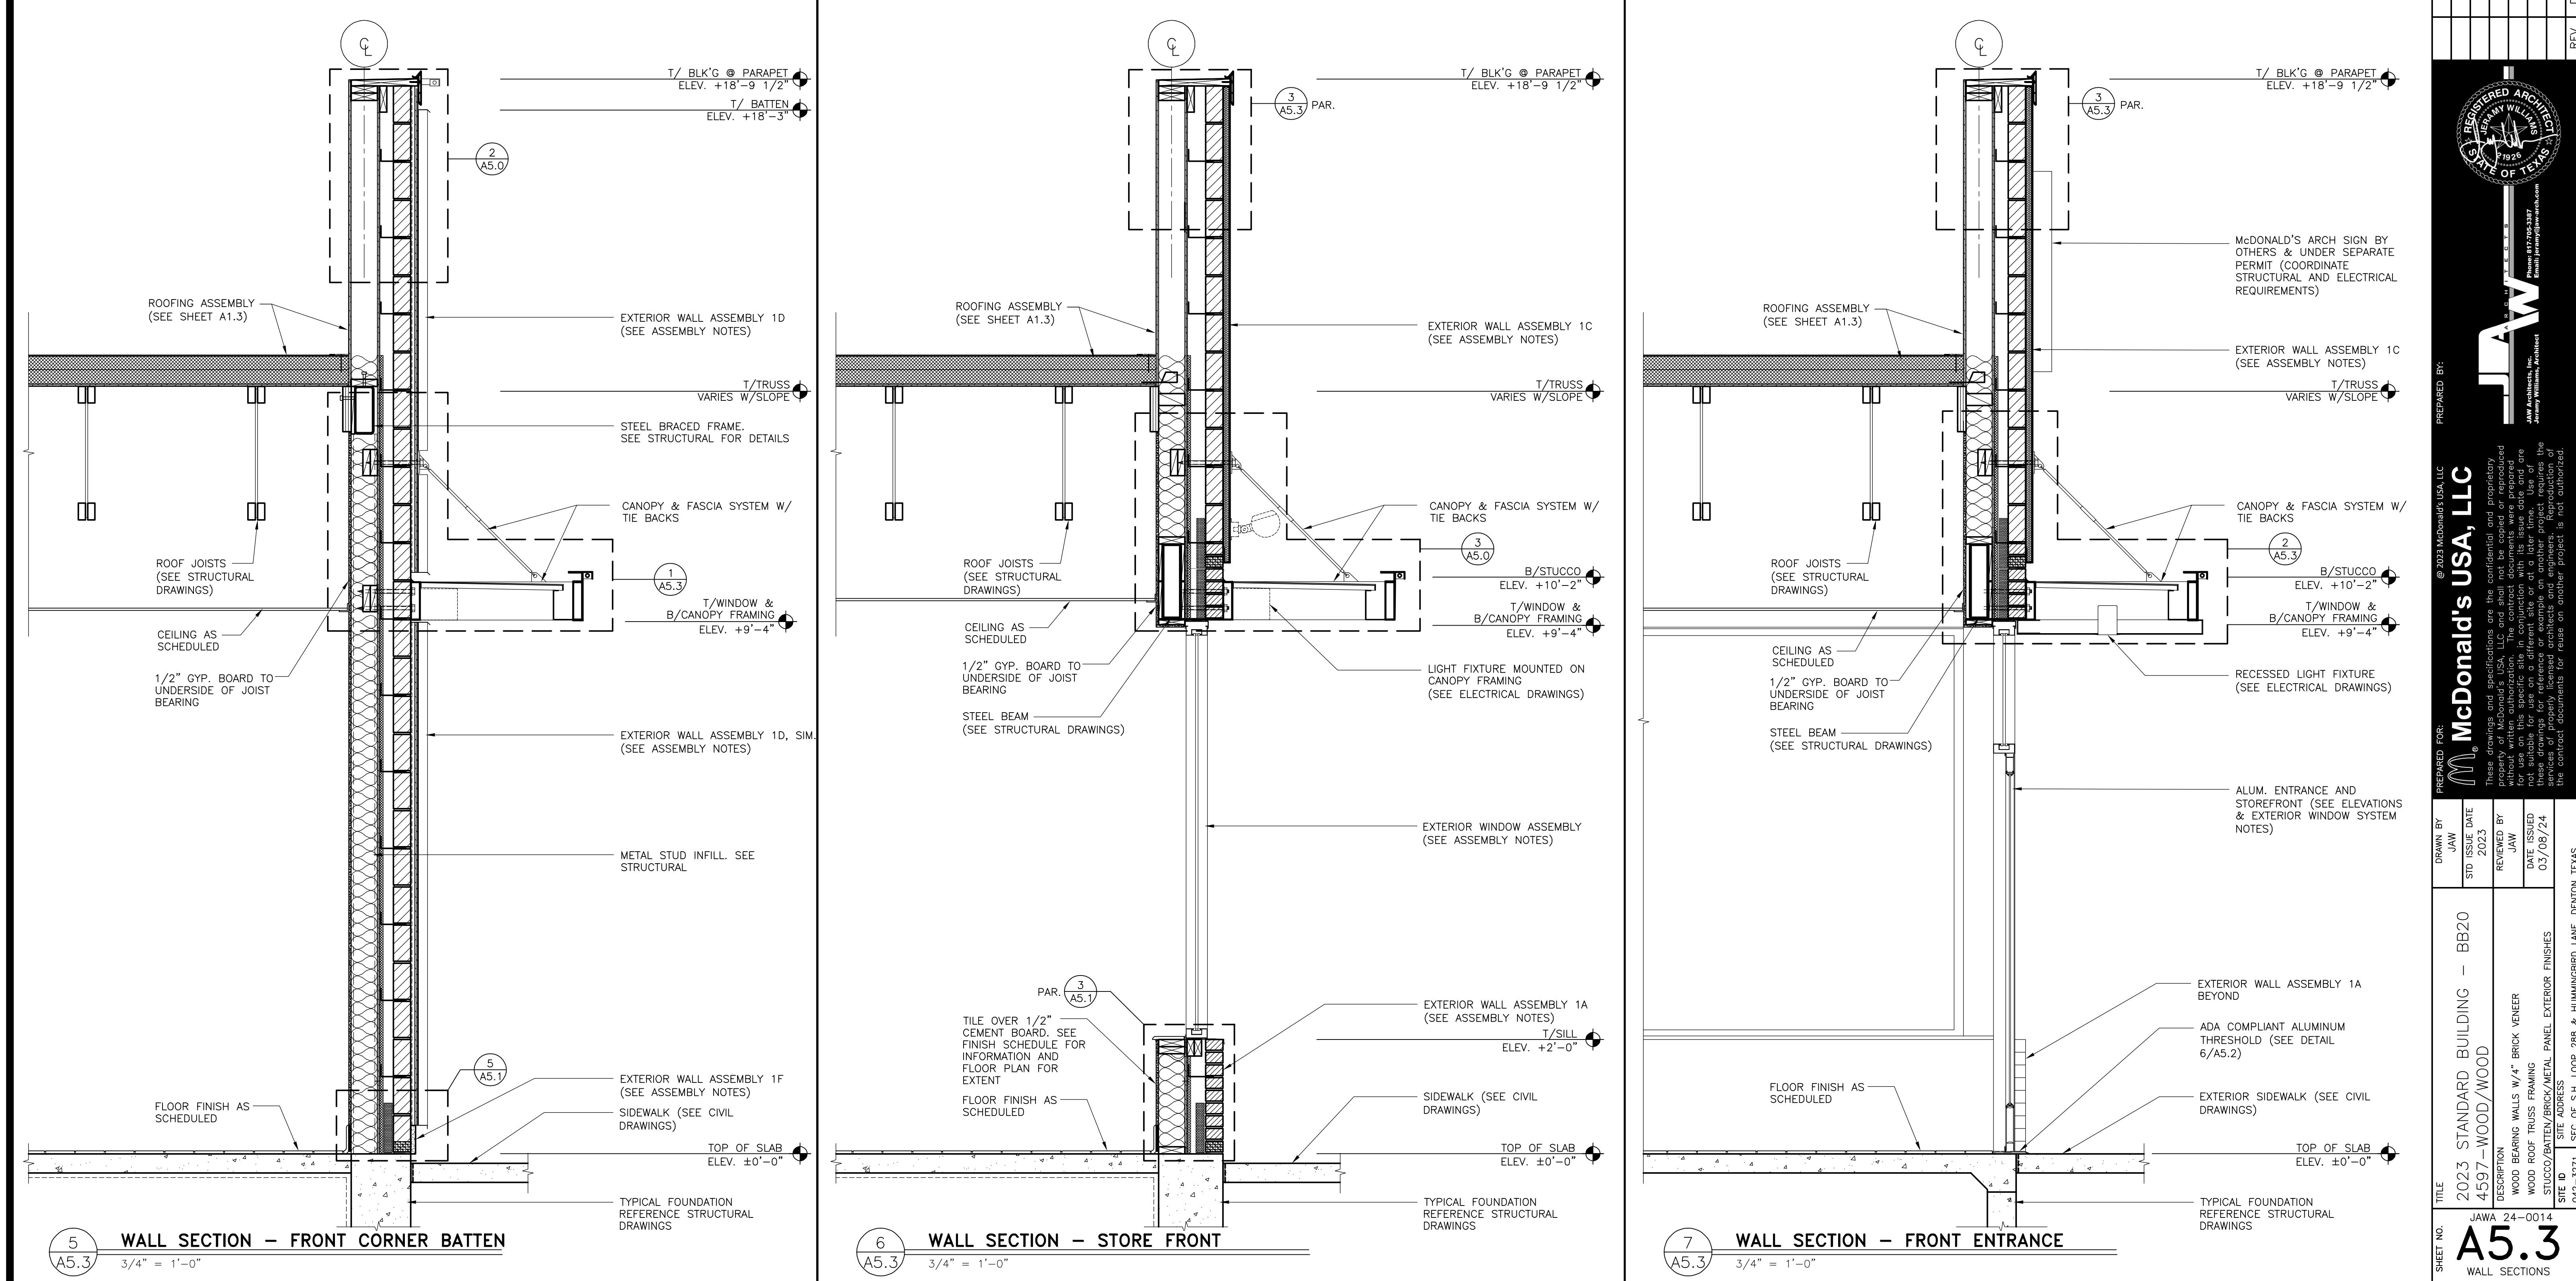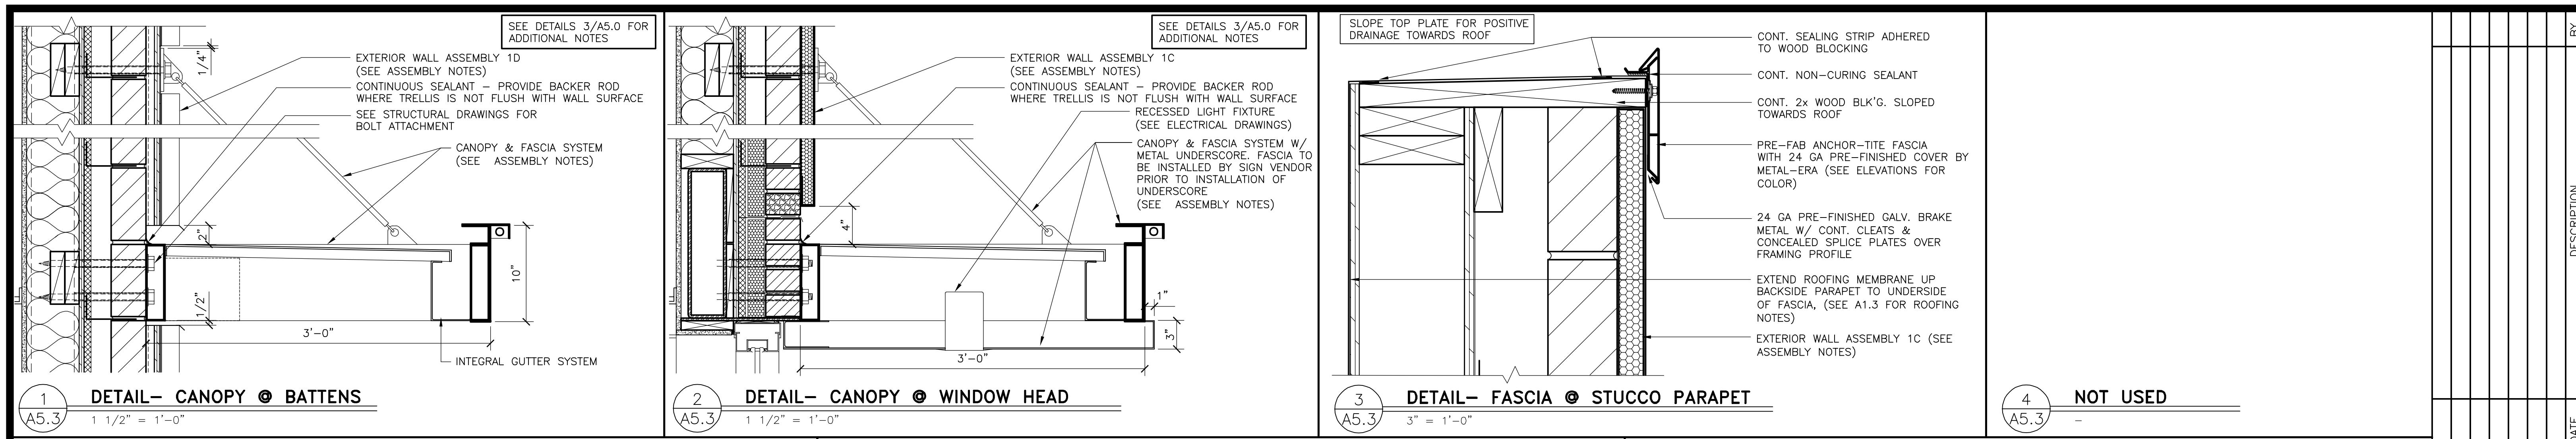

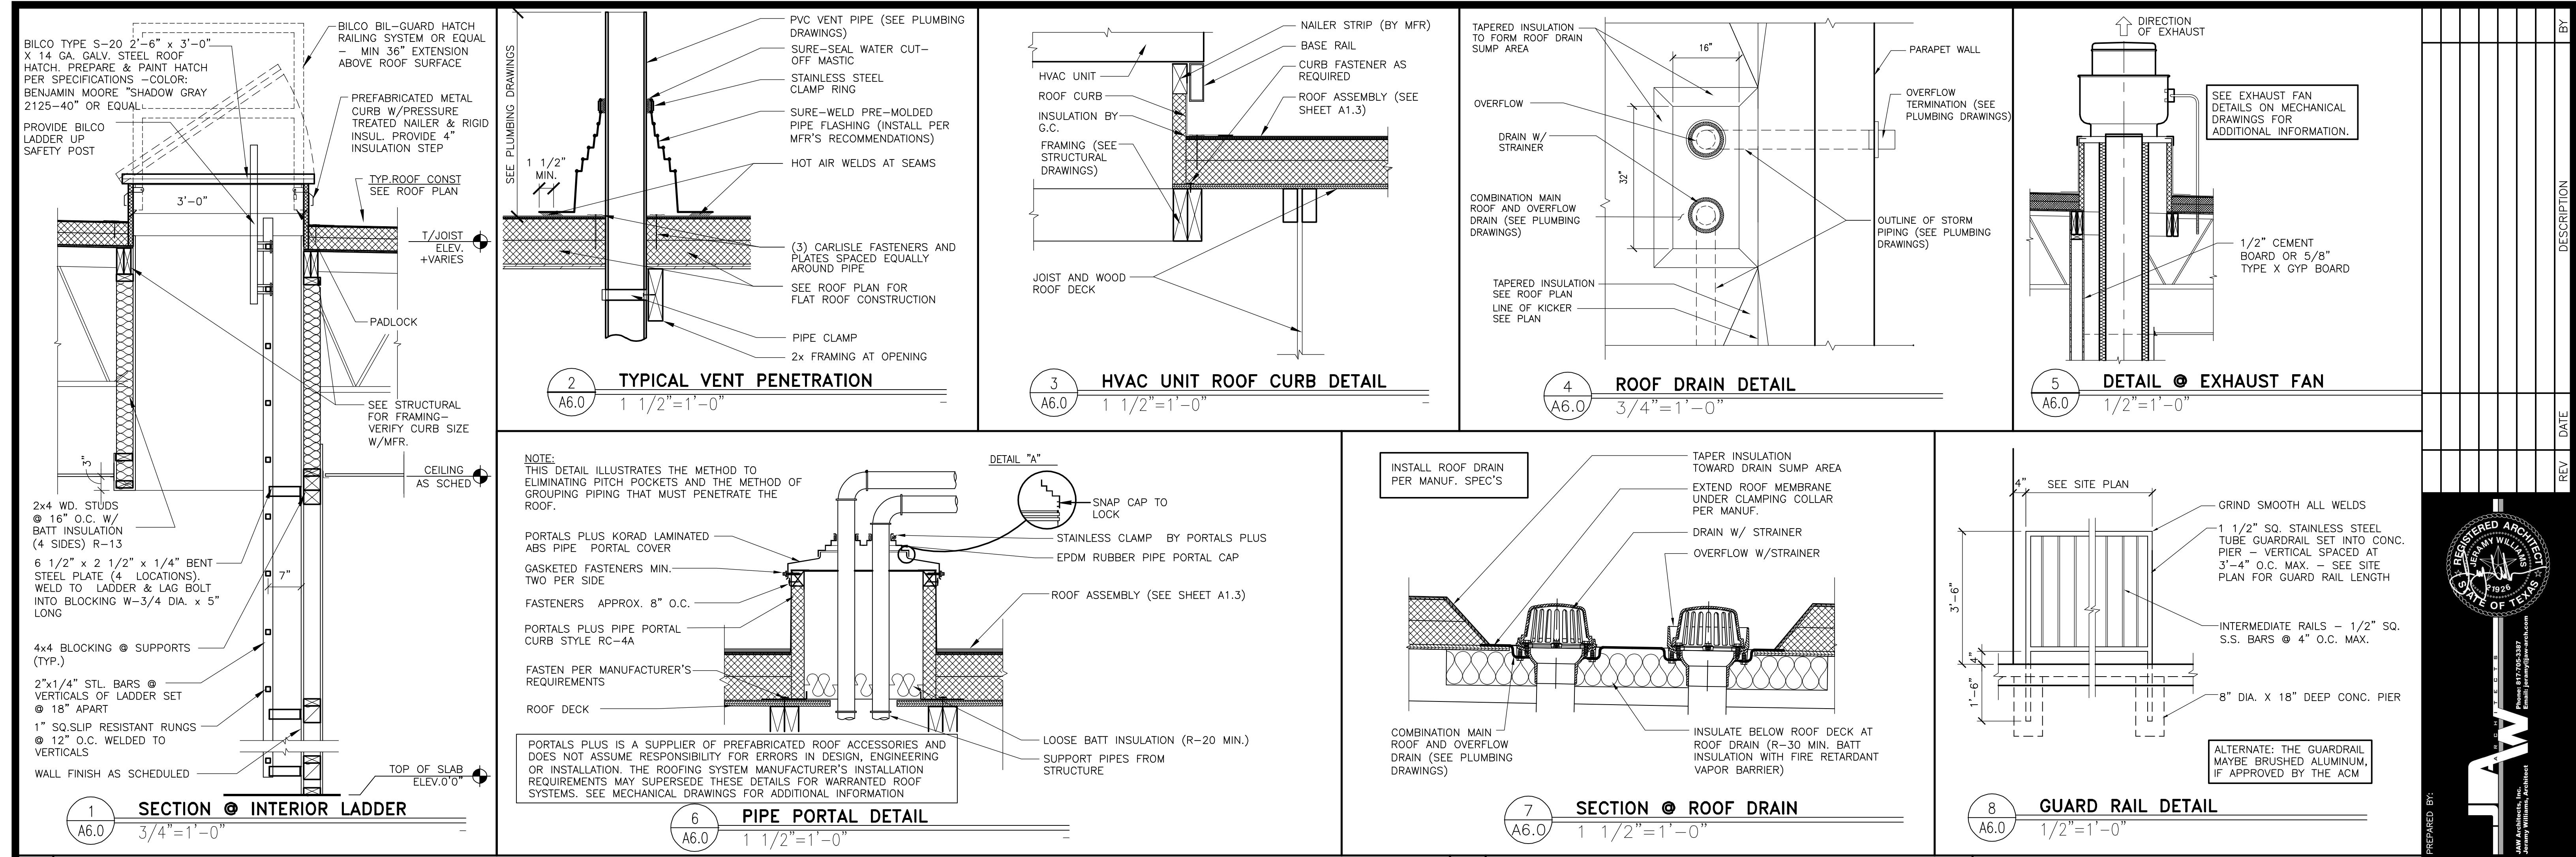


DOOR HARDWARE		DOOR SCHEDULE				DOOR TYPES	
1. EA HINGE 780-112HD 83" ALUM HAGER 2. EA CLOSER 4111 H-CUSH ALUM LCN 3. EA PANIC 9975EO-LD 48" SP28 V.DUPRIN 4. EA TRIM 990DT US260 V.DUPRIN 5. EA ALARM LOCK PG21MSS ALARM 6. EA TREADPLATE 24 X 46 UMC0 7. EA WTH/STP 160V 48 X 84 N.GUARD 8. EA THRESHOLD 325HD 48" N.GUARD 9. EA SWEEP 101VA 48" N.GUARD 10. EA SWEEP 101VA 36" N.GUARD 11. EA VIEW FRAME LVGLFD 9 X 9 DKB W/FLAP ON INSIDE N.GUARD 12. EA MORTISE CYL HOUSING 7PIN SFC 626 13. EA 7 PIN CONSTRUCTION CORE FOR ABOVE 626 14. EA CONTROL KEY FOR ABOVE	DOOR #5 - RESTROOM ENTRY 1. 3 EA HINGE BB1279 4 1/2 X 4 1/2 US260 HAGER 2. 1 EA CLOSER LDP4031 SNB ALUM LCN 3. 1 EA PUSH PLATE 30S 4 X 32 US320 40" AFF DECORATED TO CENTER OF PLATE 4. 1 EA PULL PLATE LADDER PULL HANDLE FOR DECORATIVE FIXING, 32" L 1" DIA #5-2000 - UMC0 32D. 40" AFF MOUNTED CENTER OF PULL ALT. OPTION: 1 EA PULLPLATE SANITGRASP ALT. OPTION: 1 EA PULL- PUSH BUTTON CYLINDRICAL LOCK - TRILOGY DL2700 US260 CHROME 5. 2 EA KICKPLATE 190S 8 X 34 US320 HAGER 6. 1 EA DOOR STOP 236W US320 HAGER 7. 1 EA FINGER GRD MK1B PUSH SIDE BRN F.SAFE 8. 1 EA FINGER GRD MK1B PULL SIDE BRN F.SAFE 9. 1 EA STEPPNPL PULL SIDE (OPTIONAL) DOOR #6 - ADA STALL 1. 2 EA HINGE 1250 4 1/2 X 4 1/2 US260 HAGER 1. 1 EA HINGE BB1279 4 1/2 X 4 1/2 US260 HAGER 3. 1 EA DEADBOLT B571 X 10-087 214EFC 12 X 291 X 626 SCHLAGE 4. 2 EA BACK TO BACK LADDER PULL HANDLE, 16", 1" DIA #5-16-1000 BTB-UMCO 32D MOUNTED 6" FROM EDGE OF DOOR TO CENTER OF SCREWS - 28" MOUNTED 28" FROM TOP OF DOOR TO C/G OF PULL 5. 1 EA ROBE HOOK 917 BRADLEY 6. 1 EA DOOR STOP 236W US320 HAGER DOOR #6A - STANDARD STALL 1. 2 EA HINGE 1250 4 1/2 X 4 1/2 US260 HAGER 2. 1 EA HINGE BB1279 4 1/2 X 4 1/2 US260 HAGER 3. 1 EA DEADBOLT B571 X 10-087 214EFC 12 X 291 X 626 SCHLAGE 4. 2 EA BACK TO BACK LADDER PULL HANDLE, 16", 1" DIA #5-16-1000 BTB-UMCO 32D MOUNTED 6" FROM EDGE OF DOOR TO CENTER OF SCREWS - 28" MOUNTED 28" FROM TOP OF DOOR TO C/G OF PULL 5. 1 EA ROBE HOOK 917 BRADLEY 6. 1 EA DOOR STOP 236W US320 HAGER DOOR #7 - DINING ROOM JANITORS CLOSET 1. 3 EA HINGE BB1279 4 1/2 X 4 1/2 US260 HAGER 2. 1 EA LOCK ND80PD RH 626 SCHLAGE DOOR #8 - COMPUTER CLOSET (NOT USED) 1. 4 EA HINGE BB1279 4 1/2 X 4 1/2 US260 HAGER 2. 1 EA LOCK ND80PD RH 626 SCHLAGE DOOR #8A - COMPUTER CLOSET 1. 8 EA HINGE BB1279 4 1/2 X 4 1/2 US260 HAGER 2. 1 EA LOCK ND80PD RH 626 SCHLAGE 3. 2 EA FLUSH BOLT 283D US260 HAGER DOOR #9 - COOLER 1. ALL DOOR HARDWARE FOR THE REFRIGERATED COOLER / FREEZER SHALL BE PROVIDED BY THE MANUFACTURER. MANUFACTURER: KELLOGG'S, INC., 641 N. MCCORKLE PARK ROAD, KELLOGGSONS, TN 38363 PHONE: 800-344-4675 HARDWARE PROVIDED: 1. MAGNETIC PERIMETER DOOR GASKET 2. THRESHOLD REINFORCED PLASTIC (FRP) 3. POSI-SEAL DOOR CLOSURE 4. STATIONARY CHROME DOOR PULL HANDLE 5. INTERIOR SAFETY RELEASE HANDLE 6. HINGES - BRUSHED CHROME CAST ALLOY DOOR #10 - RESTROOM ENTRY 1. 3 EA HINGE BB1279 4 1/2 X 4 1/2 US260 HAGER 2. 1 EA CLOSER LDP4031 SNB ALUM LCN 3. 1 EA LOCK ND80PD RH 626 SCHLAGE 4. 1 EA VIEW FRAME LFR100 8 X 34 DKB N.GUARD 5. 1 EA GLASS 7 X 33 X 1/4 UMC0 DOOR #11 (NOT USED) PLAYPLACE RESTROOM 1. 3 EA HINGE BB1279 4 1/2 X 4 1/2 US260 HAGER 2. 1 EA CLOSER LDP4031 SNB ALUM LCN 3. 1 EA LOCK ND80PD RH 626 SCHLAGE 4. 1 EA KICKPLATE 190S 8 X 34 US28 HAGER 5. 1 EA DOOR STOP 236W US320 HAGER 6. 2 EA TOF GUARD 202NA 36" N.GUARD 7. 1 EA FINGER GRD MK1B PUSH SIDE BRN F.SAFE 8. 1 EA FINGER GRD MK1B PULL SIDE BRN F.SAFE DOOR #12 (EMERGENCY EXIT ONLY) (NOT USED) - PLAYPLACE EMERGENCY EXIT 1. 1 EA CLOSER LCN 4041 X 18 2. 3 EA HINGES OFFSET PIVOT ANSI -A-156.4 GRADE 1; PROVIDE EXPOSED PARTS OF CAST ALUMINUM PIVOT ASSEMBLY 3. 1 EA (DOOR #1 ONLY) PULL HANDLE ROCKWOOD MFG. MODEL: RM3311. SIZE: 1-1/4" DIA CTC, 5'-10". FINISH: TO MATCH STOREFRONT DOOR. OFFSET MOUNTING: TYPE 1XHD - THRU BOLT HEAVY DUTY 4. 1 EA (DOOR #1A ONLY) PANIC HARDWARE ADAMS RITE MFG. CO. 8800 SERIES WITH OUTSIDE CYLINDER (FINISH TO MATCH STOREFRONT DOOR) 5. 1 EA THRESHOLD NATIONAL GUARD PRODUCTS, INC. SADDLE TYPE THRESHOLD 325, 6. 1 EA WEATHER STRIPPING PREMIUM COMPRESSION WEATHER STRIPPING AGAINST FIXED STOPS, AT OTHER EDGES PROVIDE SLIDING WEATHER STRIPPING RETAINED IN ADJUSTABLE STRIP MORTISED INTO DOOR EDGE. PROVIDE EPDM OR VINYL GASKET WEATHER STRIPPING IN BOTTOM DOOR RAIL ADJUSTABLE FOR CONTACT W/ THRESHOLD. 7. 1 EA SIGN MOUNT ONTO DOOR TO READ "THIS DOOR MUST REMAIN UNLOCKED WHENEVER THE BUILDING IS OCCUPIED/DURING BUSINESS HOURS." DOOR #13 & #2A - VESTIBULE 1. 1 EA CLOSER LCN 4041 X 18 2. 3 EA HINGES OFFSET PIVOT ANSI -A-156.4 GRADE 1; BY DOOR MANUFACTURER. 3. 1 EA PUSH/PULL HANDLE HAGER PUSH/PULL SET 1640/V.B. 4. 1 EA (DOOR #2A) PANIC HARDWARE ADAMS RITE MFG. CO. 8800 SERIES WITH OUTSIDE CYLINDER (FINISH TO MATCH STOREFRONT DOOR) DOOR #14 - STORAGE DELIVERY 1. 1 EA HINGE 780-112HD 83" ALUM HAGER 2. 1 EA CLOSER 4111 H-CUSH ALUM LCN 3. 1 EA PANIC 9975EO-LD 48" SP28 V.DUPRIN 4. 1 EA TRIM 990DT US260 V.DUPRIN 5. 1 EA ALARM LOCK PG21MSS ALARM 6. 1 EA TREADPLATE 24 X 46 UMC0 8. 1 EA WTH/STP 160V 48 X 84 N.GUARD 9. 1 EA THRESHOLD 325HD 48" N.GUARD 10. 1 EA SWEEP 101VA 48" N.GUARD 11. 1 EA VIEW FRAME LVGLFD 9 X 9 DKB W/FLAP ON INSIDE N.GUARD 12. 1 EA MORTISE CYL HOUSING 7PIN SFC 626 13. 1 EA 7 PIN CONSTRUCTION CORE FOR ABOVE 626 14. 1 EA CONTROL KEY FOR ABOVE DOOR #15 - REAR EXIT 1. 1 EA HINGE 780-112HD 83" ALUM HAGER 2. 1 EA CLOSER 4111 H-CUSH ALUM LCN 3. 1 EA PANIC 9975EO-LD 48" SP28 V.DUPRIN 4. 1 EA TRIM 990DT US260 V.DUPRIN 5. 1 EA ALARM LOCK PG21MSS ALARM 6. 1 EA LOCKGUARD CLP110 US320 DON-JO 7. 1 EA TREADPLATE 24 X 34 UMC0 8. 1 EA WTH/STP 160V 36 X 84 N.GUARD 9. 1 EA THRESHOLD 325HD 48" N.GUARD 10. 1 EA SWEEP 101VA 36" N.GUARD 11. 1 EA VIEW FRAME LVGLFD 9 X 9 DKB W/FLAP ON INSIDE N.GUARD 12. 1 EA MORTISE CYL HOUSING 7PIN SFC 626 13. 1 EA 7 PIN CONSTRUCTION CORE FOR ABOVE 626 14. 1 EA CONTROL KEY FOR ABOVE	GENERAL NOTES: 1. ALL EXIT DOORS SHALL BE KEYLESS IN THE DIRECTION OF EGRESS. 2. THE OPENING FORCE OF ALL EXT. PUSH/PULL DOORS SHALL NOT EXCEED 8 1/2 LBS. 3. THE OPENING FORCE OF ALL INTERIOR PUSH/PULL DOORS SHALL NOT EXCEED 5 LBS. 4. PROVIDE PANIC HARDWARE FOR ALL EXTERIOR DOORS AS NOTED ON THE DOOR SCHEDULE. 5. DOOR HARDWARE SHALL NOT REQUIRE TIGHT GRASPING, TIGHT PINCHING OR TWISTING THE WRIST TO OPERATE. DOOR #1 & #1A - ENTRY DOOR/EMERGENCY EXIT 1. 1 EA CLOSER LCN 4021 X 18 2. 3 EA HINGES OFFSET PIVOT ANSI -A-156.4 GRADE 1; PROVIDE EXPOSED PARTS OF CAST ALUMINUM PIVOT ASSEMBLY 3. 1 EA (DOOR #1 ONLY) PULL HANDLE ROCKWOOD MFG. MODEL: RM3311. SIZE: 1-1/4" DIA CTC, 5'-10". FINISH: TO MATCH STOREFRONT DOOR. OFFSET MOUNTING: TYPE 1XHD - THRU BOLT HEAVY DUTY 4. 1 EA (DOOR #1A ONLY) PANIC HARDWARE ADAMS RITE MFG. CO. 8800 SERIES WITH OUTSIDE CYLINDER (FINISH TO MATCH STOREFRONT DOOR) 5. 1 EA THRESHOLD NATIONAL GUARD PRODUCTS, INC. SADDLE TYPE THRESHOLD 325, 6. 1 EA WEATHER STRIPPING PREMIUM COMPRESSION WEATHER STRIPPING AGAINST FIXED STOPS, AT OTHER EDGES PROVIDE SLIDING WEATHER STRIPPING RETAINED IN ADJUSTABLE STRIP MORTISED INTO DOOR EDGE. PROVIDE EPDM OR VINYL GASKET WEATHER STRIPPING IN BOTTOM DOOR RAIL ADJUSTABLE FOR CONTACT W/ THRESHOLD. 7. 1 EA SIGN MOUNT ONTO DOOR TO READ "THIS DOOR MUST REMAIN UNLOCKED WHENEVER THE BUILDING IS OCCUPIED/DURING BUSINESS HOURS." DOOR #2 & #2A - VESTIBULE 1. 1 EA CLOSER LCN 4041 X 18 2. 3 EA HINGES OFFSET PIVOT ANSI -A-156.4 GRADE 1; BY DOOR MANUFACTURER. 3. 1 EA PUSH/PULL HANDLE HAGER PUSH/PULL SET 1640/V.B. 4. 1 EA (DOOR #2A) PANIC HARDWARE ADAMS RITE MFG. CO. 8800 SERIES WITH OUTSIDE CYLINDER (FINISH TO MATCH STOREFRONT DOOR) DOOR #3 - STORAGE DELIVERY 1. 1 EA HINGE 780-112HD 83" ALUM HAGER 2. 1 EA CLOSER 4111 H-CUSH ALUM LCN 3. 1 EA PANIC 9975EO-LD 48" SP28 V.DUPRIN 4. 1 EA TRIM 990DT US260 V.DUPRIN 5. 1 EA ALARM LOCK PG21MSS ALARM 6. 1 EA TREADPLATE 24 X 46 UMC0 8. 1 EA WTH/STP 160V 48 X 84 N.GUARD 9. 1 EA THRESHOLD 325HD 48" N.GUARD 10. 1 EA SWEEP 101VA 48" N.GUARD 11. 1 EA VIEW FRAME LVGLFD 9 X 9 DKB W/FLAP ON INSIDE N.GUARD 12. 1 EA MORTISE CYL HOUSING 7PIN SFC 626 13. 1 EA 7 PIN CONSTRUCTION CORE FOR ABOVE 626 14. 1 EA CONTROL KEY FOR ABOVE DOOR #4 - REAR EXIT 1. 1 EA HINGE 780-112HD 83" ALUM HAGER 2. 1 EA CLOSER 4111 H-CUSH ALUM LCN 3. 1 EA PANIC 9975EO-LD 48" SP28 V.DUPRIN 4. 1 EA TRIM 990DT US260 V.DUPRIN 5. 1 EA ALARM LOCK PG21MSS ALARM 6. 1 EA LOCKGUARD CLP110 US320 DON-JO 7. 1 EA TREADPLATE 24 X 34 UMC0 8. 1 EA WTH/STP 160V 36 X 84 N.GUARD 9. 1 EA THRESHOLD 325HD 48" N.GUARD 10. 1 EA SWEEP 101VA 36" N.GUARD 11. 1 EA VIEW FRAME LVGLFD 9 X 9 DKB W/FLAP ON INSIDE N.GUARD 12. 1 EA MORTISE CYL HOUSING 7PIN SFC 626 13. 1 EA 7 PIN CONSTRUCTION CORE FOR ABOVE 626 14. 1 EA CONTROL KEY FOR ABOVE	DOOR #5 - RESTROOM ENTRY 1. 1 EA HINGE 780-112HD 83" ALUM HAGER 2. 1 EA CLOSER LDP4031 SNB ALUM LCN 3. 1 EA PUSH PLATE 30S 4 X 32 US320 40" AFF DECORATED TO CENTER OF PLATE 4. 1 EA PULL PLATE LADDER PULL HANDLE FOR DECORATIVE FIXING, 32" L 1" DIA #5-2000 - UMC0 32D. 40" AFF MOUNTED CENTER OF PULL ALT. OPTION: 1 EA PULLPLATE SANITGRASP ALT. OPTION: 1 EA PULL- PUSH BUTTON CYLINDRICAL LOCK - TRILOGY DL2700 US260 CHROME 5. 2 EA KICKPLATE 190S 8 X 34 US320 HAGER 6. 1 EA DOOR STOP 236W US320 HAGER 7. 1 EA FINGER GRD MK1B PUSH SIDE BRN F.SAFE 8. 1 EA FINGER GRD MK1B PULL SIDE BRN F.SAFE 9. 1 EA STEPPNPL PULL SIDE (OPTIONAL) DOOR #6 - ADA STALL 1. 2 EA HINGE 1250 4 1/2 X 4 1/2 US260 HAGER 1. 1 EA HINGE BB1279 4 1/2 X 4 1/2 US260 HAGER 3. 1 EA DEADBOLT B571 X 10-087 214EFC 12 X 291 X 626 SCHLAGE 4. 2 EA BACK TO BACK LADDER PULL HANDLE, 16", 1" DIA #5-16-1000 BTB-UMCO 32D MOUNTED 6" FROM EDGE OF DOOR TO CENTER OF SCREWS - 28" MOUNTED 28" FROM TOP OF DOOR TO C/G OF PULL 5. 1 EA ROBE HOOK 917 BRADLEY 6. 1 EA DOOR STOP 236W US320 HAGER DOOR #6A - STANDARD STALL 1. 2 EA HINGE 1250 4 1/2 X 4 1/2 US260 HAGER 2. 1 EA HINGE BB1279 4 1/2 X 4 1/2 US260 HAGER 3. 1 EA DEADBOLT B571 X 10-087 214EFC 12 X 291 X 626 SCHLAGE 4. 2 EA BACK TO BACK LADDER PULL HANDLE, 16", 1" DIA #5-16-1000 BTB-UMCO 32D MOUNTED 6" FROM EDGE OF DOOR TO CENTER OF SCREWS - 28" MOUNTED 28" FROM TOP OF DOOR TO C/G OF PULL 5. 1 EA ROBE HOOK 917 BRADLEY 6. 1 EA DOOR STOP 236W US320 HAGER DOOR #7 - DINING ROOM JANITORS CLOSET 1. 3 EA HINGE BB1279 4 1/2 X 4 1/2 US260 HAGER 2. 1 EA LOCK ND80PD RH 626 SCHLAGE DOOR #8 - COMPUTER CLOSET (NOT USED) 1. 4 EA HINGE BB1279 4 1/2 X 4 1/2 US260 HAGER 2. 1 EA LOCK ND80PD RH 626 SCHLAGE 3. 2 EA FLUSH BOLT 283D US260 HAGER DOOR #9 - COOLER 1. ALL DOOR HARDWARE FOR THE REFRIGERATED COOLER / FREEZER SHALL BE PROVIDED BY THE MANUFACTURER. MANUFACTURER: KELLOGG'S, INC., 641 N. MCCORKLE PARK ROAD, KELLOGGSONS, TN 38363 PHONE: 800-344-4675 HARDWARE PROVIDED: 1. MAGNETIC PERIMETER DOOR GASKET 2. THRESHOLD REINFORCED PLASTIC (FRP) 3. POSI-SEAL DOOR CLOSURE 4. STATIONARY CHROME DOOR PULL HANDLE 5. INTERIOR SAFETY RELEASE HANDLE 6. HINGES - BRUSHED CHROME CAST ALLOY DOOR #10 - RESTROOM ENTRY 1. 3 EA HINGE BB1279 4 1/2 X 4 1/2 US260 HAGER 2. 1 EA CLOSER LDP4031 SNB ALUM LCN 3. 1 EA LOCK ND80PD RH 626 SCHLAGE 4. 1 EA VIEW FRAME LFR100 8 X 34 DKB N.GUARD 5. 1 EA GLASS 7 X 33 X 1/4 UMC0 DOOR #11 (NOT USED) PLAYPLACE RESTROOM 1. 3 EA HINGE BB1279 4 1/2 X 4 1/2 US260 HAGER 2. 1 EA CLOSER LDP4031 SNB ALUM LCN 3. 1 EA LOCK ND80PD RH 626 SCHLAGE 4. 1 EA KICKPLATE 190S 8 X 34 US28 HAGER 5. 1 EA DOOR STOP 236W US320 HAGER 6. 2 EA TOF GUARD 202NA 36" N.GUARD 7. 1 EA FINGER GRD MK1B PUSH SIDE BRN F.SAFE 8. 1 EA FINGER GRD MK1B PULL SIDE BRN F.SAFE DOOR #12 (EMERGENCY EXIT ONLY) (NOT USED) - PLAYPLACE EMERGENCY EXIT 1. 1 EA CLOSER LCN 4041 X 18 2. 3 EA HINGES OFFSET PIVOT ANSI -A-156.4 GRADE 1; BY DOOR MANUFACTURER. 3. 1 EA (DOOR #1A ONLY) PULL HANDLE ROCKWOOD MFG. MODEL: RM3311. SIZE: 1-1/4" DIA CTC, 5'-10". FINISH: TO MATCH STOREFRONT DOOR. OFFSET MOUNTING: TYPE 1XHD - THRU BOLT HEAVY DUTY 4. 1 EA (DOOR #1A ONLY) PANIC HARDWARE ADAMS RITE MFG. CO. 8800 SERIES WITH OUTSIDE CYLINDER (FINISH TO MATCH STOREFRONT DOOR) 5. 1 EA THRESHOLD NATIONAL GUARD PRODUCTS, INC. SADDLE TYPE THRESHOLD 325, 6. 1 EA WEATHER STRIPPING PREMIUM COMPRESSION WEATHER STRIPPING AGAINST FIXED STOPS, AT OTHER EDGES PROVIDE SLIDING WEATHER STRIPPING RETAINED IN ADJUSTABLE STRIP MORTISED INTO DOOR EDGE. PROVIDE EPDM OR VINYL GASKET WEATHER STRIPPING IN BOTTOM DOOR RAIL ADJUSTABLE FOR CONTACT W/ THRESHOLD. 7. 1 EA SIGN MOUNT ONTO DOOR TO READ "THIS DOOR MUST REMAIN UNLOCKED WHENEVER THE BUILDING IS OCCUPIED/DURING BUSINESS HOURS." DOOR #13 & #2A - VESTIBULE 1. 1 EA CLOSER LCN 4041 X 18 2. 3 EA HINGES OFFSET PIVOT ANSI -A-156.4 GRADE 1; BY DOOR MANUFACTURER. 3. 1 EA PUSH/PULL HANDLE HAGER PUSH/PULL SET 1640/V.B. 4. 1 EA (DOOR #2A) PANIC HARDWARE ADAMS RITE MFG. CO. 8800 SERIES WITH OUTSIDE CYLINDER (FINISH TO MATCH STOREFRONT DOOR) DOOR #14 - STORAGE DELIVERY 1. 1 EA HINGE 780-112HD 83" ALUM HAGER 2. 1 EA CLOSER 4111 H-CUSH ALUM LCN 3. 1 EA PANIC 9975EO-LD 48" SP28 V.DUPRIN 4. 1 EA TRIM 990DT US260 V.DUPRIN 5. 1 EA ALARM LOCK PG21MSS ALARM 6. 1 EA TREADPLATE 24 X 46 UMC0 8. 1 EA WTH/STP 160V 48 X 84 N.GUARD 9. 1 EA THRESHOLD 325HD 48" N.GUARD 10. 1 EA SWEEP 101VA 48" N.GUARD 11. 1 EA VIEW FRAME LVGLFD 9 X 9 DKB W/FLAP ON INSIDE N.GUARD 12. 1 EA MORTISE CYL HOUSING 7PIN SFC 626 13. 1 EA 7 PIN CONSTRUCTION CORE FOR ABOVE 626 14. 1 EA CONTROL KEY FOR ABOVE DOOR #15 - REAR EXIT 1. 1 EA HINGE 780-112HD 83" ALUM HAGER 2. 1 EA CLOSER 4111 H-CUSH ALUM LCN 3. 1 EA PANIC 9975EO-LD 48" SP28 V.DUPRIN 4. 1 EA TRIM 990DT US260 V.DUPRIN 5. 1 EA ALARM LOCK PG21MSS ALARM 6. 1 EA LOCKGUARD CLP110 US320 DON-JO 7. 1 EA TREADPLATE 24 X 34 UMC0 8. 1 EA WTH/STP 160V 36 X 84 N.GUARD 9. 1 EA THRESHOLD 325HD 48" N.GUARD 10. 1 EA SWEEP 101VA 36" N.GUARD 11. 1 EA VIEW FRAME LVGLFD 9 X 9 DKB W/FLAP ON INSIDE N.GUARD 12. 1 EA MORTISE CYL HOUSING 7PIN SFC 626 13. 1 EA 7 PIN CONSTRUCTION CORE FOR ABOVE 626 14. 1 EA CONTROL KEY FOR ABOVE	DRAWN BY JAW STD ISSUE DATE 2023 REVIEWED BY JAW DATE ISSUED 03/08/24 SHEET NO. A6.0 TITLE 2023 STANDARD BUILDING - BB20 DESCRIPTION 4.597-WOOD/WOOD PREPARED FOR McDonald's USA, LLC These drawings and specifications are the confidential and proprietary property of McDonald's USA, LLC and shall not be copied or reproduced without the express			

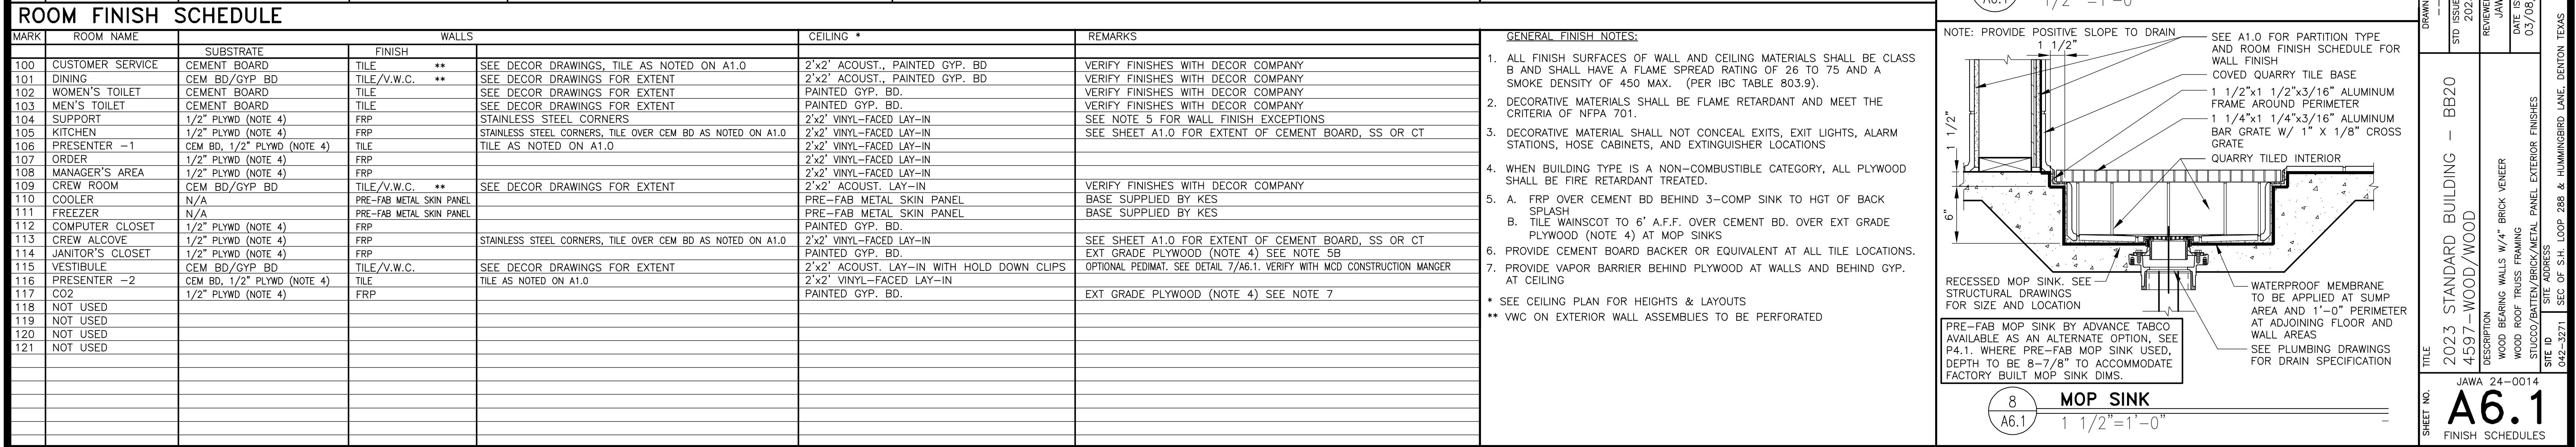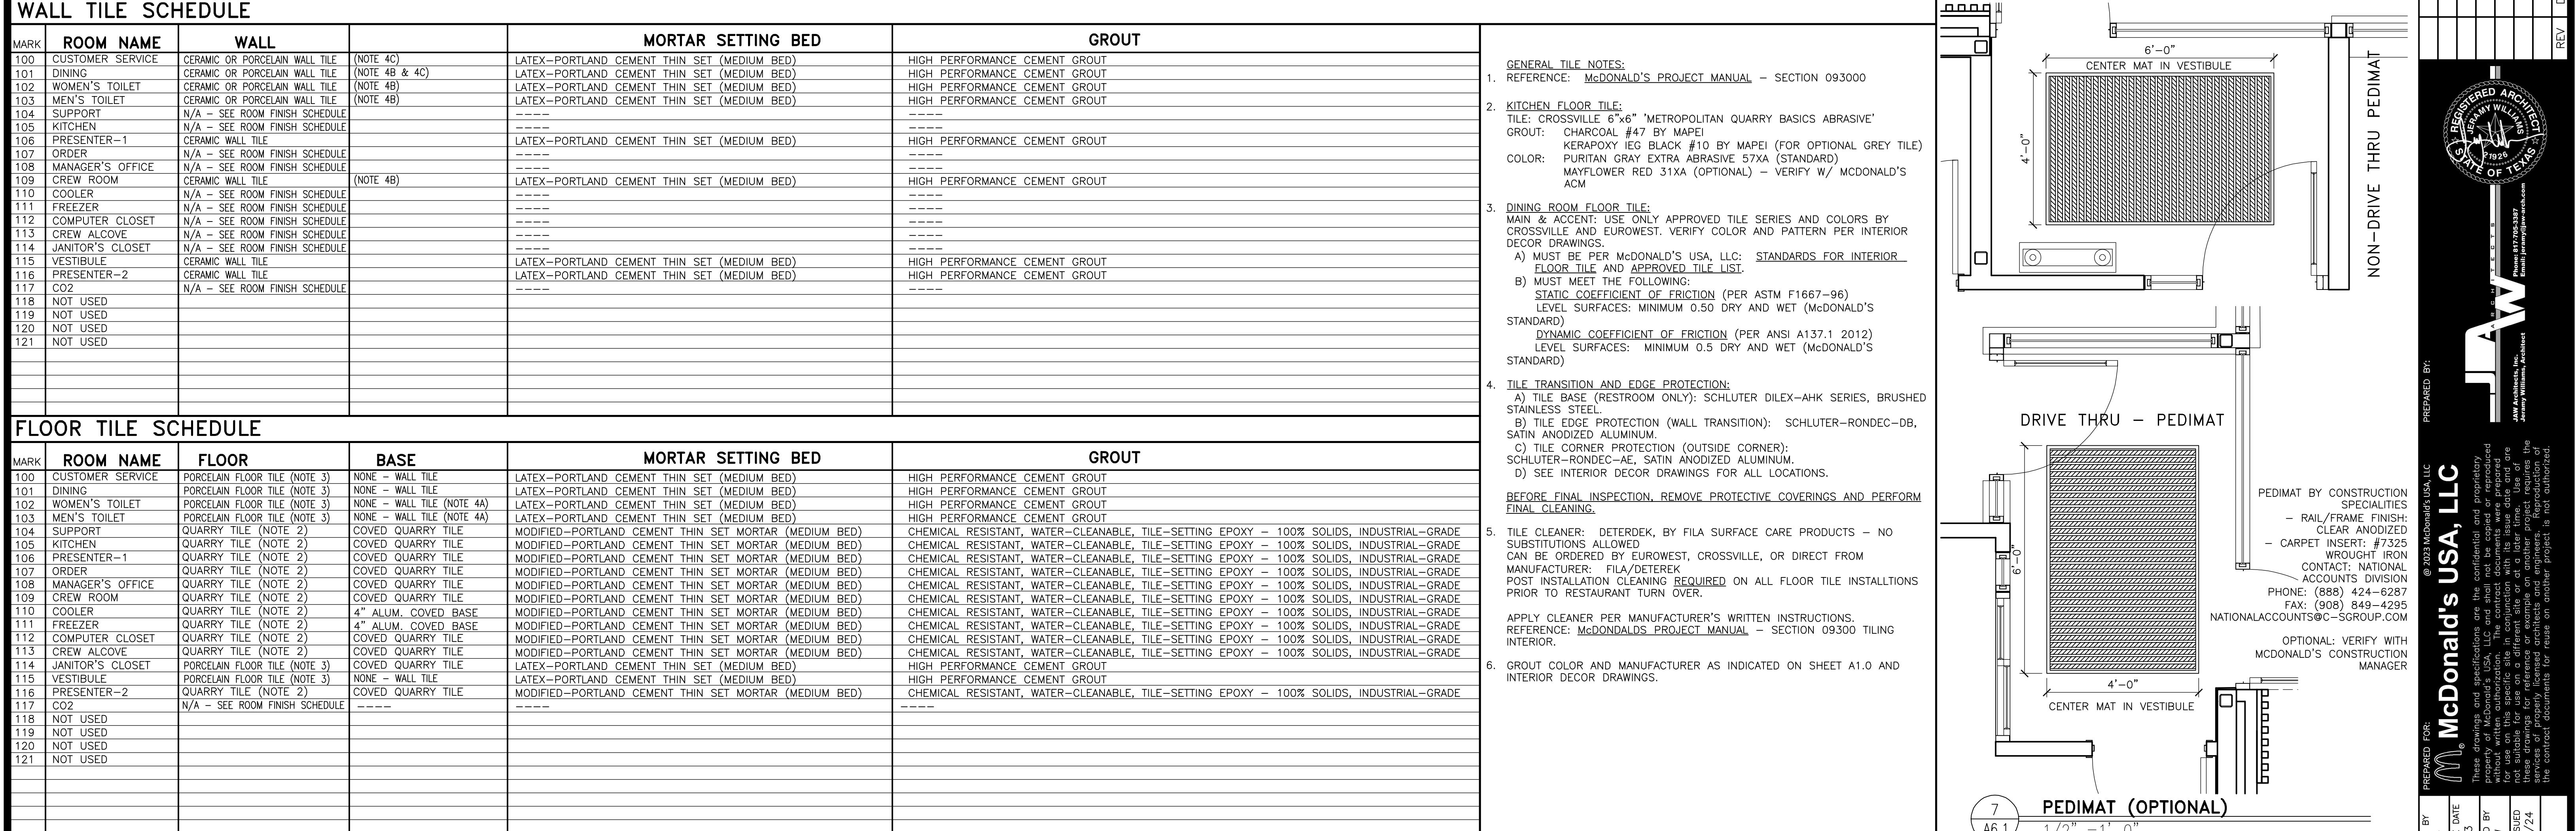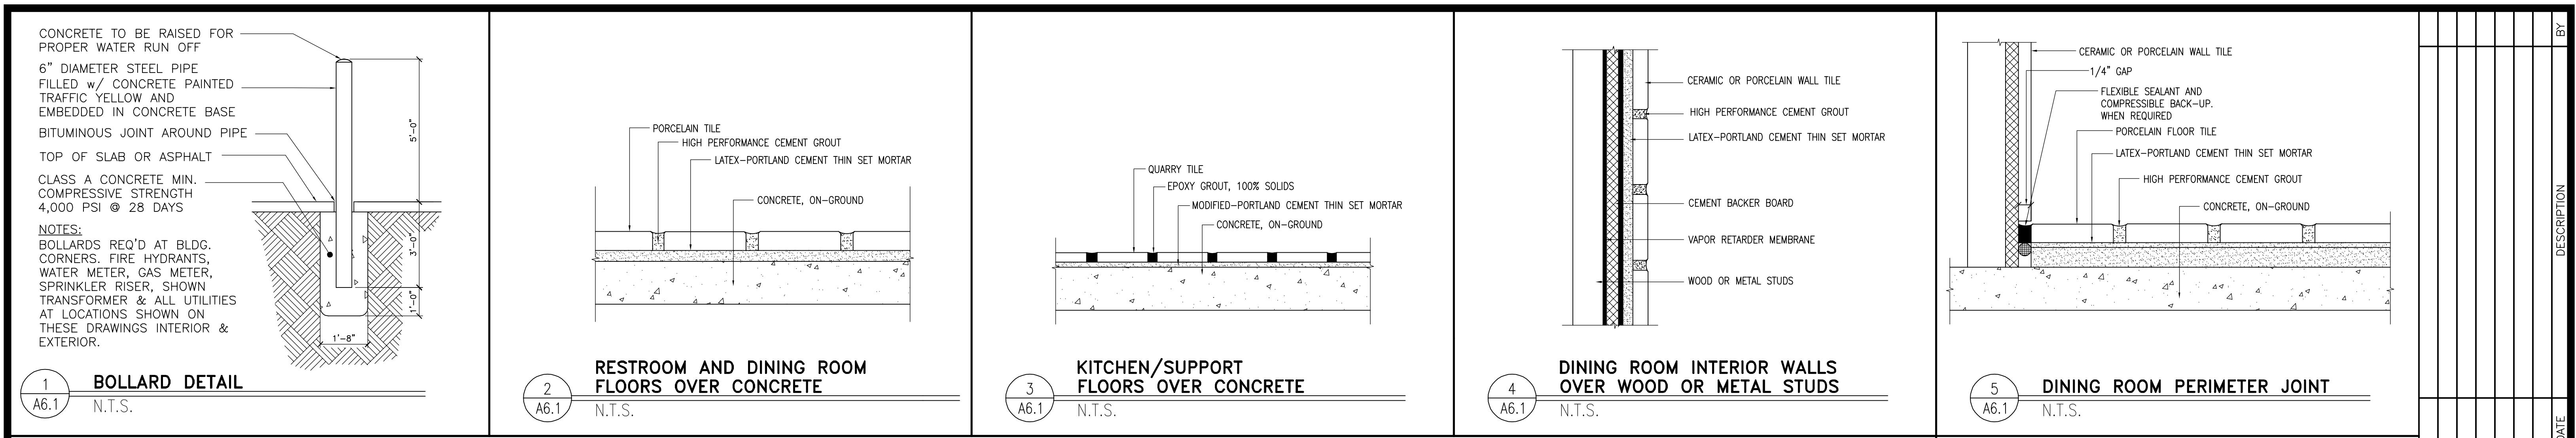


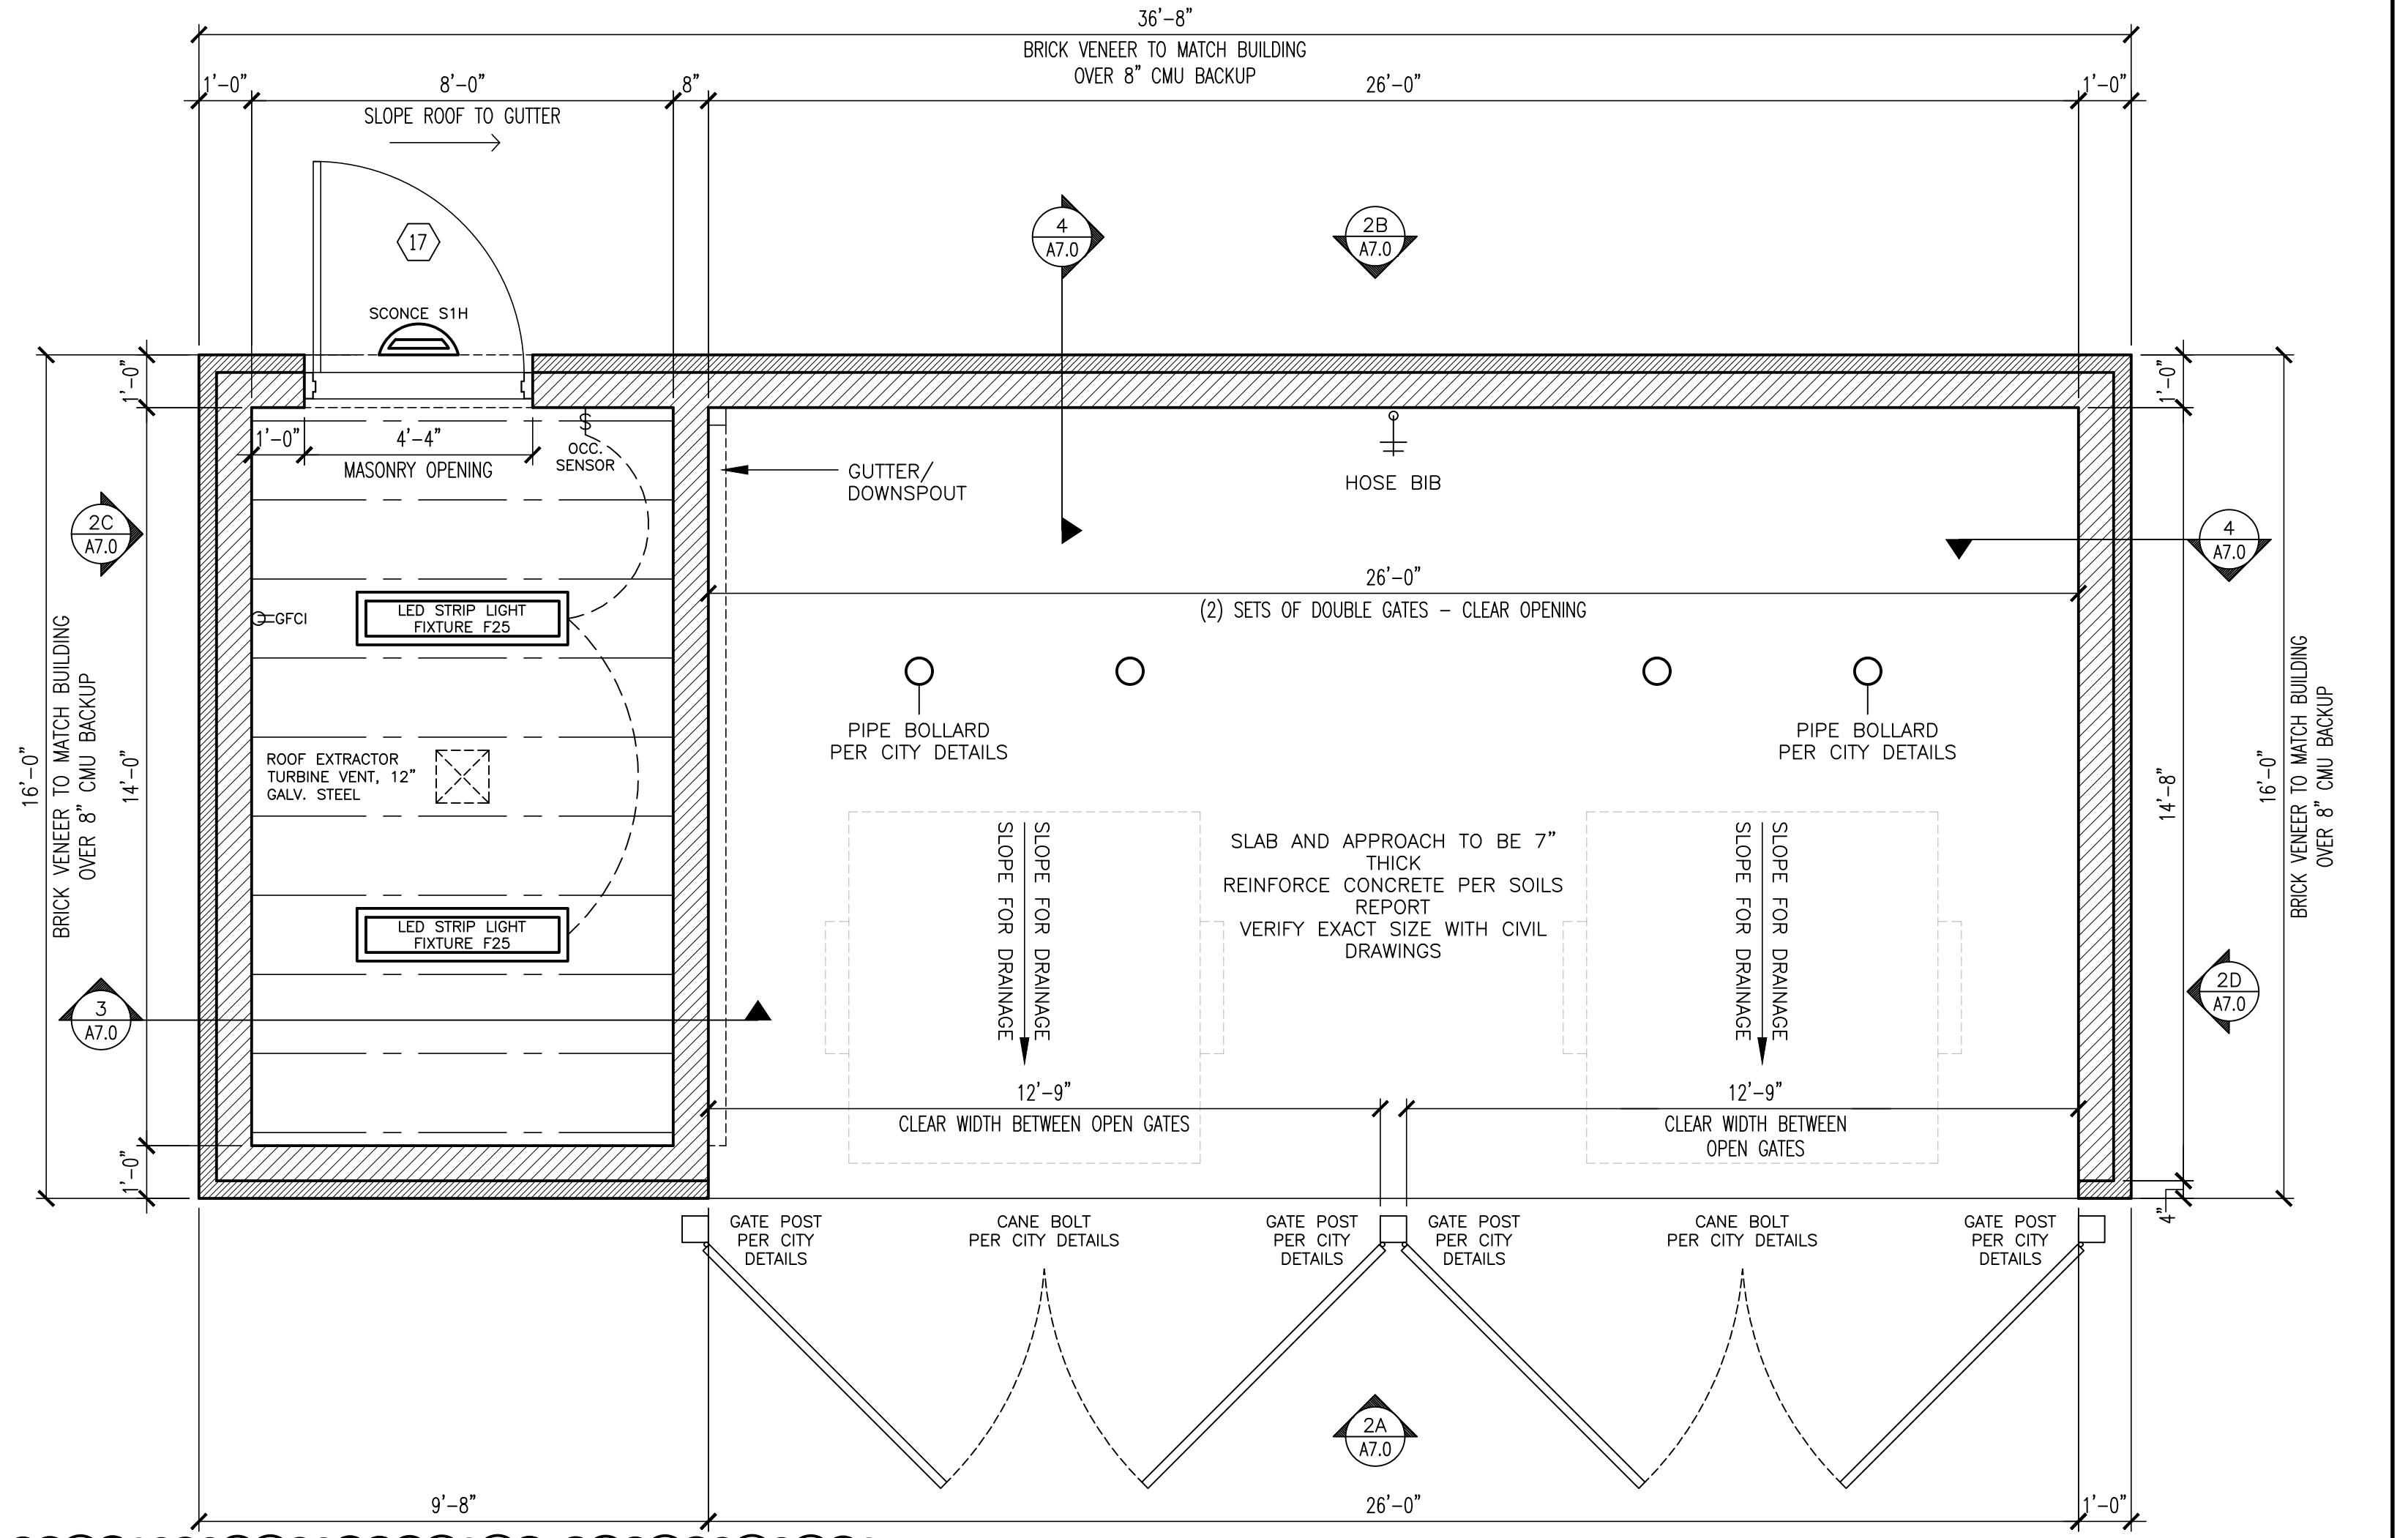


1 | DUMPSTER ENCLOSURE PLAN SCALE 3/8"=1'-0"

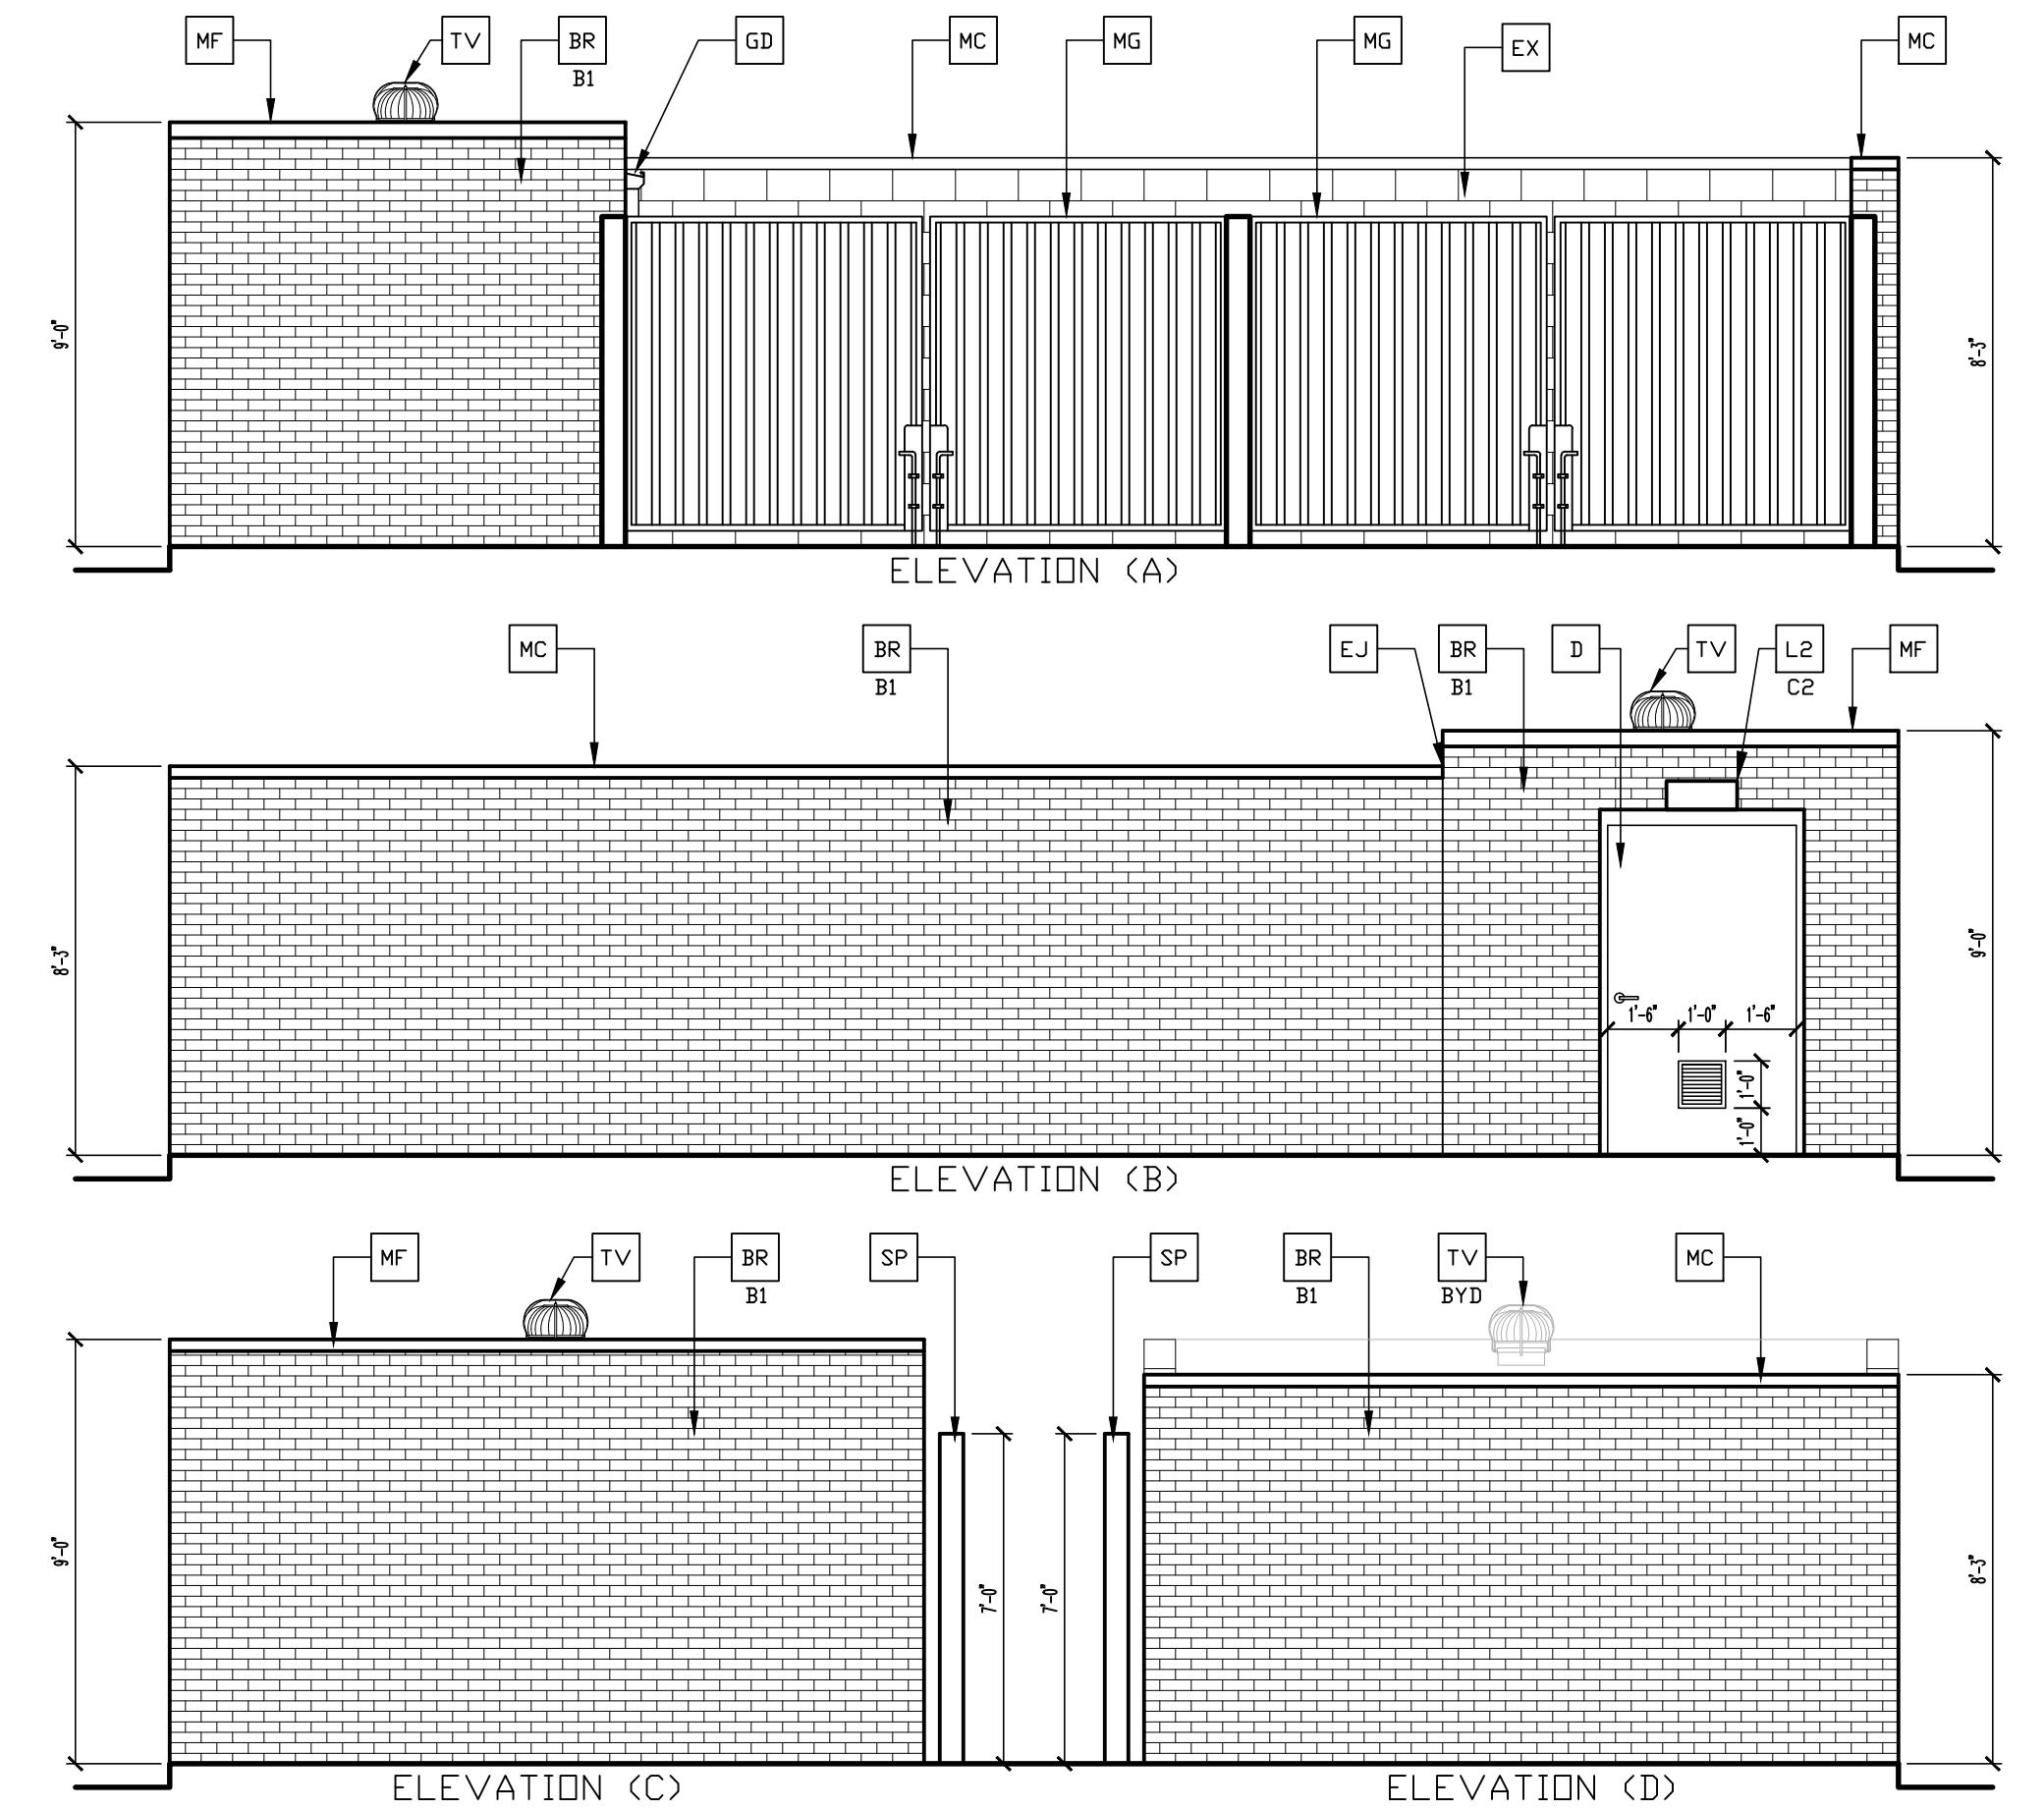

2 | DUMPSTER ELEVATIONS SCALE 1/4"=1'-0"

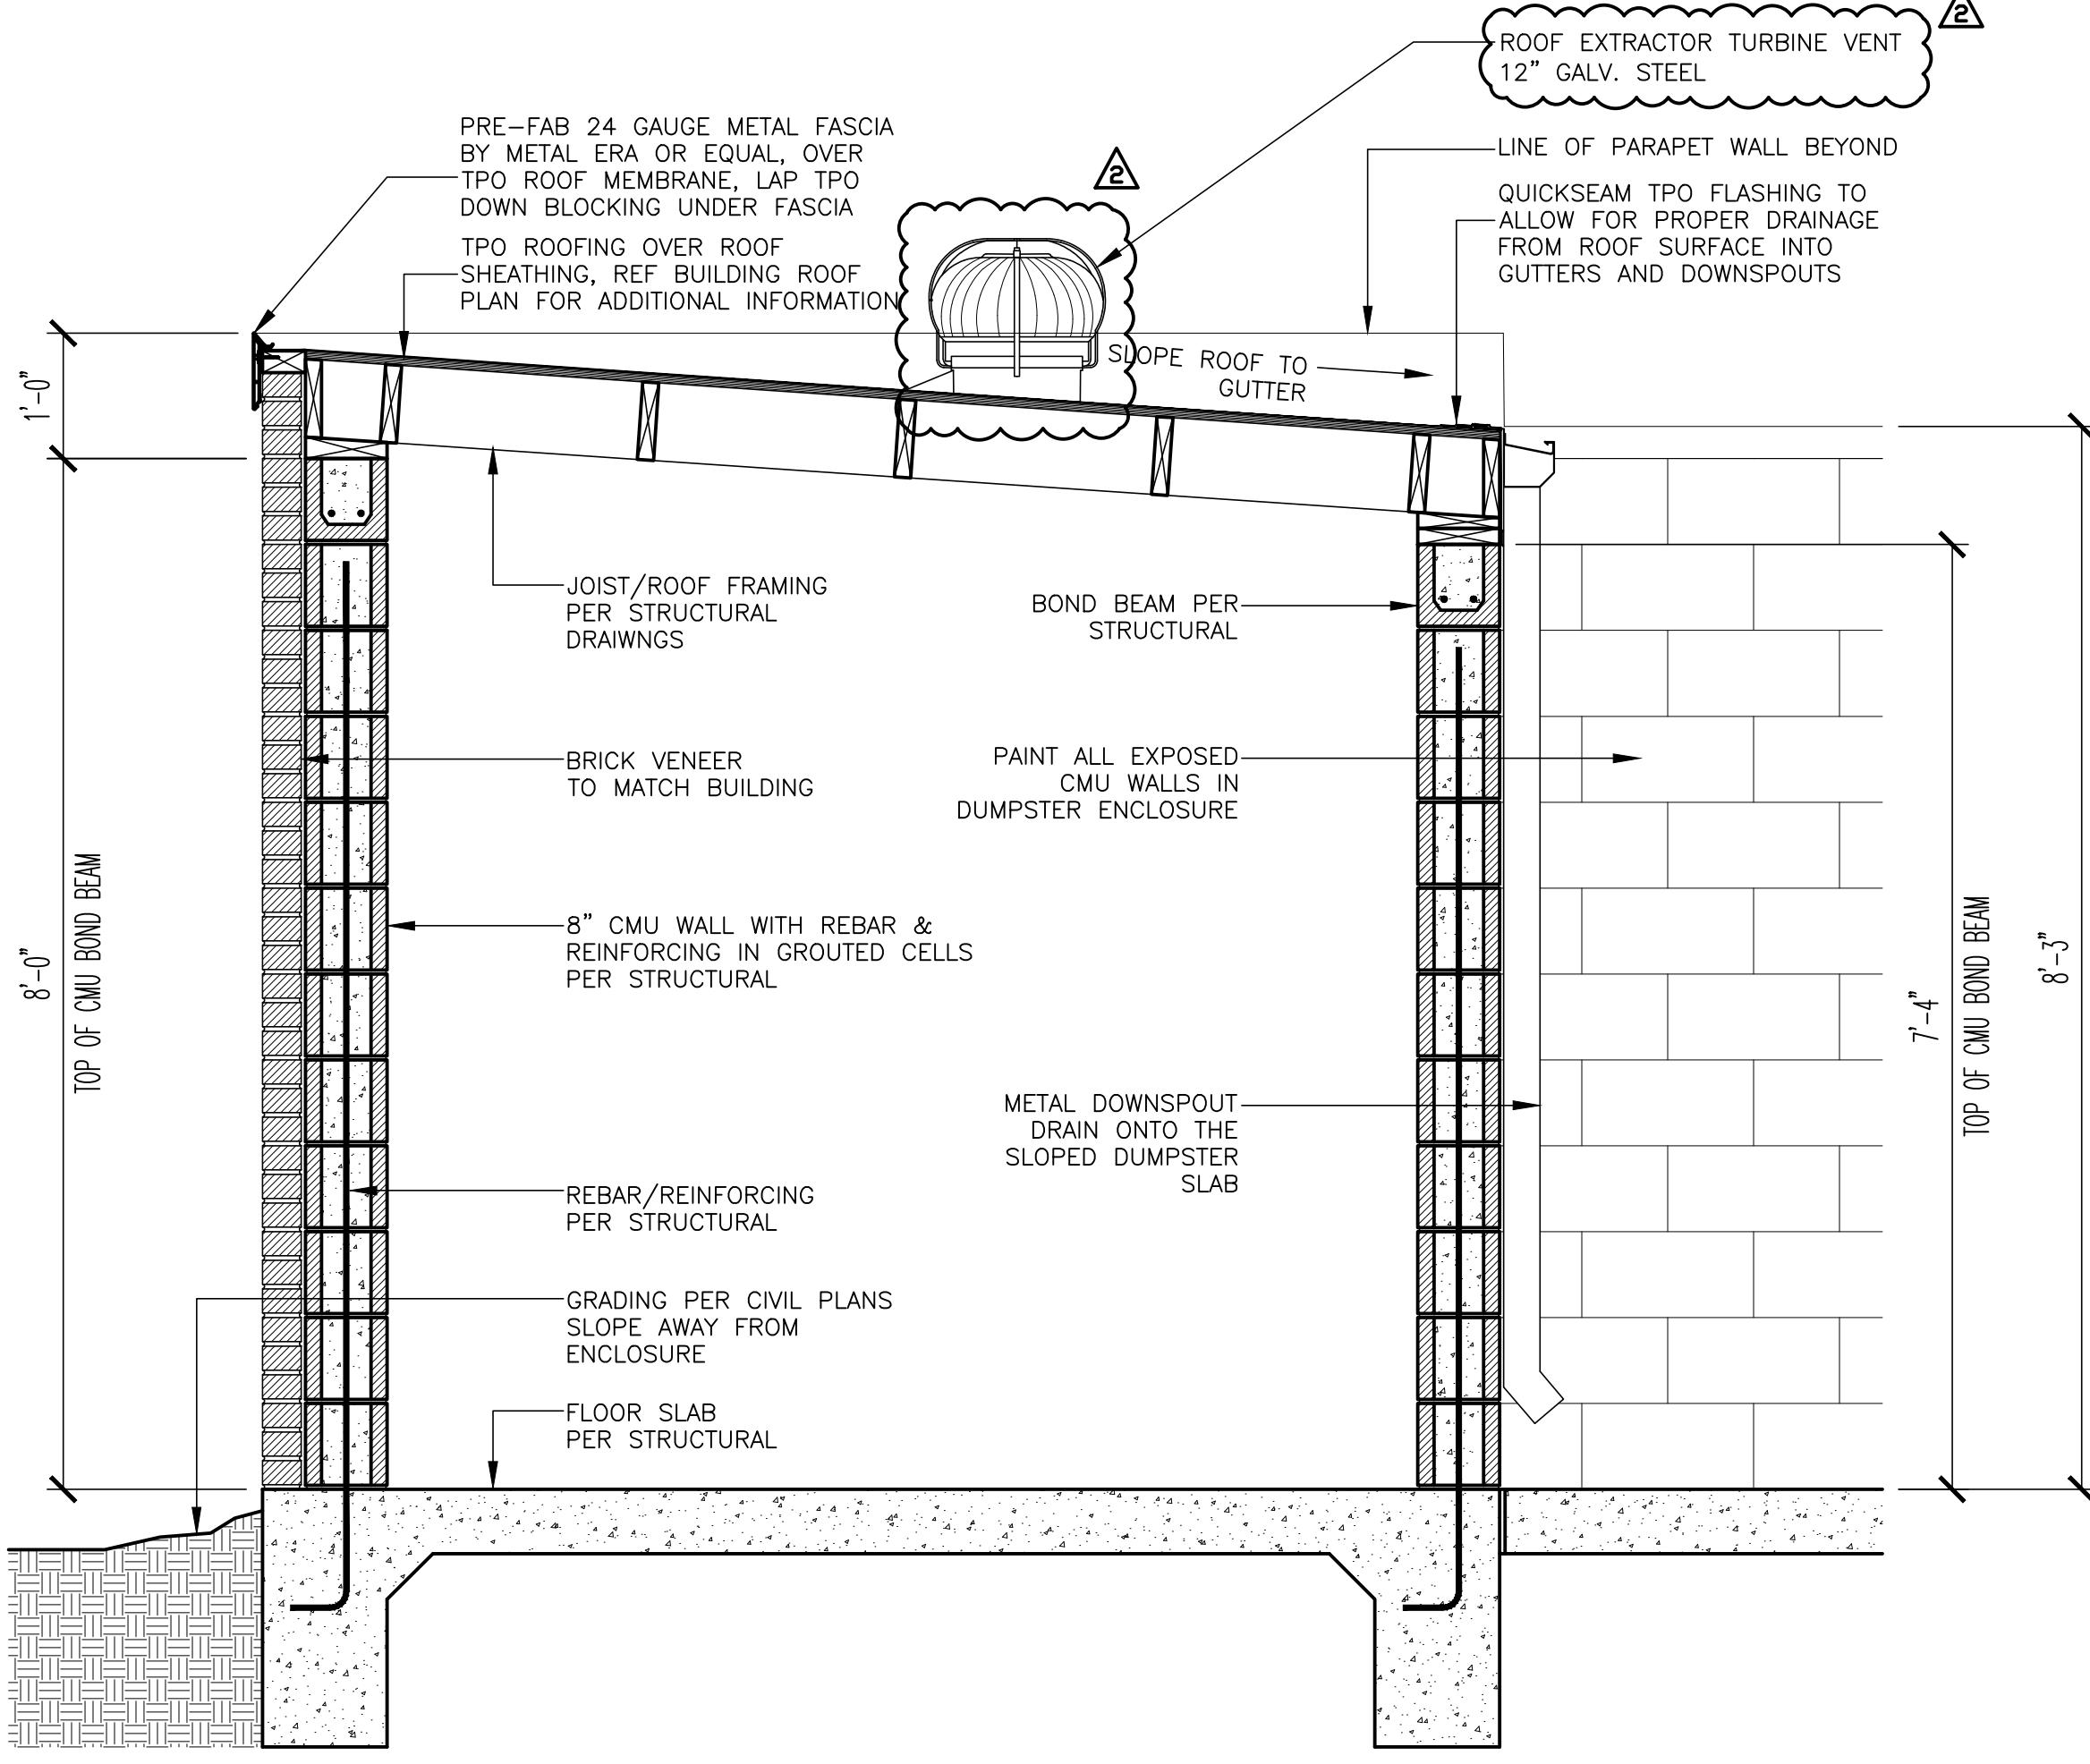

3 | WALL SECTION DETAIL SCALE 3/4"=1'-0"

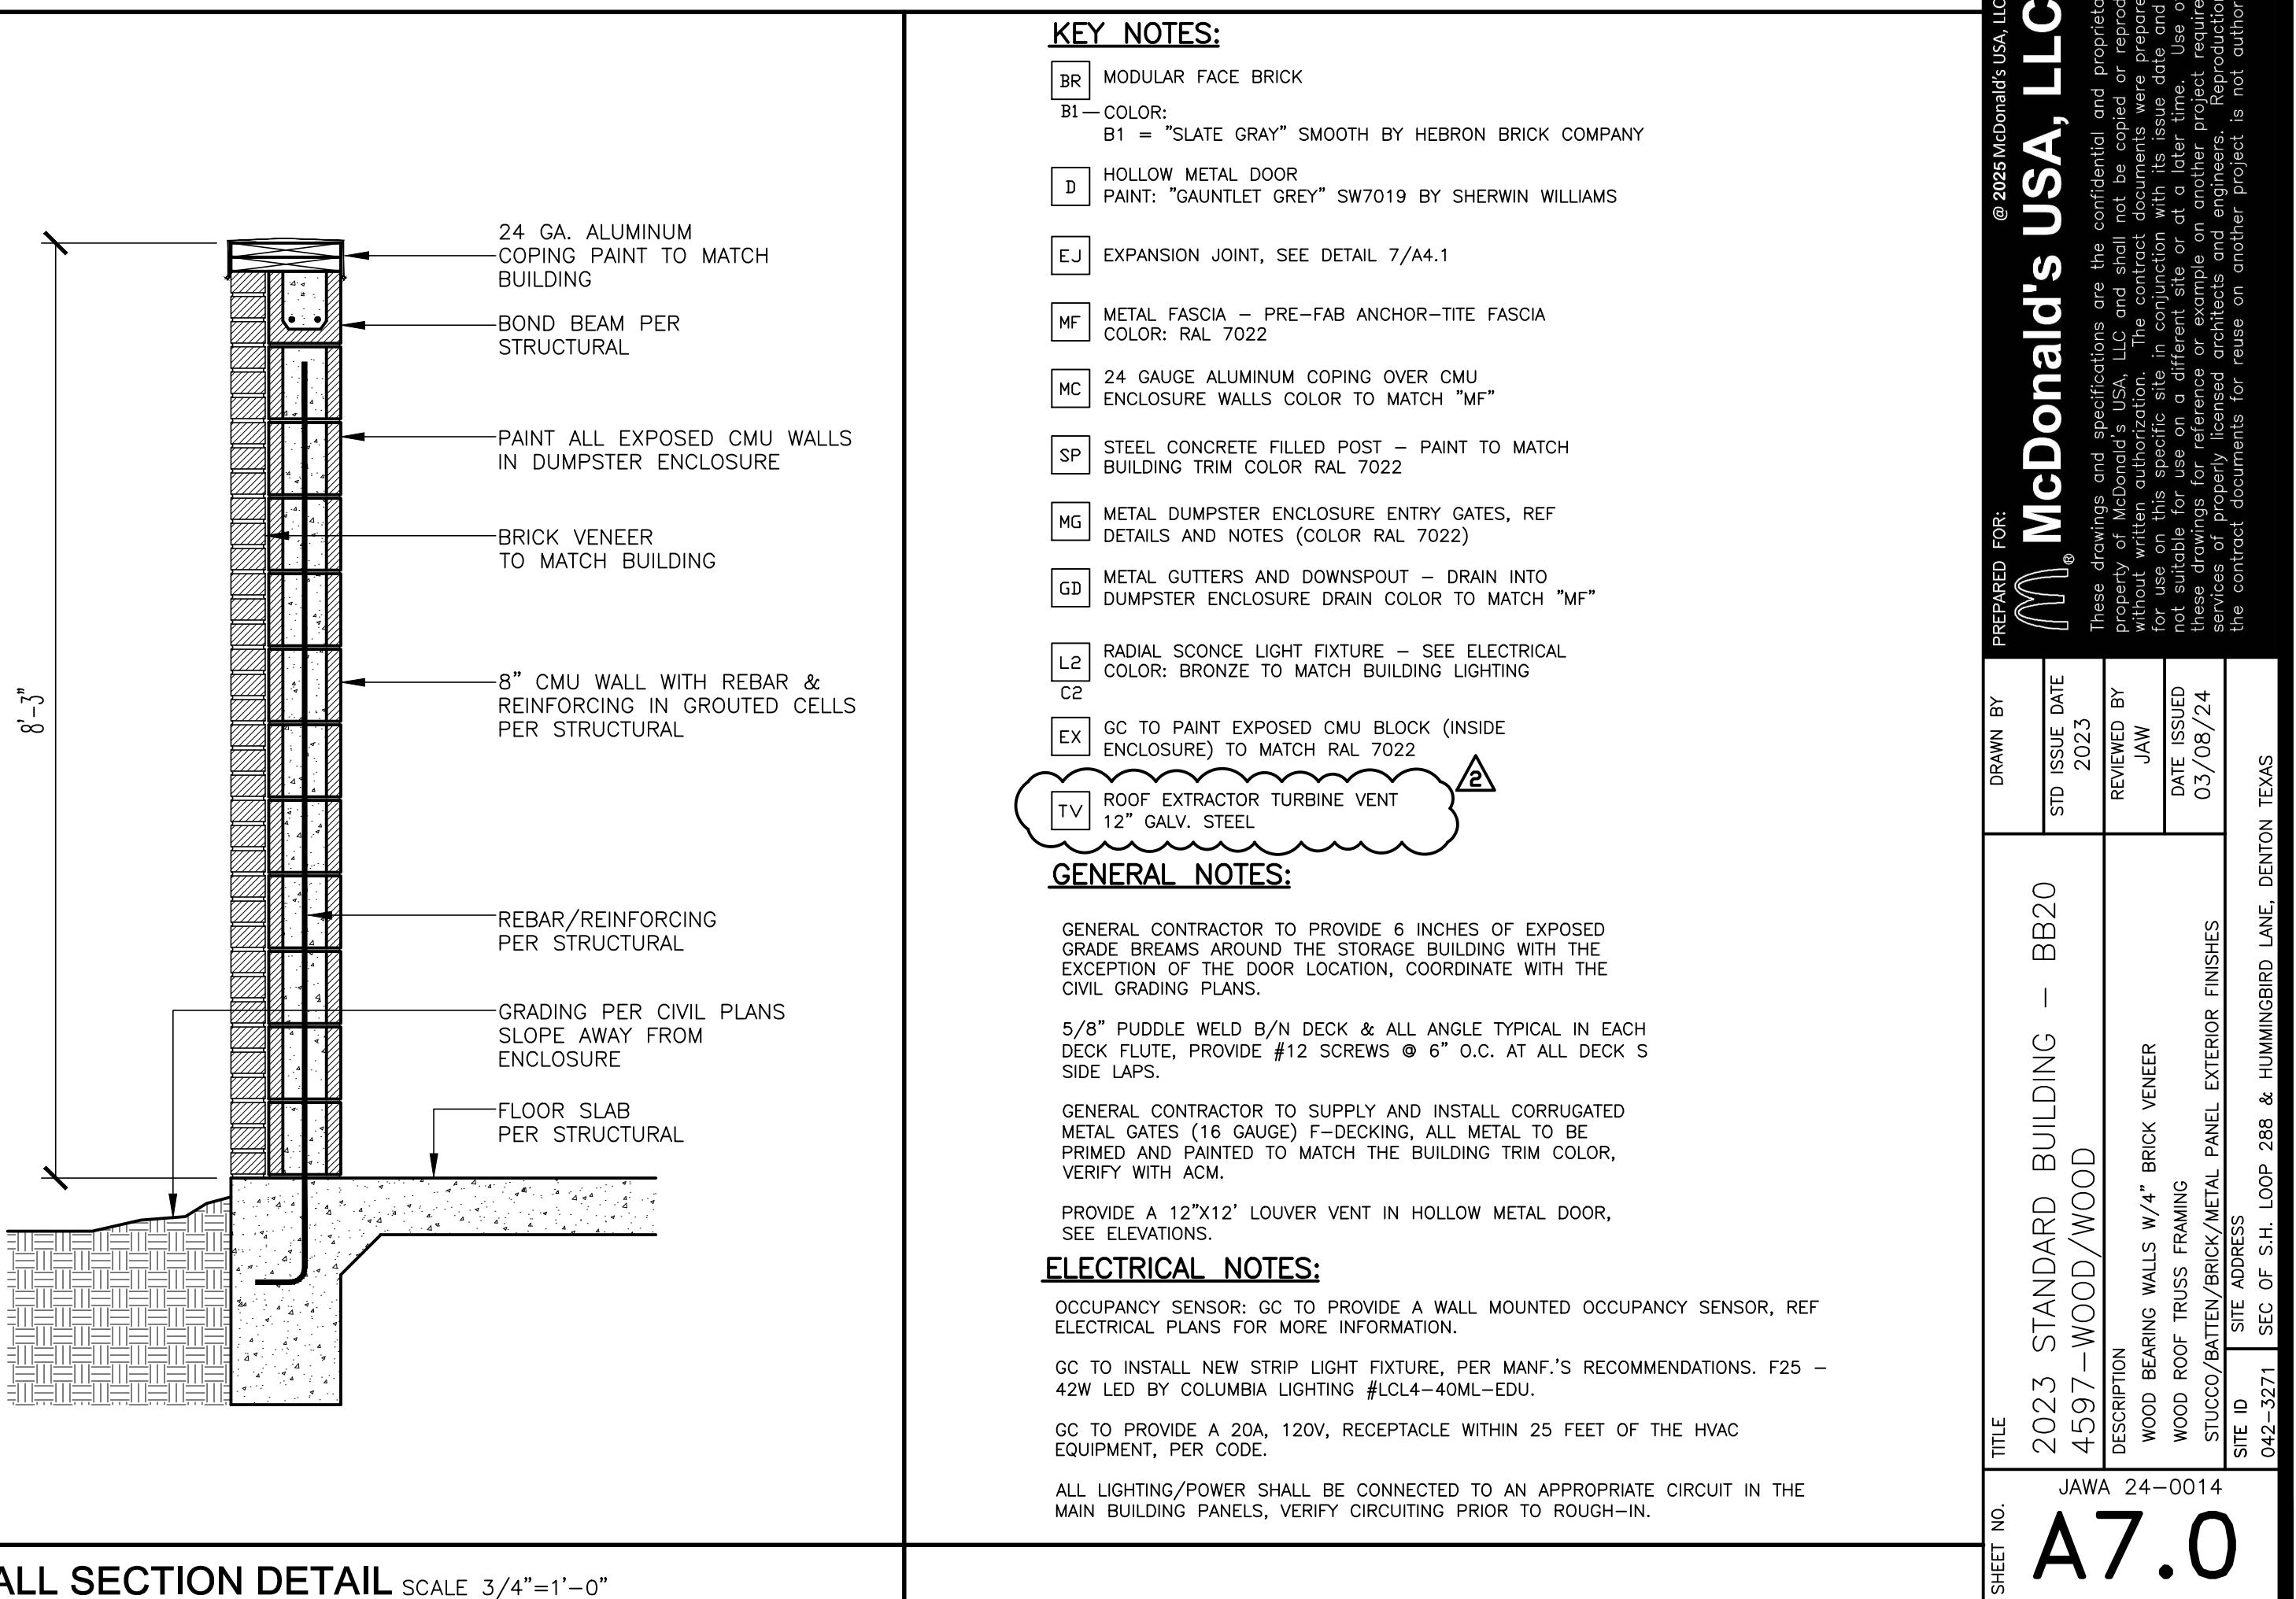

4 | WALL SECTION DETAIL SCALE 3/4"=1'-0"

PREPARED BY:

JAW

J.W. Williams, Architect

REGISTERED ARCHITECT
STATE OF TEXAS

CB

1926

1926

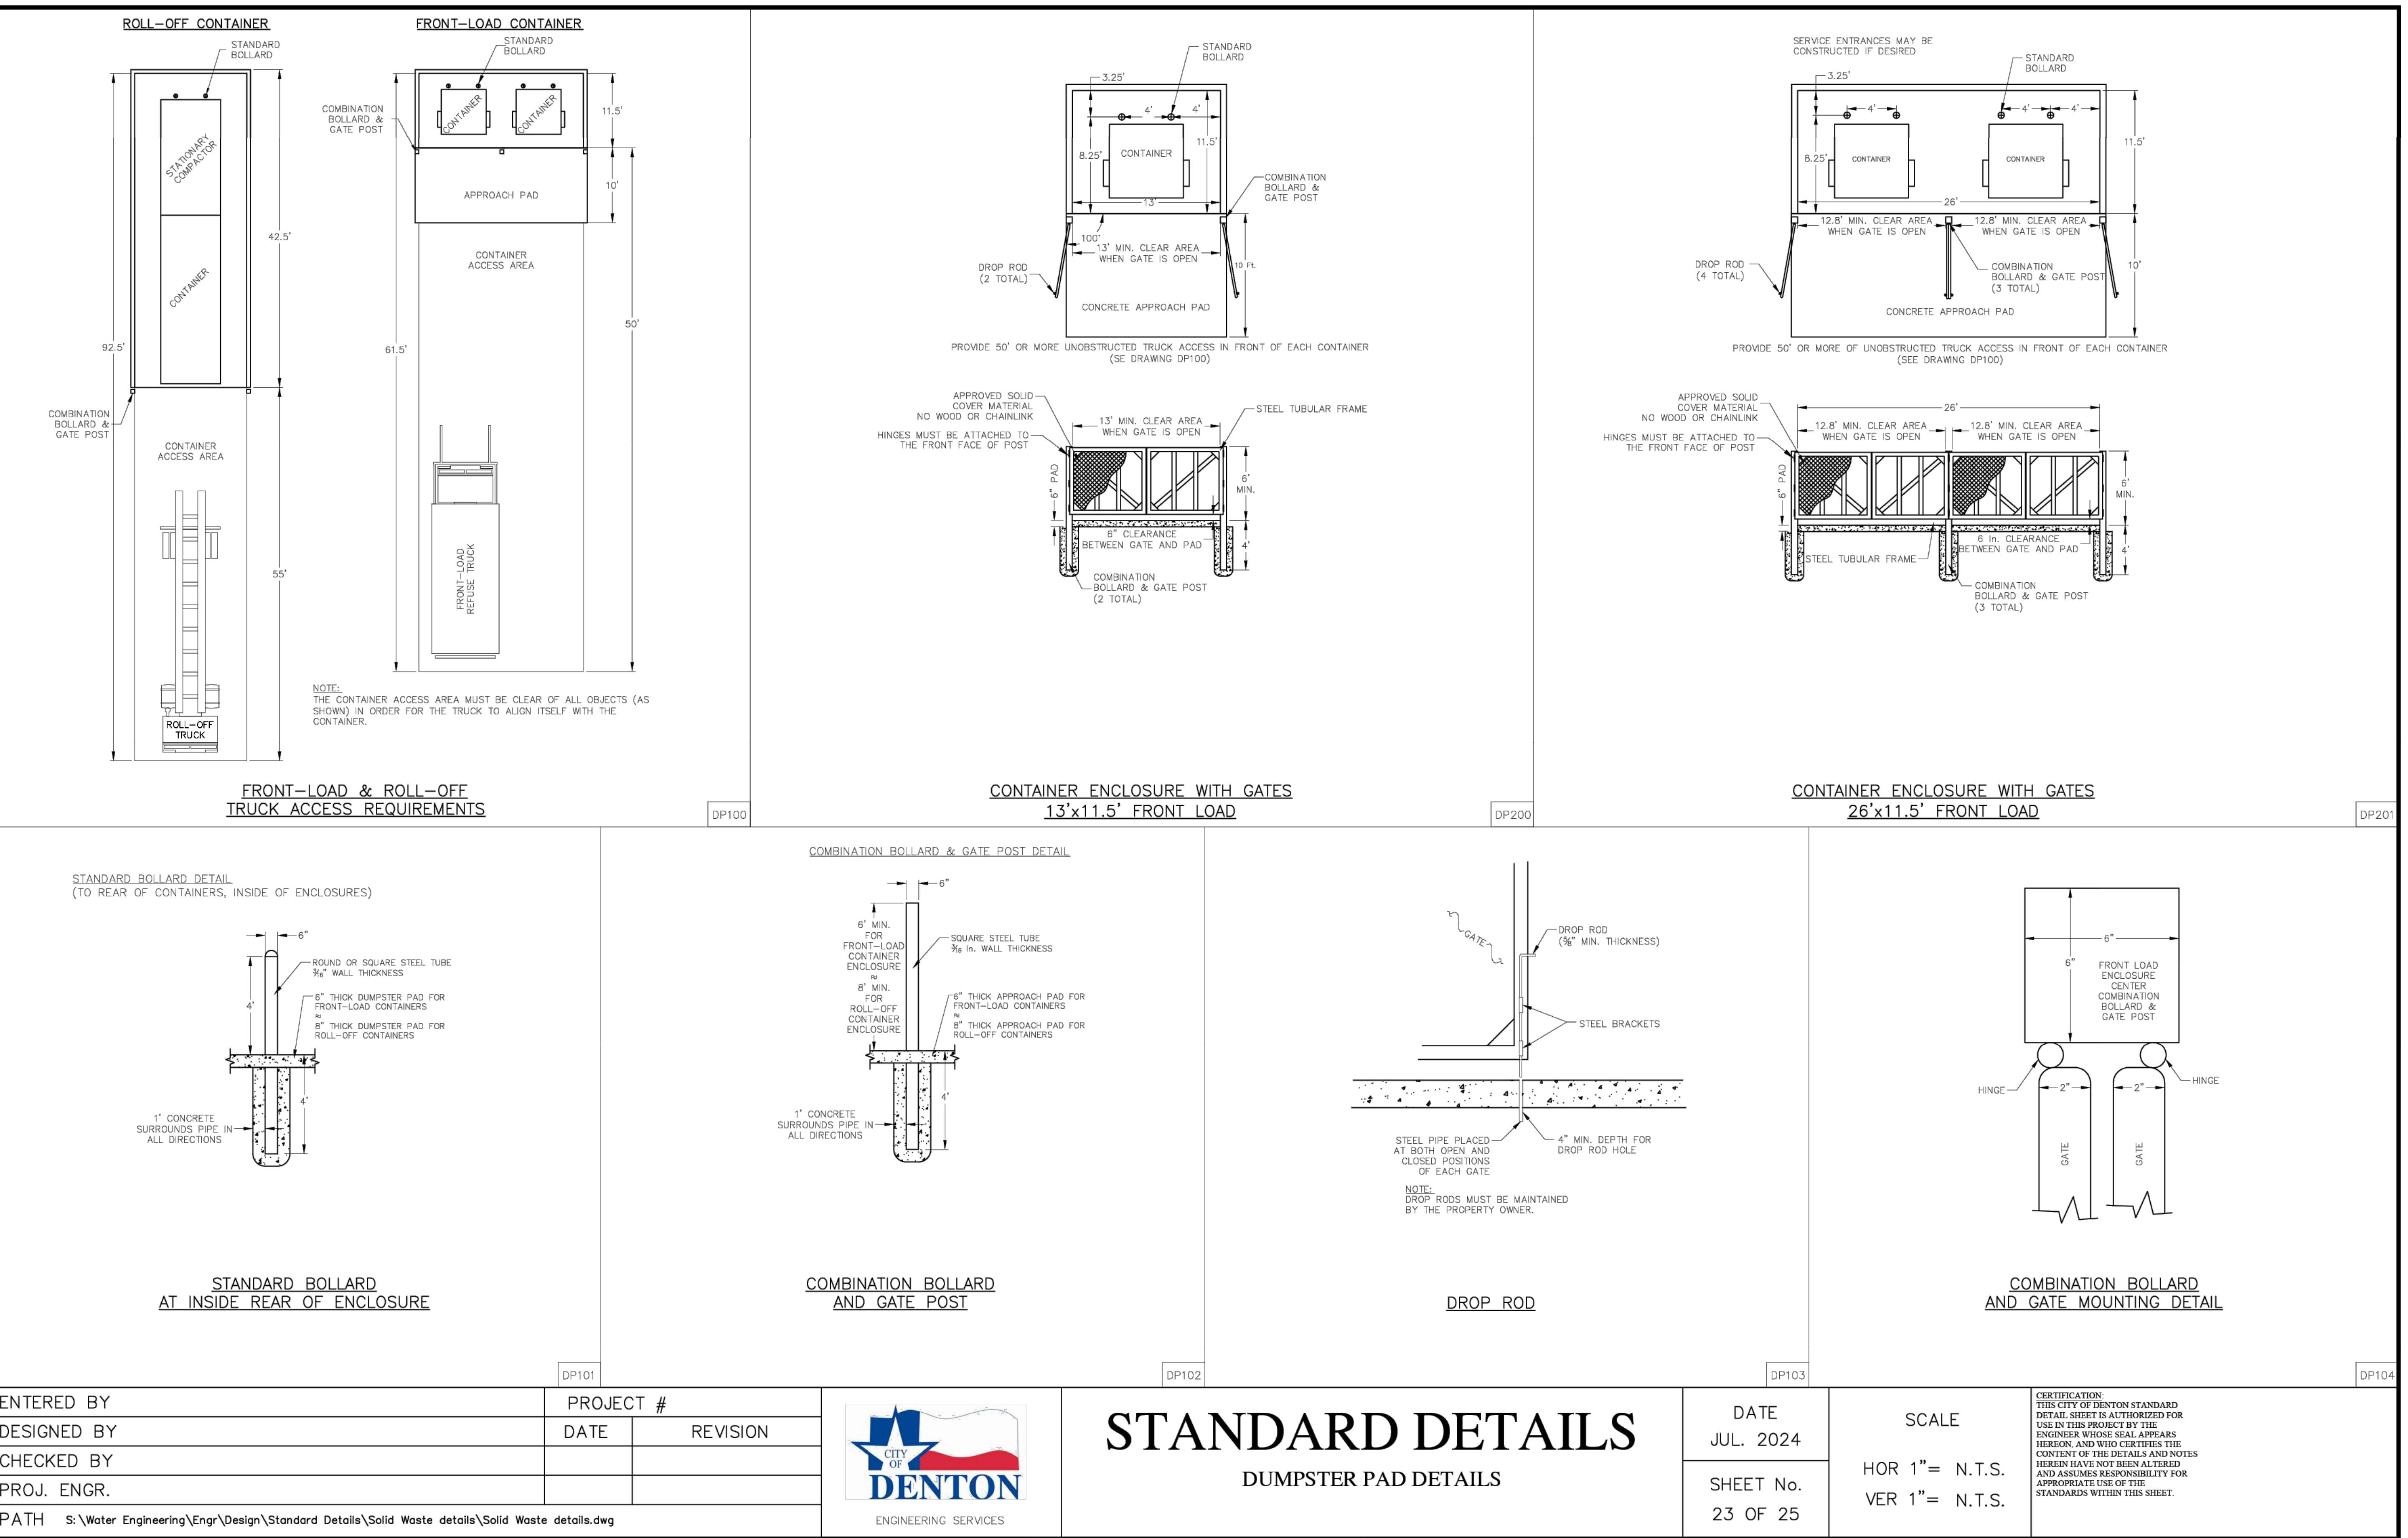

SHEET NO.	TITLE	DRAWN BY	PREPARED BY:
1	2023 STANDARD BUILDING - BB20	JAW	McDonald's USA, LLC
2	4.59'-7-WOOD/WOOD	JAW	McDonald's USA, LLC
	STD ISSUE DATE 2023	REVIEWED BY JAW	These drawings and specifications are the confidential and proprietary property of McDonald's USA, LLC and shall not be copied or reproduced without the written consent of McDonald's USA, LLC. The product documents were prepared for the project identified above. These drawings are not suitable for use on a different site or at a later time. Use of these drawings for reference or example on another project requires the services of properly licensed architects and engineers. Reproduction of the complete documents for reuse on another project is not authorized.
	DATE ISSUED 03/08/24	DATE ISSUED 03/08/24	JAW Architects, Inc. Amy Williams, Architect Phone: 817-705-3387 Email: amy.williams@waterworks.com
		REV. DATE	

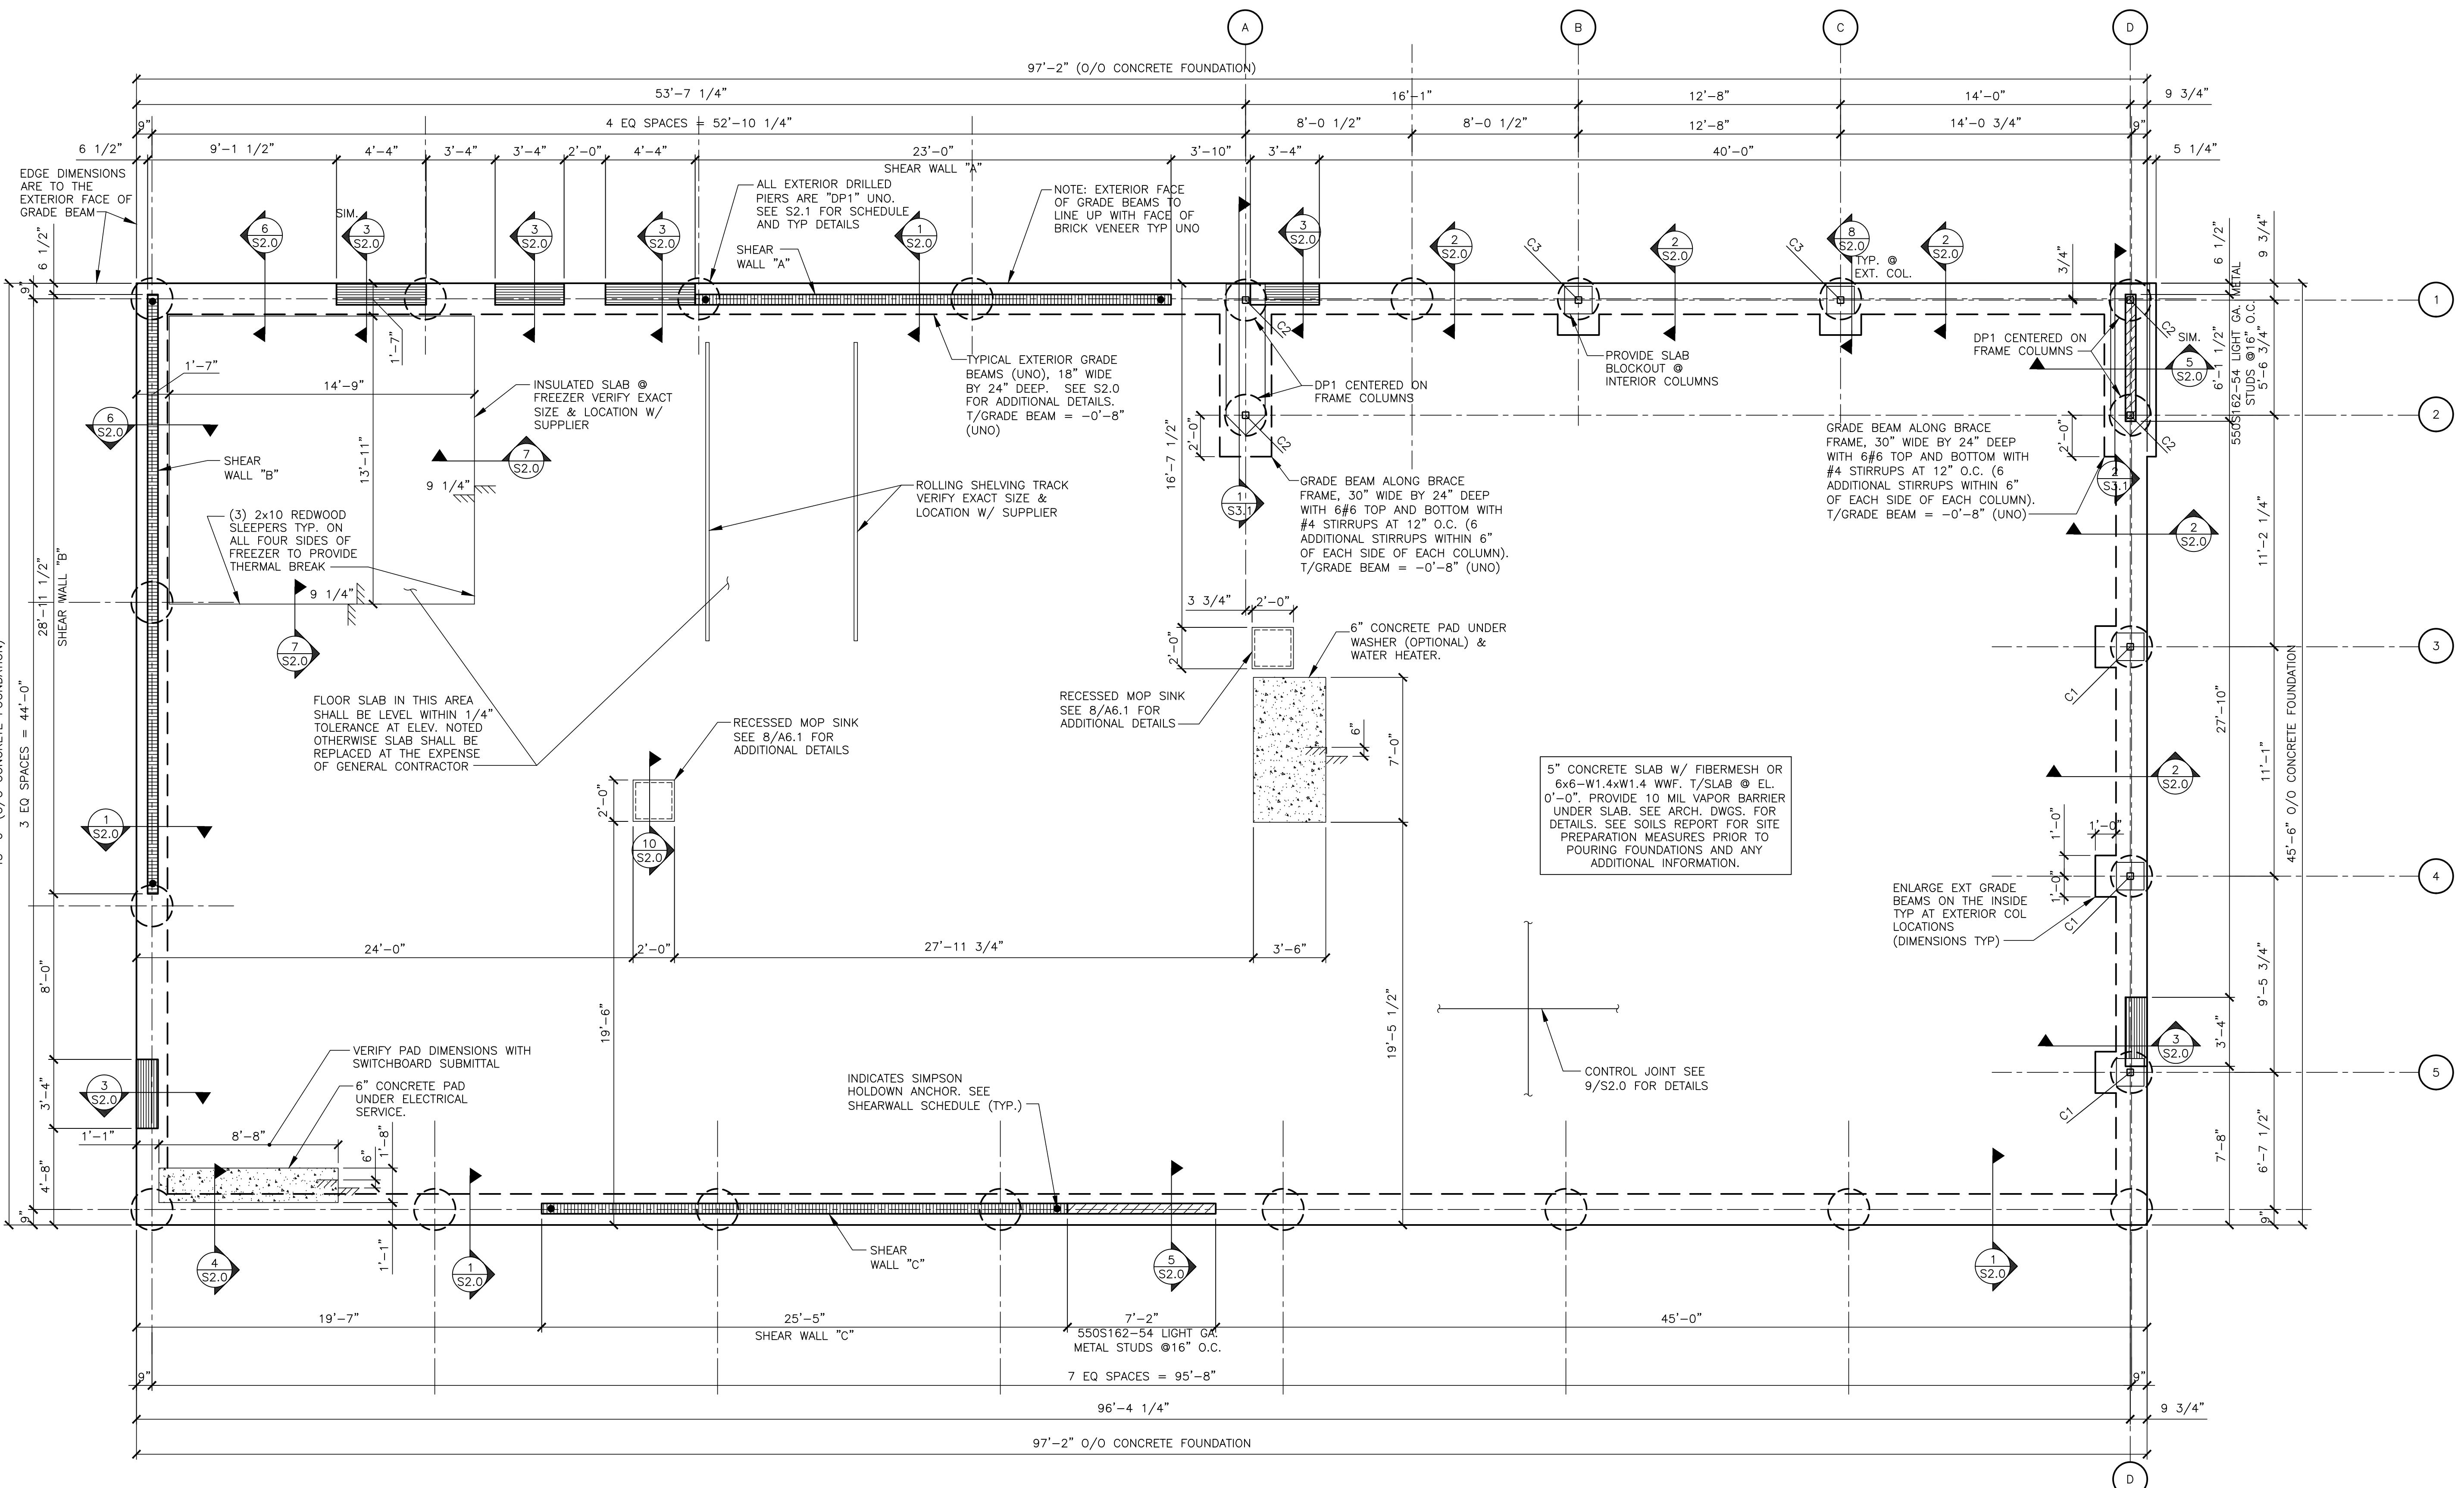

COLUMN & BASE PLATE SCHEDULE

MARK	MEMBER	SHAPE	BASE PLATE	REMARKS
C1	HSS4x4x1/4	+	A	EXTEND TO ROOF
C2	HSS4x4x5/16	+	B	BRACED FRAME
C3	HSS4x4x5/16	+	A	EXTEND TO ROOF

NOTE: SEE DETAIL 3/S3.1 FOR BASE PLATE AND ANCHOR ROD DETAILS

McDonald's USA, LLC


These drawings and specifications are the confidential and proprietary property of McDonald's USA, LLC and shall not be copied or reproduced for use on other specific site in conjunction with its issue date and are not suitable for use on a different site or at a later time. Use of these drawings, for reference or example, on another project requires the contract documents for release on another project is not authorized.



Signed/Sealed:
03/06/2024


REV	DATE	DESCRIPTION

JAVA 24-0014
S1.0
FOUNDATION PLAN
042-3271 SEC OF S.H. LOOP 288 & HUMMINGBIRD LANE, DENTON TEXAS

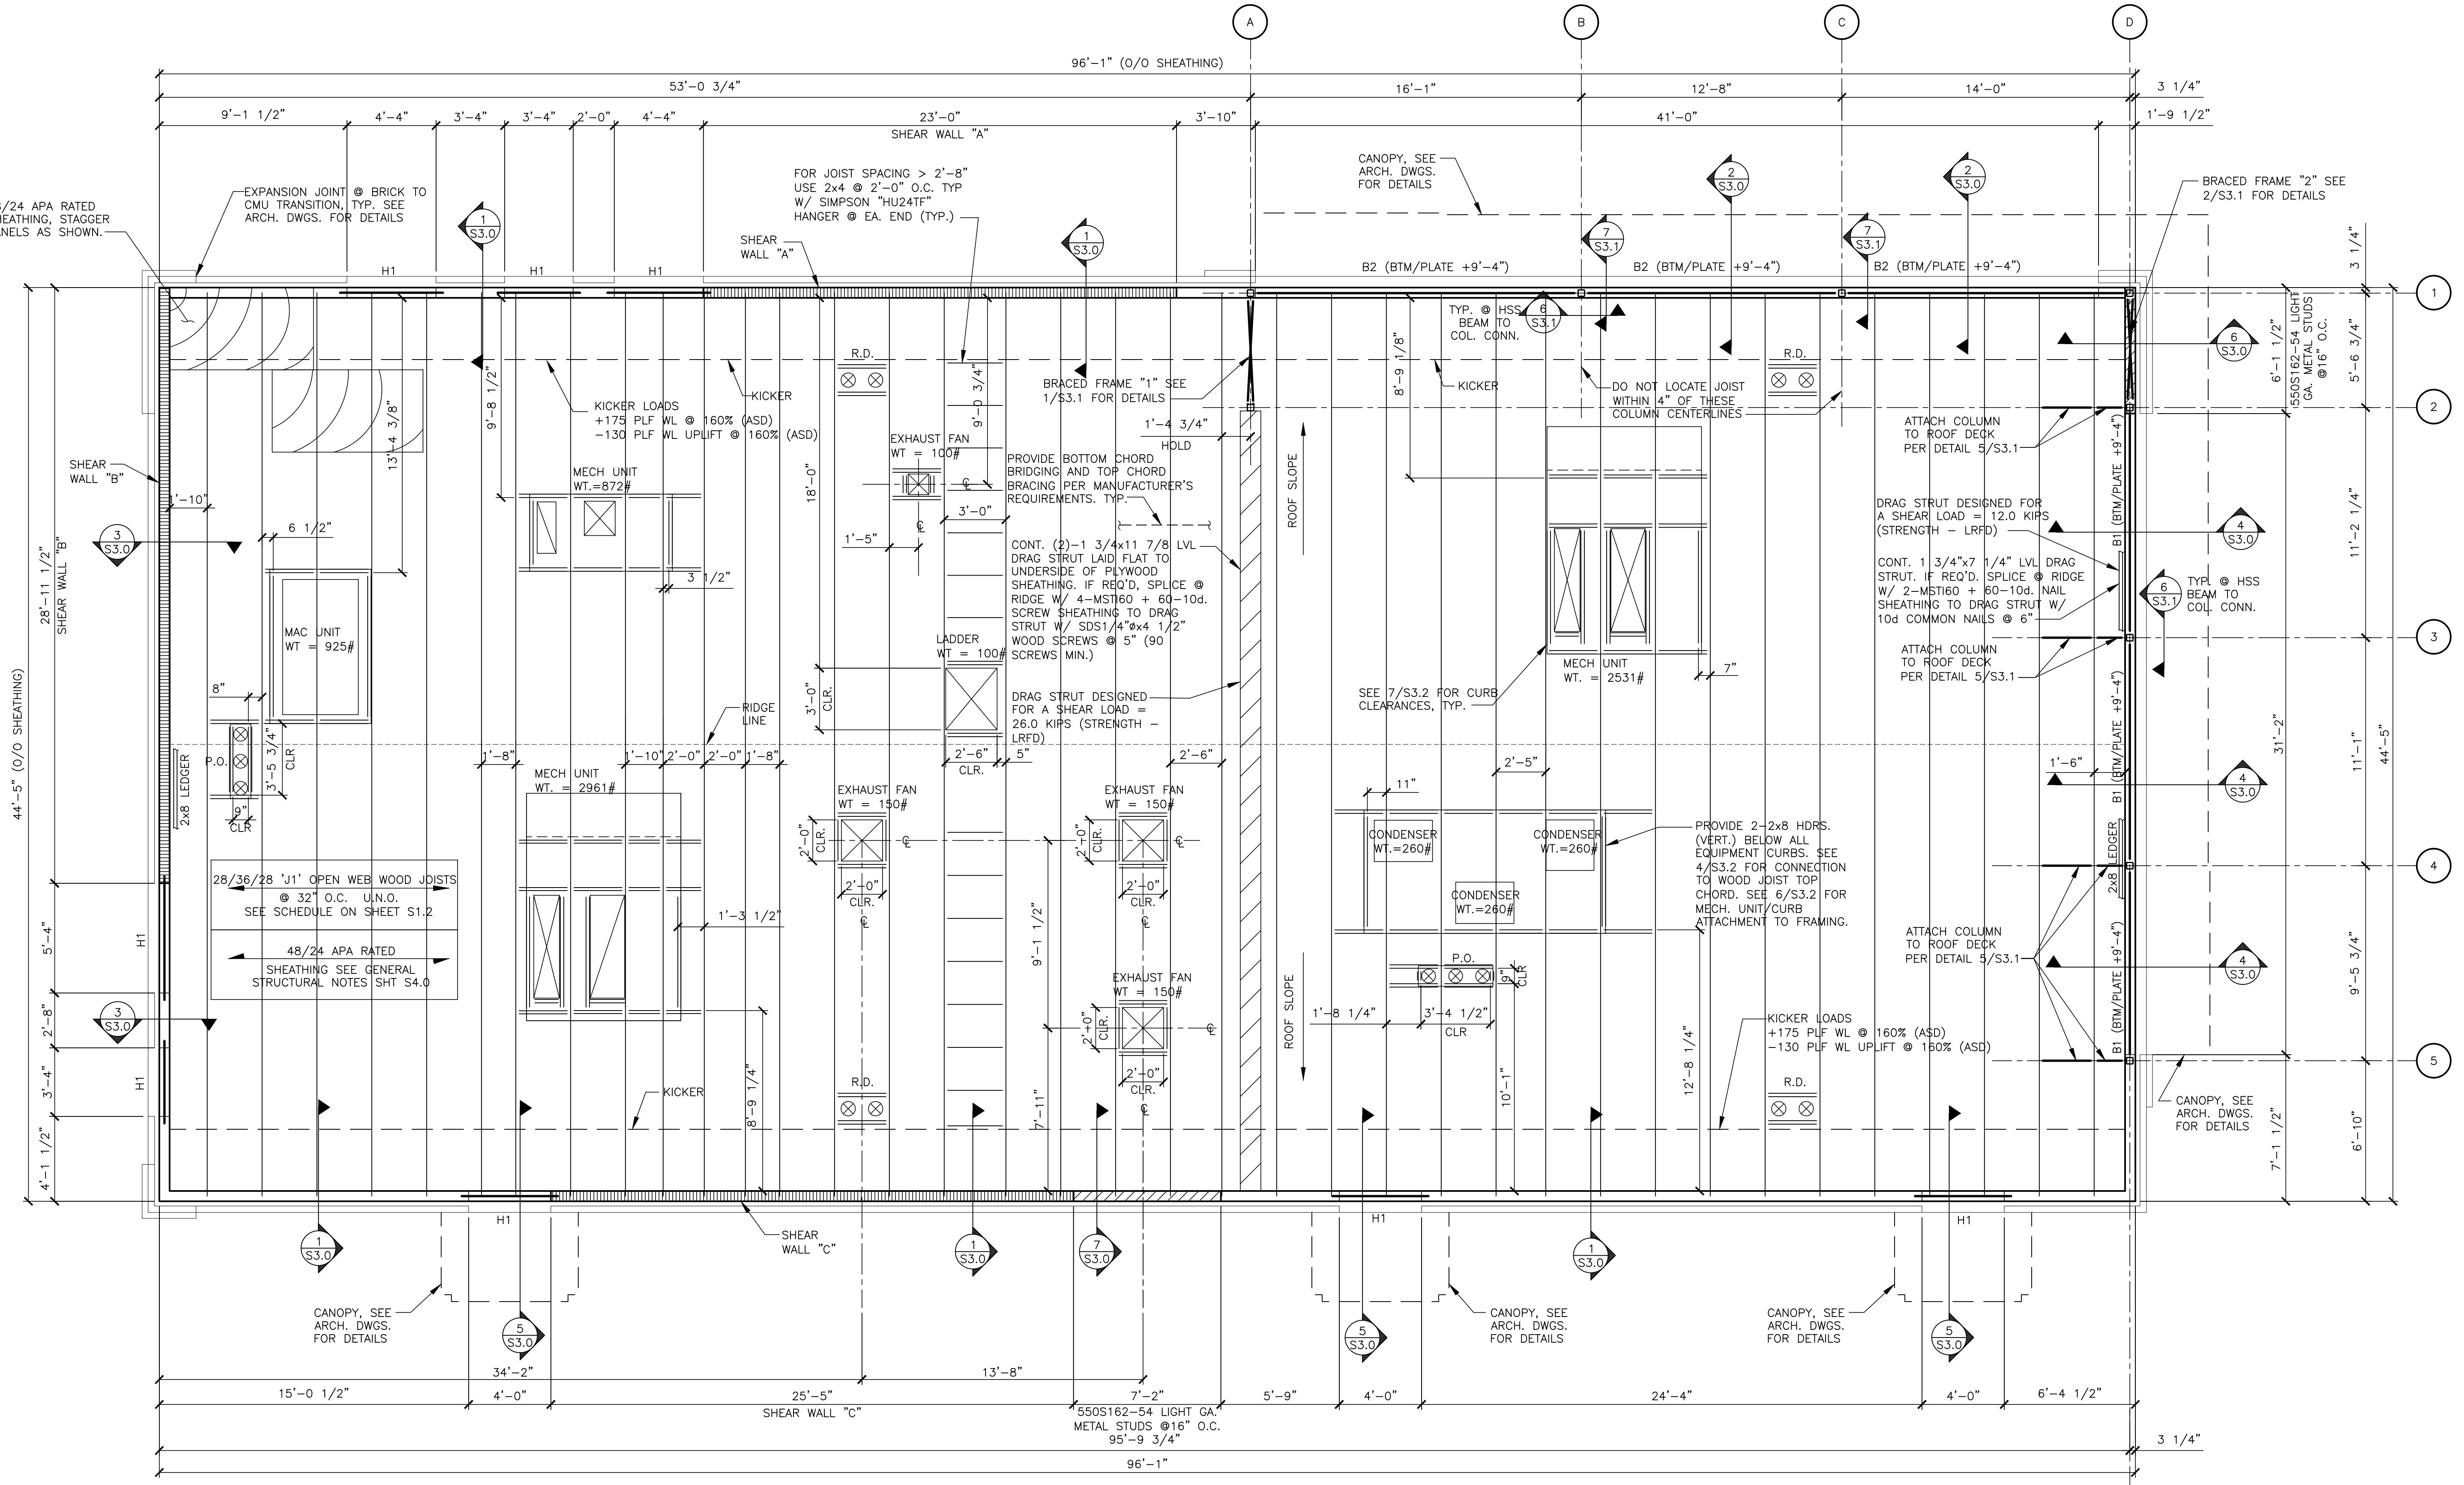

McDonald's USA, LLC

These drawings and specifications are the confidential and proprietary property of McDonald's USA, LLC and shall not be copied or reproduced for use on other specific site in conjunction with its issue date and are not suitable to use on a different site or at a later time. Use of these drawings or reference to them on another project requires the express written consent of McDonald's USA, LLC. Any unauthorized use of the contract documents for release on another project is not authorized.

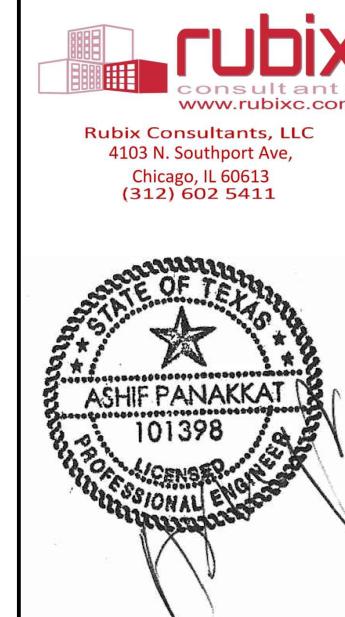



Signed/Sealed:
03/08/2024

JAWA 24-0014

SHEET NO.	TITLE
4597-WOOD/WOOD	2023 STANDARD BUILDING - BB20
DESCRIPTION	WOOD BEARING WALLS W/4" BRICK VENEER
SITE ID	SEC OF S.H. LOOP 288 & HUMMINGBIRD LANE, DENTON TEXAS
DRAWN BY	MKP
STD ISSUE DATE	2023
REVISED BY	AP
DATE ISSUED	03/08/24


S1.2
FRAMING PLAN

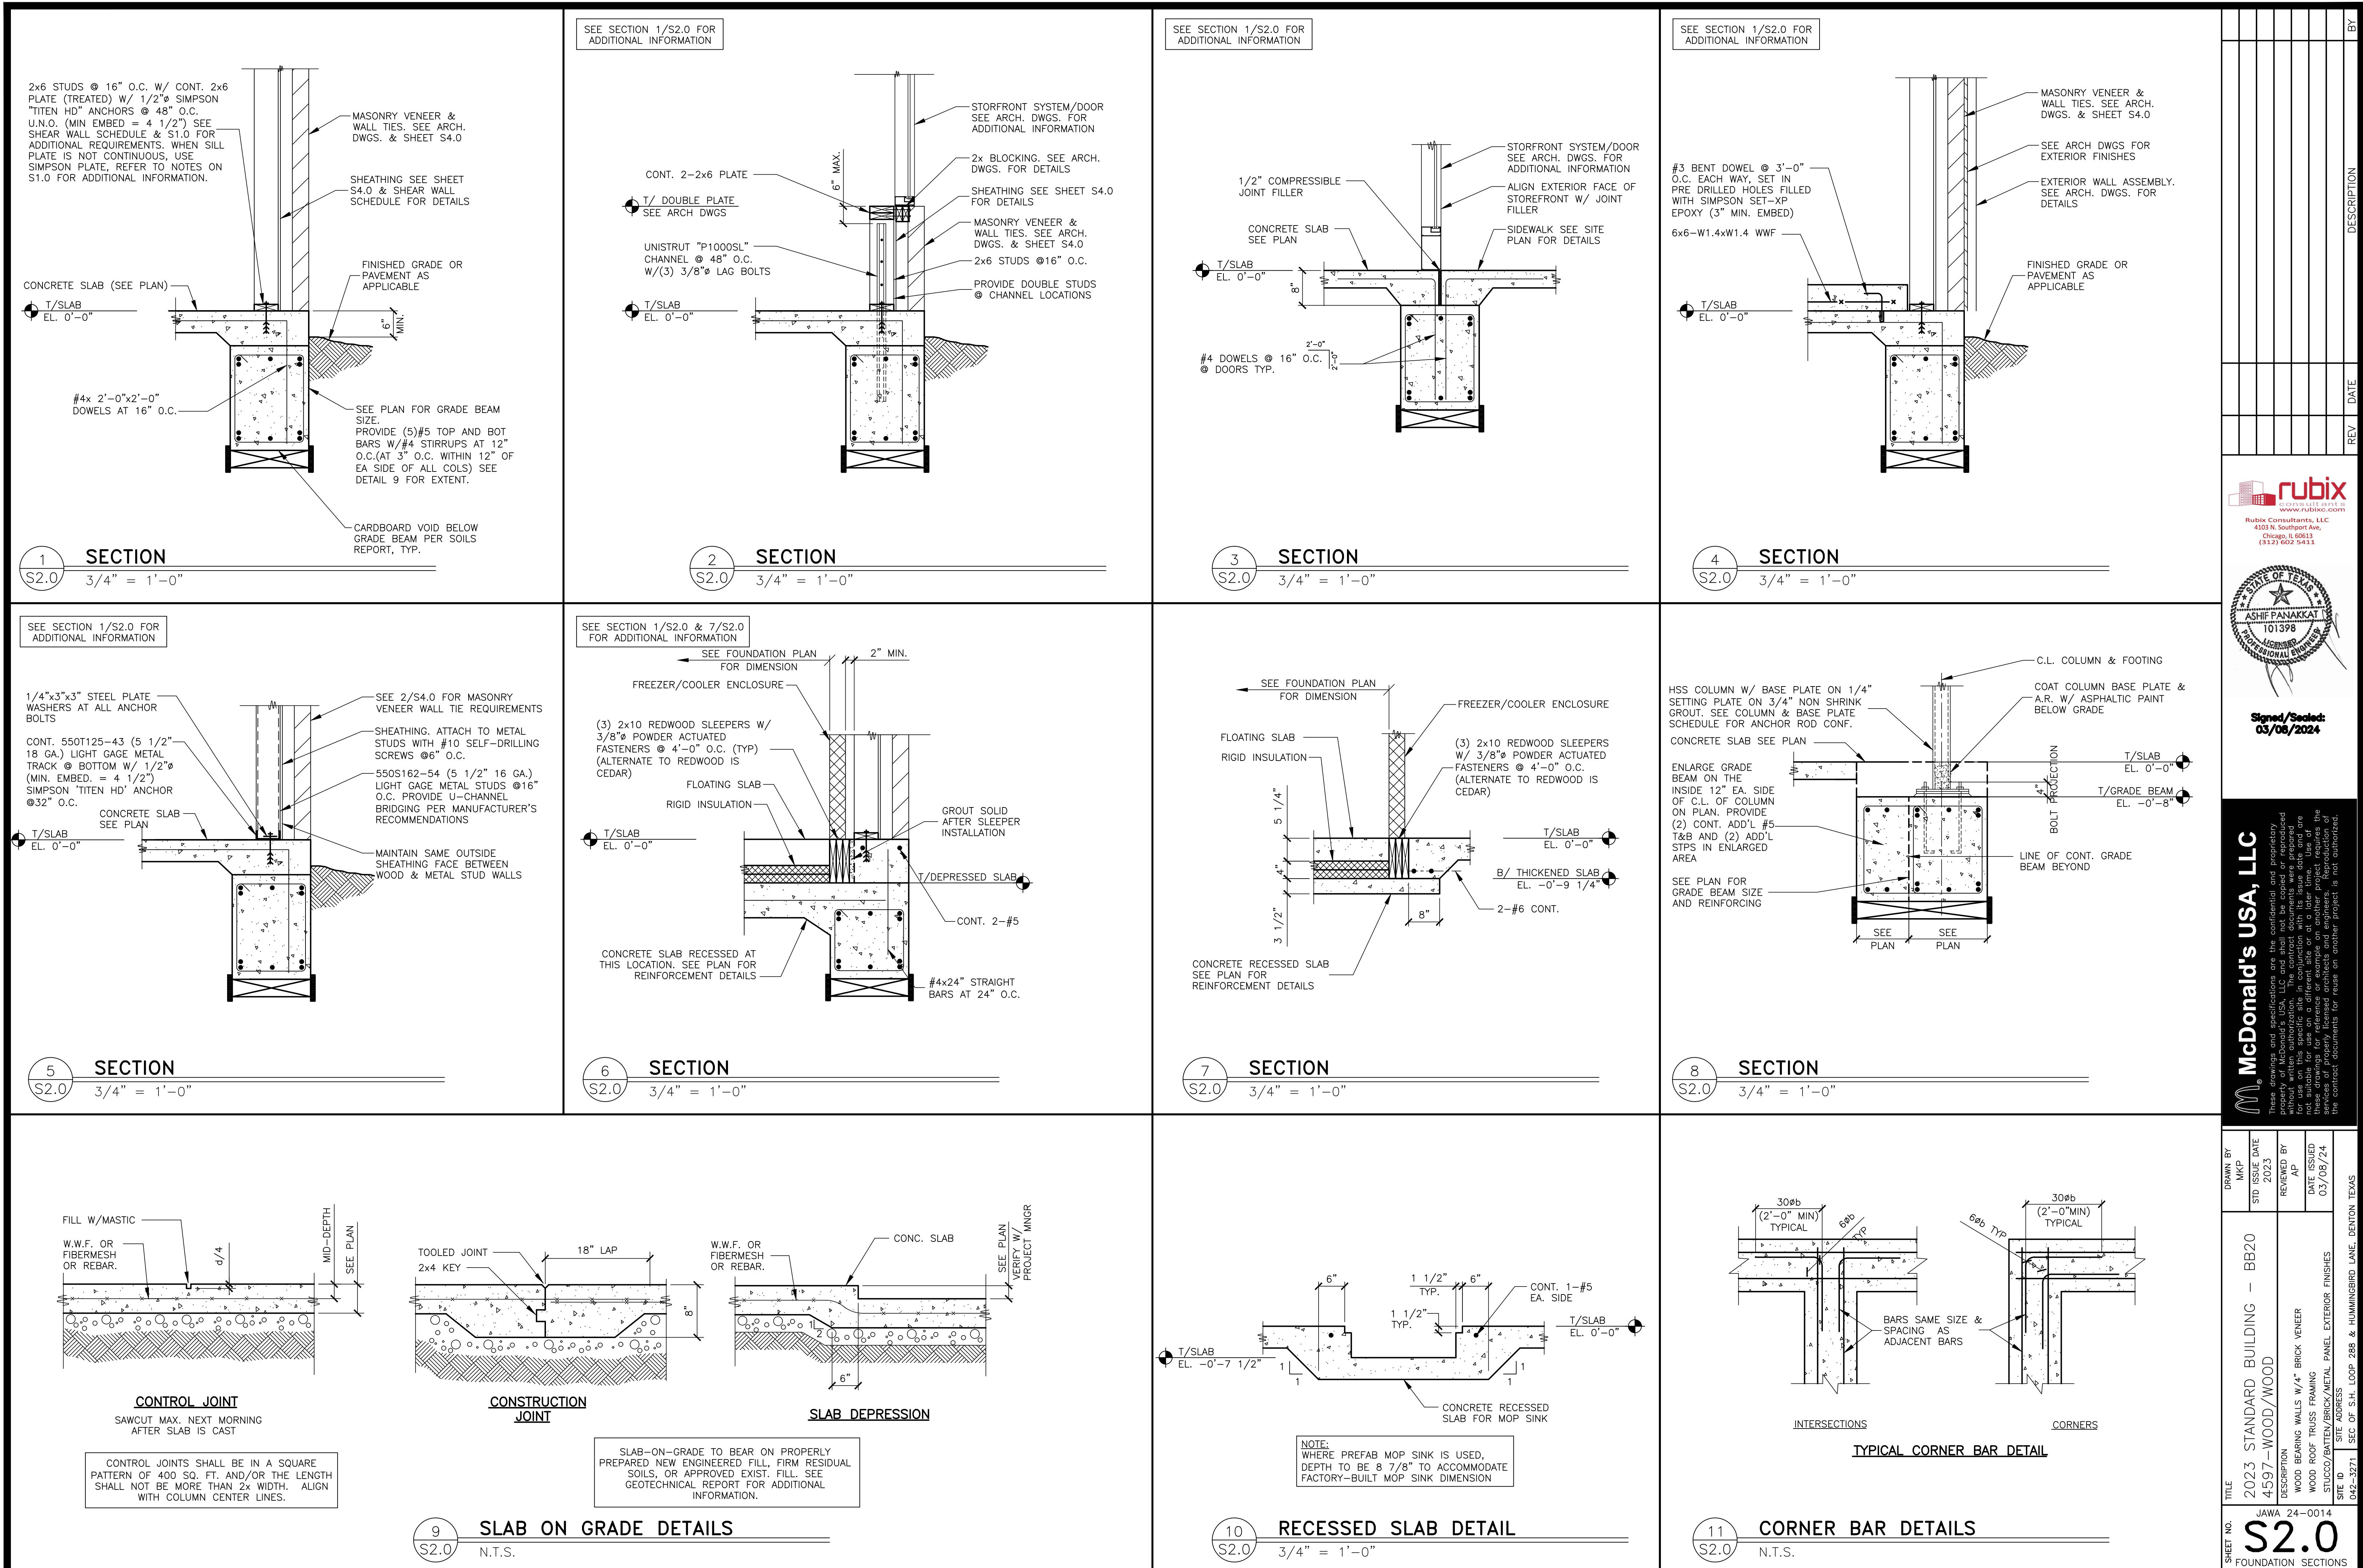

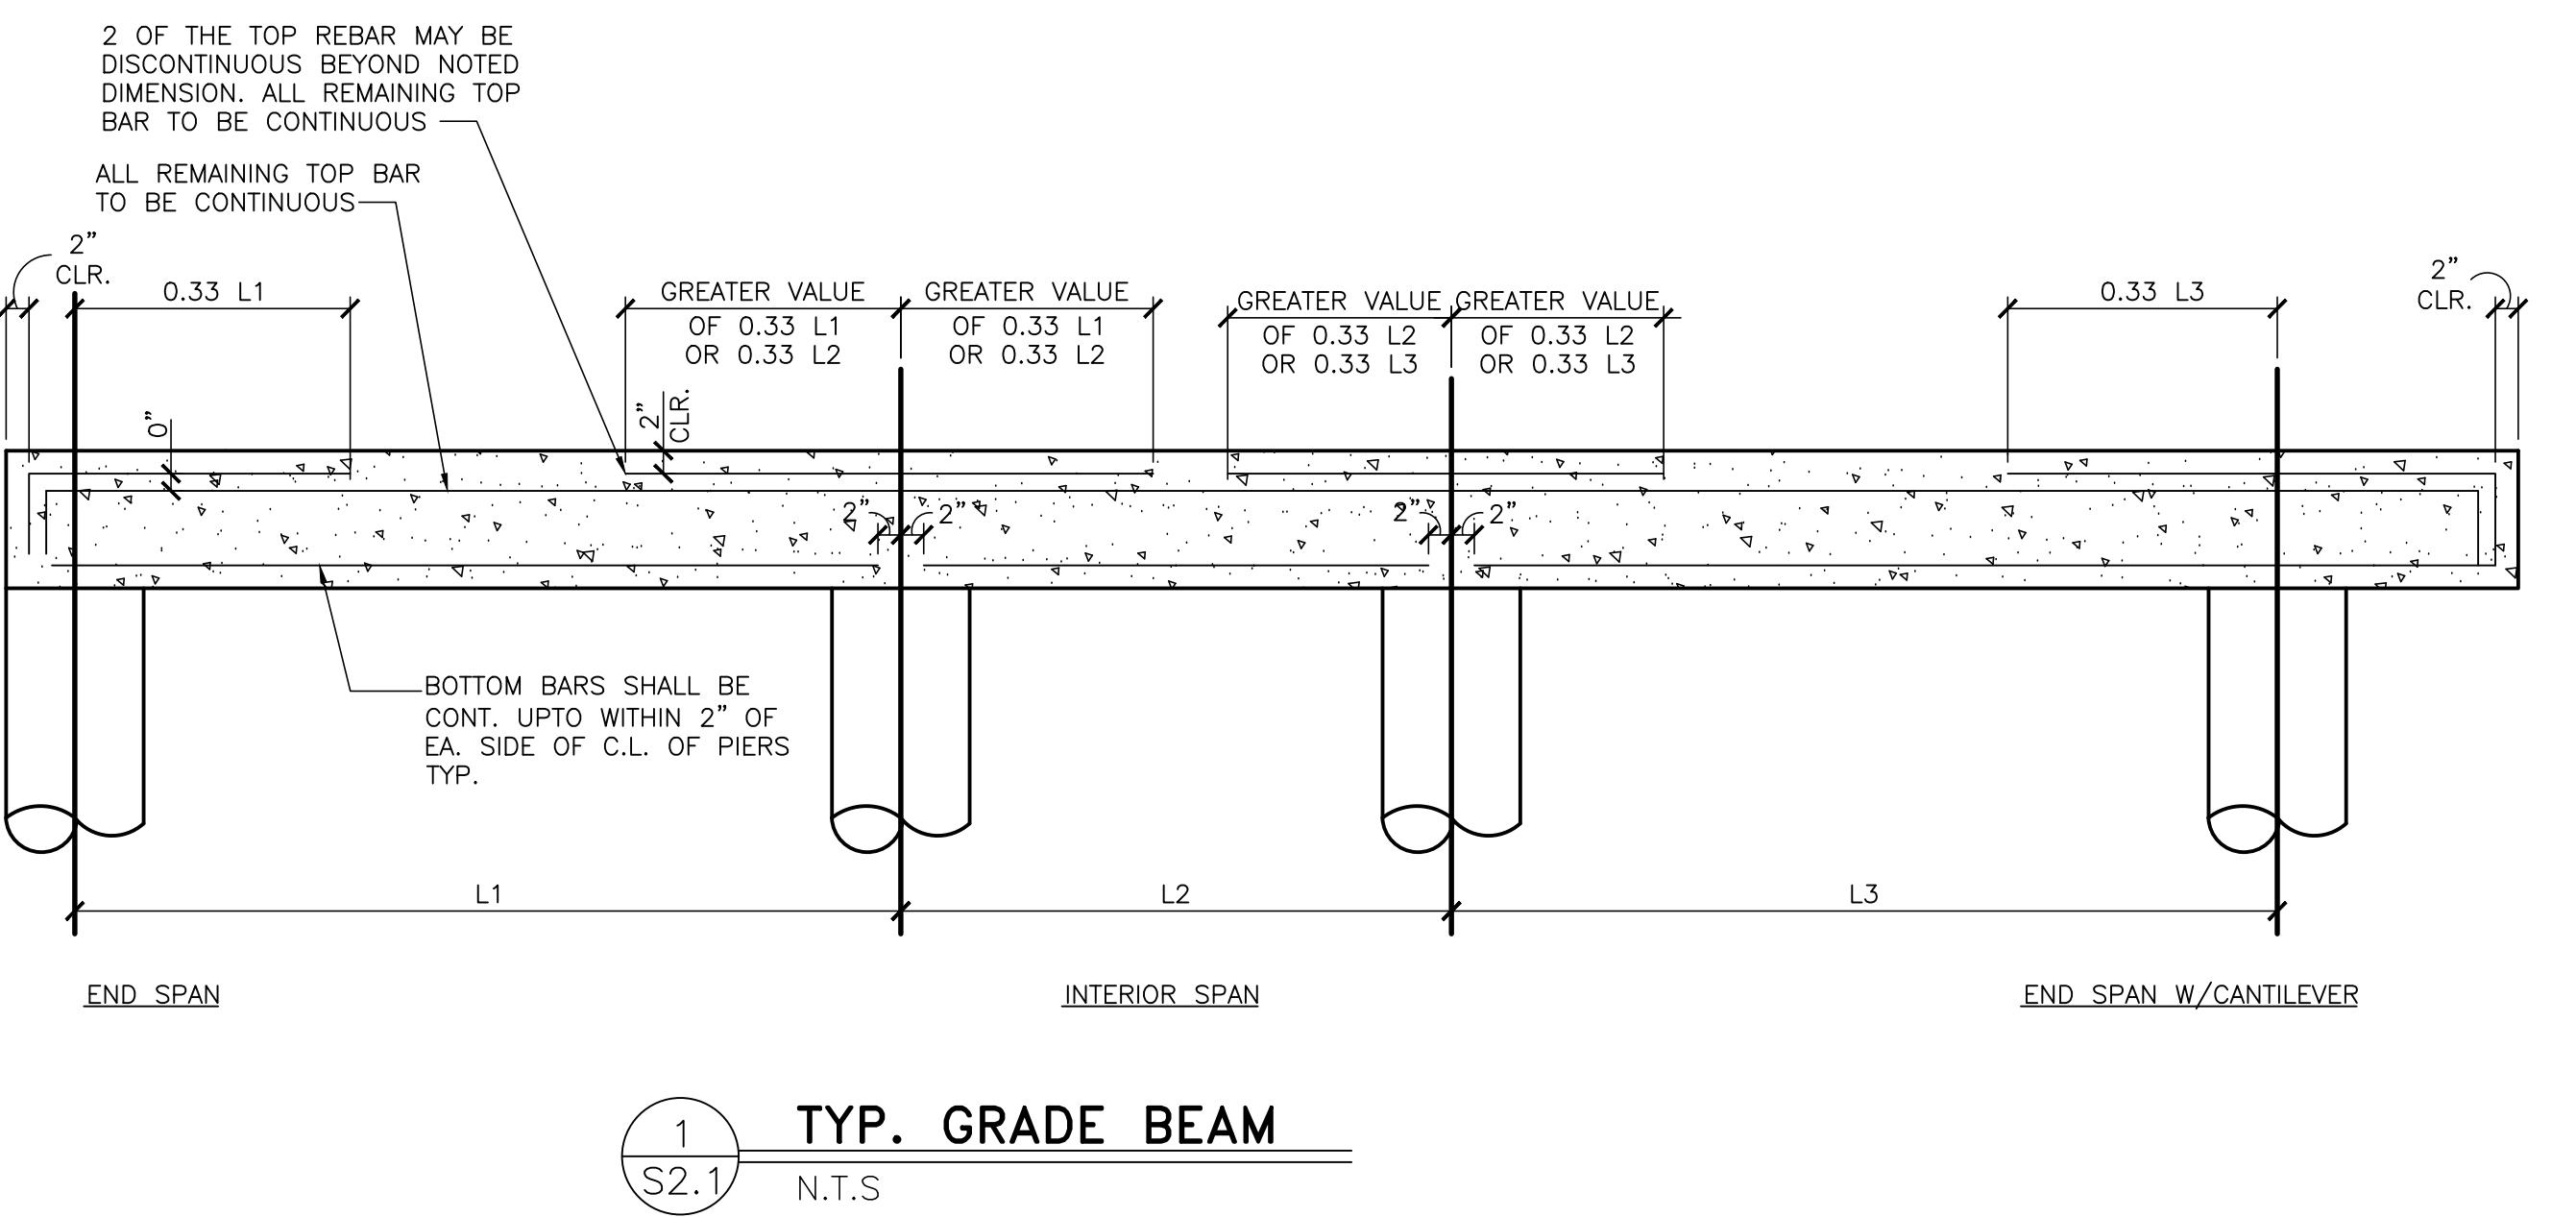

DRILLED PIER SCHEDULE			
MARK	SHAFT DIA.	REINFORCING	MIN PENETRATION IN DARK GREY SHALE
DP1	2'-0"	10 - #6V + #3 @ 12"	4'-0"

PROVIDE 3'-0" LAP SPLICE FOR VERTICAL BARS AS REQUIRED + #3 TIES @ 4"

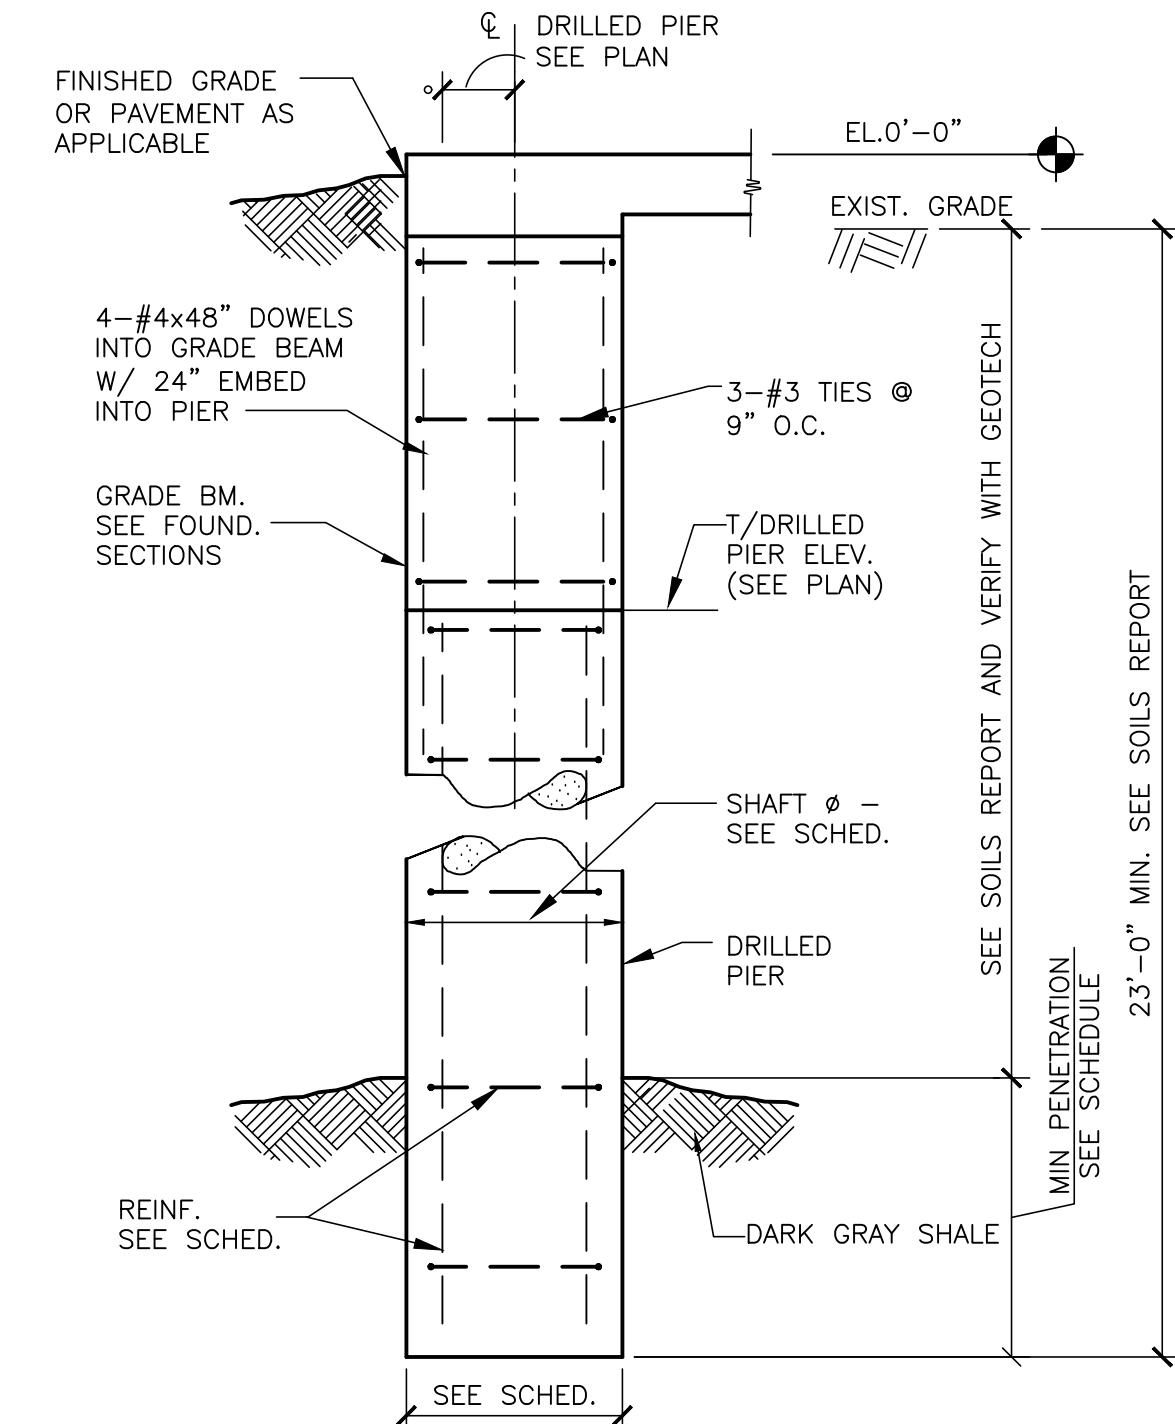


McDonald's USA, LLC

These drawings and specifications are the confidential and proprietary property of McDonald's USA, LLC and shall not be copied or reproduced for use on other specific site in conjunction with its issue date and are not suitable to use on a different site or at a later time. Use of these drawings, reference or reliance on another project requires the written consent of McDonald's USA, LLC. Any unauthorized use or copying of these documents for release on another project is not authorized.

SHEET NO.	TITLE	DRAWN BY
	2023 STANDARD BUILDING - BB20	MKP
	4.597-WOOD/WOOD	STD ISSUE DATE 2023
	WOOD BEARING WALLS W/4" BRICK VENEER	REVIEWED BY AP
	STUCCO/BATEN/BRICK/METAL PANEL EXTERIOR FINISHES	DATE ISSUED 03/08/24
SITE ID	SITE ADDRESS 042-3271 SEC OF S.H. LOOP 288 & HUMMINGBIRD LANE, DENTON TEXAS	

S2.1
DETAILS



rubix
Rubix Consultants, LLC
403 N. Dearborn Street, Suite 1100
Chicago, IL 60611
(312) 602-5411

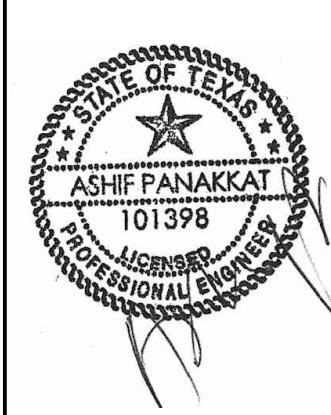



Signed/Sealed:
03/08/2024

TYP DRILLED PIER

2 S2.1 N.T.S.

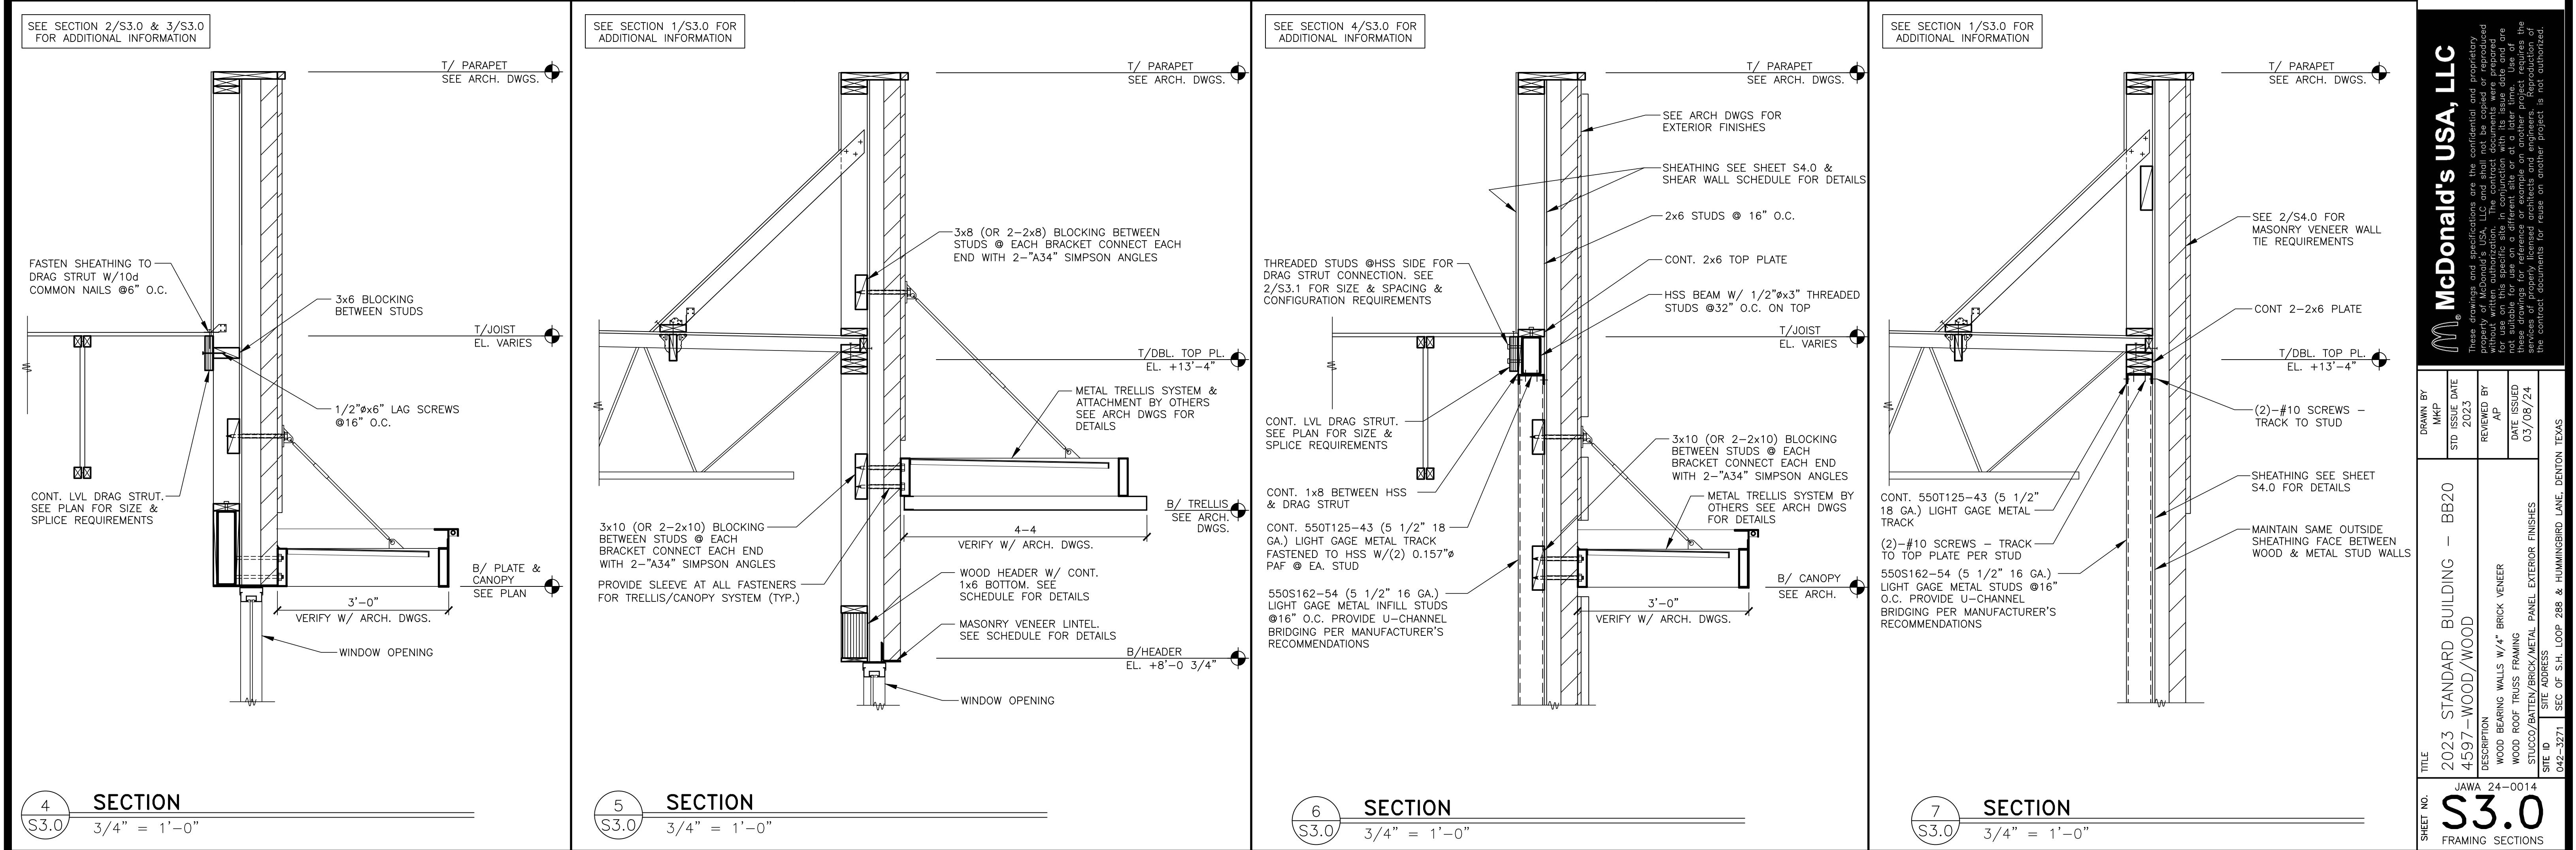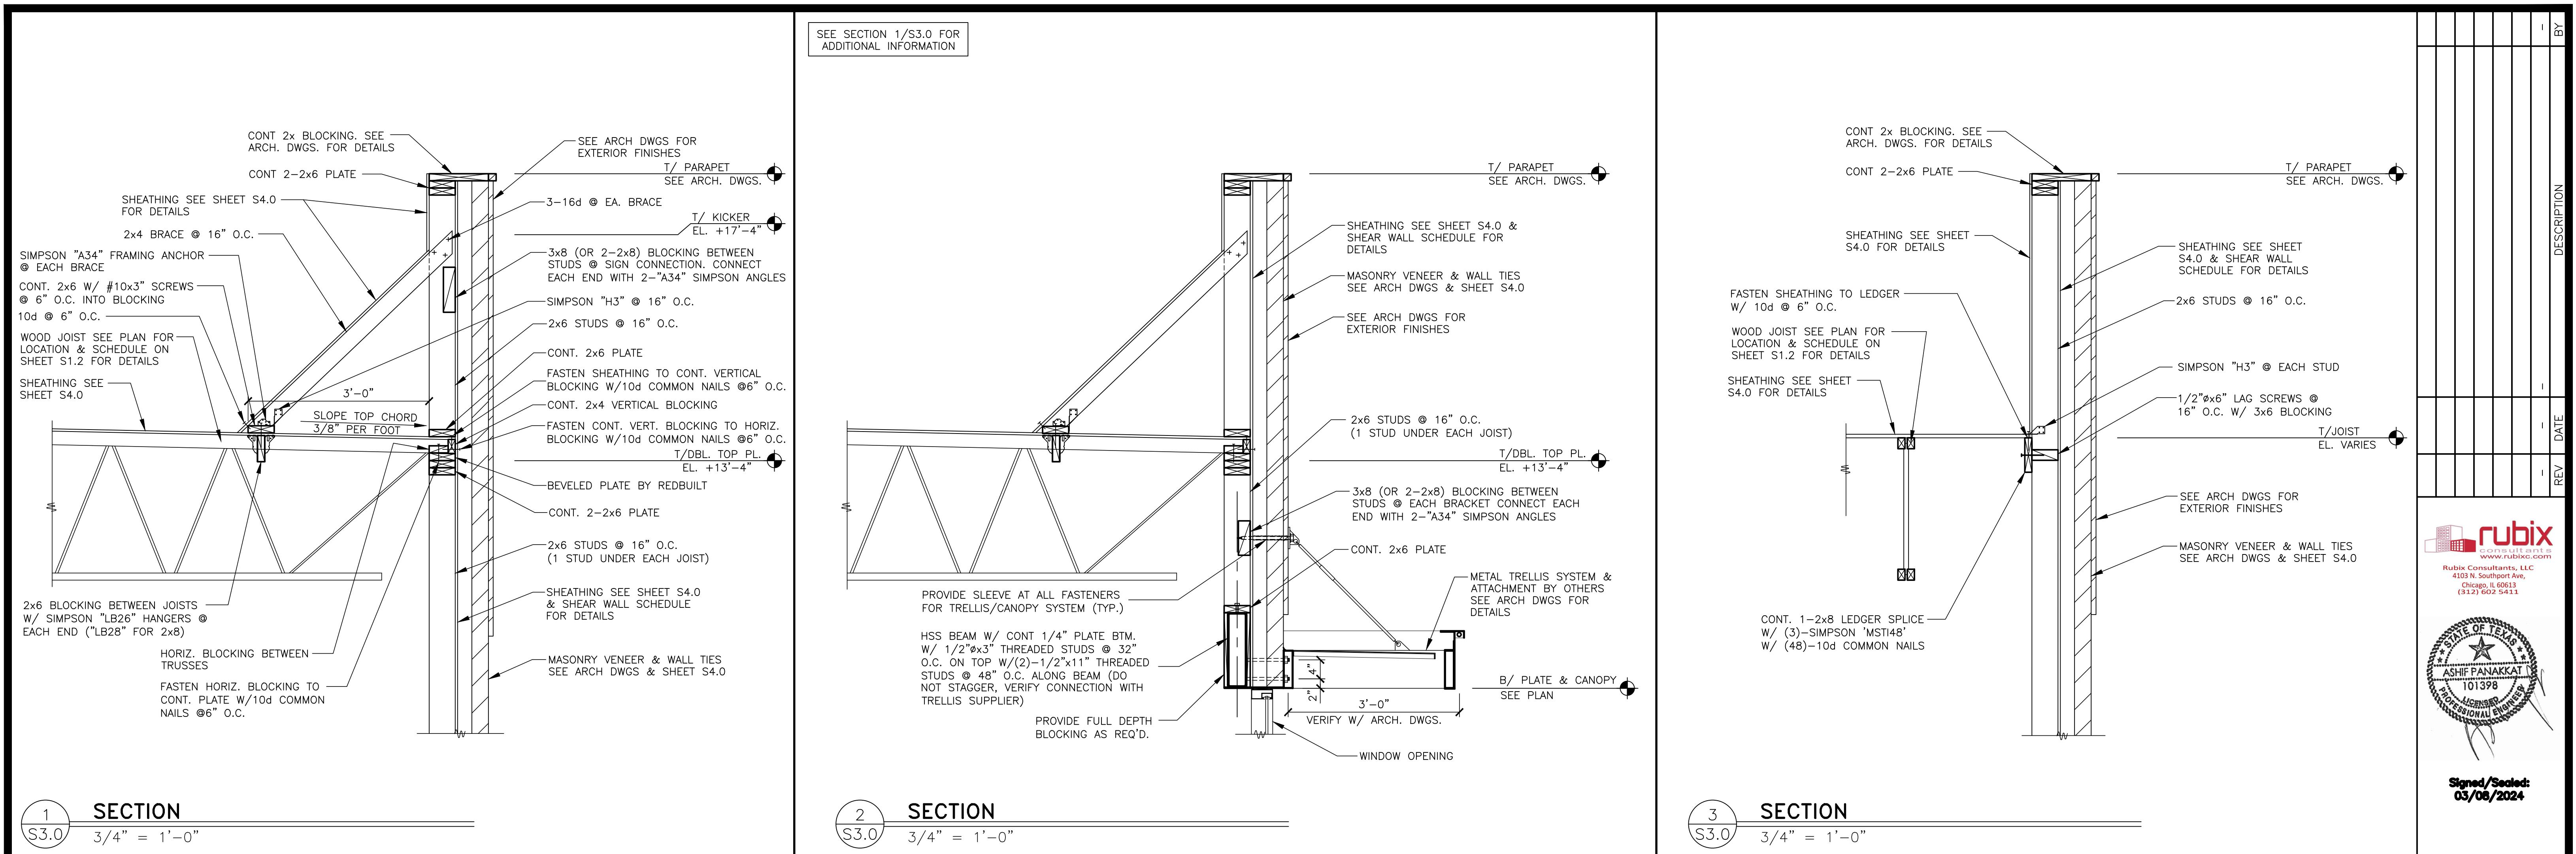


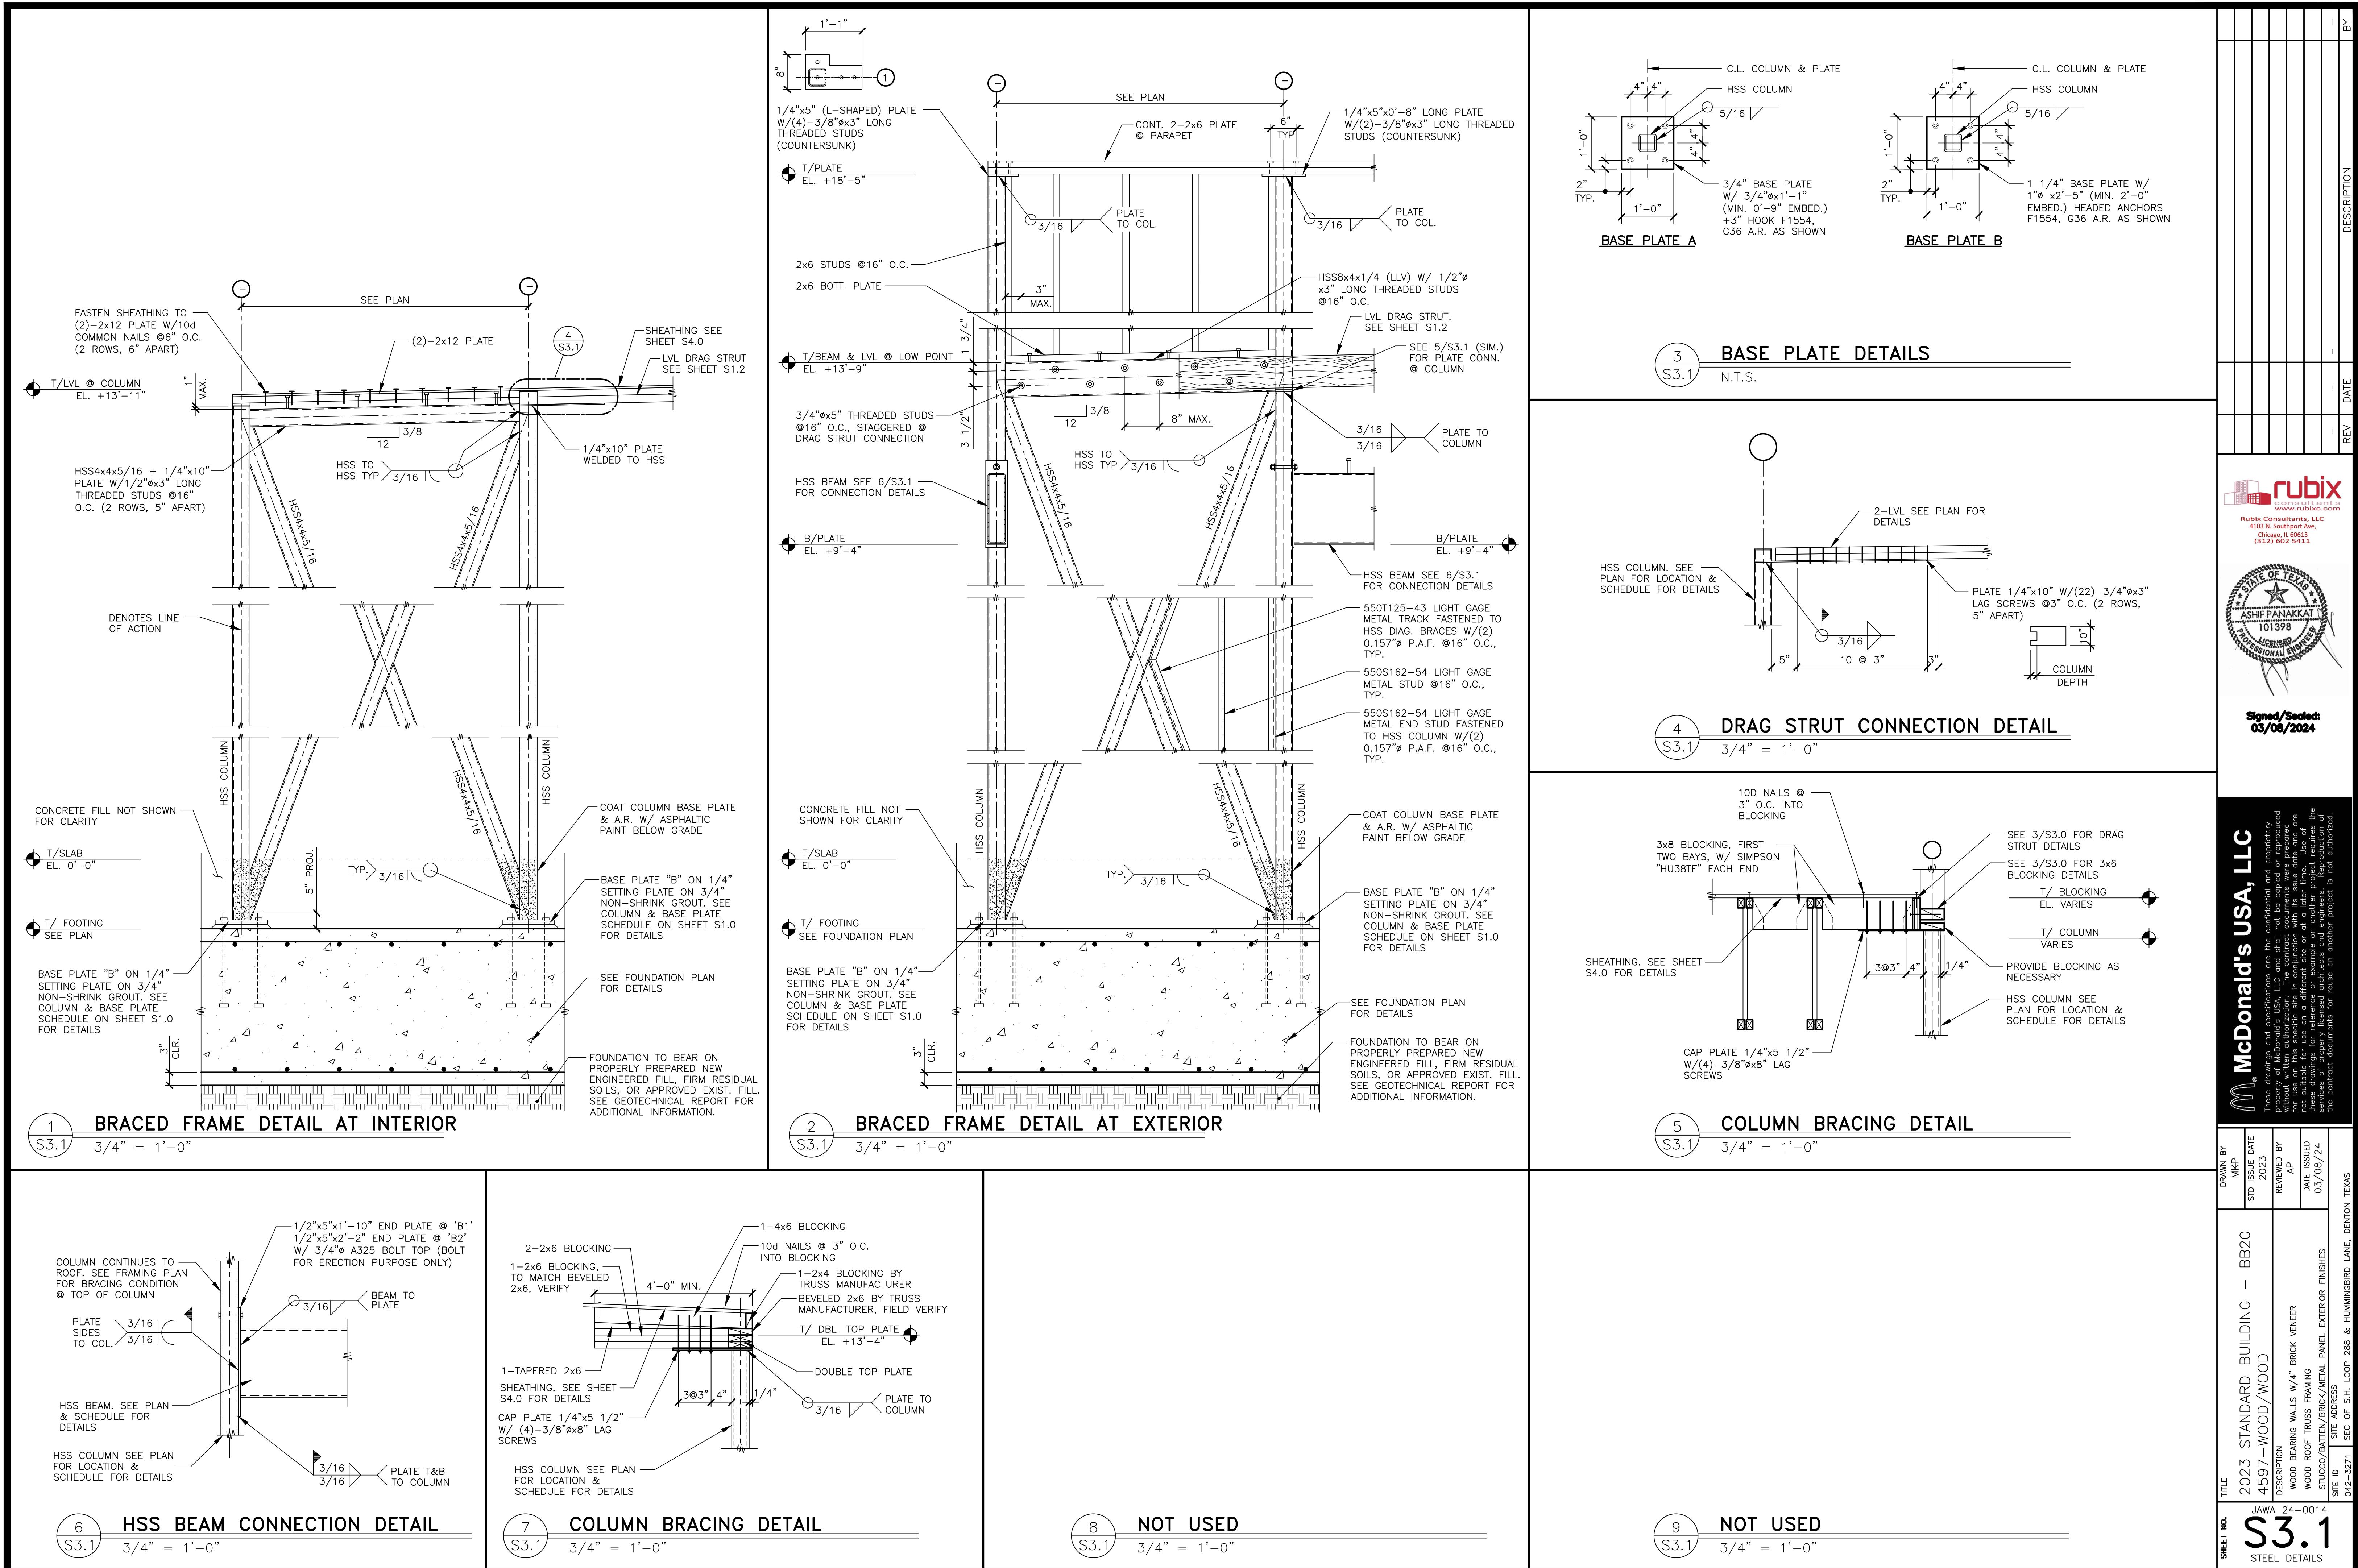


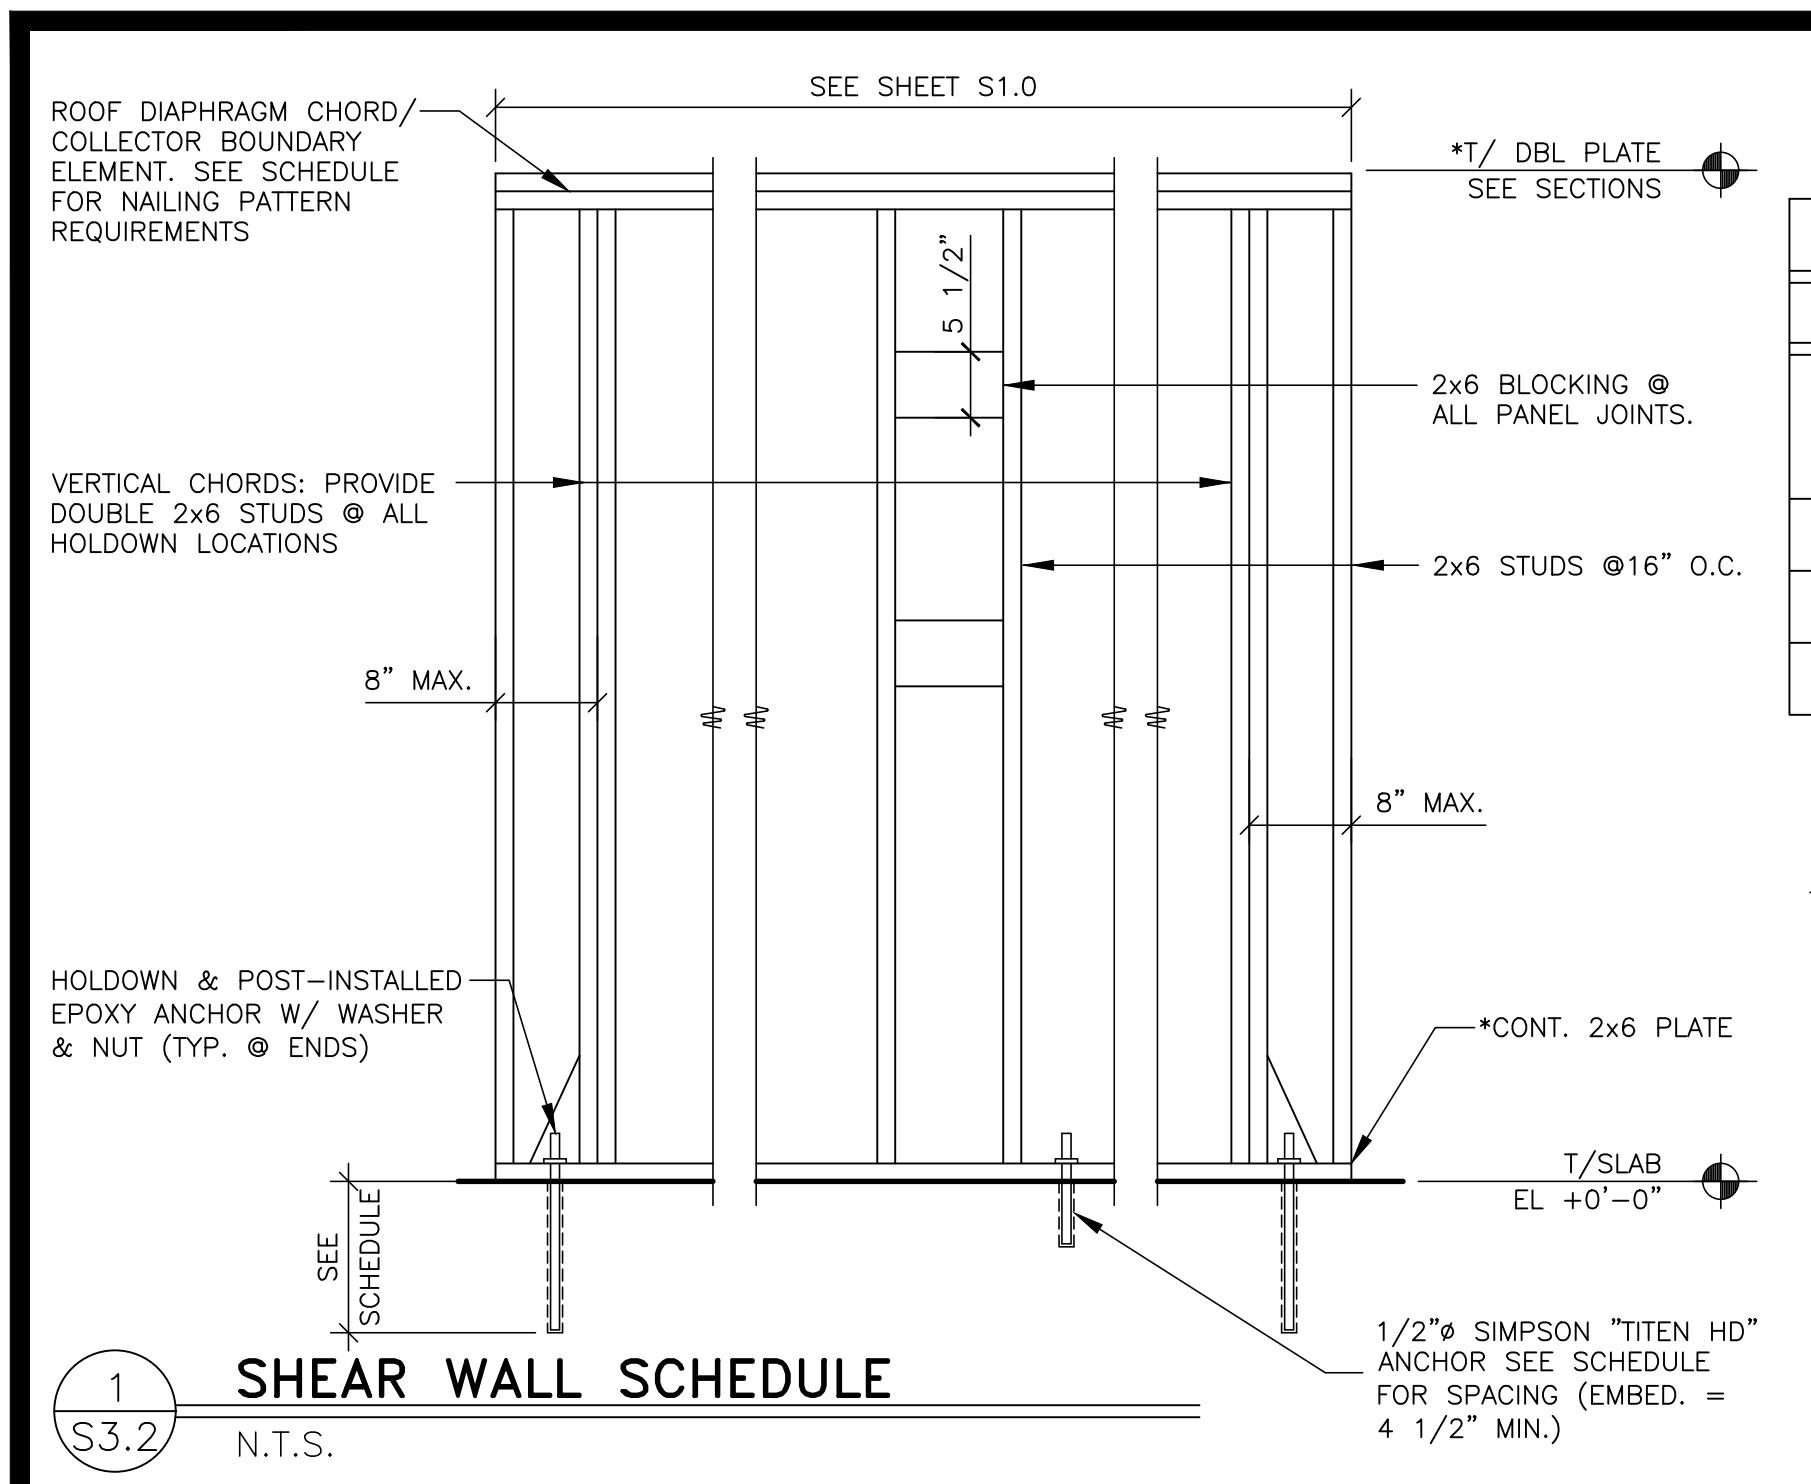

SHEAR WALL SCHEDULE						
WIND: 105 MPH (EXPOSURE C) SEISMIC: Sds = 10.5%, Sd1 = 5.7%						
MARK	SHEATHING	SHEATHING NAIL SIZE	SHEATHING NAIL** SPACING @ PANEL EDGES	HOLDDOWN*** ANCHORS	ANCHOR BOLT SPACING	REMARKS
A	1-15/32"	8d	6"	1-HDU8-SDS2.5 7/8" EPOXY ANCH.	40"	15" MIN. EMBED. ON HOLDDOWN ANCHORS.
B	1-15/32"	8d	6"	1-HDU8-SDS2.5 7/8" EPOXY ANCH.	32"	15" MIN. EMBED. ON HOLDDOWN ANCHORS.
C	1-15/32"	8d	6"	1-HDU8-SDS2.5 7/8" EPOXY ANCH.	40"	15" MIN. EMBED. ON HOLDDOWN ANCHORS.

NOTES:









1. SHEATHING PANELS MAY BE LAID UP HORIZONTALLY OR VERTICALLY. NO VERTICAL PANEL EDGES ON VERTICAL CHORDS (HOLDOWN LOCATION).
2. WIND LOADS GOVERN OVER SEISMIC LOADS UNLESS AS NOTED IN THE REMARKS COLUMN.
3. NAIL ALL SHEATHING TO INTERMEDIATE SUPPORTS @ 12" O.C.
4. SCREW HOLDDOWN ANCHORS TO VERTICAL MEMBER W/ 20"-SDS1/4"x2 1/2" SCREWS EACH
- * IF SILL PLATE OR TOP PLATES ARE NOT CONTINUOUS, CONTACT THE ENGINEER OF RECORD FOR SOLUTION.
- ** NAIL SHEATHING TO ROOF DIAPHRAGM CHORD & TO EACH MEMBER/WALL VERTICAL CHORD W/ 10d COMMON NAILS @ 6" O.C., UNO.
- *** AS MANUF. BY SIMPSON, USE SET HIGH STRENGTH EPOXY FOR THE INSTALLATION OF END THREADED ROD ANCHORS.

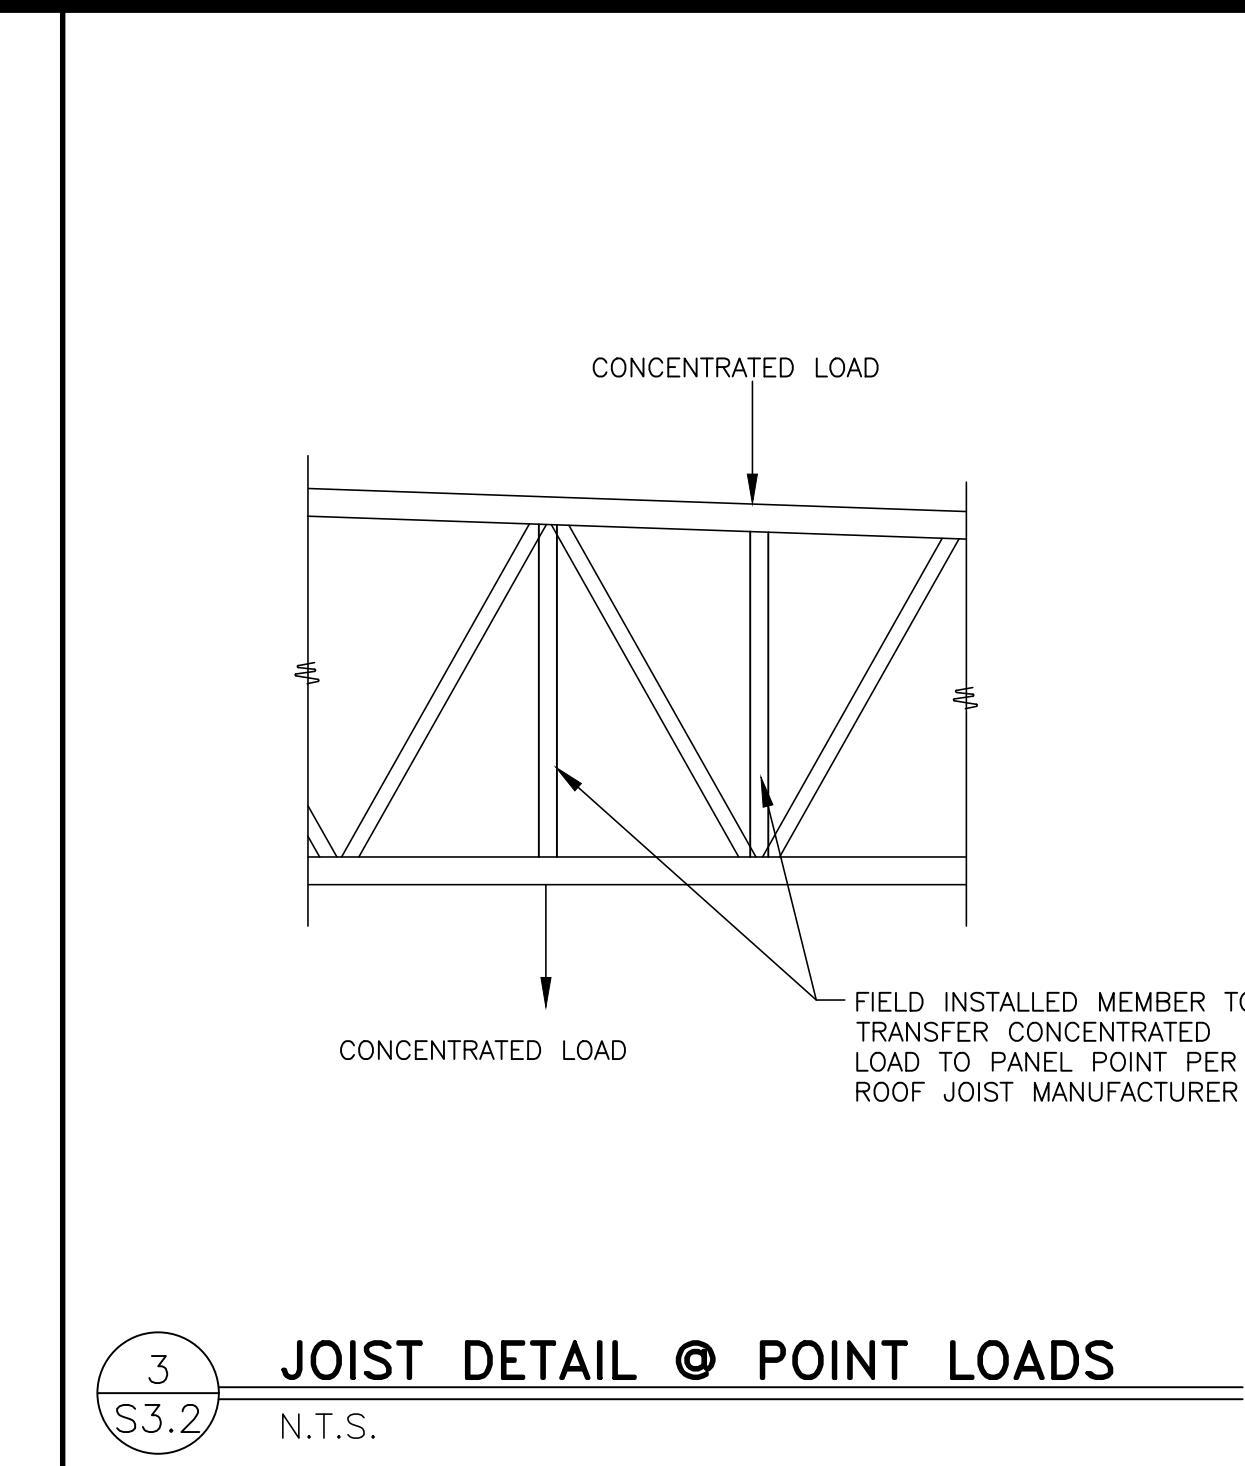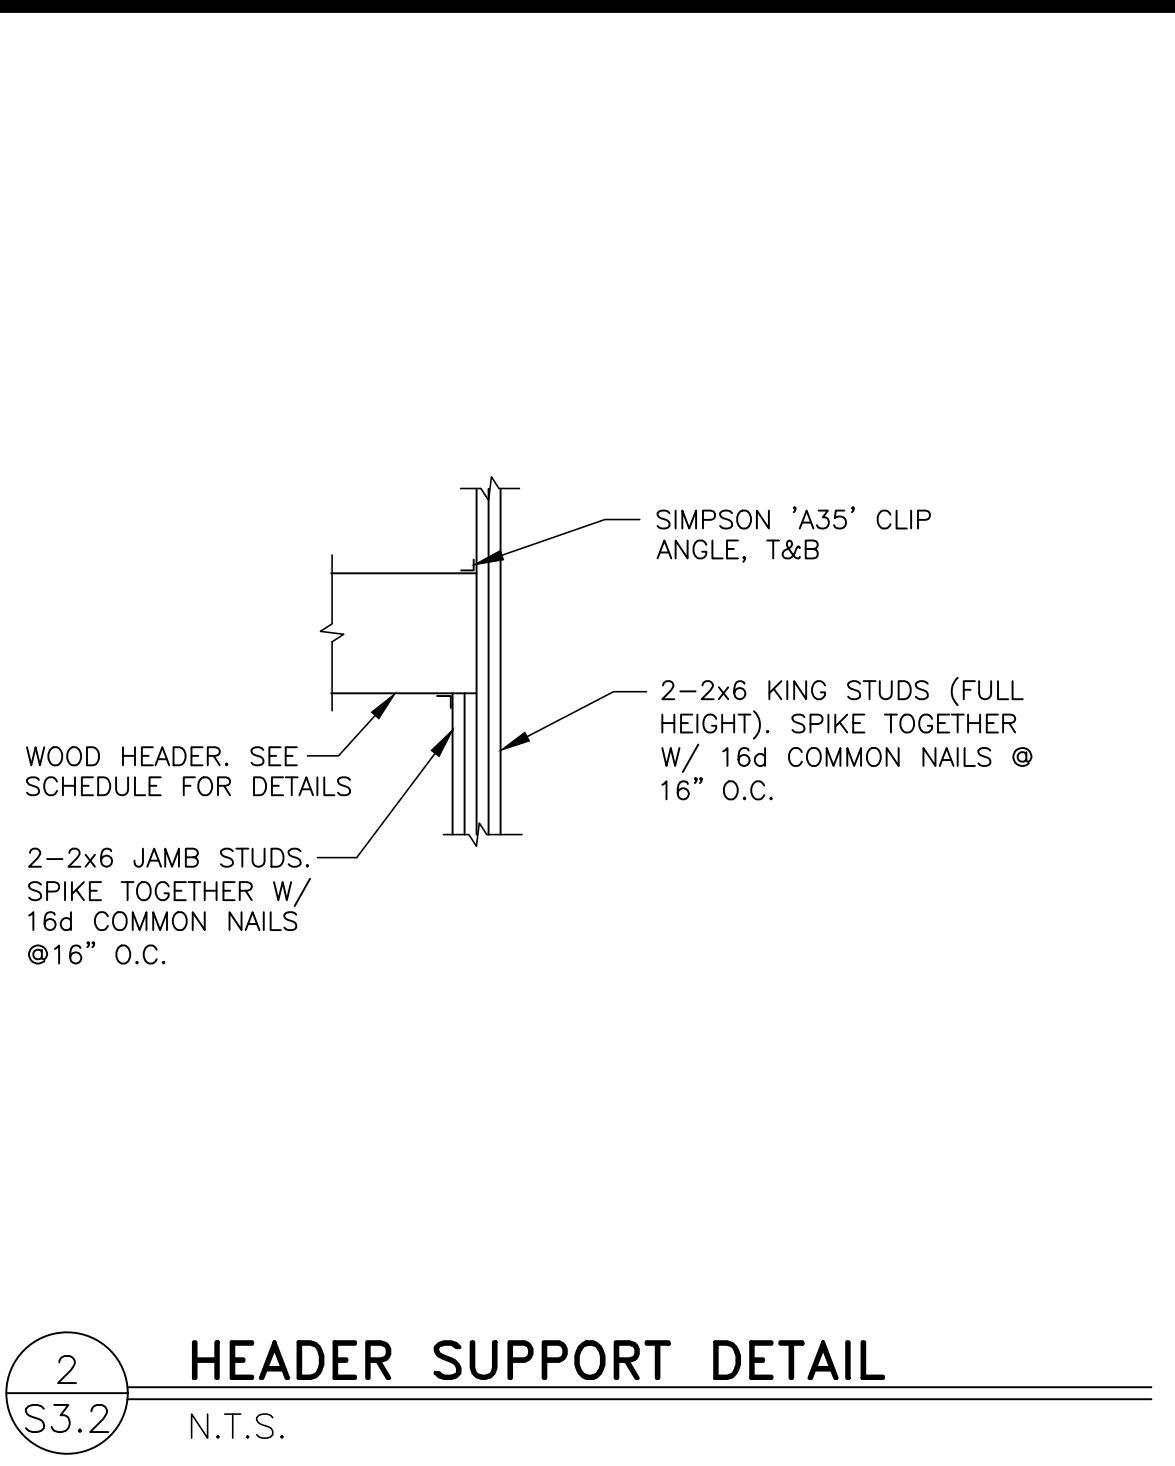

REV	DATE	DESCRIPTION

RUBIX
Rubix Consultants, LLC
403 N. Dearborn Ave.
Chicago, IL 60601
(312) 602-5411


**Signed/Sealed:
03/08/2024**

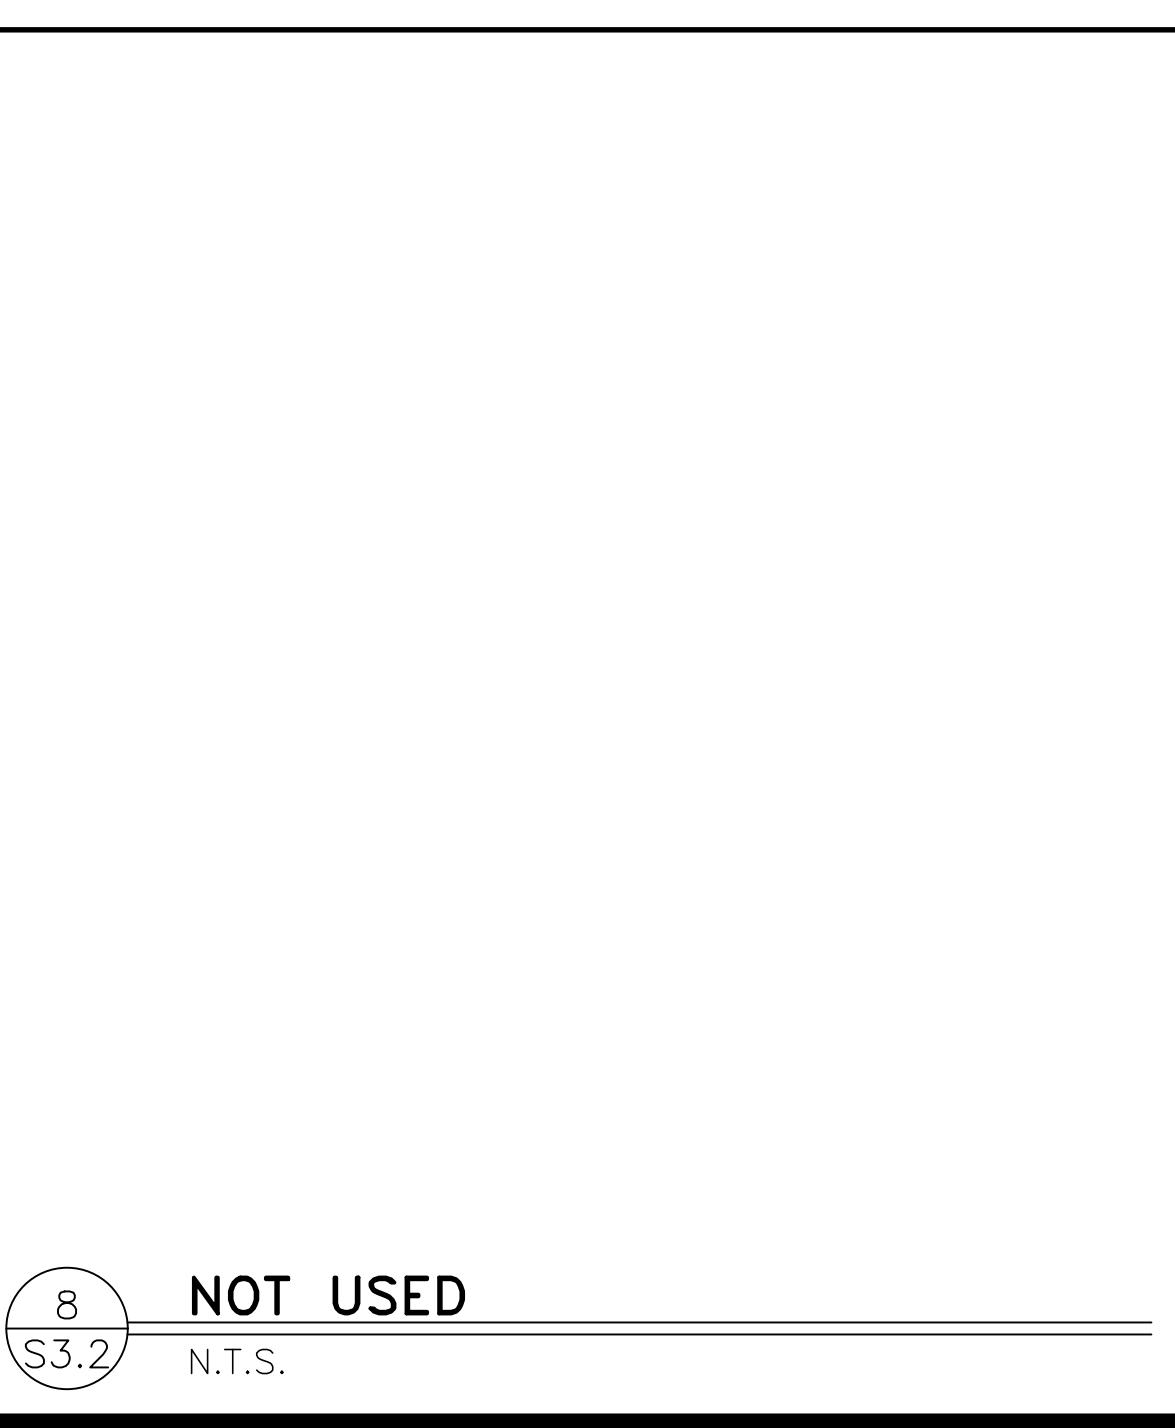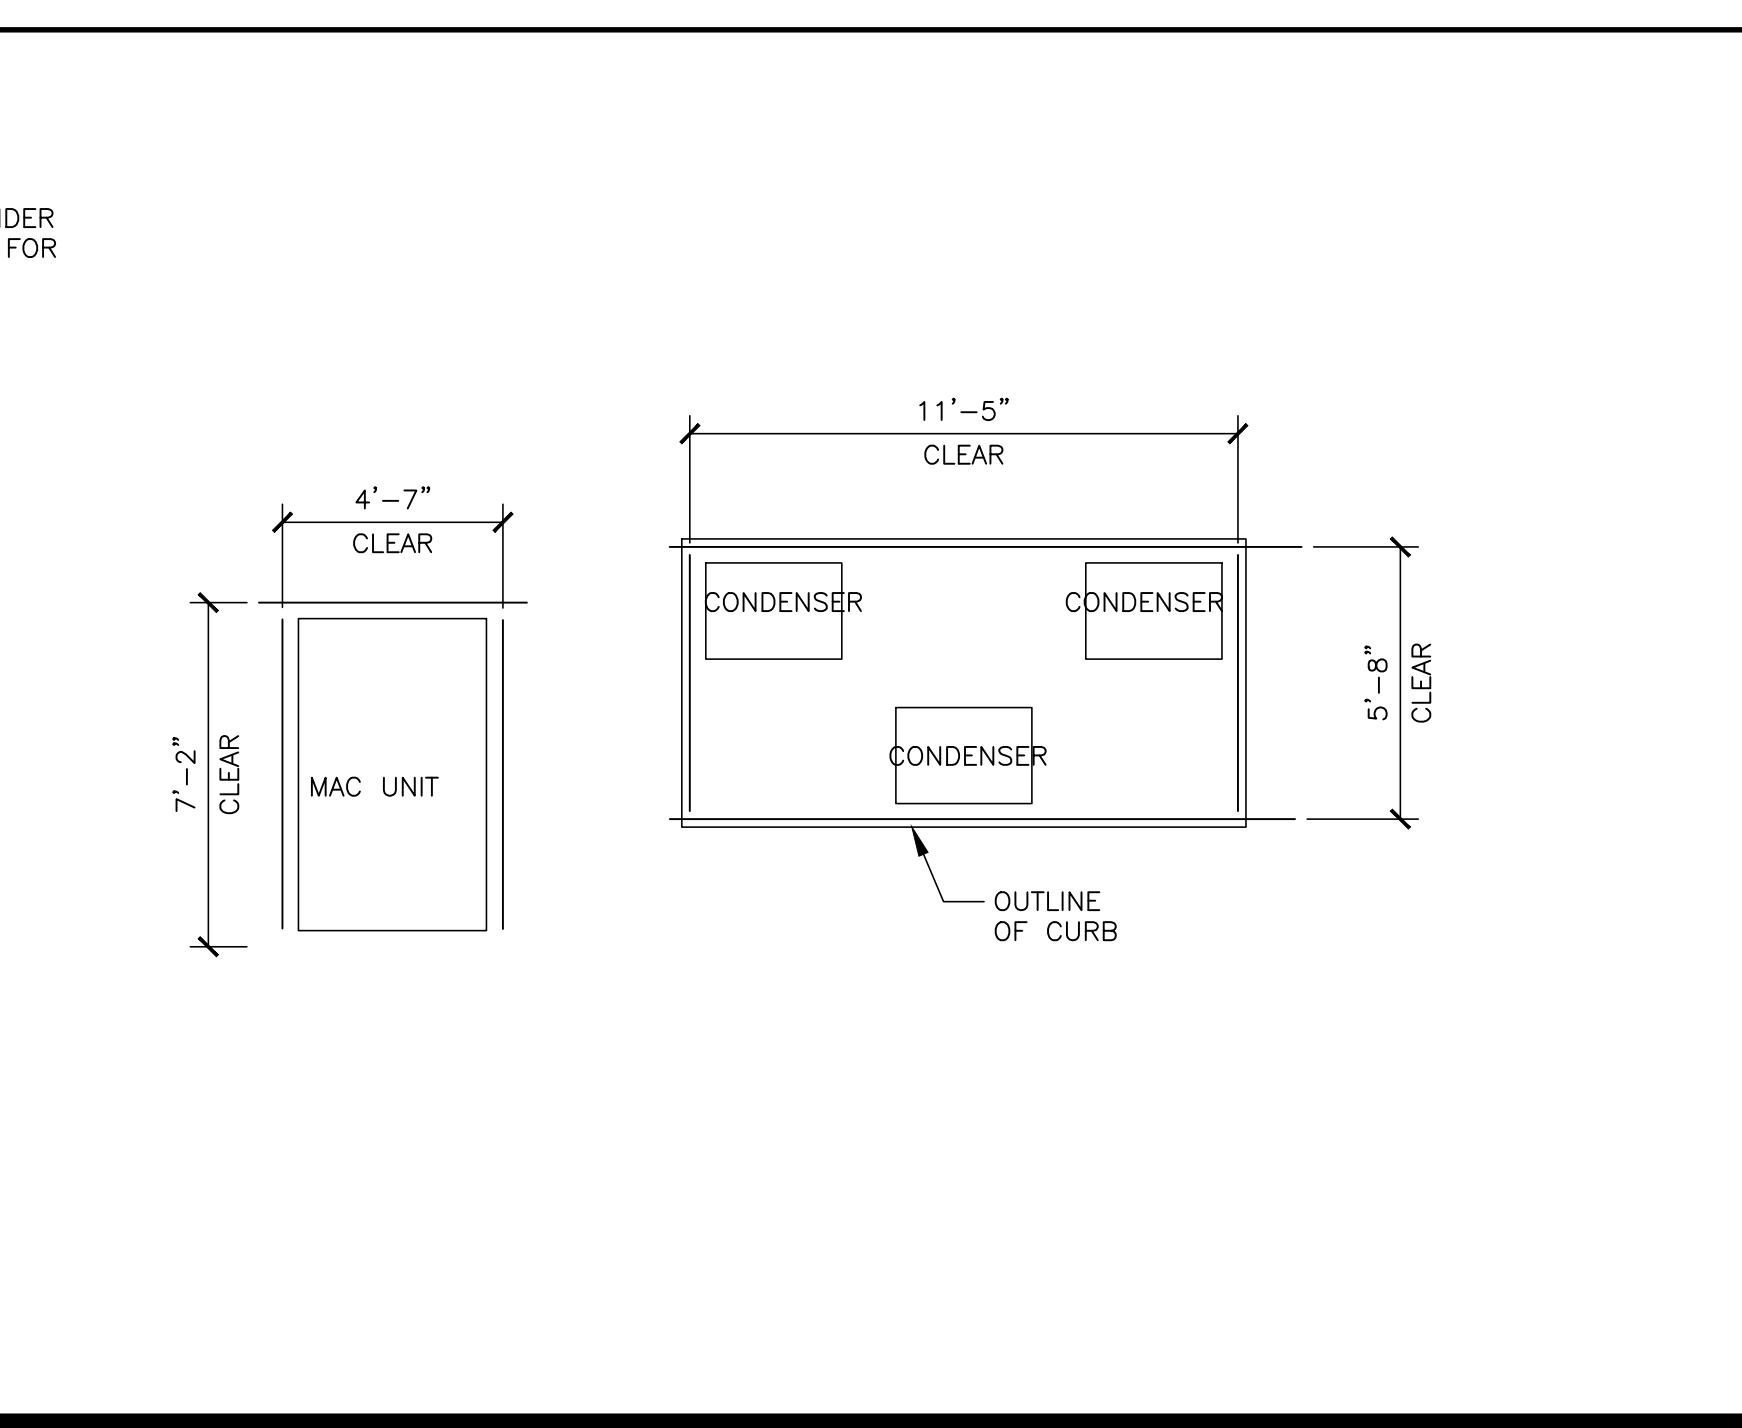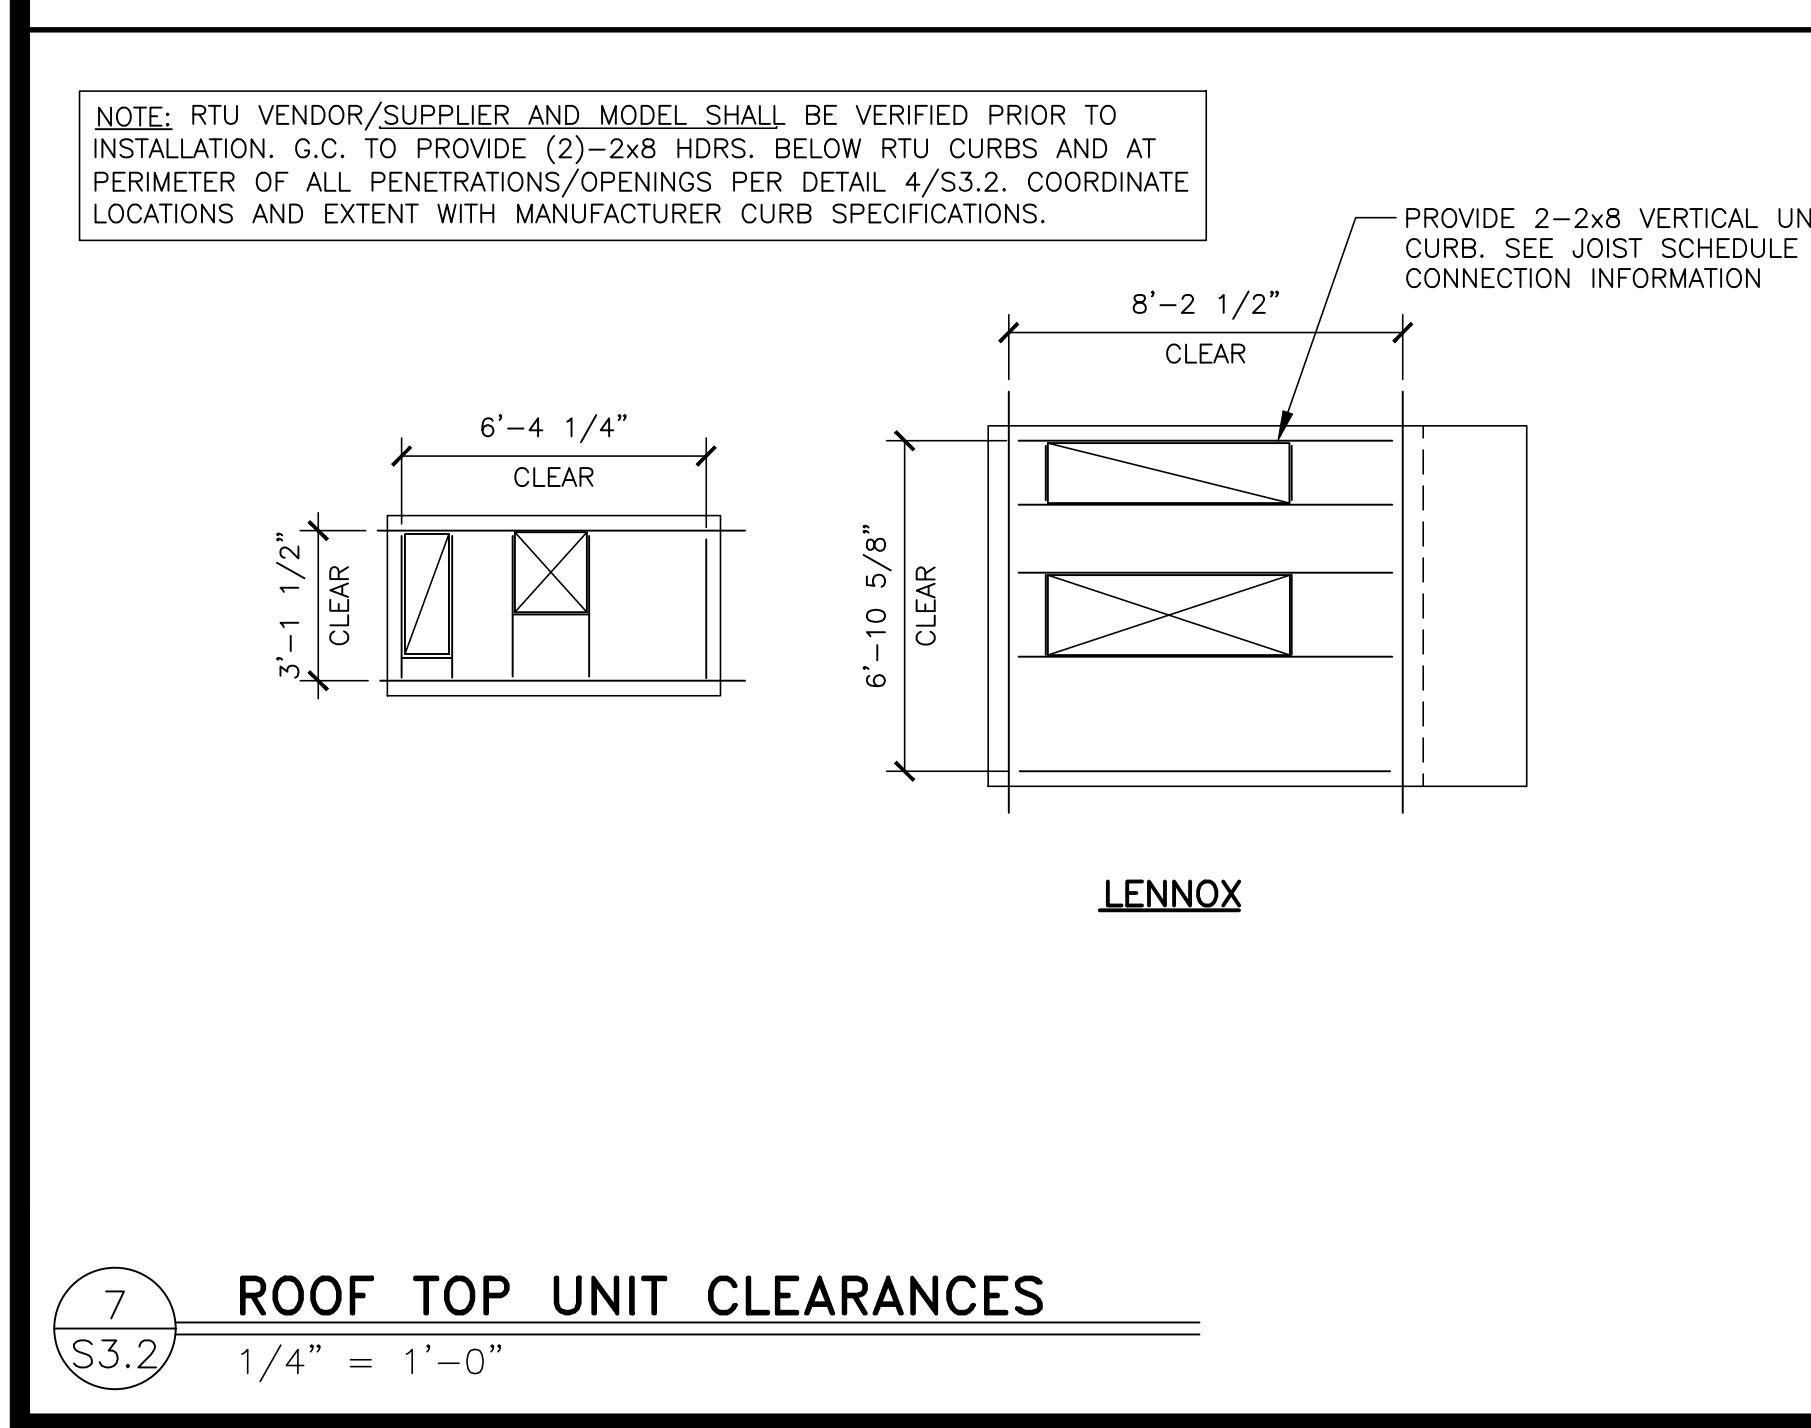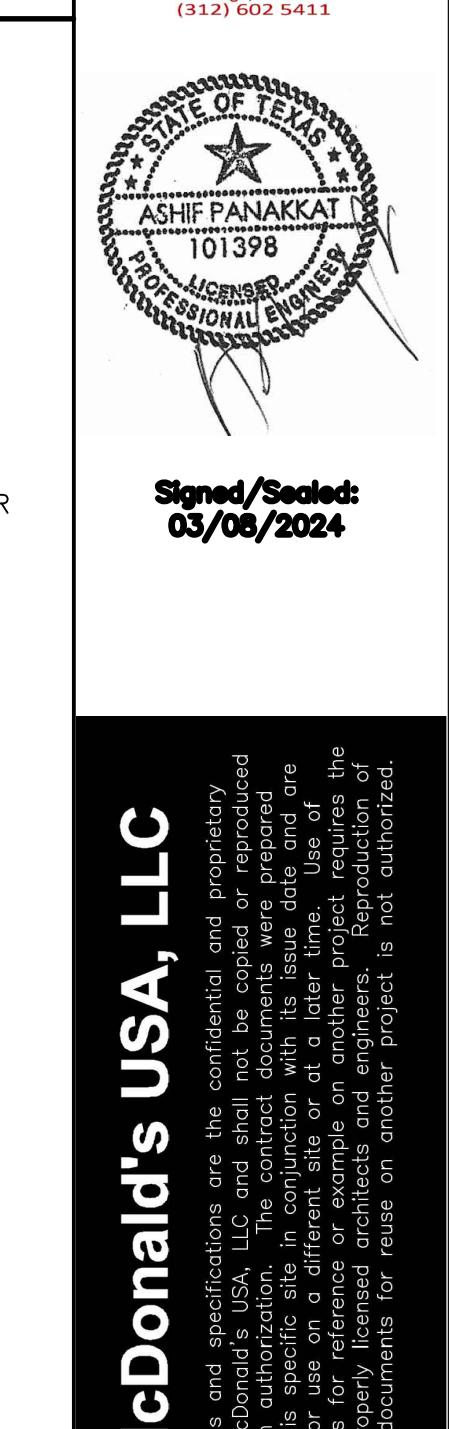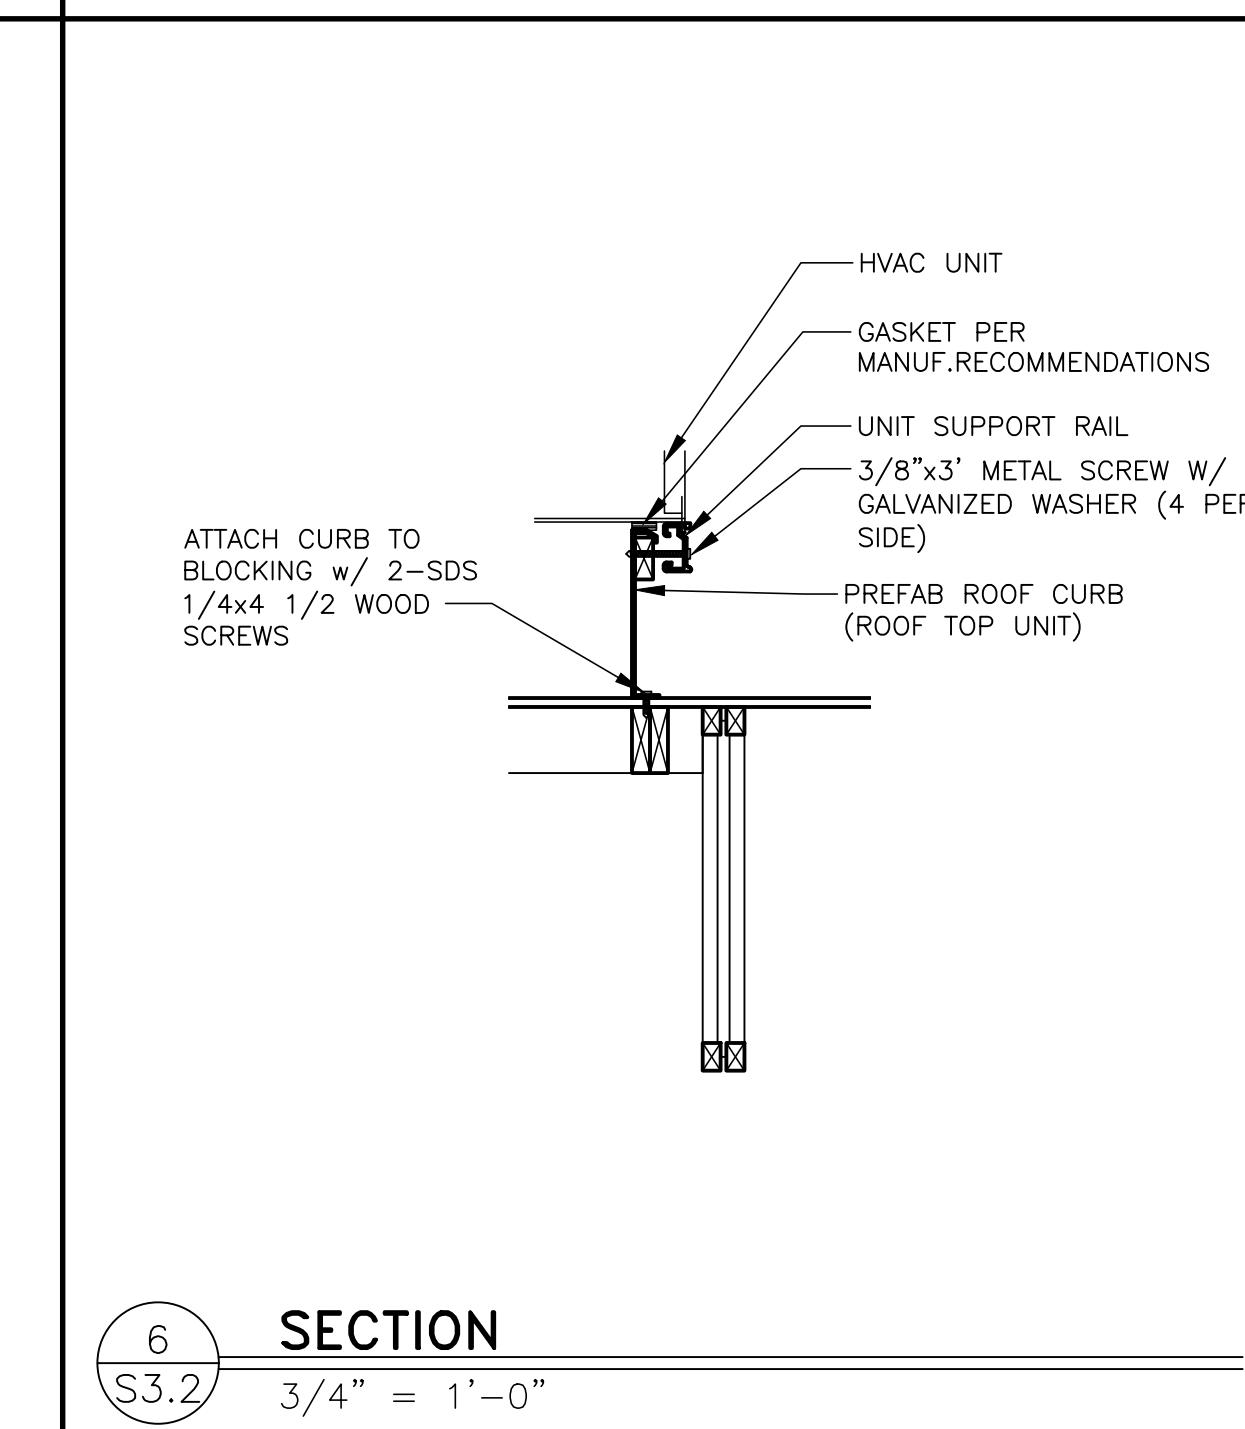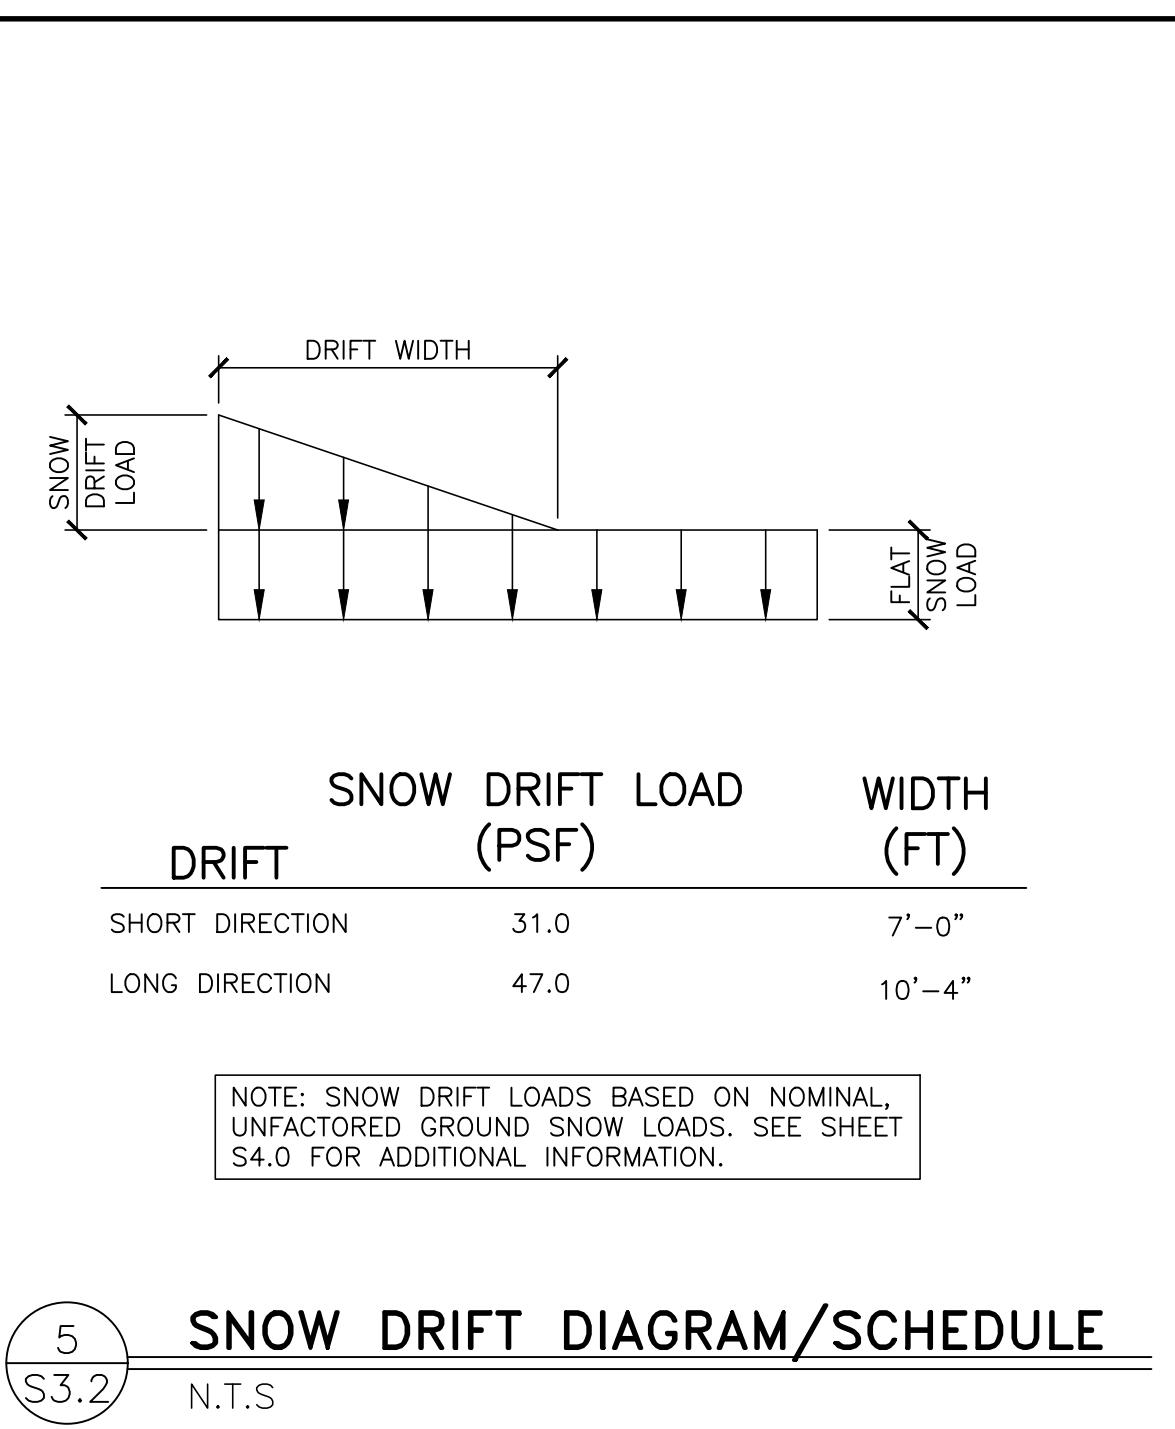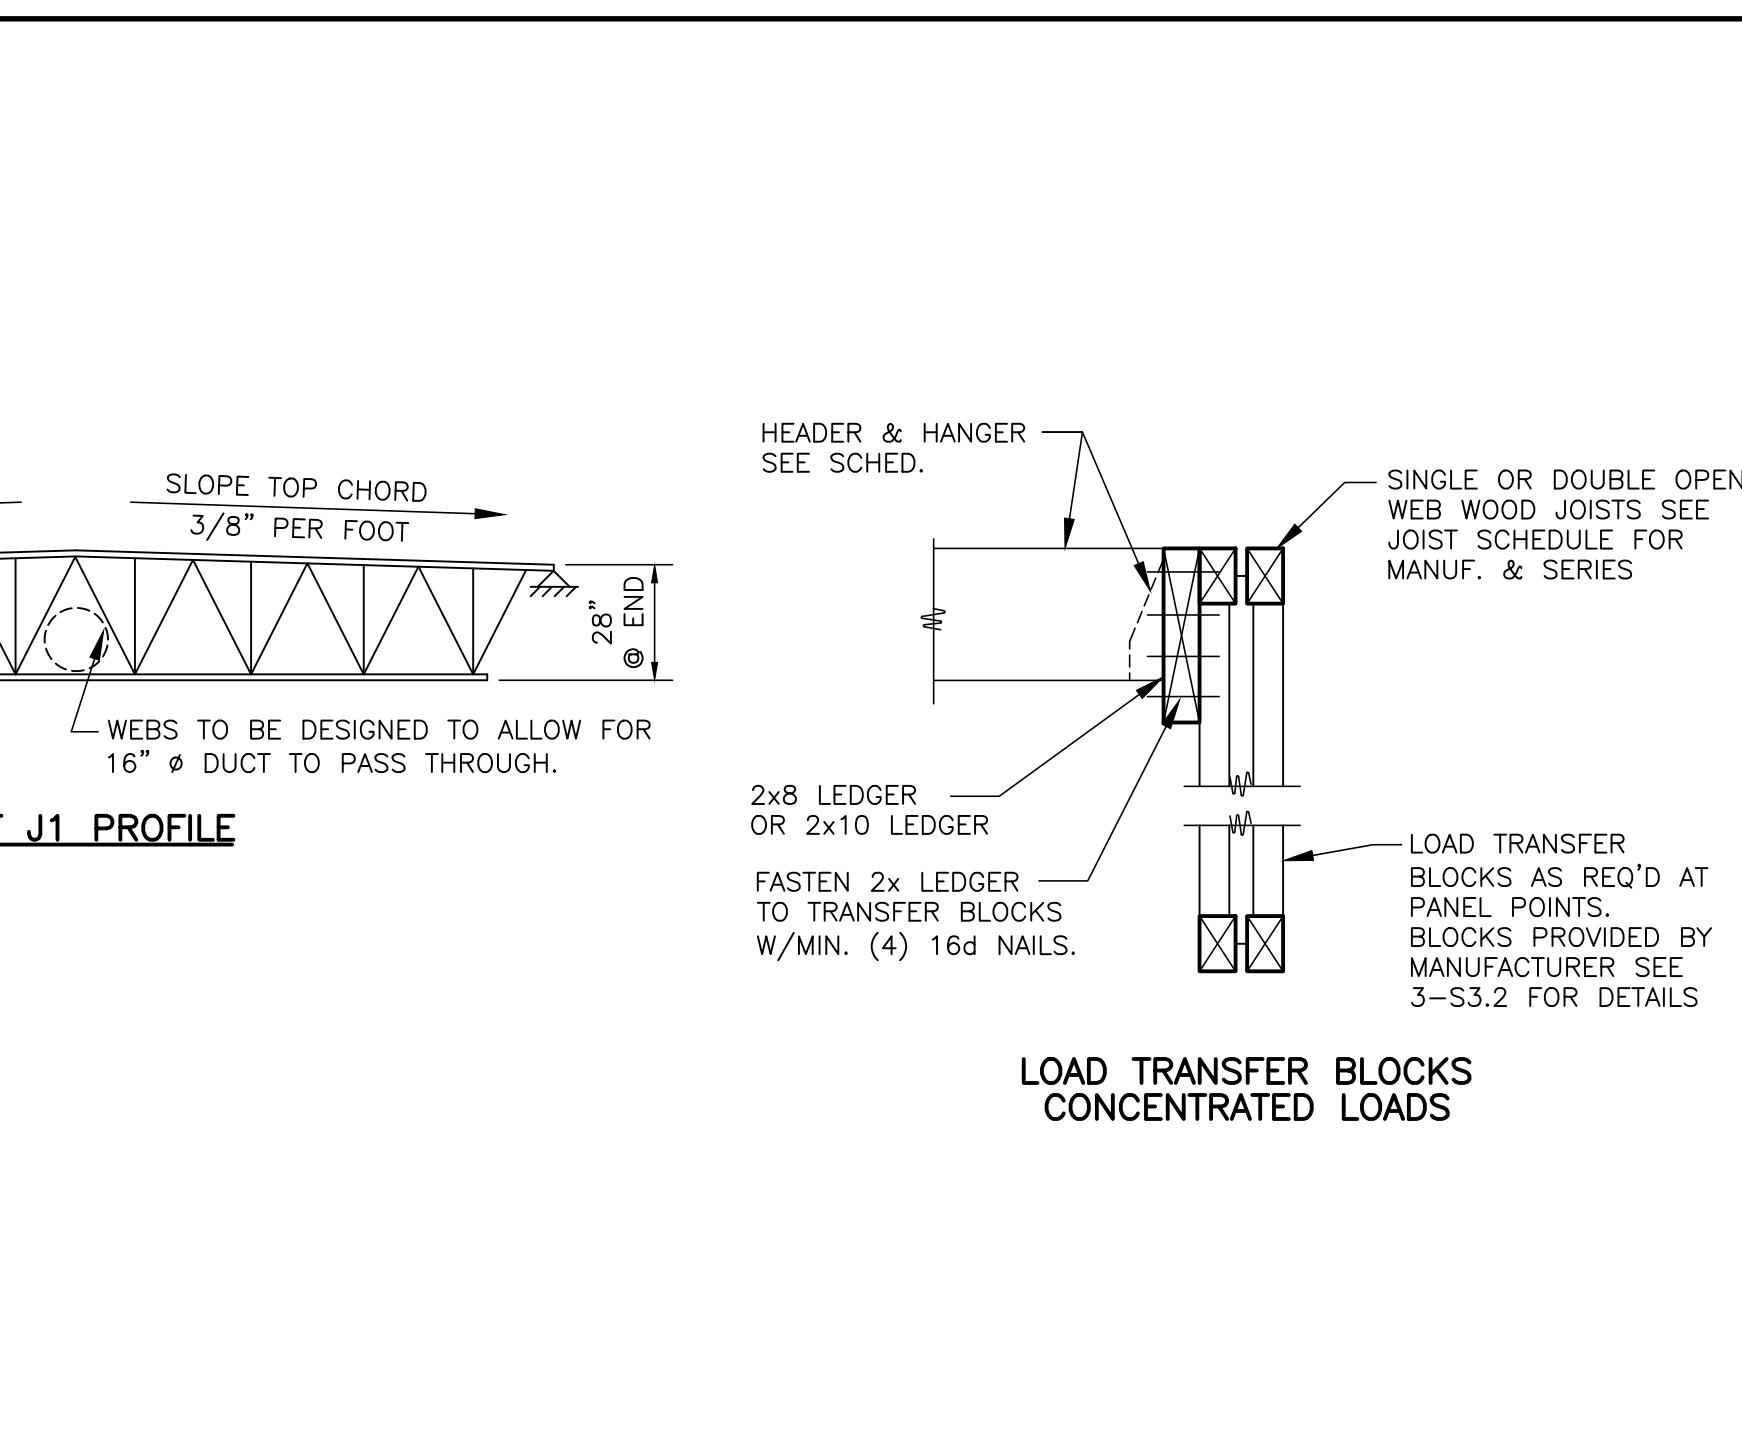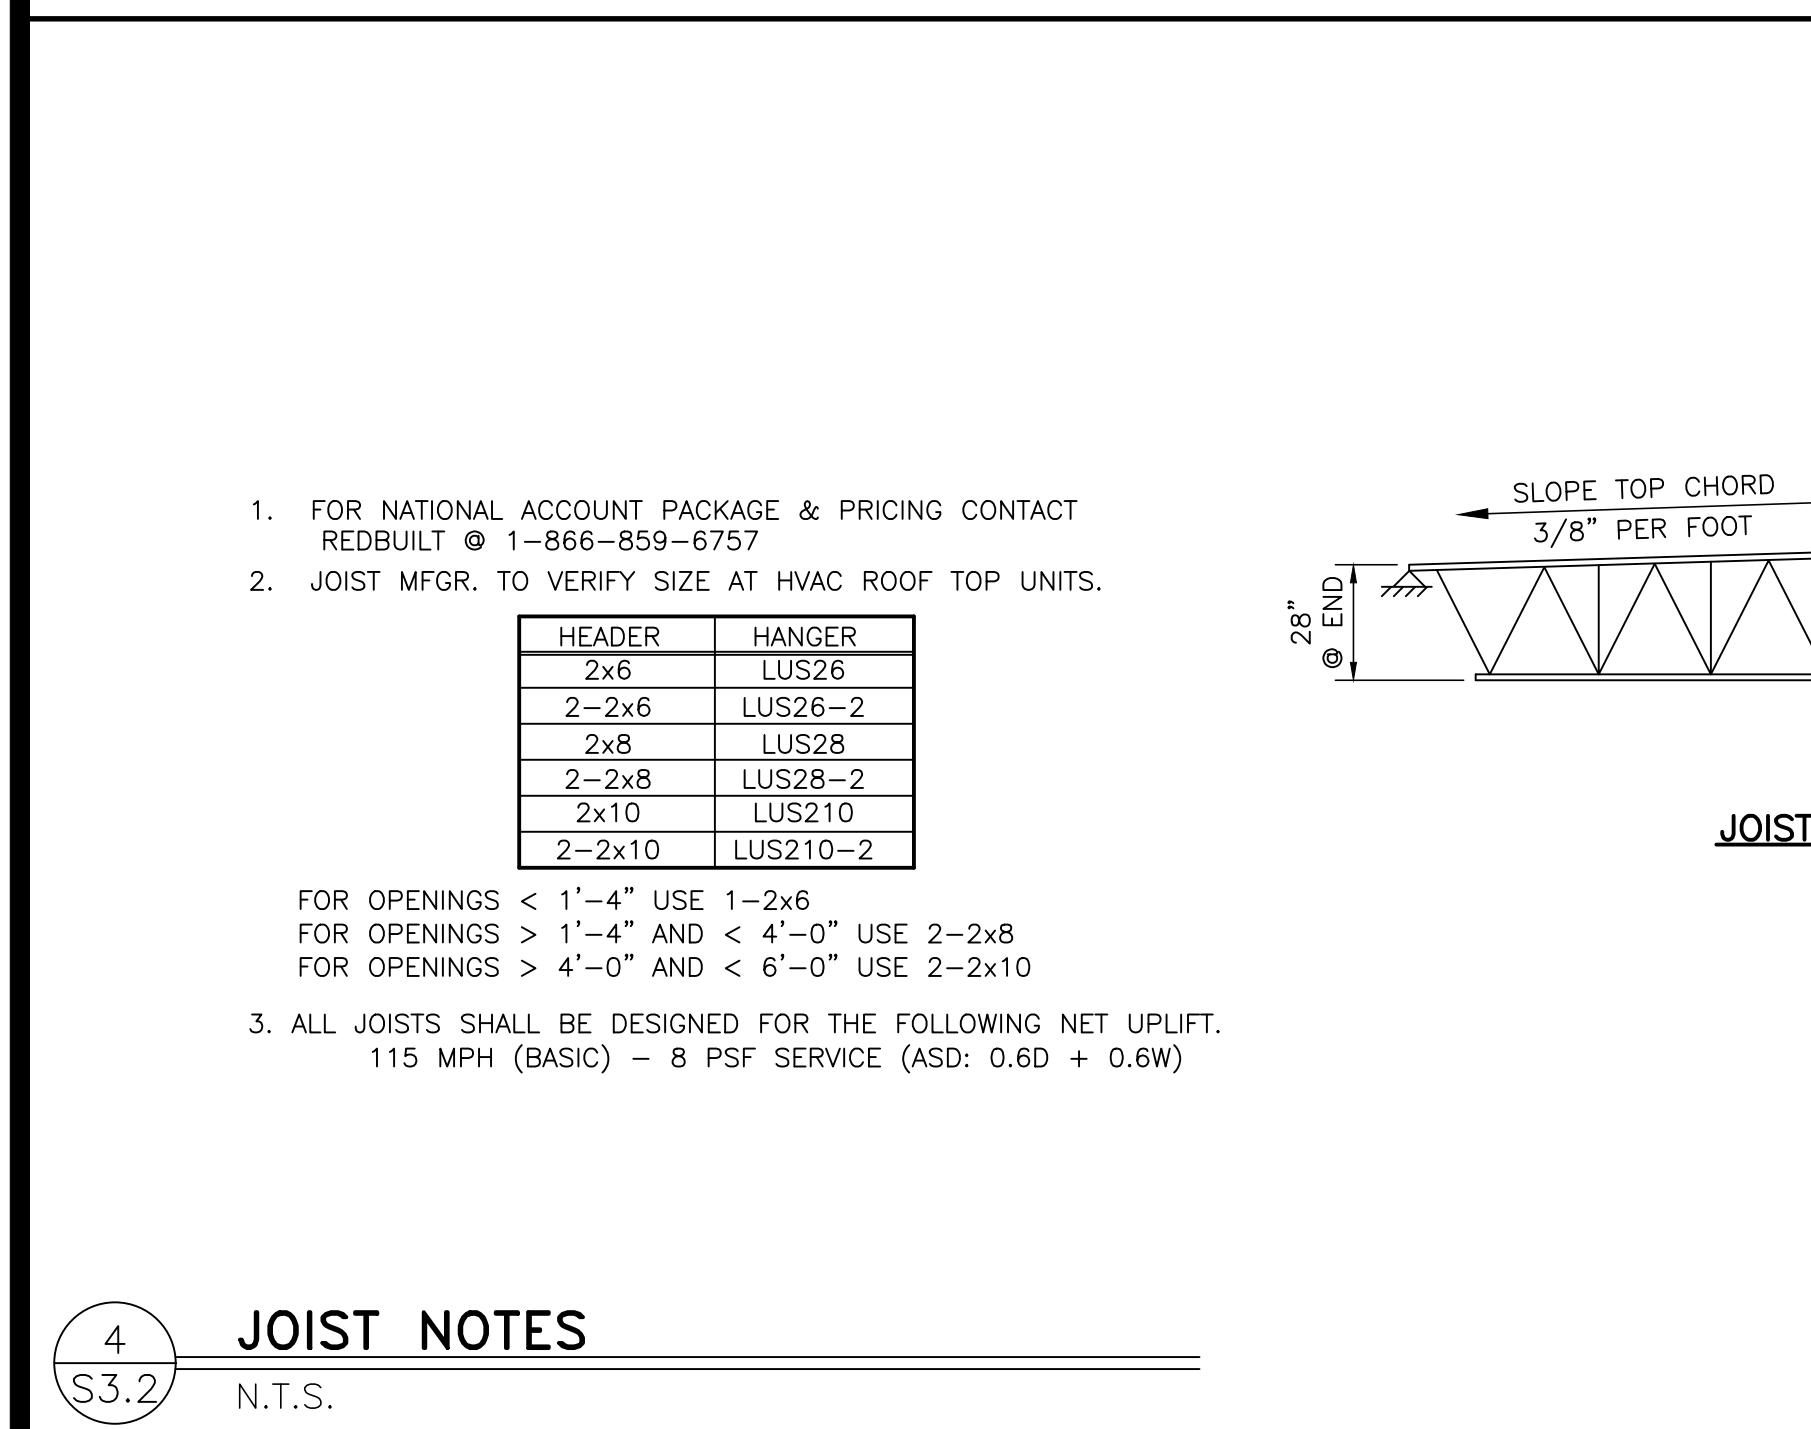


SHEET NO.	TITLE	DRAWN BY	STD ISSUE DATE
	2023 STANDARD BUILDING - BB20	MKP	2023
	4.597-WOOD/WOOD	AP	
	WOOD BEARING WALLS W/4" BRICK VENEER		
	STUCCO/BATEN/BRICK/METAL PANEL EXTERIOR FINISHES		
	SITE ADDRESS		
	SEC OF S.H. LOOP 288 & HUMMINGBIRD LANE, DENTON TEXAS		
	042-3271		

JAWA 24-0014

S3.2 DETAILS

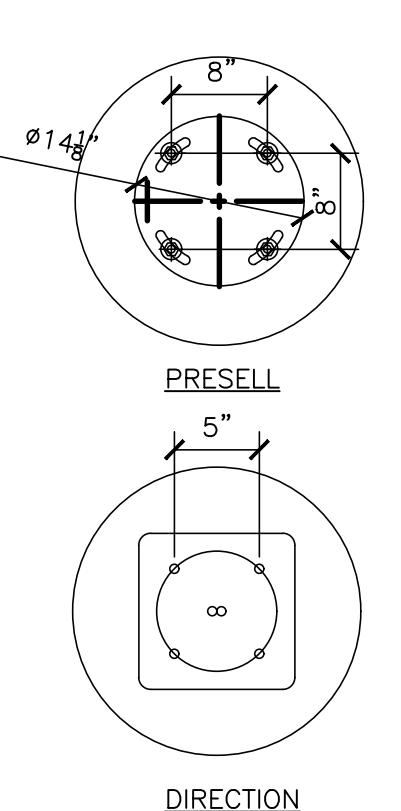

ANCHOR BOLT PATTERN

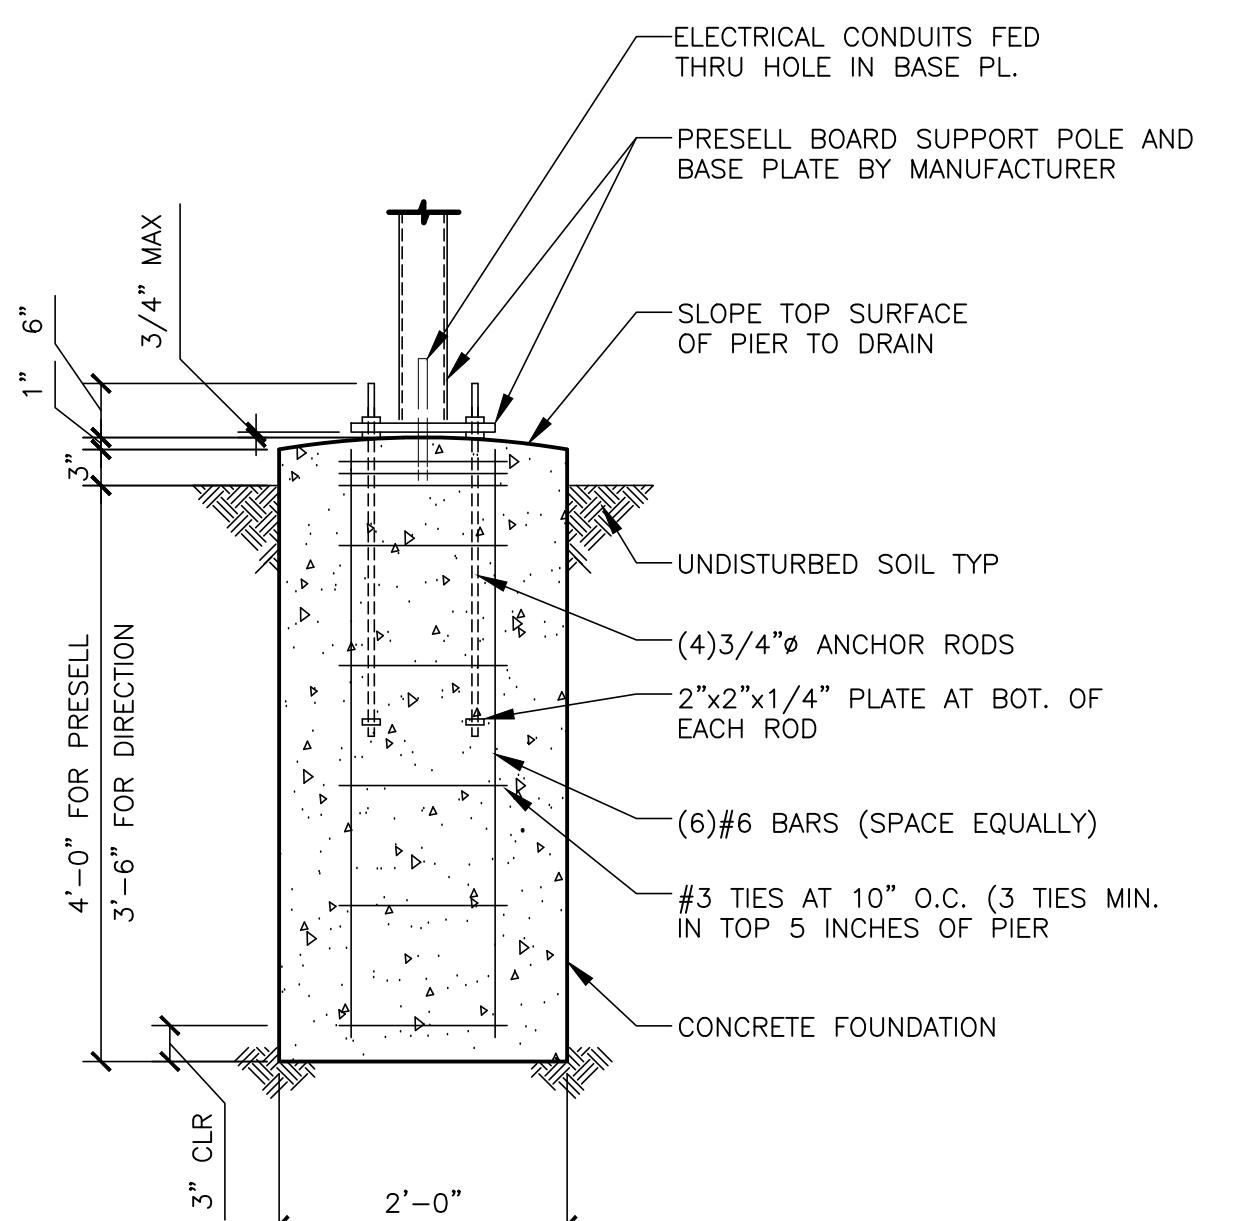

PIER SECTION DETAIL

1 FOUNDATION FOR PRESELL & DIRECTION BOARD


S3.3 $\frac{3}{4}$ " = 1'-0"

- SEE SHEET S4.0 FOR FOUNDATION, CONCRETE AND STRUCTURAL STEEL GENERAL NOTES.
- DESIGN LOADS DERIVED FROM CODES AND FORCES
- Axial - 120# (PRESELL) 180# (DIRECTION)
- Shear - 267# (PRESELL) 270# (DIRECTION)
- Moment - 1,219# (PRESELL) 1,010# (DIRECTION)
- ALL FOOTING EXCAVATIONS ARE TO BE CLEAR OF WATER AND FOREIGN MATTER BEFORE PLACING CONCRETE
- TOP 6" OF SOIL NEGLECTED IN EMBEDMENT DEPTH CALCULATIONS (EMBEDMENT DEPTHS SHOWN ARE FROM GRADE)
- ELECTRICAL CONTRACTOR TO PROVIDE INFORMATION ON CONDUIT AND ELECTRICAL REQUIREMENTS.
- ALL FOOTINGS SHALL BEAR ON FIRM UNDISTURBED RESIDUAL SOIL AND/OR ENGINEERED EARTH FILL COMPACTED TO 98% OF ITS MAXIMUM DRY DENSITY AS PER ASTM D 698-70 (STANDARD PROCTOR) UNLESS NOTED OTHERWISE.
- TOP OF PIERS SHALL BE SLOPED SUCH THAT MOISTURE CANNOT ACCUMULATE.
- DO NOT PLACE POLES ON CONCRETE UNTIL CONCRETE HAS CURED PER MCDONALDS CAST-IN-PLACE CONCRETE SPECIFICATION, SECTION 3.11-E. PERFORMED IN ACCORDANCE WITH AWS D1.1.
- REFER TO SIGN MANUFACTURER DRAWINGS AND INSTRUCTIONS FOR ADDITIONAL INFORMATION.
- ANCHOR RODS, NUTS, AND WASHERS SHALL BE SHIPPED AS AN ASSEMBLY FROM THE SIGN/LIGHTING MANUFACTURER
- DO NOT CUT ANCHOR BOLTS AFTER INSTALLATION OF POLE
- ITS FOUNDATION IS TO BE USED ONLY WITH FLORIDA PLASTICS INTERNATIONAL INC. STANDARD OPO-1 PRESSELL BOARD


2 FOUNDATION FOR MENU BOARD

S3.3 $\frac{3}{4}$ " = 1'-0"


- SEE SHEET S4.0 FOR FOUNDATION, CONCRETE AND STRUCTURAL STEEL GENERAL NOTES
- DESIGN LOADS DERIVED FROM CODES AND FORCES
- Axial - 850#
- Shear - 1310#
- Moment - 7,294#'
- ALL FOOTING EXCAVATIONS ARE TO BE CLEAR OF WATER AND FOREIGN MATTER BEFORE PLACING CONCRETE
- TOP 6" OF SOIL NEGLECTED IN EMBEDMENT DEPTH CALCULATIONS (EMBEDMENT DEPTHS SHOWN ARE FROM GRADE)
- ELECTRICAL CONTRACTOR TO PROVIDE INFORMATION ON CONDUIT AND ELECTRICAL REQUIREMENTS.
- ALL FOOTINGS SHALL BEAR ON FIRM UNDISTURBED RESIDUAL SOIL AND/OR ENGINEERED EARTH FILL COMPACTED TO 98% OF ITS MAXIMUM DRY DENSITY AS PER ASTM D 698-70 (STANDARD PROCTOR) UNLESS NOTED OTHERWISE.
- TOP OF PIERS SHALL BE SLOPED SUCH THAT MOISTURE CANNOT ACCUMULATE.
- DO NOT PLACE POLES ON CONCRETE UNTIL CONCRETE HAS CURED PER MCDONALDS CAST-IN-PLACE CONCRETE SPECIFICATION, SECTION 3.11-E. PERFORMED IN ACCORDANCE WITH AWS D1.1.
- REFER TO SIGN MANUFACTURER DRAWINGS AND INSTRUCTIONS FOR ADDITIONAL INFORMATION.
- ANCHOR RODS, NUTS, AND WASHERS SHALL BE SHIPPED AS AN ASSEMBLY FROM THE SIGN/LIGHTING MANUFACTURER
- DO NOT CUT ANCHOR BOLTS AFTER INSTALLATION OF POLE
- DETAILS AND STRUCTURAL MEMBERS NOT SHOWN DESIGNED BY OTHERS

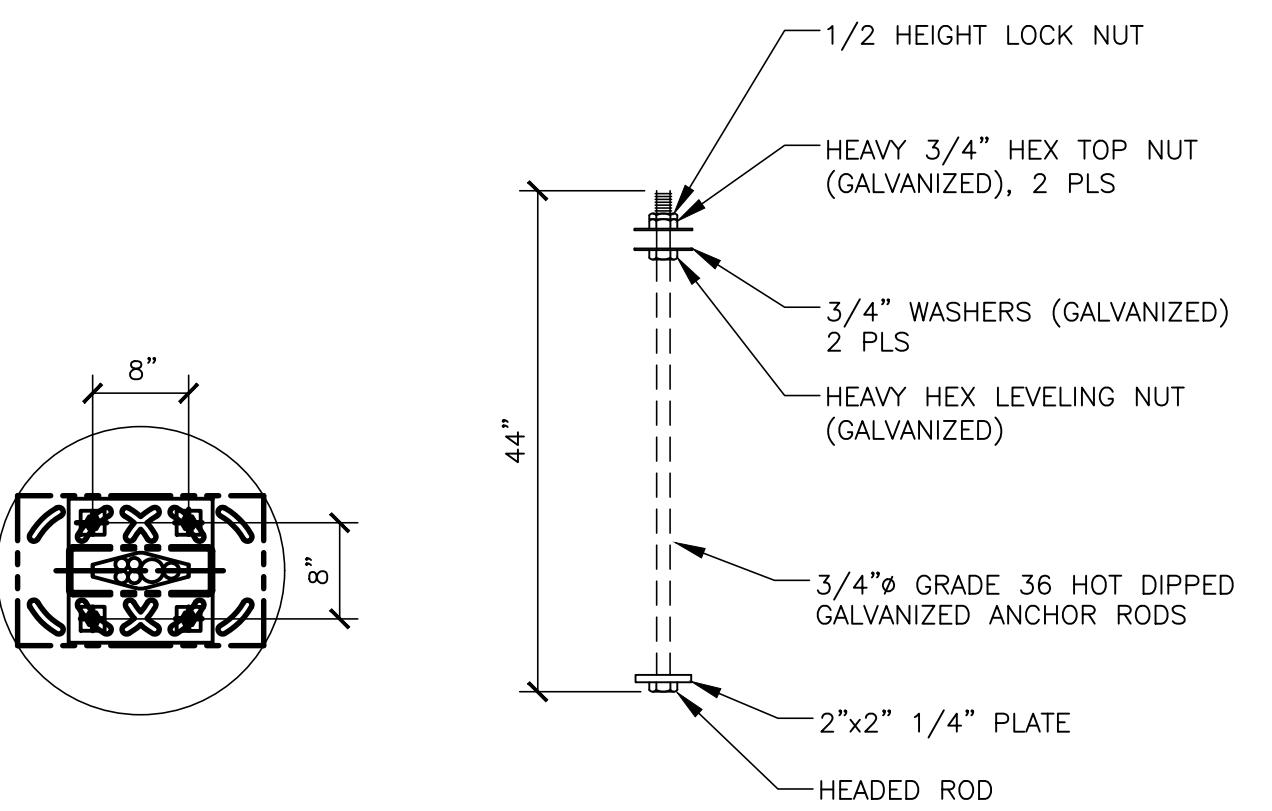

ANCHOR BOLT PATTERN

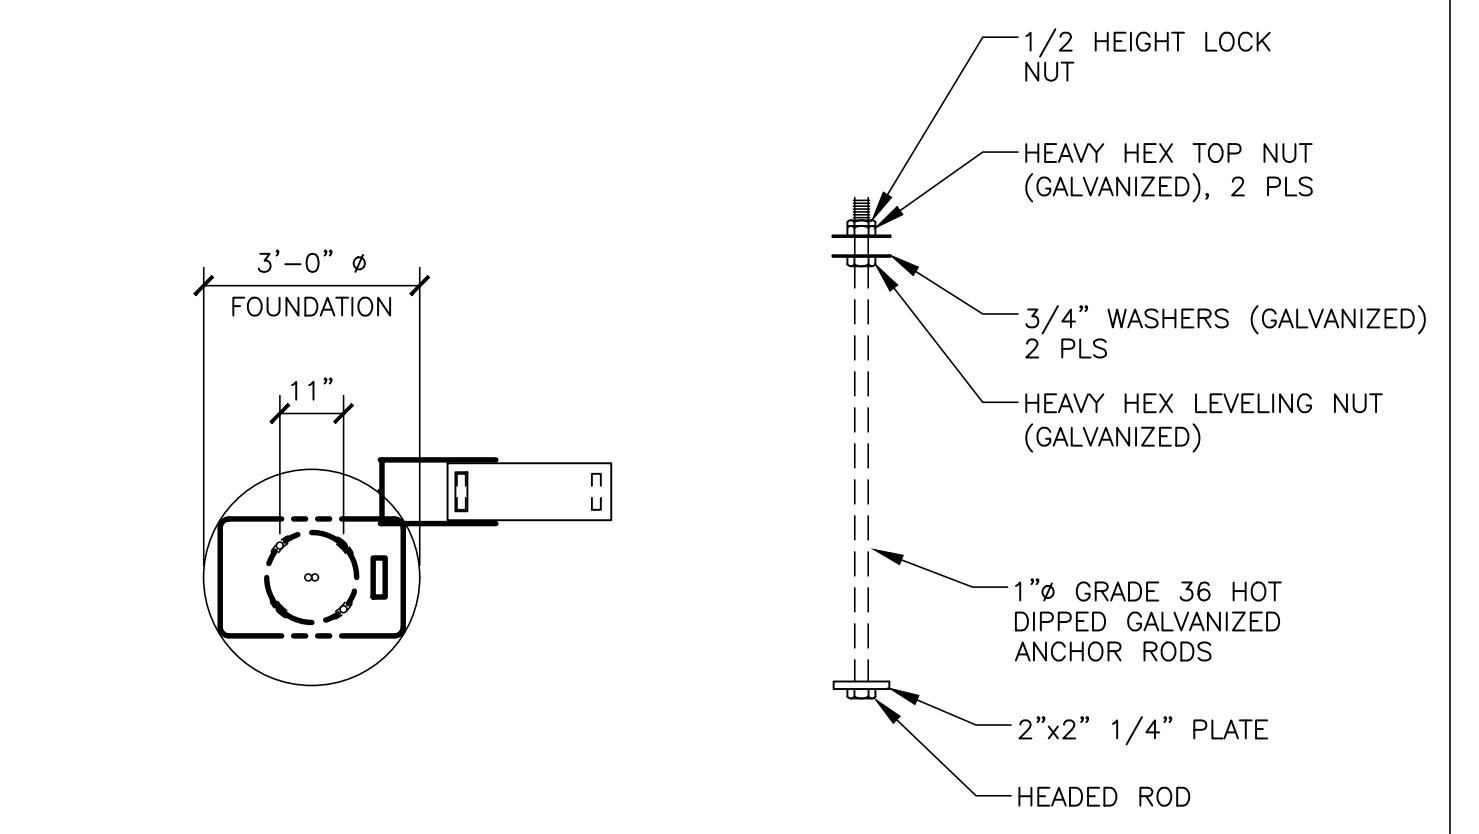

ANCHOR BOLT PATTERN

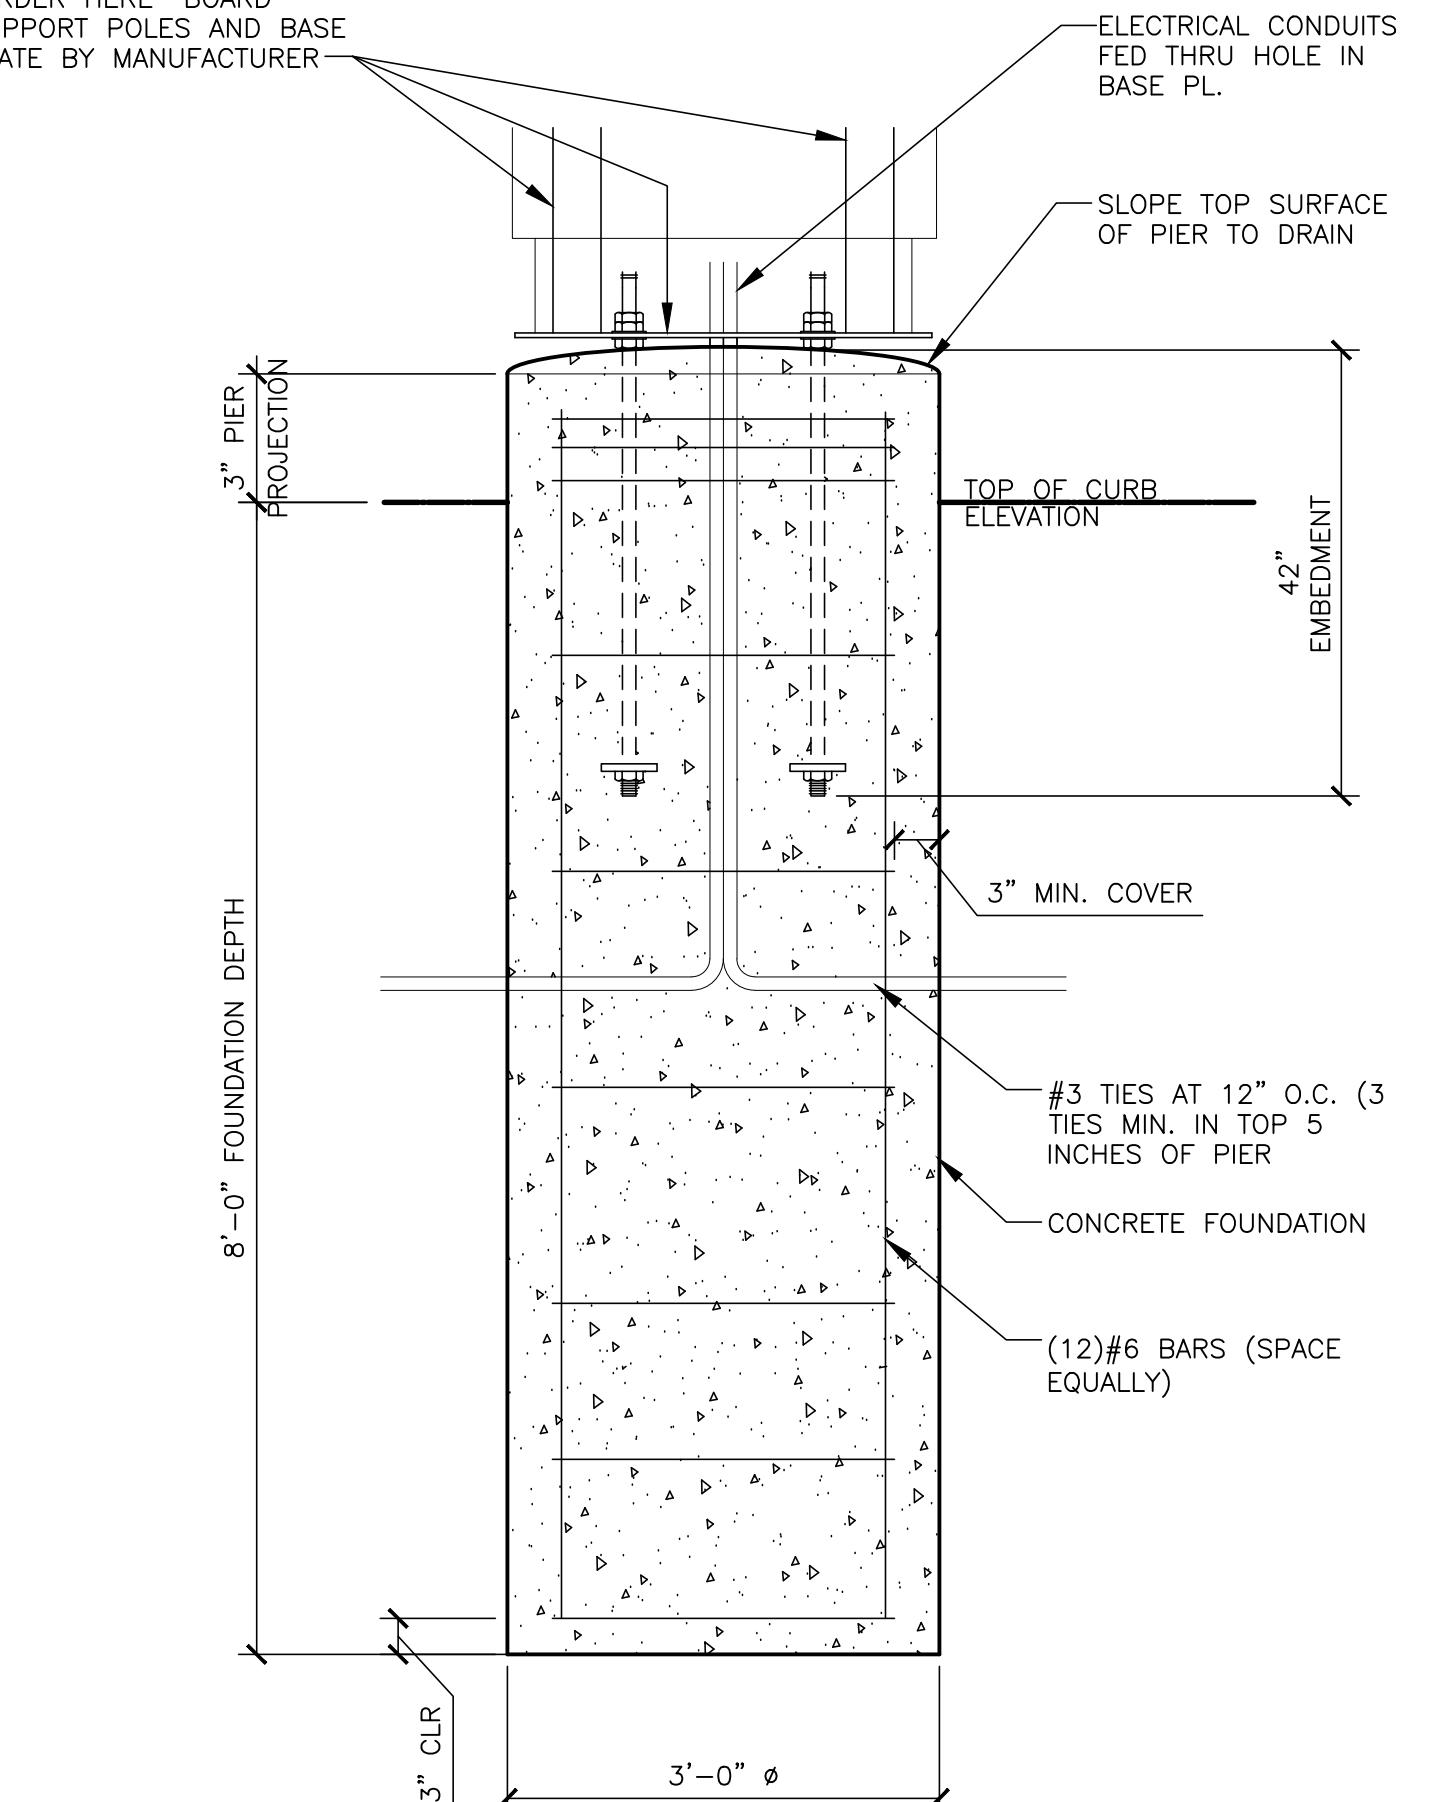

PIER SECTION DETAIL

3 FOUNDATION FOR "ORDER HERE" BOARD

S3.3 $\frac{3}{4}$ " = 1'-0"


- SEE SHEET S4.0 FOR FOUNDATION, CONCRETE AND STRUCTURAL STEEL GENERAL NOTES
- DESIGN LOADS DERIVED FROM CODES AND FORCES
- Axial - 2600#
- Shear - 2904#
- Moment - 14,500#'
- ALL FOOTING EXCAVATIONS ARE TO BE CLEAR OF WATER AND FOREIGN MATTER BEFORE PLACING CONCRETE
- TOP 6" OF SOIL NEGLECTED IN EMBEDMENT DEPTH CALCULATIONS (EMBEDMENT DEPTHS SHOWN ARE FROM GRADE)
- ELECTRICAL CONTRACTOR TO PROVIDE INFORMATION ON CONDUIT AND ELECTRICAL REQUIREMENTS.
- ALL FOOTINGS SHALL BEAR ON FIRM UNDISTURBED RESIDUAL SOIL AND/OR ENGINEERED EARTH FILL COMPACTED TO 98% OF ITS MAXIMUM DRY DENSITY AS PER ASTM D 698-70 (STANDARD PROCTOR) UNLESS NOTED OTHERWISE.
- TOP OF PIERS SHALL BE SLOPED SUCH THAT MOISTURE CANNOT ACCUMULATE.
- DO NOT PLACE POLES ON CONCRETE UNTIL CONCRETE HAS CURED PER MCDONALDS CAST-IN-PLACE CONCRETE SPECIFICATION, SECTION 3.11-E. PERFORMED IN ACCORDANCE WITH AWS D1.1.
- REFER TO SIGN MANUFACTURER DRAWINGS AND INSTRUCTIONS FOR ADDITIONAL INFORMATION.
- ANCHOR RODS, NUTS, AND WASHERS SHALL BE SHIPPED AS AN ASSEMBLY FROM THE SIGN/LIGHTING MANUFACTURER
- DO NOT CUT ANCHOR BOLTS AFTER INSTALLATION OF POLE
- DETAILS AND STRUCTURAL MEMBERS NOT SHOWN DESIGNED BY OTHERS

4 FOUNDATION FOR CLEARANCE GATEWAY

S3.3 $\frac{3}{4}$ " = 1'-0"

- SEE SHEET S4.0 FOR FOUNDATION, CONCRETE AND STRUCTURAL STEEL GENERAL NOTES
- DESIGN LOADS DERIVED FROM CODES AND FORCES
- Axial - 790#
- Shear - 600#
- Moment - 5,335#'
- ALL FOOTING EXCAVATIONS ARE TO BE CLEAR OF WATER AND FOREIGN MATTER BEFORE PLACING CONCRETE
- TOP 6" OF SOIL NEGLECTED IN EMBEDMENT DEPTH CALCULATIONS (EMBEDMENT DEPTHS SHOWN ARE FROM GRADE)
- ELECTRICAL CONTRACTOR TO PROVIDE INFORMATION ON CONDUIT AND ELECTRICAL REQUIREMENTS.
- ALL FOOTINGS SHALL BEAR ON FIRM UNDISTURBED RESIDUAL SOIL AND/OR ENGINEERED EARTH FILL COMPACTED TO 98% OF ITS MAXIMUM DRY DENSITY AS PER ASTM D 698-70 (STANDARD PROCTOR) UNLESS NOTED OTHERWISE.
- TOP OF PIERS SHALL BE SLOPED SUCH THAT MOISTURE CANNOT ACCUMULATE.
- DO NOT PLACE POLES ON CONCRETE UNTIL CONCRETE HAS CURED PER MCDONALDS CAST-IN-PLACE CONCRETE SPECIFICATION, SECTION 3.11-E. PERFORMED IN ACCORDANCE WITH AWS D1.1.
- REFER TO SIGN MANUFACTURER DRAWINGS AND INSTRUCTIONS FOR ADDITIONAL INFORMATION.
- ANCHOR RODS, NUTS, AND WASHERS SHALL BE SHIPPED AS AN ASSEMBLY FROM THE SIGN/LIGHTING MANUFACTURER
- DO NOT CUT ANCHOR BOLTS AFTER INSTALLATION OF POLE
- DETAILS AND STRUCTURAL MEMBERS NOT SHOWN DESIGNED BY OTHERS

rubix
Rubix Consultants, LLC
403 N. Dearborn Street, Suite 1000
Chicago, IL 60603
(312) 602-5411

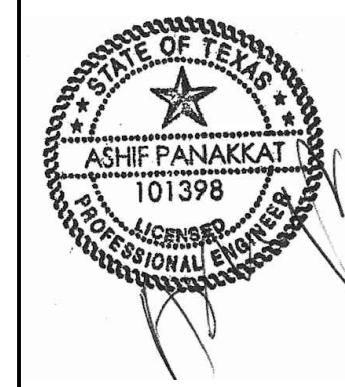

Signed/Sealed:
03/06/2024


McDonald's USA, LLC



SHEET NO.	TITLE	DRAWN BY	REVIEWED BY	DATE ISSUED
	2023 STANDARD BUILDING - BB20	MKP 2023	AP	
	STD ISSUE DATE			
	DESCRIPTION			
	WOOD BEARING WALLS W/4" BRICK VENEER			
	STUCCO/BATEN/BRICK/METAL PANEL EXTERIOR FINISHES			
	SITE ADDRESS			
	SEC OF S.H. LOOP 288 & HUMMINGBIRD LANE, DENTON TEXAS			
	JAWA 24-0014			
	S3.3			
	SITE ELEMENTS DETAILS			
	042-3271			


LIGHT POLE BASE NOTES

- SEE SHEET S4.0 FOR STRUCTURAL GENERAL NOTES
 - DESIGN CRITERIA:
 - AASHTO "STANDARD SPECIFICATIONS FOR STRUCTURAL SUPPORTS FOR HIGHWAY SIGNS, LUMINAIRES AND TRAFFIC SIGNALS, FIFTH EDITION, 2009"
 - FOUNDATION DESIGN PARAMETERS:
 - MAXIMUM LIGHT POLE BASE REACTIONS:
 - BASE MOMENT = 16,845 lbs-ft
 - BASE SHEAR = 978 lbs
 - 6" MAXIMUM DEPTH OF DISTURBED SOIL OR TOP SOIL
 - THIS FOUNDATION DESIGN SHALL NOT BE USED IN LOCATIONS WHICH ARE CLOSER THAN 8ft FROM A RETAINING WALL.
 - THIS FOUNDATION DESIGN SHALL NOT BE USED AT LOCATIONS WHERE THE GROUND SLOPE EXCEEDS 4 inches per foot.

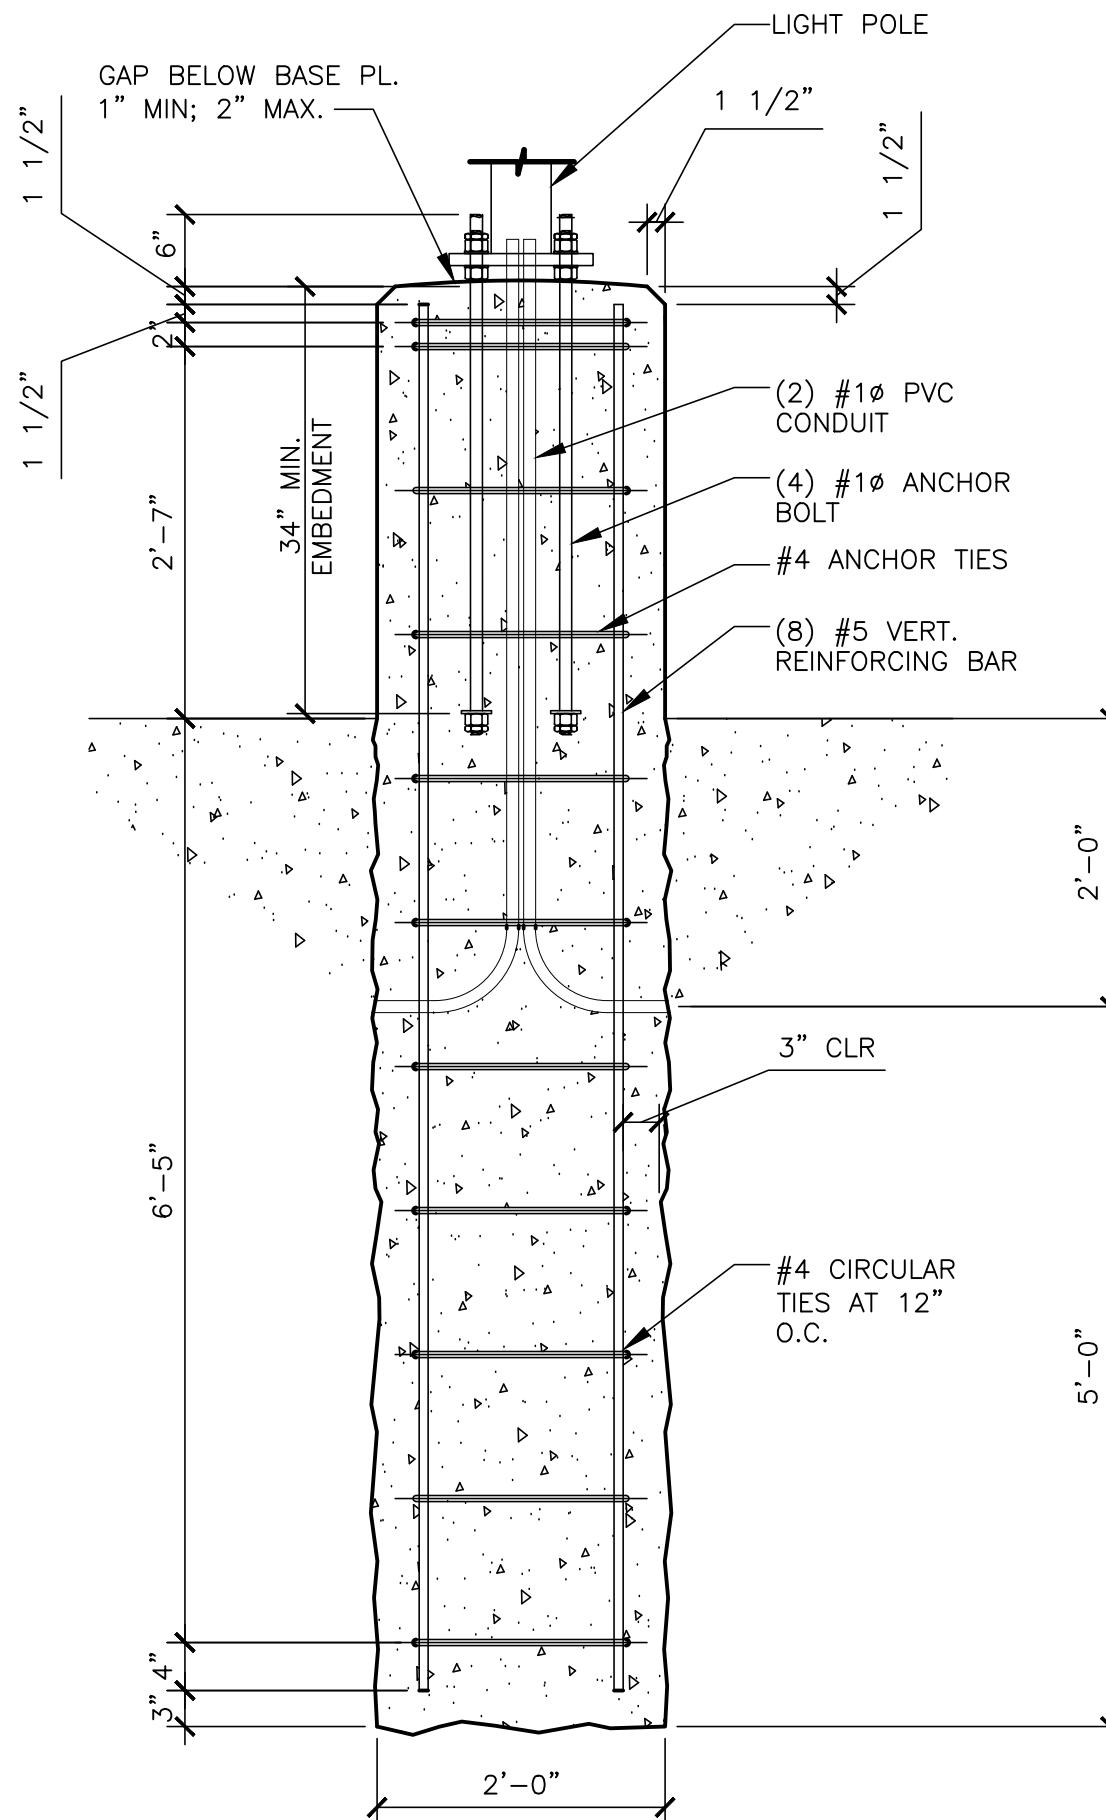


PIER SECTION DETAIL

- SEE SHEET S4.0 FOR FOUNDATION, CONCRETE AND STRUCTURAL STEEL GENERAL NOTES
 - DESIGN LOADS DERIVED FROM CODES AND FORCES
 - AXIAL - 180# (DIRECTION)
 - SHEAR - 270# (DIRECTION)
 - MOMENT - 1,010#' (DIRECTION)
 - ALL FOOTING EXCAVATIONS ARE TO BE CLEAR OF WATER AND FOREIGN MATTER BEFORE PLACING CONCRETE
 - TOP 6" OF SOIL NEGLECTED IN EMBEDMENT DEPTH CALCULATIONS (EMBEDMENT DEPTHS SHOWN ARE FROM GRADE)
 - ELECTRICAL CONTRACTOR TO PROVIDE INFORMATION ON CONDUIT AND ELECTRICAL REQUIREMENTS.
 - ALL FOOTINGS SHALL BEAR ON FIRM UNDISTURBED RESIDUAL SOIL AND/OR ENGINEERED EARTH FILL COMPAKTED TO 98% OF ITS MAXIMUM DRY DENSITY AS PER ASTM D 698-70 (STANDARD PROCTOR) UNLESS NOTED OTHERWISE.
 - TOP OF PIERS SHALL BE SLOPED SUCH THAT MOISTURE CANNOT ACCUMULATE.
 - DO NOT PLACE POLES ON CONCRETE UNTIL CONCRETE HAS CURED PER MCDONALDS CAST-IN-PLACE CONCRETE SPECIFICATION, SECTION 3.11-E. ERFORMED IN ACCORDANCE WITH AWS D1.1.
 - REFER TO SIGN MANUFACTURER DRAWINGS AND INSTRUCTIONS FOR ADDITIONAL INFORMATION.
 - ANCHOR RODS, NUTS, AND WASHERS SHALL BE SHIPPED AS AN ASSEMBLY FROM THE SIGN/LIGHTING MANUFACTURER
 - DO NOT CUT ANCHOR BOLTS AFTER INSTALLATION OF POLE

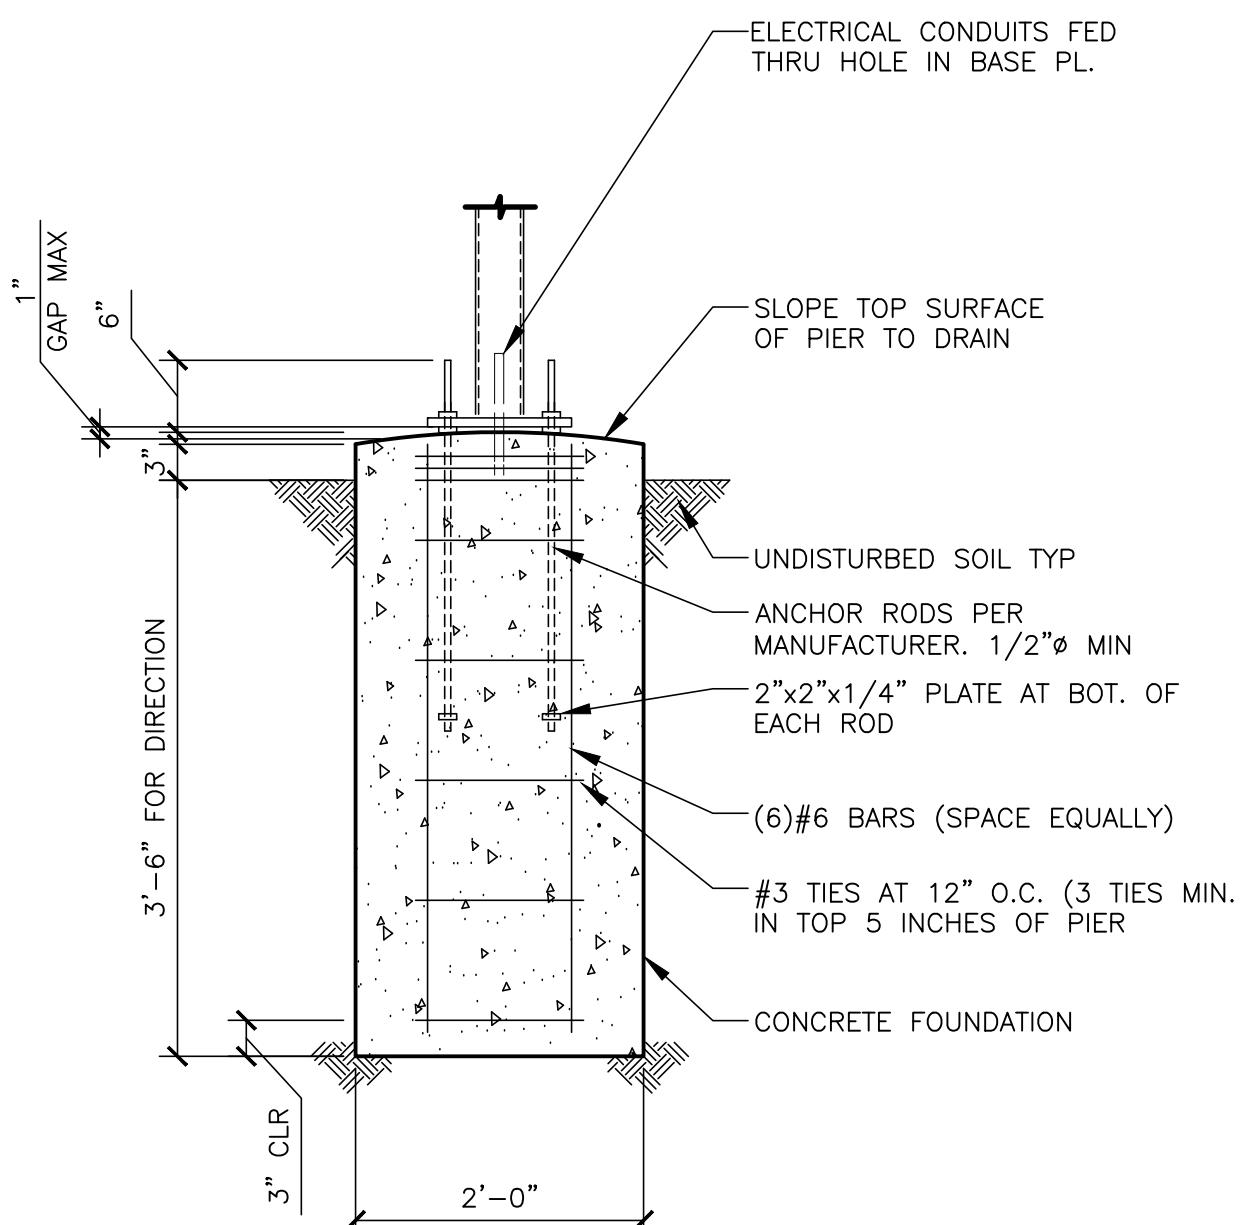

PIER SECTION DETAIL

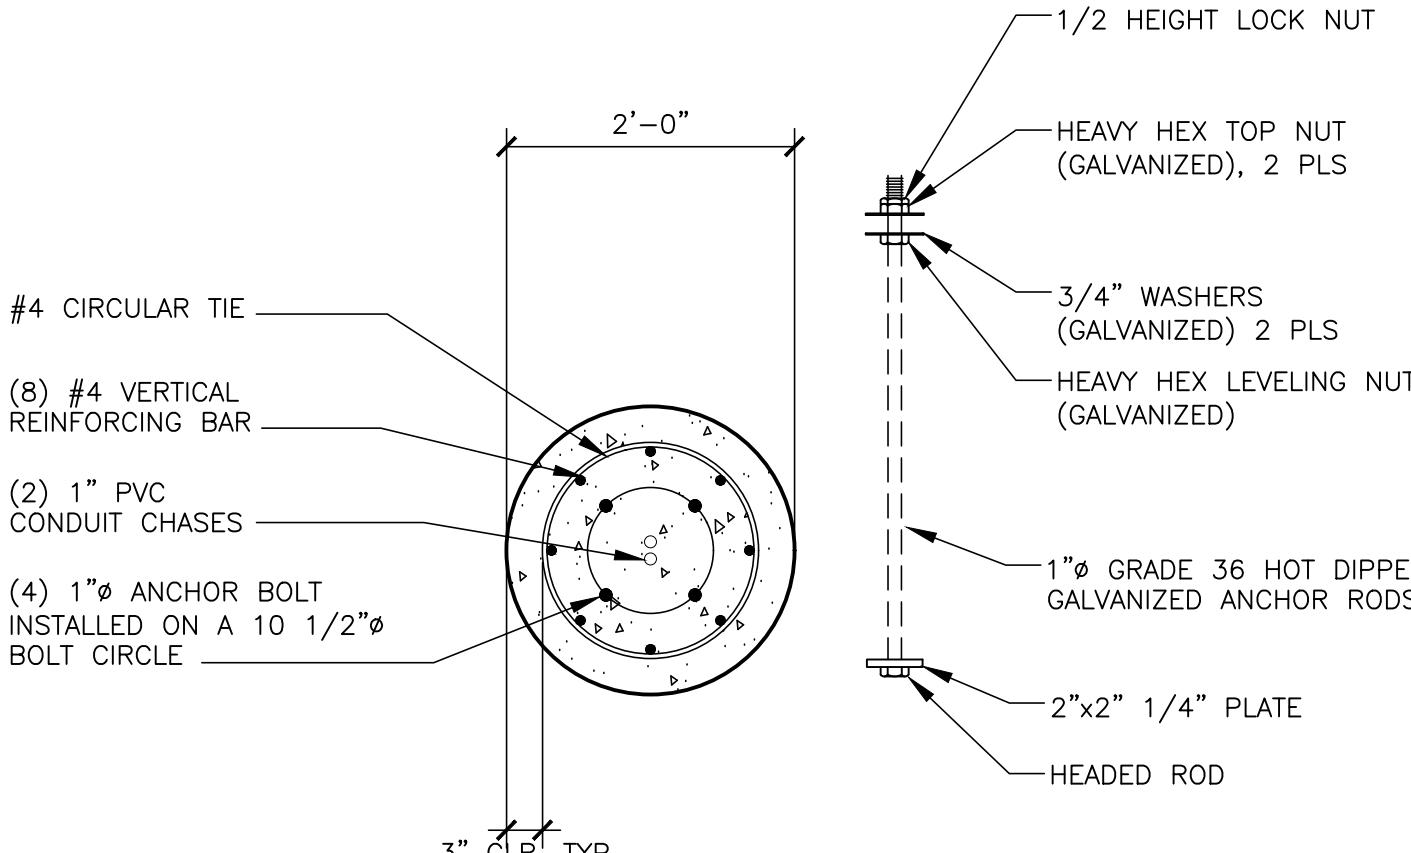


ANCHOR BOLT PATTERN


FOUNDATION FOR LIGHT POLE BASE

FLAG POLE BASE NOTES


- SEE SHEET S4.0 FOR STRUCTURAL GENERAL NOTES AND DESIGN CODES
 - DESIGN CRITERIA:
 - AASHTO "STANDARD SPECIFICATIONS FOR STRUCTURAL SUPPORTS FOR HIGHWAY SIGNS, LUMINAIRES AND TRAFFIC SIGNALS, FIFTH EDITION, 2009
 - FOUNDATION DESIGN PARAMETERS:
 - MAXIMUM LIGHT POLE BASE REACTIONS:
 - BASE MOMENT = 33,480 lbs-ft
 - BASE SHEAR = 1682 lbs
 - 6" MAXIMUM DEPTH OF DISTURBED SOIL OR TOP SOIL
 - THIS FOUNDATION DESIGN SHALL NOT BE USED IN LOCATIONS WHICH ARE CLOSER THAN 8ft FROM A RETAINING WALL.
 - THIS FOUNDATION DESIGN SHALL NOT BE USED AT LOCATIONS WHERE THE GROUND SLOPE EXCEEDS 4 inches per foot.
 - ELECTRICAL CONTRACTOR TO PROVIDE INFORMATION ON CONDUIT AND ELECTRICAL REQUIREMENTS.
 - INSTALL SAND AND POLE PER MANUFACTURERS INSTALLATION INSTRUCTIONS.
 - SEAL SAND IN FOUNDATION WITH CAULK PER MANUFACTURERS GUIDELINES.
 - FLAG SIZES SHALL NOT EXCEED THE FOLLOWING AREA LIMITATIONS:
 - 25'-0" POLE --> 5'-0" x 8'-0" FLAG
 - 30'-0" POLE --> 6'-0" x 10'-0" FLAG
 - 40'-0" POLE --> 8'-0" x 12'-0" FLAG
 - 50'-0" POLE --> 10'-0" X 15'-0" FLAG
 - REFER TO FLAG MANUFACTURER DRAWINGS AND INSTRUCTIONS FOR ADDITIONAL INFORMATION INCLUDING INSTALLATION INSTRUCTIONS.

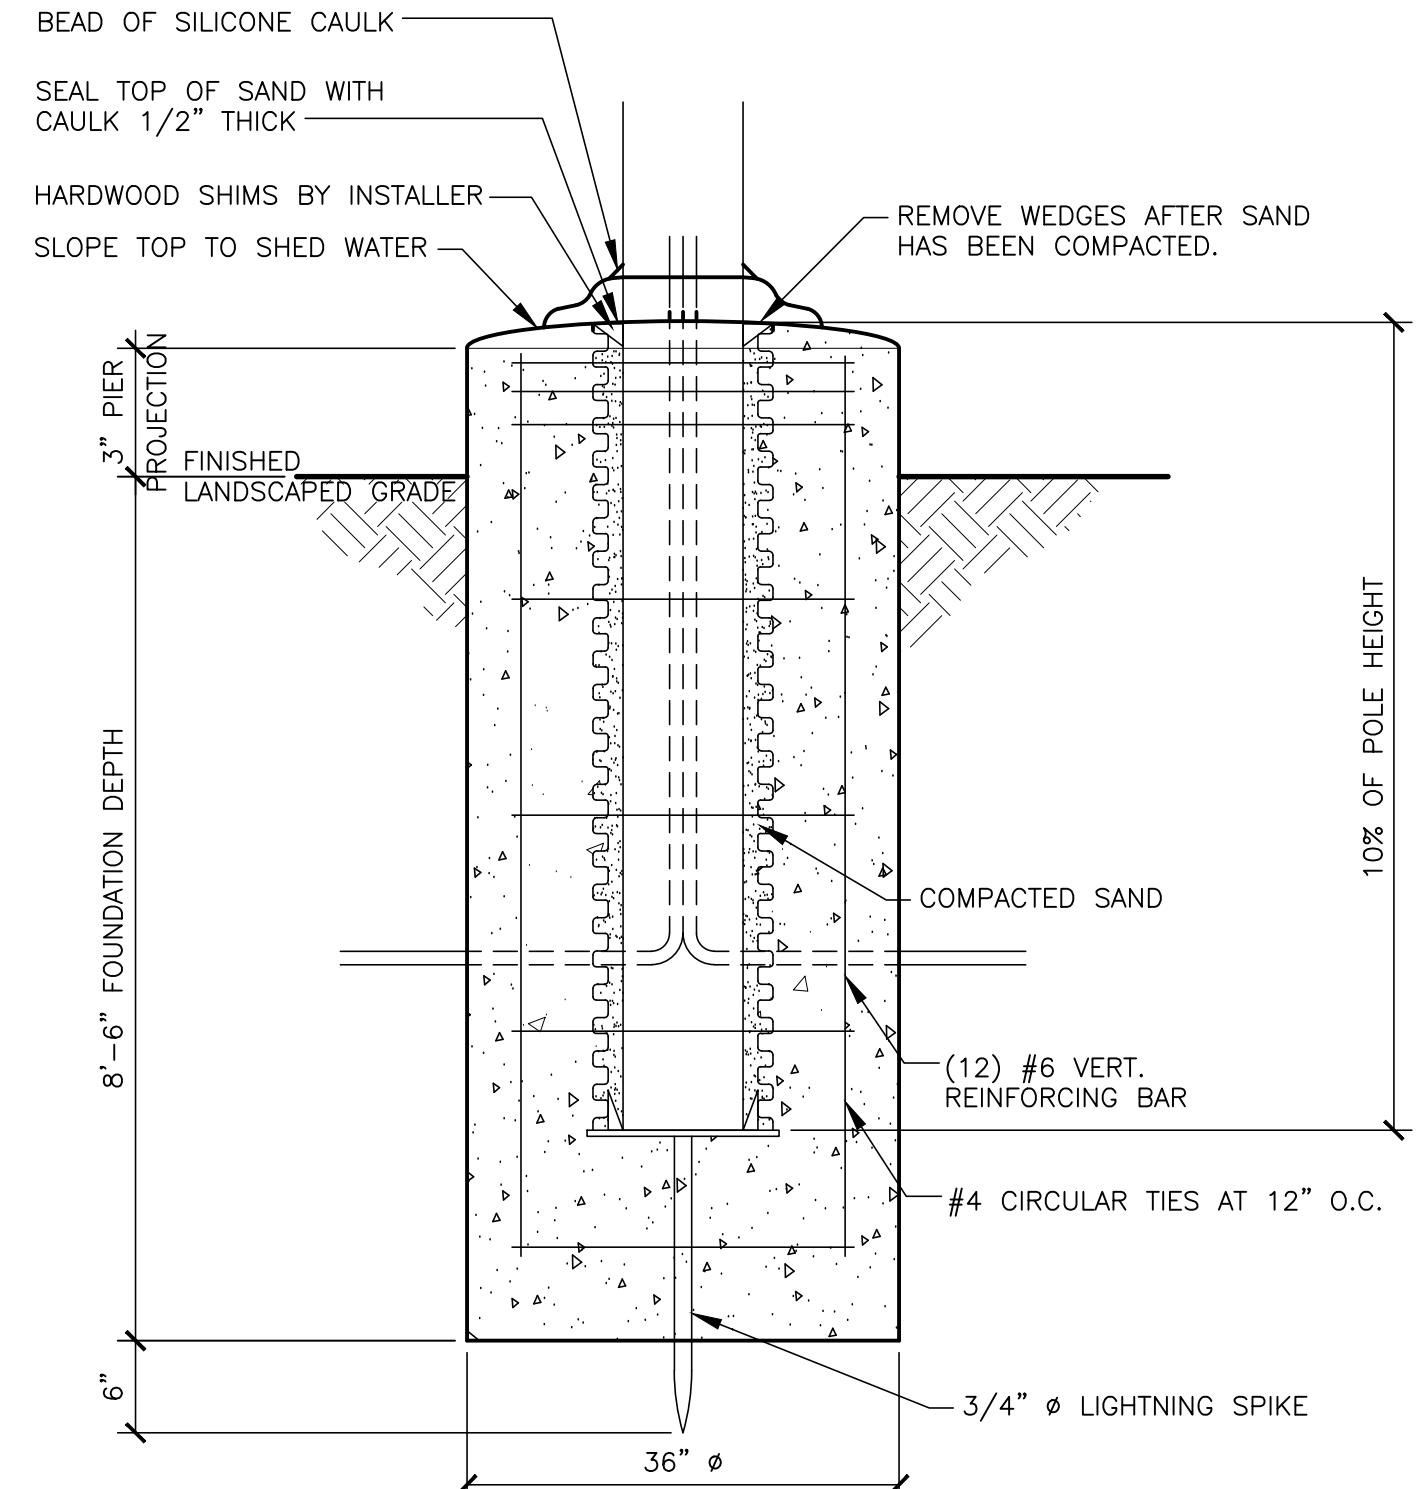

PIER SECTION DETAIL

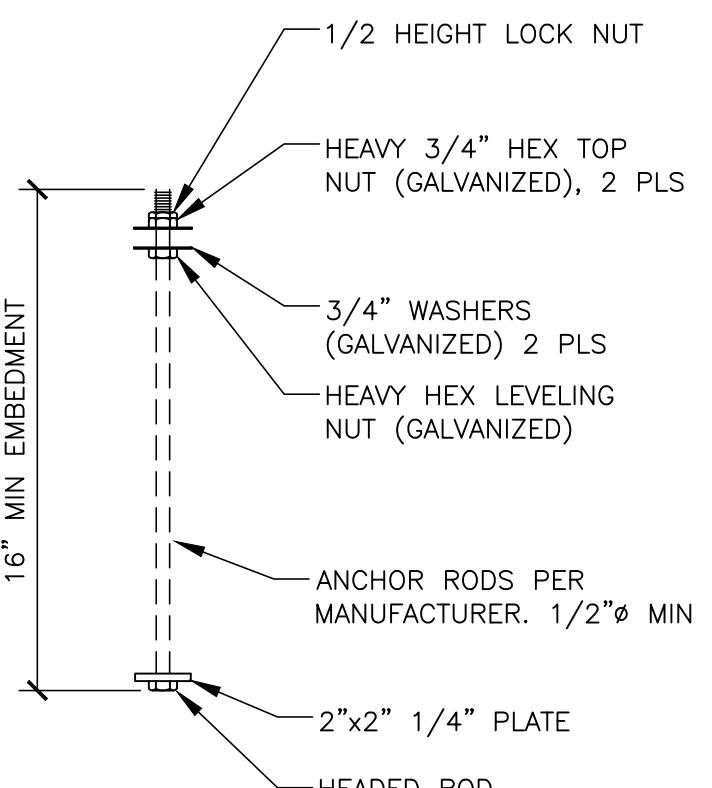

ANCHOR BOLT PATTERN

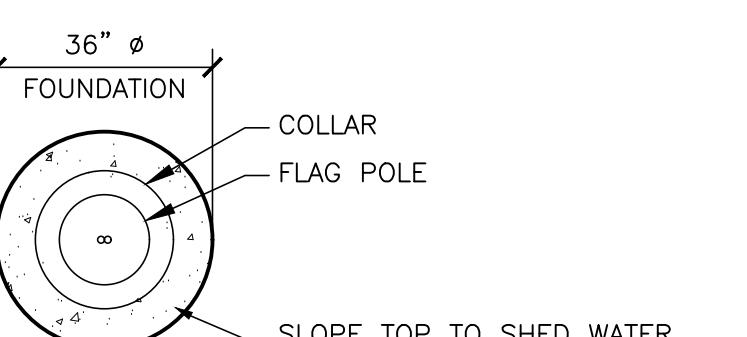

ANCHOR BOLT PATTERN



FOUNDATION FOR FLAG POLE BASE

Rubix
consultants
www.rubixc.com

Rubix Consultants, LLC
4103 N. Southport Ave,
Chicago, IL 60613
(312) 602 5411

STATE OF TEXAS
ASHIF PANAKKAT
101398
LICENSED PROFESSIONAL ENGINEER

**Signed/Sealed:
03/08/2024**


M McDonald's USA, LLC

DRAWN BY MKP	ISSUE DATE 2023	REVIEWED BY AP	DATE ISSUED 3/08/24	XAS
-----------------	--------------------	-------------------	------------------------	-----

McDonald's USA, LLC


These drawings and specifications are the confidential and proprietary property of McDonald's USA, LLC and shall not be copied or reproduced without written authorization. The contract documents were prepared for use on this specific site in conjunction with its issue date and are not suitable for use on a different site or at a later time. Use of these drawings for reference or example on another project requires the services of properly licensed architects and engineers. Reproduction of the contract documents for reuse on another project is not authorized.

SHEET NO.	S3.4	
TITLE	2023 STANDARD BUILDING – BB20 4597-WOOD/WOOD	
DRAW MI STD ISSU 20		
REVIEW A		
DATE 03/0		
DESCRIPTION	WOOD BEARING WALLS W/4" BRICK VENEER WOOD ROOF TRUSS FRAMING STUCCO/BATTEN/BRICK/METAL PANEL EXTERIOR FINISHES	
SITE ID	SITE ADDRESS 042-3271 SEC OF S.H. LOOP 288 & HUMMINGBIRD LANE, DENTON TEXAS	
JAWA 24-0014		
SITE ELEMENTS DETAILS		

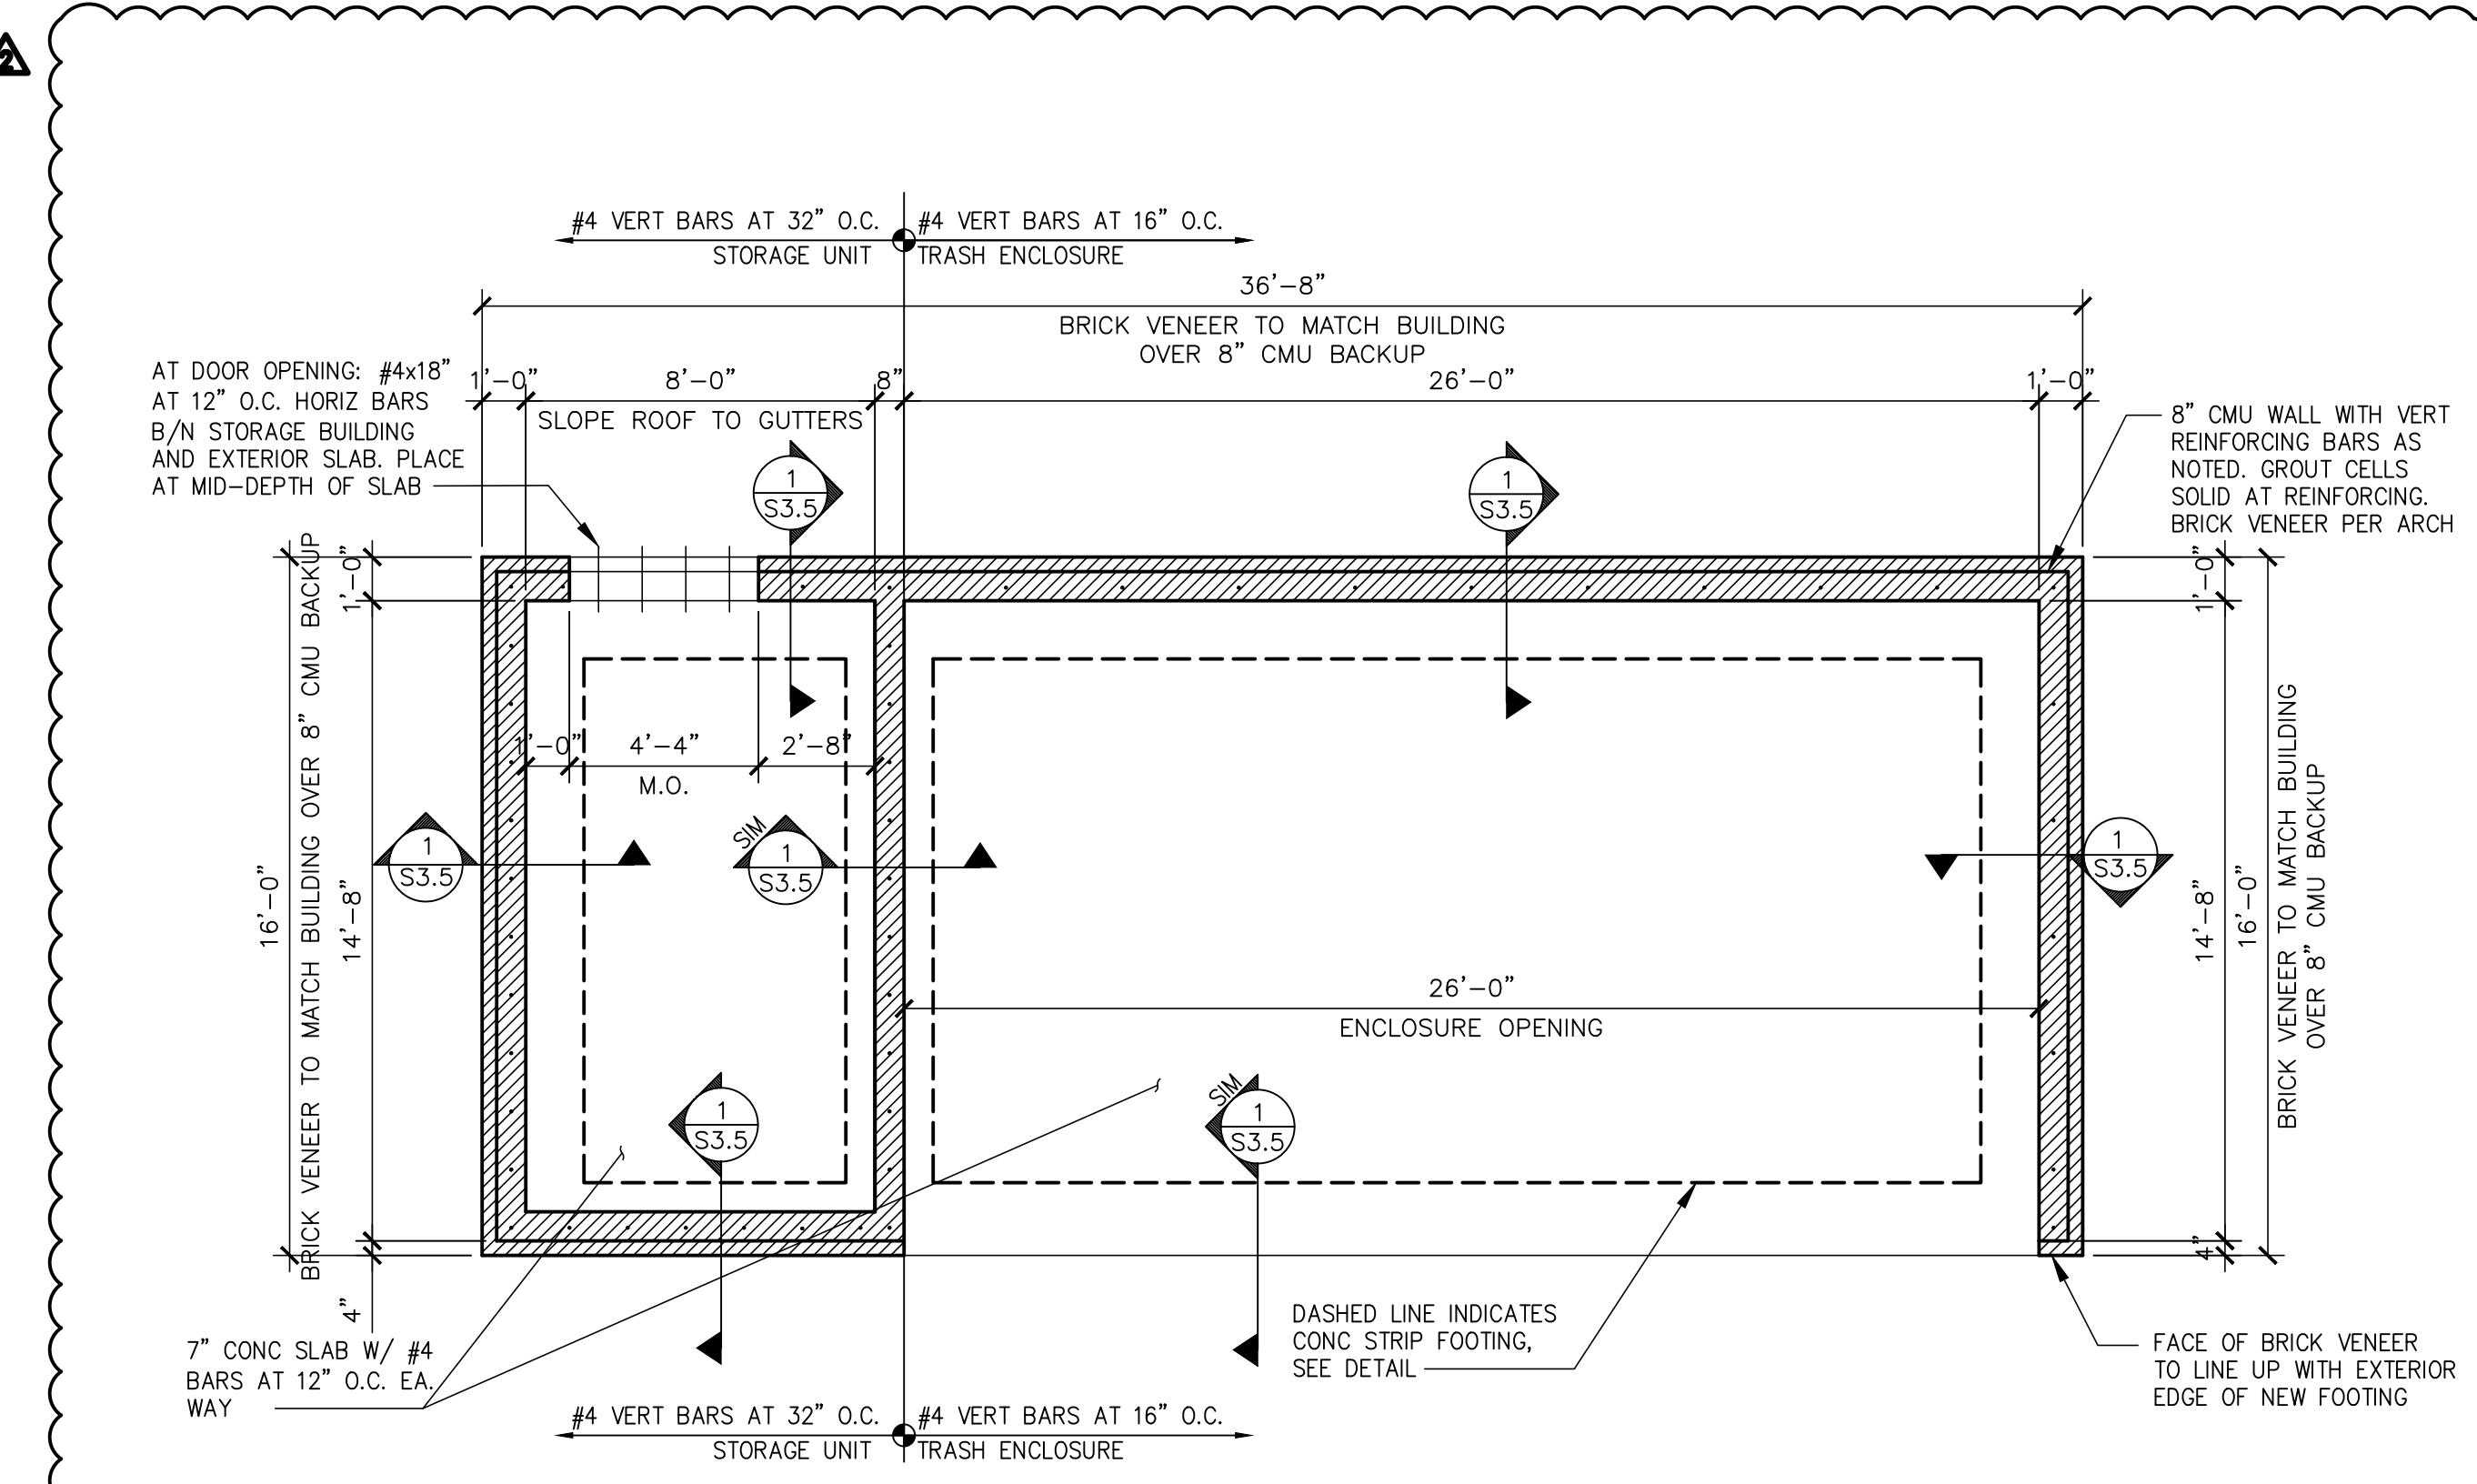


VENEER TIES W/ WIRE SIZE (W2.8 OR 3/16"Ø) SPACED 16" O.C. VERTICALLY AND 32" HORIZONTALLY.
ADDITIONAL TIES ALONG ALL OPENINGS GREATER THAN 16" ARE REQUIRED TO BE LOCATED WITHIN 12" OF
OPENING AND SPACED 36" O.C. MAX. AROUND OPENING PERIMETER. (DUR-O-WALL DA700 WITH DA 210 OR
EQUAL).


FOUNDATION PLAN @ TRASH ENCL
N.T.S.

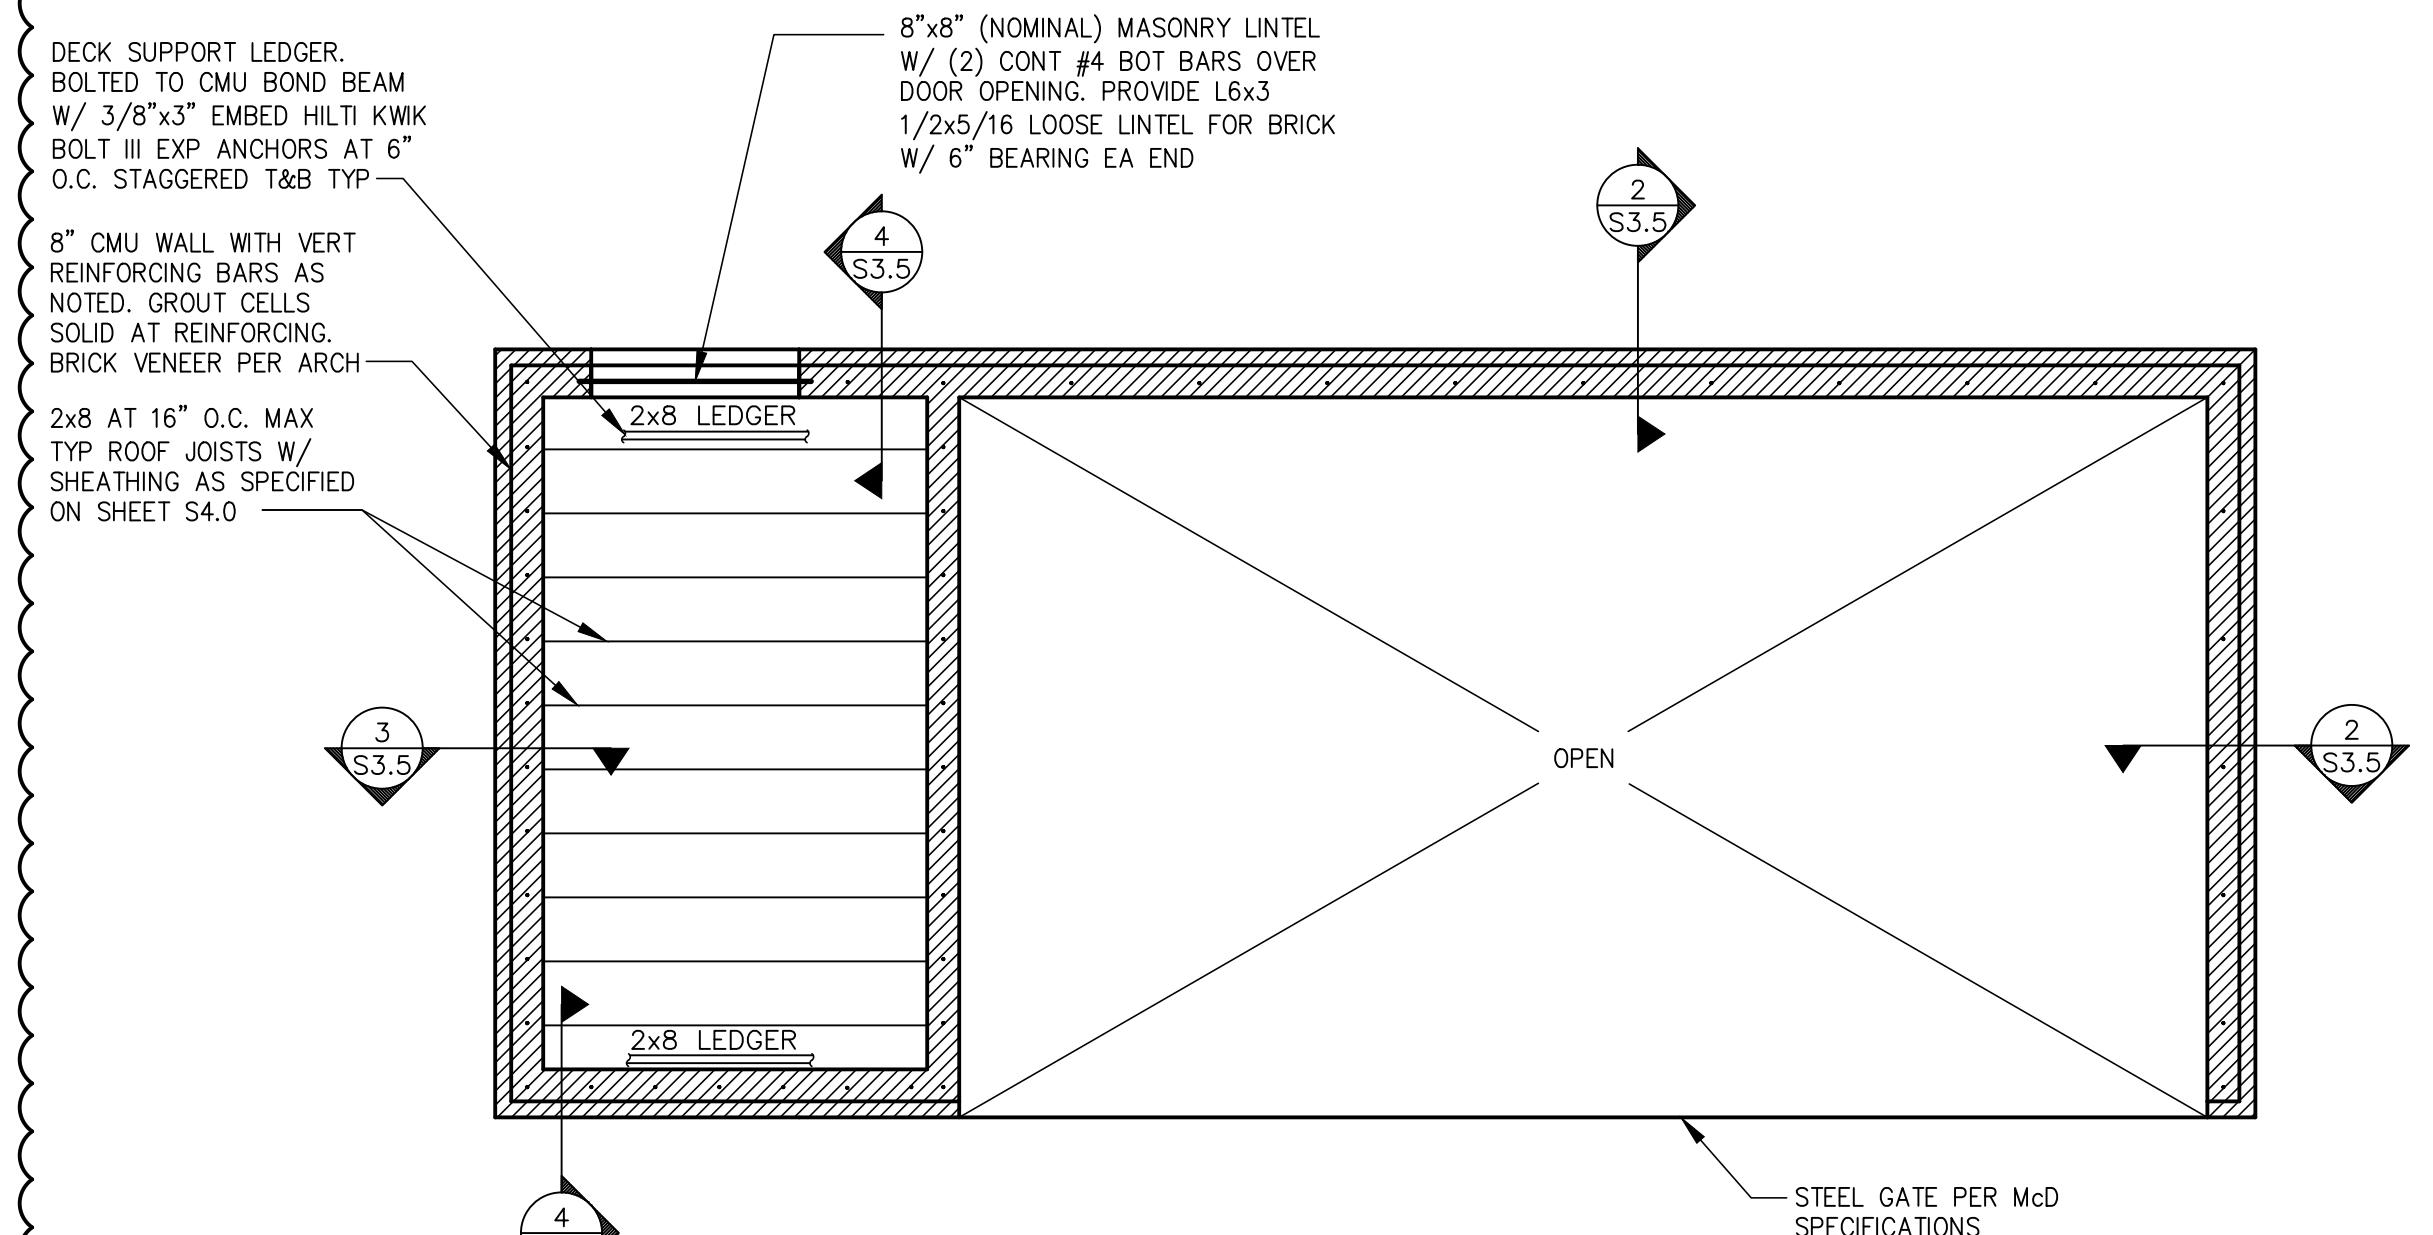


FRAMING PLAN @ TRASH ENCL
N.T.S.

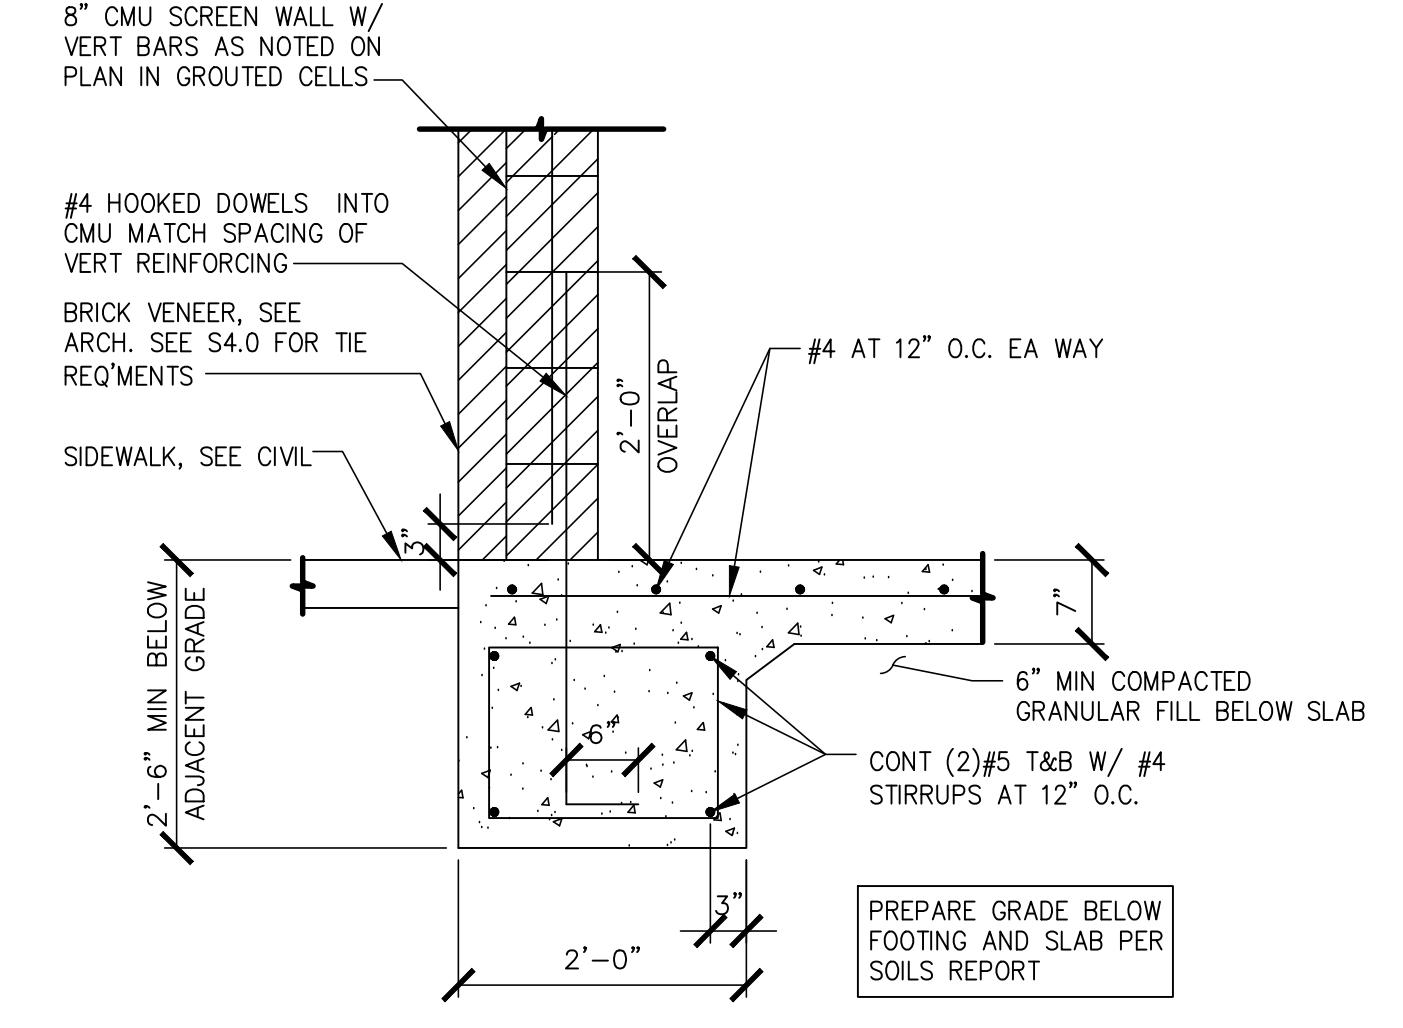


FOUNDATION DETAIL
N.T.S.

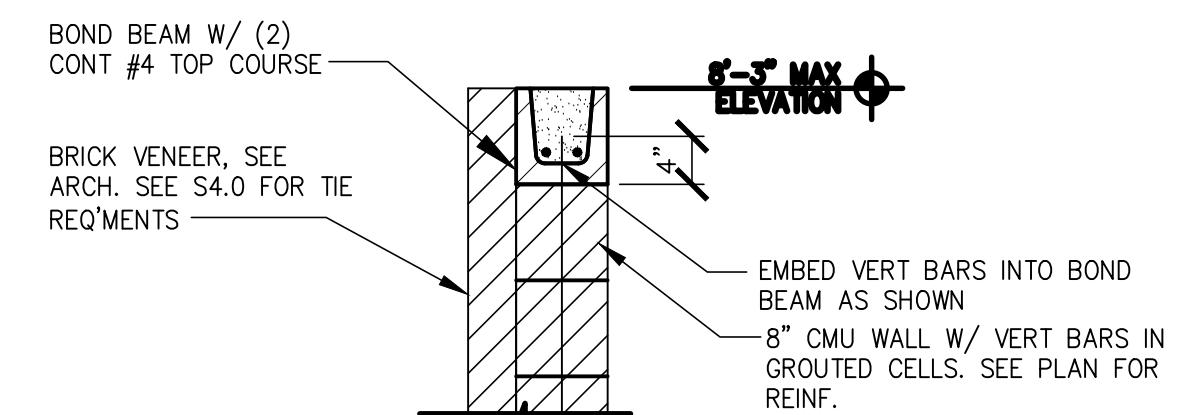

TOP OF WALL @ TRASH ENCL
N.T.S.

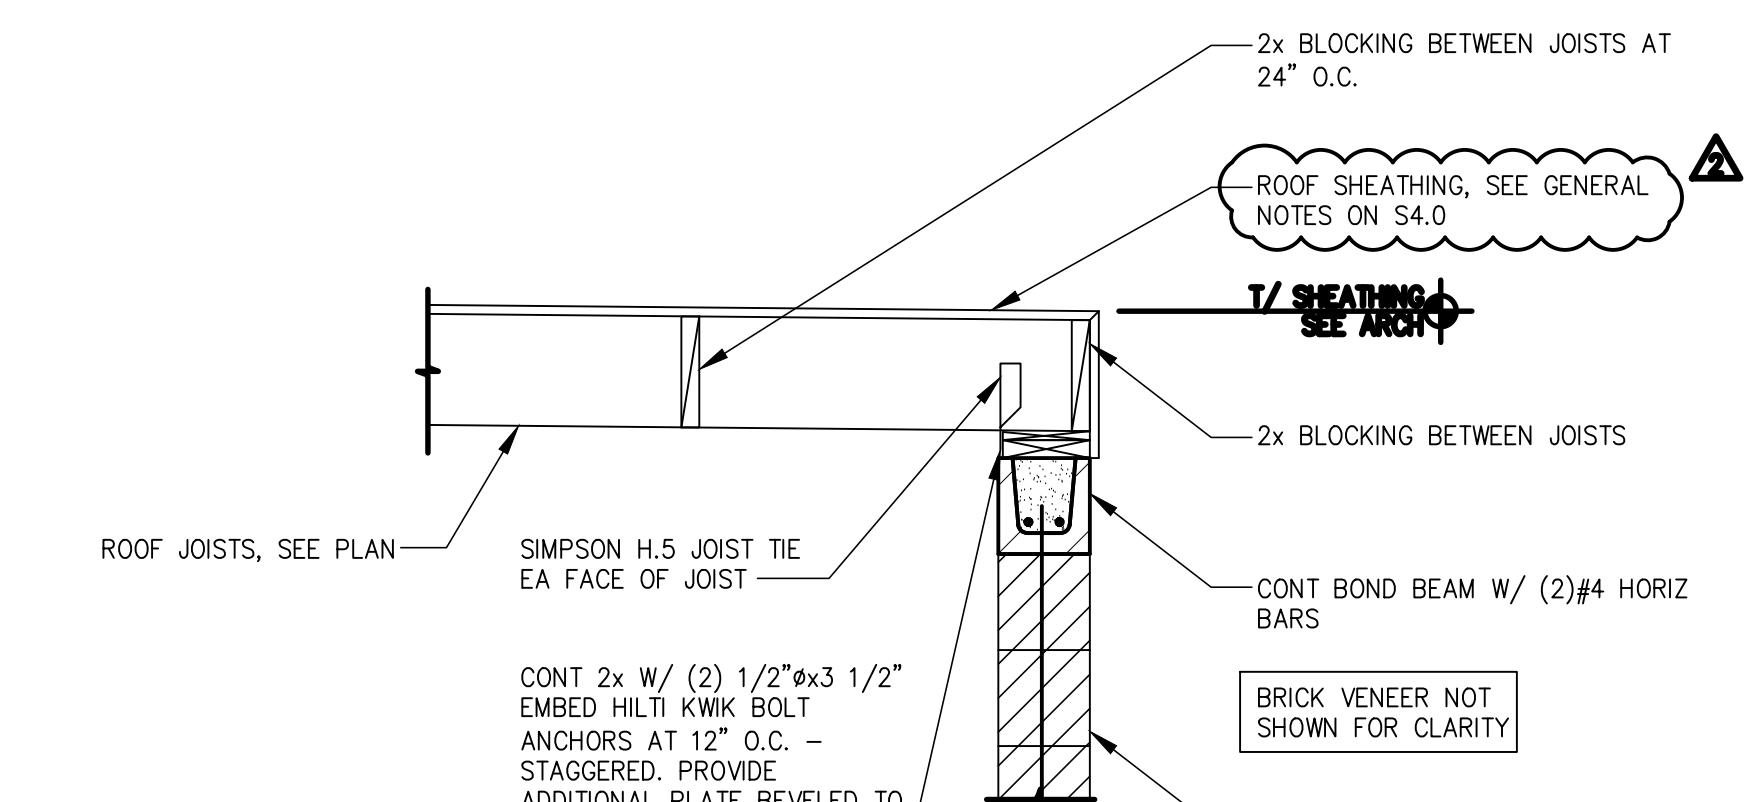

TOP OF WALL @ STORAGE BLDG
N.T.S.

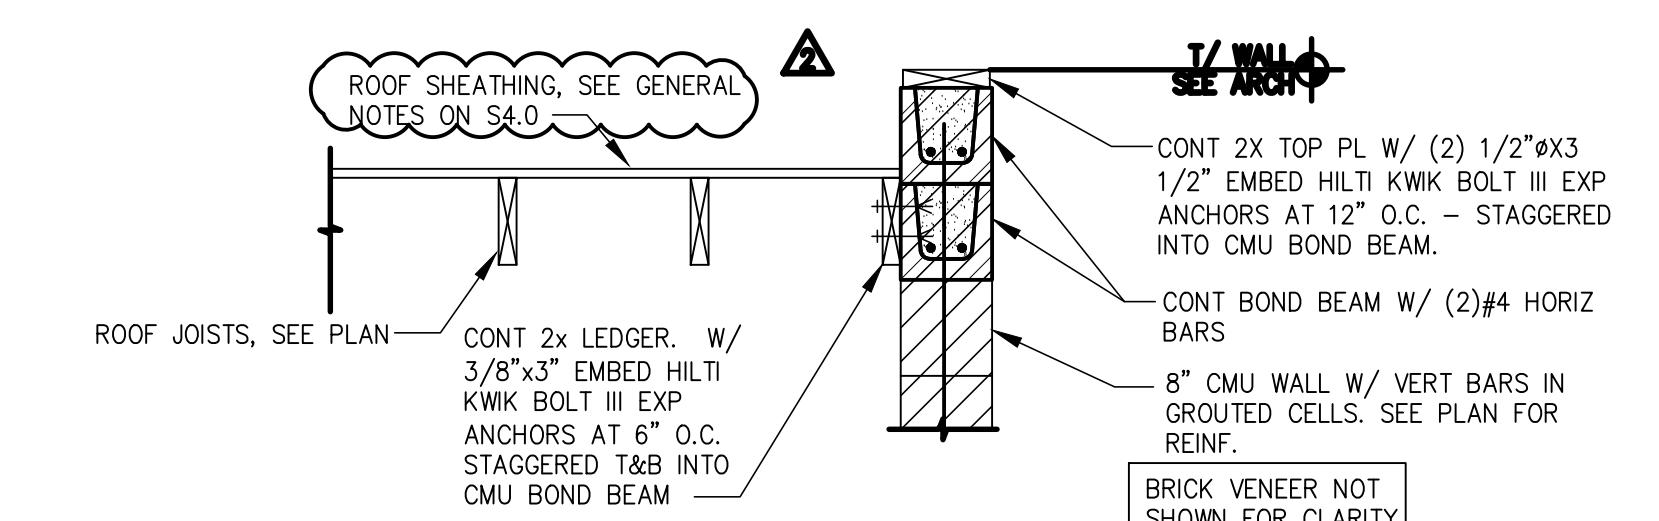

SECTION @ STORAGE BLDG
N.T.S.


McDonald's USA, LLC

These drawings and specifications are the confidential and proprietary property of McDonald's USA, LLC and may not be copied or reproduced for use on this specific site in conjunction with its issue date and are not suitable to use on a different site or on a later time. Use of these drawings, or reference or reliance on another project, requires the specific written consent of McDonald's USA, LLC. Use of these drawings on another project is not authorized.

SHEET NO.	TITLE	DRAWN BY	REVIEWED BY	APPROVED BY	DATE ISSUED	BY
1	2023 STANDARD BUILDING - BB20	MKP			05/06/25	USRD QC PLAN REVIEW COMMENTS
2	4.597-WOOD/WOOD					DUMPSTER ENCLOSURE DESIGN UPDATE

JAVA 24-0014
S3.5
TRASH ENCL DETAILS

STRUCTURAL GENERAL NOTES:		
DESIGN AND LOADING	<p>1. THE STRUCTURAL DESIGN OF THIS BUILDING WAS BASED ON THE DESIGN CRITERIA: A. BUILDING CODE: 2021 INTERNATIONAL BUILDING CODE B. FLOOR: LIVE LOAD: 115 PSF C. ROOF: LIVE LOAD: 20 PSF DEAD LOAD: 20 PSF D. SNOW: GROUND LOAD: 5 PSF FLAT ROOF LOAD: 5 PSF SNOW EXPOSURE FACTOR, CE: 1.0 IMPORTANCE FACTOR, I: 1.0 THERMAL COEFFICIENT, CT: 1.0 E. WIND: BASIC WIND SPEED: 105 MPH (3 SEC GUST) IMPORTANCE FACTOR: 1.00 BUILDING OCCUPANCY CATEGORY: II WIND EXPOSURE: C PRESSURES PER ASCE 7 F. SEISMIC: OCCUPANCY CATEGORY: II IMPORTANCE FACTOR: 1.00 SITE CLASS: C SS = 0.121, SD1 = 0.057 SDS = 0.105, SD1 = 0.057 DESIGN CATEGORY: A PLYWOOD SHEAR WALLS (R = 6.5) STEEL ORDINARY CONCENTRICALLY BRACED FRAME (R = 3.25) ANALYSIS PROCEDURE: EQUIVALENT LATERAL FORCE PROCEDURE G. FLOOD LOAD: N/A H. SPECIAL LOADS: N/A</p> <p>1. FOUNDATION DESIGN OF THIS BUILDING WAS BASED ON THE FOLLOWING CRITERIA: A. MINIMUM ALLOWABLE SOIL BEARING CAPACITY = 11,800 PSF (AT THE BASE OF STRAIGHT-DRILLED SHAFTS BEARING ON DARK GRAY SHALE). ALLOWABLE SKIN FRICTION IN TENSION = 1,300 PSF. B. RECOMMENDED BY TERRACON CONSULTANTS, INC IN THEIR REPORT NO. 94235335 DATED OCTOBER 16, 2023. C. ALL GRADE BEAM SHALL HAVE A MINIMUM CARDBOARD VOID FORM BELOW AS NOTED ON GEOTECHNICAL REPORT. .</p> <p>2. THE CONTRACTOR SHALL NOTIFY THE ARCHITECT OR ENGINEER OF RECORD IMMEDIATELY IN THE EVENT THAT THE SOILS CONDITIONS ENCOUNTERED VARY FROM THOSE SHOWN ON THE BORING LOGS.</p> <p>3. ALL FOUNDATION EXCAVATIONS AND PIER PENETRATIONS IN GRAY LIMESTONE SHALL BE INSPECTED AND APPROVED BY A SOILS TESTING LABORATORY PRIOR TO PLACEMENT OF CONCRETE.</p> <p>CONCRETE AND REINFORCING</p> <p>1. ALL CONCRETE SHALL BE IN ACCORDANCE WITH THE "AMERICAN CONCRETE INSTITUTE BUILDING CODE" (ACI 318) AND WITH "SPECIFICATIONS FOR STRUCTURAL CONCRETE FOR BUILDINGS" (ACI 301) LATEST EDITIONS.</p> <p>2. ALL NORMAL WEIGHT CONCRETE (145 PCF) SHALL OBTAIN A MINIMUM 28 DAY COMPRESSIVE STRENGTH OF 3000 PSI (3500 PSI FOR SLABS).</p> <p>3. ALL CONCRETE SUBJECT TO EXTERIOR EXPOSURE SHALL BE AIR ENTRAINED AS RECOMMENDED BY ACI 318.</p> <p>4. TEST CYLINDERS SHALL BE MADE AND TESTED AS OUTLINED IN CHAPTER 16 OF ACI-301.</p> <p>5. REINFORCING BARS SHALL BE DEFORMED BARS OF NEW BILLET STEEL CONFORMING TO ASTM A-615, GRADE 60. WELDED WIRE FABRIC SHALL CONFORM TO ASTM A-185. ALL REINFORCING AND ACCESSORIES SHALL BE DETAILED AND PLACED IN ACCORDANCE WITH ACI STANDARD 315 AND 315R.</p> <p>6. PROVIDE ALL ACCESSORIES NECESSARY TO SUPPORT REINFORCEMENT AT POSITIONS SHOWN ON THE PLANS AND DETAILS. PLASTIC COATED ACCESSORIES SHALL BE USED IN ALL EXPOSED CONCRETE WORK.</p> <p>7. THE GENERAL CONTRACTOR SHALL CHECK WITH ARCHITECTURAL, MECHANICAL AND ELECTRICAL DRAWINGS AND THE SUB-CONTRACTORS FOR OPENINGS, SLEEVES, ANCHORS, HANGERS, INSERTS, SLAB DEPRESSIONS AND OTHER ITEMS RELATED TO THE CONCRETE WORK AND SHALL ASSUME RESPONSIBILITY FOR THEIR PROPER LOCATION.</p> <p>STRUCTURAL STEEL</p> <p>1. STRUCTURAL STEEL SHALL BE DETAILED, FABRICATED AND ERECTED IN CONFORMANCE WITH THE AISC360 "SPECIFICATION FOR STRUCTURAL STEEL". SEISMIC DESIGN OF STRUCTURAL STEEL STRUCTURES SHALL CONFORM TO AISC 341.</p> <p>2. STRUCTURAL STEEL SHALL CONFORM TO THE FOLLOWING ASTM SPECIFICATIONS: A. ANCHOR RODS F1554, GRADE 36 B. HIGH STRENGTH STRUCTURAL BOLTS A325-N U.N.O. C. STRUCTURAL SHAPES (W) A992 D. STRUCTURAL SHAPES (M, S, C, MC, PLATES) A36 E. STRUCTURAL SHAPES (HP) A572 F. STRUCTURAL TUBING (HSS) A500 GRADE B G. STRUCTURAL ANGLES A36</p> <p>3. ALL WELDING ELECTRODES SHALL BE E70-XX. ALL SHOP AND FIELD WELDING SHALL BE MADE IN ACCORDANCE WITH A.W.S. D1.1 "CODE FOR WELDING IN BUILDING CONSTRUCTION" AND SHALL BE MADE BY CERTIFIED WELDERS.</p> <p>LAMINATED VENEER LUMBER (LVL)</p> <p>1. ALL BEAMS SHALL BE MANUFACTURED WITH LAMINATED VENEER LUMBER AND WATERPROOF ADHESIVES.</p> <p>2. SIZE, MANUFACTURER & SERIES OF ALL LVL MEMBERS SHALL BE AS SHOWN ON DRAWINGS.</p> <p>3. ANY SUBSTITUTIONS MUST BE APPROVED IN WRITING BY ENGINEER OR ARCHITECT OF RECORD.</p> <p>4. PROVIDE 3" MINIMUM BEARING OR AS SPECIFIED ON PLANS. REFER TO PLANS FOR FASTENING OF MULTIPLE PIECE BEAMS.</p> <p>OPEN WEB WOOD JOISTS</p> <p>1. OPEN WEB WOOD JOISTS SHALL BE MANUFACTURED WITH MACHINE STRESS RATED TOP AND BOTTOM CHORDS. WEBS SHALL BE TUBULAR STEEL MEMBERS PER MANUFACTURERS' SPECIFICATIONS.</p> <p>2. SIZE, MANUFACTURER & SERIES OF ALL OPEN WEB JOISTS SHALL BE AS SHOWN ON DRAWINGS. ANY SUBSTITUTIONS MUST BE APPROVED IN WRITING BY ENGINEER OR ARCHITECT OF RECORD.</p> <p>3. PROVIDE 3 1/2" MINIMUM BEARING OR AS SPECIFIED ON PLANS. SHIM AS REQUIRED TO PROVIDE FULL BEARING AND LEVEL SUPPORT.</p> <p>4. DO NOT CUT TOP OR BOTTOM CHORDS.</p> <p>5. ALL HANGERS AND FRAMING CONNECTORS SHOWN ARE MANUFACTURED BY SIMPSON STRONG TIE, ANY SUBSTITUTIONS MUST BE APPROVED IN WRITING BY ENGINEER OR ARCHITECT OF RECORD.</p> <p>6. REFER TO PLANS FOR WEB STIFFENER AND CONCENTRATED LOAD REQUIREMENTS.</p> <p>7. REFER TO MANUFACTURERS' INSTALLATION GUIDE FOR JOIST BRACING DURING ERECTION. REFER TO MANUFACTURERS' INSTALLATION GUIDE FOR JOIST BRIDGING REQUIREMENTS.</p> <p>SAWN LUMBER</p> <p>1. ALL GRADES OF LUMBER INDICATED ON STRUCTURAL DRAWINGS SHALL BE RATED BY THE</p>	<p>SOUTHERN PINE INSPECTION BUREAU (SPIB), OR THE WESTERN WOOD PRODUCTS ASSOCIATION (WWPA), LUMBER GRADES SHALL BE AS FOLLOWS, WITH A MAXIMUM MOISTURE CONTENT OF 19%: A. SOUTHERN PINE NO. 1. B. DOUGLASS FIR-LARCH NO. 1. C. HEM-FIR NORTH NO. 1</p> <p>2. BOLT HEADS AND NUTS BEARING ON WOOD SHALL BE PROVIDED WITH STANDARD CUT WASHERS. ALL WOOD IN CONTACT WITH CONCRETE OR MASONRY SHALL BE PRESSURE TREATED.</p> <p>3. MINIMUM NAILED CONNECTIONS FOR WOOD FRAMING MEMBERS SHALL BE IN ACCORDANCE WITH THE LOCAL BUILDING CODE OR TABLE 2304.9.1 OF THE INTERNATIONAL BUILDING CODE IF NO OTHER CRITERIA IS GIVEN.</p> <p>4. CONNECTORS SHOWN ON THE DETAILS ARE MANUFACTURED BY SIMPSON. WRITTEN APPROVAL BY ENGINEER REQUIRED FOR SUBSTITUTIONS.</p> <p>ROOF & WALL SHEATHING</p> <p>1. ALL SHEATHING SHALL CONFORM TO AMERICAN PLYWOOD ASSOCIATION (APA) DESIGN SPECIFICATIONS, LATEST EDITION. SHEATHING SHALL BE CONTINUOUS OVER THREE ADJACENT SPANS MINIMUM.</p> <p>2. WALL SHEATHING SHALL BE 15/32" (1/2" NOMINAL) APA RATED SHEATHING, EXPOSURE 1, 3/16". ALL WALL SHEATHING SHALL BE FASTENED TO SUPPORTING MEMBERS W/ 8d COMMON NAILS @ 6" O.C. AT PANEL EDGES AND 12" O.C. AT INTERMEDIATE SUPPORTS, U.N.O.</p> <p>3. ROOF SHEATHING SHALL BE 23/32" (3/4" NOMINAL) APA RATED SHEATHING, EXPOSURE 1, 48/24". ALL ROOF SHEATHING SHALL BE FASTENED TO SUPPORTING MEMBERS W/ 10d COMMON NAILS @ 6" O.C. AT PANEL EDGES, AND 12" O.C. AT INTERMEDIATE SUPPORTS. U.N.O.</p> <p>MASONRY</p> <p>CONCRETE BLOCK DESIGN AND CONSTRUCTION SHALL CONFORM TO "BUILDING CODE REQUIREMENTS FOR MASONRY STRUCTURES," TMS 402/ACI 530/ASCE 5 AND "SPECIFICATIONS FOR MASONRY STRUCTURES" (TMS 602/ACI 530.1/ASCE 6)</p> <p>1. MASONRY MATERIALS SHALL CONFORM TO THE LATEST EDITION OF THE FOLLOWING SPECIFICATIONS: A. HOLLOW LOAD BEARING CONCRETE BLOCK: ASTM C-90. MINIMUM COMPRESSIVE STRENGTH = 2800 PSI AT 28 DAYS. B. MORTAR: ASTM C-270, TYPE S. MINIMUM COMPRESSIVE STRENGTH = 1800 PSI AT 28 DAYS. C. MORTAR: ASTM C-270, TYPE M. MINIMUM COMPRESSIVE STRENGTH = 2500 PSI AT 28 DAYS. (USED FOR BELOW GRADE WORK) D. GROUT: ASTM C-476. MINIMUM COMPRESSIVE STRENGTH = 2000 PSI AT 28 DAYS. E. MASONRY REINFORCEMENT: ASTM A-82 GALVANIZED (JOINT BEDS, TIES) F. MASONRY PRISM STRENGTH: F'm = 2000 PSI</p> <p>2. PRIOR TO DELIVERY OF MASONRY UNITS TO THE JOB SITE, FURNISH TO THE OWNER AFFIDAVITS FROM AN APPROVED TESTING LABORATORY CERTIFYING THAT ALL UNITS CONFORM TO THEIR RESPECTIVE ASTM REQUIREMENTS.</p> <p>3. GROUT ALL CAVITIES CONTAINING REINFORCEMENT IN LIFTS NOT TO EXCEED 5'-0".</p> <p>4. LABORATORY PREPARED MIXES SHALL BE PREPARED AND TESTED IN ACCORDANCE WITH ASTM C-270. FIELD MORTAR SHALL BE TESTED BY AN APPROVED TESTING LABORATORY IN ACCORDANCE WITH ASTM C-780 TWO SETS OF THREE MORTAR CUBES SHALL BE TAKEN DIRECTLY FROM THE MIXER FOR EACH DAY OF MASONRY WORK. TEST THE CUBES AT 28 DAYS. ACCEPTANCE OF THE MORTAR SHALL BE AT THE DISCRETION OF THE ENGINEER.</p> <p>5. CALCIUM CHLORIDE AND/OR ADMIXTURES CONTAINING CALCIUM CHLORIDE SHALL NOT BE INCLUDED IN MORTAR OR GROUT MIX, EXCEPT WHEN APPROVED IN WRITING BY THE STRUCTURAL ENGINEER. NO ANTI FREEZE COMPOUNDS SHALL BE USED TO LOWER THE MORTAR'S FREEZING POINT.</p> <p>6. NO EXTERIOR MASONRY SHALL BE LAID WHEN THE OUTSIDE AIR TEMPERATURE IS LESS THAN 40 DEGREES FAHRENHEIT, UNLESS THE RECOMMENDATIONS SPECIFIED BY THE BUILDING CODE REQUIREMENTS FOR MASONRY STRUCTURES" TMS 402/ACI 530/ASCE 5 AND "SPECIFICATIONS FOR MASONRY STRUCTURES" (TMS 602/ACI 530.1/ASCE 6) FOR COLD WEATHER CONSTRUCTION ARE STRICTLY FOLLOWED.</p> <p>7. THE MASONRY CONTRACTOR SHALL PROVIDE BRACING TO WITHSTAND HORIZONTAL PRESSURES AS REQUIRED BY THE BUILDING CODE AND LOCAL ORDINANCE.</p> <p>LIGHT GAGE METAL FRAMING</p> <p>1. 16 GA. AND HEAVIER STUDS SHALL HAVE A MINIMUM YIELD STRESS OF 50,000 PSI. 18 GA. AND LIGHTER STUDS AND TRACKS SHALL HAVE A MINIMUM YIELD STRESS OF 33,000 PSI. 2. STUDS AND TRACKS SHALL BE 18 GA. MINIMUM U.N.O. THEY SHALL BE MANUFACTURED BY DIETRICH INDUSTRIES, INC. OR APPROVED EQUAL. 3. PROVIDE DOUBLE STUDS FOR FULL HEIGHT OF WALL EACH SIDE OF ALL OPENINGS UNLESS OTHERWISE NOTED. WELD STUDS TO EACH OTHER WITH 1 1/2" LONG 1/8" FILLET WELDS AT 12" O.C. EACH SIDE. PROVIDE STUD TRACK AT EACH HEAD AND SILL. 4. REFER TO PLANS AND DETAILS FOR CONNECTION OF STUD WALLS TO FOUNDATION, FLOOR OR ROOF.</p> <p>SHOP DRAWINGS</p> <p>1. SHOP DRAWING SUBMITTALS SHALL BE SUBMITTED ELECTRONICALLY. 2. SHOP DRAWINGS SHALL BE REVIEWED BY CONTRACTOR TO VERIFY THAT SUBMITTAL IS COMPLETE PRIOR TO SUBMITTING TO ARCHITECT/ENGINEER. 3. DRAWINGS CREATED BY THE ENGINEER OF RECORD CANNOT BE REPRODUCED AND/OR USED AS A SHOP DRAWING SUBMITTAL. SHOP DRAWING SUBMITTALS SHALL INCLUDE THE FOLLOWING: A. CONCRETE MIX DESIGN B. FOUNDATION REINFORCING BARS C. STRUCTURAL STEEL D. OPEN WEB JOISTS AND CALCULATIONS E. ROOF SHEATHING F. TRELLIS SYSTEM & CALCULATIONS G. LAMINATED VENEER LUMBER (LVL) H. SAWN LUMBER AND CONNECTORS</p> <p>SPECIAL INSPECTIONS</p> <p>1. SPECIAL INSPECTIONS SHALL BE PERFORMED IN ACCORDANCE WITH SECTION 1705 OF IBC AND THE OWNER SHALL EMPLOY ONE OR MORE SPECIAL INSPECTORS TO PROVIDE INSPECTIONS DURING CONSTRUCTION ON THE TYPES OF WORK LISTED UNDER SECTION 1705. THE FOLLOWING AREAS OF WORK REQUIRE SPECIAL INSPECTIONS IN ACCORDANCE WITH THE LISTED 2021 INTERNATIONAL BUILDING CODE SECTIONS/LOCATIONS: A. SOILS – SECTION 1705.6 PER TABLE 1705.6 B. CONCRETE – SECTION 1705.3 PER TABLE 1705.3 C. STEEL – SECTION 1705.2 (SEE AISC 360.10) D. MASONRY – SECTION 1705.4 E. WOOD – SECTION 1705.5</p> <p>MISCELLANEOUS</p> <p>ALL DIMENSIONS ON STRUCTURAL DRAWINGS TO BE CHECKED AGAINST ARCHITECTURAL, MECHANICAL AND ELECTRICAL DRAWINGS BY THE GENERAL CONTRACTOR AND ANY DISCREPANCIES ARE TO BE REPORTED TO THE ARCHITECT IMMEDIATELY.</p> <p>THE CONTRACTOR SHALL ASSUME RESPONSIBILITY, UNRELIEVED BY REVIEW OF SHOP DRAWINGS OR PERIODIC OBSERVATION OF CONSTRUCTION, FOR COMPLIANCE WITH THE CONTRACT DOCUMENTS, FOR FABRICATION PROCESSES AND CONSTRUCTION TECHNIQUES, AND FOR SAFE CONDITIONS ON THE JOB SITE.</p> <p>DO NOT SCALE THE DRAWINGS.</p> <p>CONCRETE BLOCK JOINT REINFORCEMENT (AT DUMPSTER ENCLOSURE):</p> <p>ALL CONCRETE BLOCK WALLS TO RECEIVE THE FOLLOWING JOINT REINFORCEMENT: LADDER TYPE JOINT REINFORCING WITH SIDE AND CROSS RODS WITH WIRE SIZE (W.2.8 OR 3/16") SPACED 16" O.C. VERTICALLY. (HOHMANN & BARNARD 220 "SUPER HEAVY DUTY" OR EQUAL) SIMILAR FOR CONCRETE BRICK PRODUCTS.</p> <p>CONCRETE BLOCK JOINT REINFORCEMENT</p> <p>1 S4.0</p> <p>VENeer TIE REQUIREMENTS:</p> <p>1. FOR SEISMIC DESIGN CATEGORIES 'A' THROUGH 'C' WITH ULTIMATE WIND SPEED LESS THAN 140 MPH, USE THE FOLLOWING: VENEER TIES W/ WIRE SIZE (W.2.8 OR 3/16") SPACED 16" O.C. VERTICALLY AND 32" HORIZONTALLY. ADDITIONAL TIES ALONG ALL OPENINGS GREATER THAN 16" ARE REQUIRED TO BE LOCATED WITHIN 12" OF OPENING AND SPACED 36" O.C. MAX. AROUND OPENING PERIMETER. (HOHMANN & BARNARD VBT-VEE-BYNA TIE WITH DW10-HS ANCHOR PLATE OR EQUAL).</p> <p>2 S4.0</p> <p>ALL UTILITY CONNECTIONS IS TO BE COORDINATED WITH CIVIL ENGINEER ON RECORD AND ACM, CC TO VERIFY ANY DISCREPANCIES WITH ARCHITECT, ENGINEERS OF RECORD, AND ACM.</p>
<p>rubix Rubix Consultants, LLC www.rubix.com 4803 N. Cicero Ave., Suite 100 Chicago, IL 60613 (312) 602-5411</p> <p>ASHIF PANAKKAT 101598 LICENSED PROFESSIONAL ENGINEER SIGNED/SEALED 03/08/2024</p> <p>McDonald's USA, LLC These drawings and specifications are the confidential and proprietary property of McDonald's USA, LLC and shall not be copied or reproduced for use on other projects or sites in conjunction with its issue date and are not suitable to use on a different site or at a later time. Use of these drawings and specifications on another project requires the express written consent of McDonald's USA, LLC. These drawings and specifications are intended for use on one specific project and are not authorized for the contract documents for reuse on another project. If reuse on another project is desired, the contractor must obtain a copy of the original contract documents for reuse on another project.</p>		
<p>DRAWN BY MKP STD ISSUE DATE 2023</p> <p>REVIEWED BY AP</p> <p>DATE ISSUED 03/08/24</p> <p>TITLE 2023 STANDARD BUILDING - BB20</p> <p>DESCRIPTION 4.597-WOOD/WOOD</p> <p>WOOD BEARING WALLS W/4" BRICK VENEER</p> <p>STUCCO/BATEN/BRICK/METAL PANEL EXTERIOR FINISHES</p> <p>SITE ID 402-3271</p> <p>SITE ADDRESS SEC OF S.H. LOOP 288 & HUMMINGBIRD LANE, DENTON, TEXAS</p> <p>SHEET NO. JAWA 24-0014</p> <p>S4.0 STRUCTURAL NOTES</p>		

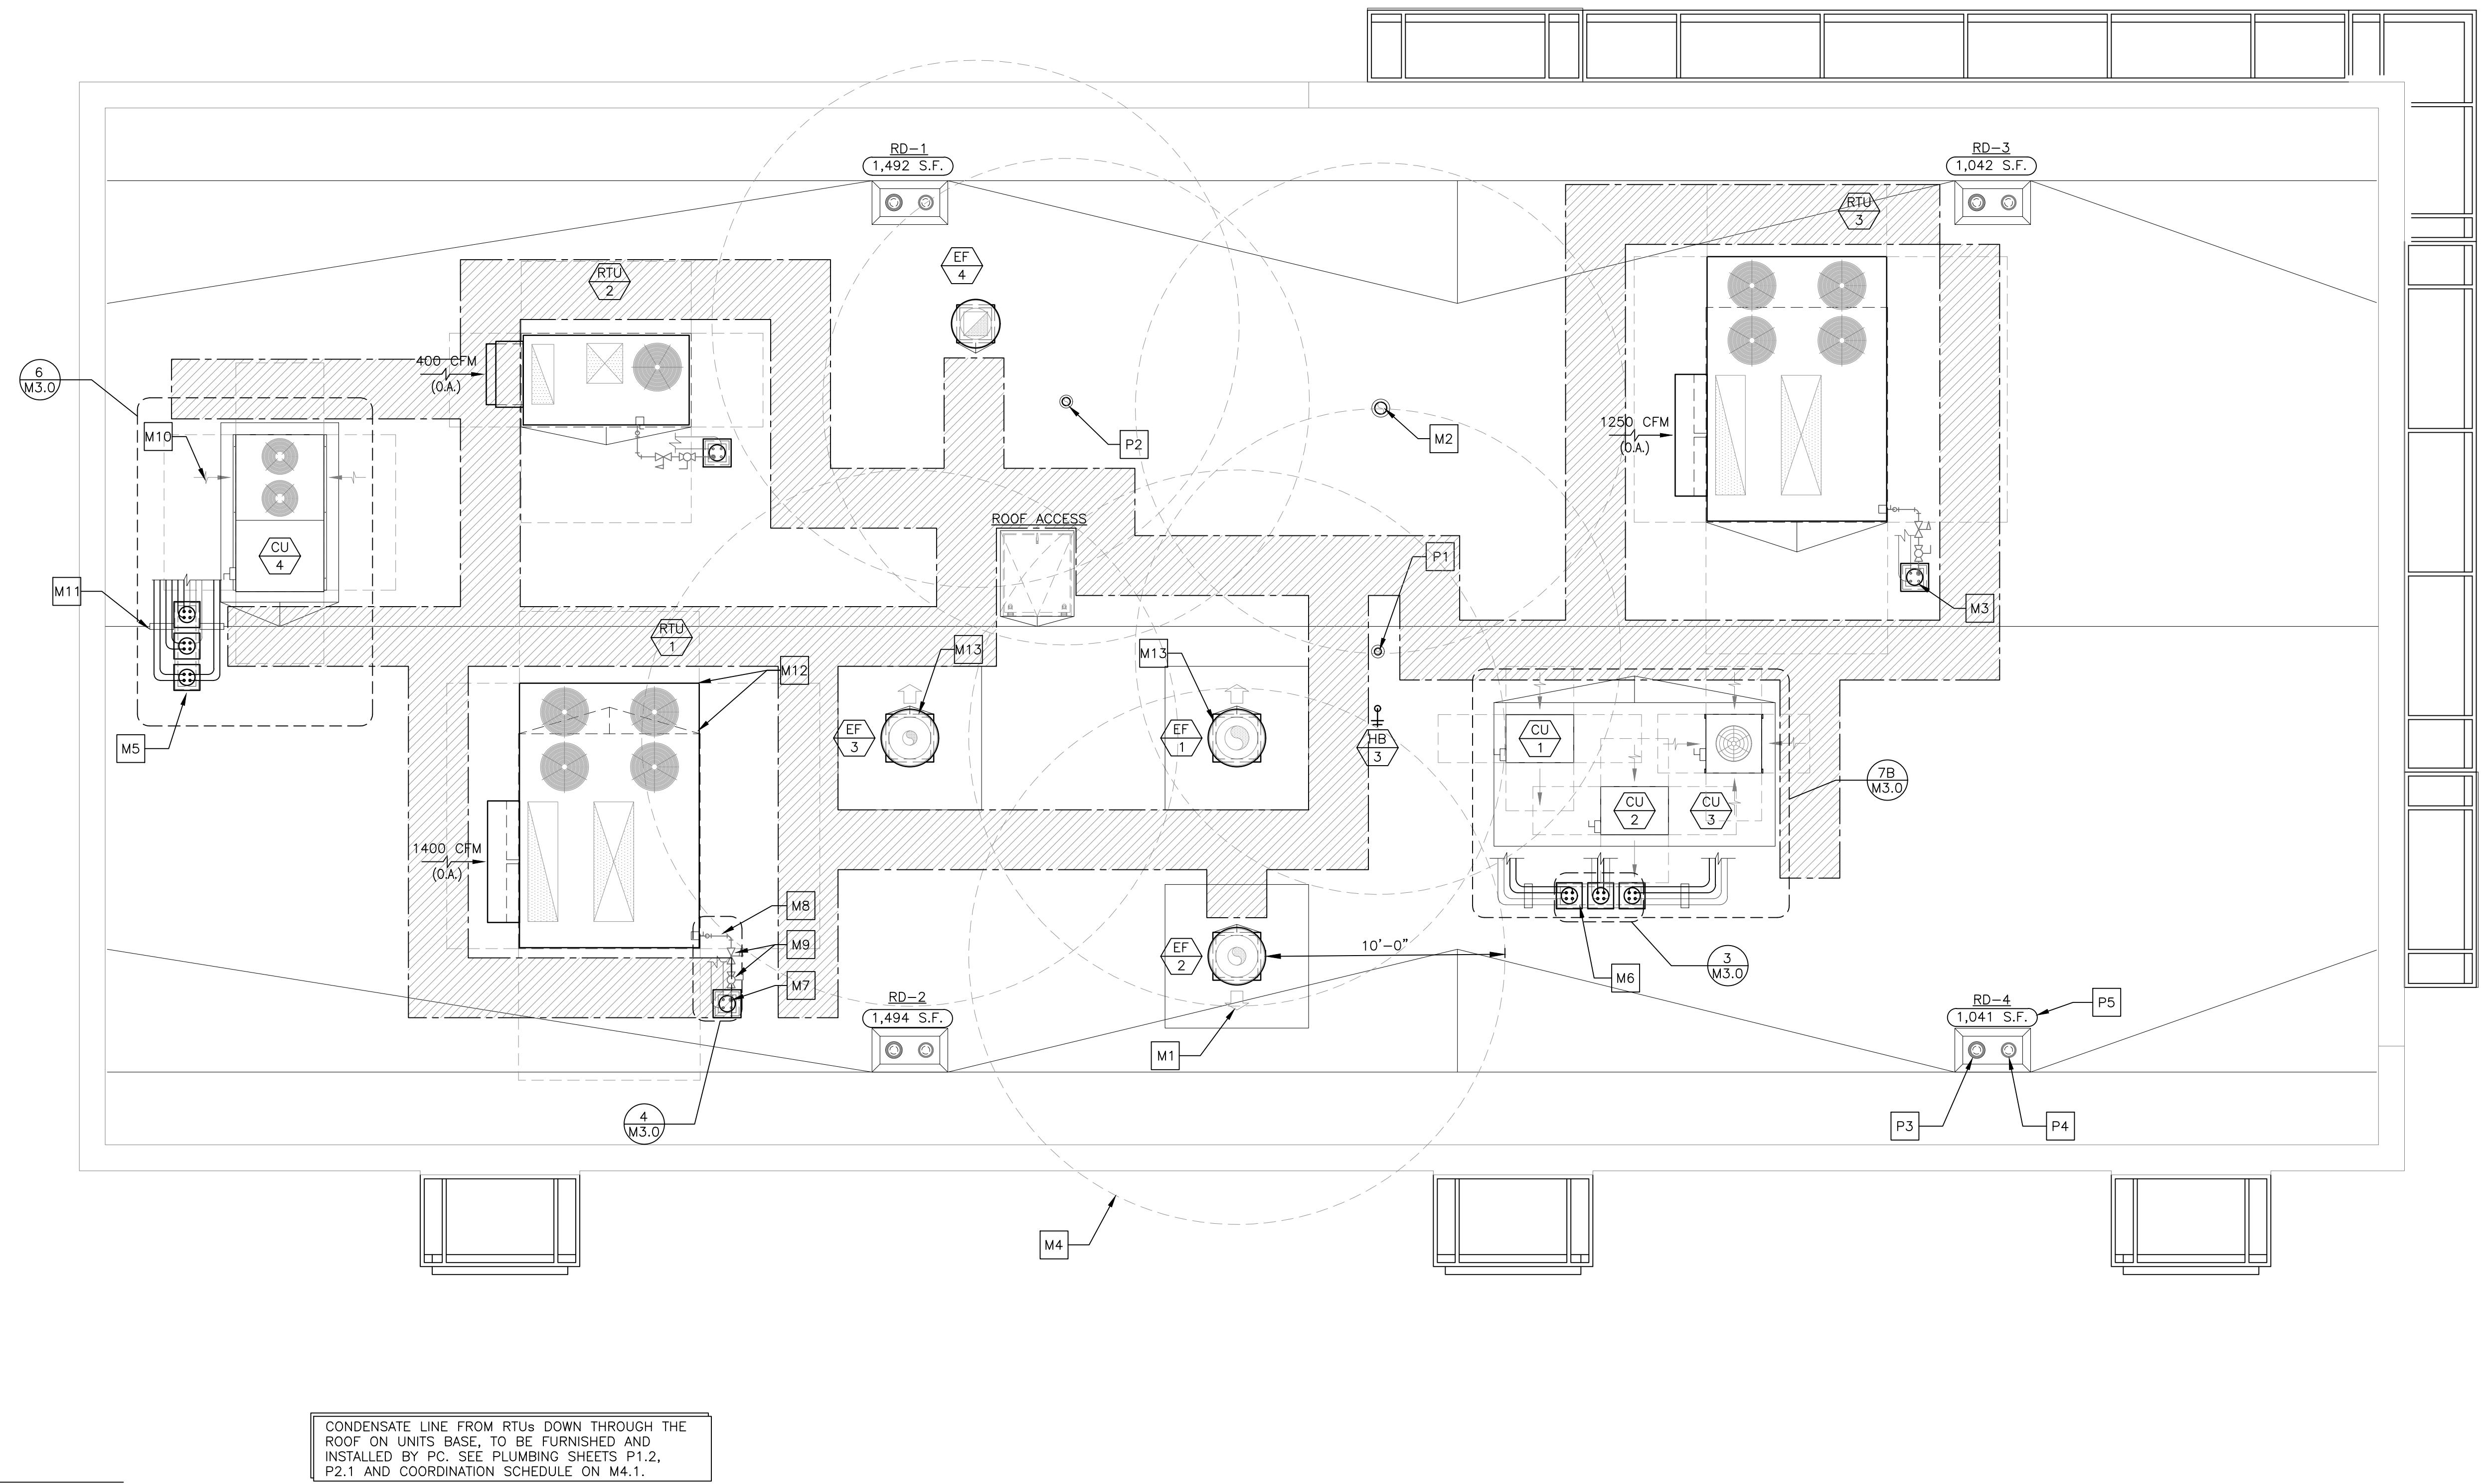

1
M1.0 ROOF PLAN
 $1/4'' = 1'-0''$

DRAWING NOTES

1. ROOFTOP EQUIPMENT LOCATIONS SHOWN ARE GENERAL. ACTUAL LOCATIONS SHALL BE COORDINATED WITH THE STRUCTURAL DRAWINGS.
 2. ROOF OPENINGS FOR ROOFTOP UNITS AND EXHAUST FANS SHALL BE COORDINATED WITH THE MANUFACTURER.
 3. ROOF OPENINGS FOR PIPE PORTALS SHALL ONLY BE LARGE ENOUGH TO ALLOW PIPE AND CONDUIT PENETRATIONS. PIPE PORTAL CURB SHALL BE FILLED WITH AS MUCH BATT INSULATION AS POSSIBLE.
 4. PRIOR TO INSTALLING THE TOP OF THE EQUIPMENT PLATFORM, INSIDE OF THE PLATFORM SHALL BE INSULATED WITH AS MUCH BATT INSULATION AS POSSIBLE.

KEYED NOTES

- M1 ARROW INDICATES DIRECTION OF EXHAUST FAN HINGE SWING (TYP.)
 - M2 6"Ø ALUMINUM EXHAUST DUCT FROM EXHAUST FAN (EF-5). PROVIDE PORTALS PLUS PLASTI-FLASH WITH C-126 CAP (OR EQUAL) FOR ROOF PENETRATION. TERMINATE DUCT A MIN. OF 24" ABOVE FINISHED ROOF WITH GOOSENECK.
 - M3 GAS PIPING DOWN (TYP. 3 PLACES)
 - M4 MAINTAIN A MINIMUM 10'-0" CLEARANCE FROM EDGE OF OUTLETS AND VENT TERMINALS TO FRESH AIR INTAKES (TYP.)
 - M5 ROOF PIPE PORTAL FOR MAC UNIT
 - M6 ROOF PIPE PORTAL FOR CONDENSING UNITS
 - M7 ROOF PIPE PORTAL FOR ROOFTOP UNITS (TYP. 3 PLACES)
 - M8 GAS PIPING FROM ROOF PORTAL TO ROOFTOP UNIT SHALL BE COATED WITH A CORROSION RESISTANT PAINT (SEE SHEET M4.0 "NATURAL GAS SYSTEMS", NOTE 8)
 - M9 GAS PRESSURE REGULATOR AND SHUT-OFF VALVE, SET PRESSURE AT 7" W.C. - NATURAL GAS (TYP. OF 3)
 - M10 ARROW INDICATES DIRECTION OF AIRFLOW FOR CONDENSING OR ROOFTOP UNIT AIR INTAKE (TYP.)
 - M11 REFRIGERANT PIPING SUPPORT AS REQUIRED. PROVIDE ROOFTOP BLOX MODEL RTB-01 (OR EQUAL) AND ALL NECESSARY ACCESSORIES FOR PROPER PIPE AND CONDUIT SUPPORT. PROVIDE GALVANIZED PIPE SHIELD TO PROTECT INSULATION AT ALL SUPPORTS.

PIPE PORTAL SCHEDULE

ER	CURB DIMENSIONS	CURB TYPE	CAP TYPE (QTY)	SERVES	THERMOSTAT SETTINGS				DRAWN MES	STD ISSUE 2023	REVIEWED JAW	DATE ISSUED 03/08/2023		
					SETPOINTS		FAN	COOLING						
	12"x12"x11"H	RC-2A	N18 (1)	RTU-1 THROUGH RTU-3	MODE	FAN		COOLING		HEATING		B20		
					OCCUPIED	ON		75°F		70°F				
	43"x12"x13"H	RC-2A	N18 (3)	CU-1 THROUGH CU-4	UNOCCUPIED	AUTO		90°F		55°F		ES		
					HUMIDITY					HUMIDITY SETPOINT (FOR DEHUMIDIFICATION UNITS ONLY)				

SEQUENCE OF OPERATION

- TU-1, RTU-2 & RTU-3:

 - . OCCUPIED MODE SHALL BEGIN AS FOLLOWS:
 - RTU-1: 1.5 HOURS BEFORE OPEN
 - RTU-2: 1 HOUR BEFORE OPEN
 - RTU-3: 30 MINUTES BEFORE OPEN
 - . ROOFTOP UNIT FAN SHALL RUN CONTINUOUSLY DURING OCCUPIED MODE
 - . ECONOMIZER SHALL BE OPEN DURING OCCUPIED MODE (OUTDOOR AIR THROUGH ROOFTOP UNITS SERVES AS MAKE-UP AIR FOR THE KITCHEN EXHAUST SYSTEM) – REFER TO E3.2 FOR HOOD/FAN INTERLOCK DETAILS.
 - . UNOCCUPIED MODE SHALL BEGIN ONE (1) HOUR AFTER STORE CLOSES
 - . DURING UNOCCUPIED MODE, ECONOMIZER IS CLOSED AND HEATING, COOLING AND FAN OPERATE IN AUTO MODE (ON DEMAND)

McDonald's USA, LLC


Robert D. Anderson, Inc.
EP Engineering & Design Consultants
*Illumination*Plumbing*Power Distribution*Controls

Robert D. Anderson
4403 Zion Rd.
Garland, TX 75043

972-814-7324
robert.d.anderson@sbcglocal.net


Mark Swanson-Project Manager
817-556-0986
mark@mepdesigntx.com

IS DIAGRAMMATIC, AND AS SUCH ADJUSTMENTS FOR
FIELD CONDITIONS MAY BE REQUIRED; THIS DRAWING WAS
DRAFTED FOR SPECIFIC USE ON THE DATE AND SITE INDICATED HEREON;
THIS DRAWING FOR REFERENCE OR EXAMPLE ON ANOTHER
PROJECT REQUIRES THE SERVICES OF THIS ENGINEER. DRAWINGS ARE
NOT COPYRIGHT AND MAY NOT BE REPRODUCED, DISTRIBUTED,
OR USED IN ANY WAY WITHOUT THE EXPRESS WRITTEN
CONSENT OF ROBERT D. ANDERSON, P.E.

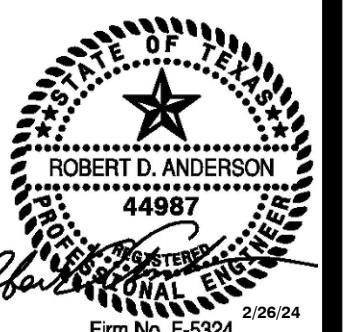

McDonald's USA, LLC

2023 STANDARD BUILDING		BB20	STD ISSUE DATE 2023
4597-WOOD/WOOD		REVIEWED BY JAW	DATE ISSUED 03/08/24
<p>DESCRIPTION</p> <p>WOOD BEARING WALLS W/4" BRICK VENEER</p> <p>WOOD ROOF TRUSS FRAMING</p> <p>STUCCO/BATTEN/BRICK/METAL PANEL EXTERIOR FINISHES</p>			
SITE ID 042-3271	SITE ADDRESS SEC OF S.H. LOOP 288 & HUMMINGBIRD LANE, DENTON TEXAS		
JAWA 24-0014			

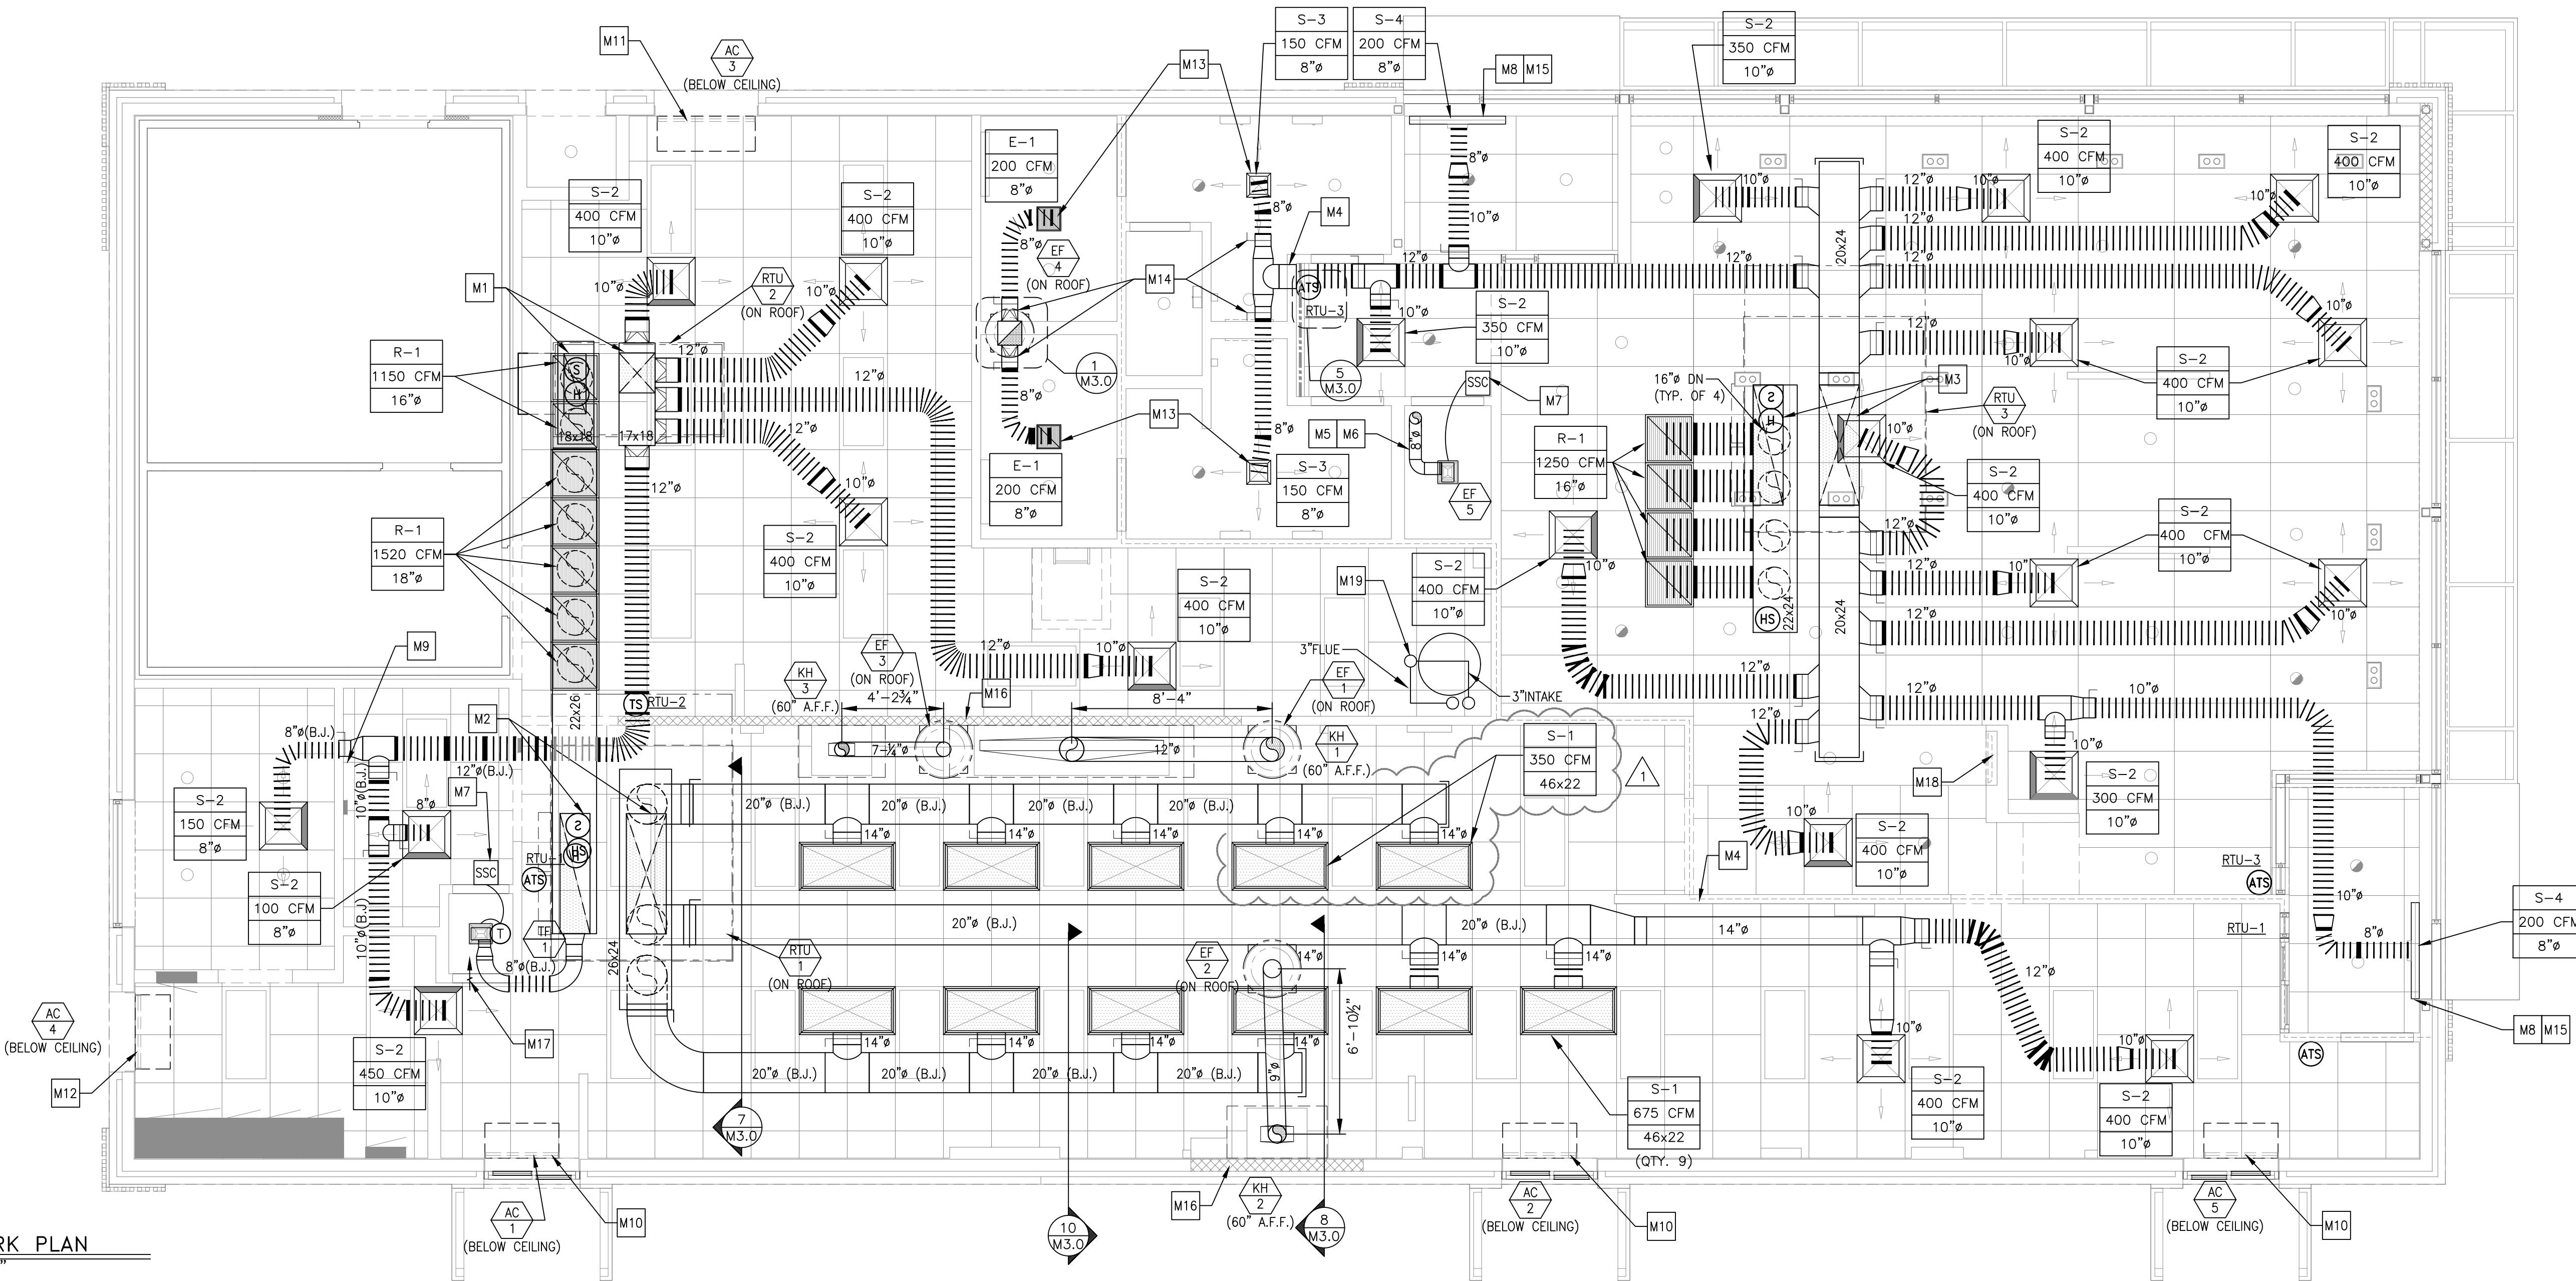

DRAWING NOTES

- ALL DUCTWORK SHALL BE RUN BETWEEN OR THROUGH THE JOISTS UNLESS NOTED OTHERWISE. DUCTWORK DESIGNED WITH (B.J.) SHALL BE RUN BELOW THE JOISTS.
- DUCT SIZES SHOWN ARE INTERNAL FREE AREA DIMENSIONS UNLESS NOTED OTHERWISE.
- ALL SHEET METAL DUCTWORK SHALL BE EXTERNALLY INSULATED. INSULATION IS NOT SHOWN FOR CLARITY. SEE MECHANICAL NOTES FOR INSULATION REQUIREMENTS.
- CARBON STEEL KITCHEN EXHAUST DUCTWORK SHALL BE EXTERNALLY INSULATED. INSULATION NOT SHOWN FOR CLARITY. SEE MECHANICAL NOTES AND DETAILS FOR INSULATION REQUIREMENTS.
- RETURN AIRFLOW VOLUME SHOWN ON PLAN IS FOR DUCTWORK SIZING PURPOSES WHEN THE UNIT IS IN RECIRCULATION (UNOCCUPIED) MODE.
- DIFFUSERS IN DINING ROOM ARE SPECIFIC TO THE DECOR PLAN SHOWN. DIFFERENT CEILING LAYOUTS MAY REQUIRE A DIFFERENT DIFFUSER TYPES, QUANTITIES, LOCATIONS AND FINISHES/COLORS.
- NO DIFFUSERS OR GRILLES TO BE INSTALLED ABOVE KIOSKS TO AVOID CONFLICTS WITH KIOSK'S CEILING PENETRATIONS FOR CONDUITS
- M1 18x20 SUPPLY AND 11x30 RETURN DUCT DROPS FROM ROOFTOP UNIT (RTU-2)
- M2 20x60 SUPPLY AND 15x60 RETURN DUCT DROPS FROM ROOFTOP UNIT (RTU-1)
- M3 20x60 SUPPLY AND 15x60 RETURN DUCT DROPS FROM ROOFTOP UNIT (RTU-3)
- M4 PROVIDE SHEET METAL DUCT AT ALL DRAFTSTOP WALL PENETRATIONS (TYP.)
- M5 6"Ø ALUMINUM DUCT FROM EXHAUST FAN UP THROUGH ROOF
- M6 EXTERNALLY INSULATE EXHAUST DUCT FROM FAN TO ROOF PENETRATION
- M7 STEADY STATE SPEED CONTROLLER FOR CEILING MOUNTED EXHAUST FAN. STEADY STATE SPEED CONTROLLER SHALL BE INSTALLED OVER SUSPENDED CEILING FOR ACCESS. DO NOT INSTALL OVER AREAS WITH DRYWALL CEILINGS.
- M8 SET DIFFUSER'S (S-5) OUTER SLOT FOR VERTICAL AIR THROW PATTERN AND INNER SLOT FOR HORIZONTAL THROW PATTERN (TYP.)
- M9 BUILDING AUTOMATION SYSTEM LOCATION. SEE LIGHTING CONTROL DETAILS ON SHEET E4.1.
- M10 MOUNT AIR CURTAIN TIGHT TO CEILING
- M11 MOUNT AIR CURTAIN WITH BOTTOM OF UNIT AT TOP OF DOOR FRAME
- M12 MOUNT AIR CURTAIN WITH BOTTOM OF UNIT ABOVE DOOR FRAME AND TOP OF SWITCHGEAR TO MEET 3'-0" MINIMUM SWITCHGEAR'S CLEARANCE REQUIREMENT
- M13 FOR DIFFUSERS INSTALLED IN DRYWALL CEILINGS, VOLUME DAMPER IS INTEGRAL TO DIFFUSER AND ADJUSTABLE AT FACE OF DIFFUSER (SEE NOTE 18 UNDER "VENTILATION SYSTEMS" ON DRAWING M4.0 AND AIR DEVICE SCHEDULE ON DRAWING M4.1)
- M14 FOR DIFFUSERS INSTALLED IN DRYWALL CEILINGS, INSTALL HIGH-EFFICIENCY TAKE-OFFS WITH VOLUME DAMPER IN FULL-OPEN POSITION TO FACILITATE BALANCING AT FACE OF DIFFUSER.
- M15 GENERAL CONTRACTOR SHALL PROVIDE ADDITIONAL T-BAR FRAME TO PROPERLY LOCATE DIFFUSER AS SHOWN. AIR STREAM FROM DIFFUSER SHALL COVER ENTIRE DOOR OPENING.
- M16 NONCOMBUSTIBLE WALL CONSTRUCTION BEHIND TYPE I KITCHEN HOODS. REFER TO SHEET A1.0 FOR MORE INFORMATION.
- M17 ONE INCH DOOR UNDERCUT TRANSFER AIR TO CLOSET (100 CFM)
- M18 MECHANICAL CONTRACTOR TO PROVIDE 4x12 LOUVERED RETURN AIR BEHIND EACH RECESSED MENU BOARD. SEE ARCHITECTURAL PLANS, DETAIL 14/A3.1. AND AIR DEVICE SCHEDULE (R-2) ON SHEET M4.1.

KEYED NOTES


2021 IMC SECTION 403.3 - VENTILATION SCHEDULE

UNIT	AREA SERVED	AREA FT ² (A _z)	CFM/PERSON (R _p)	CFM/FT ² (V _{bz})	PEOPLE OR PEOPLE/1000 FT ²	UNCORRECTED REQUIRED O/A CFM (V _{bz})	E _z *	Ev**	REQUIRED O/A CFM (V _{ot})***	ACTUAL O/A CFM	REQUIRED EXHAUST CFM	ACTUAL EXHAUST CFM
RTU-1	PRESENTER	343	5	0.06	4	41	0.8	0.98	305	311	1300	
	KITCHEN	714	7.5	0.18	18	-	0.8					
RTU-2	SUPPORT	603	0	0.12	0	72	0.8	0.84	-	-	-	
	MANAGER'S OFFICE	60	5	0.06	1	9	0.8		-	-	-	
RTU-3	CREW ROOM	96	5	0.06	5	30	0.8	-	-	-	-	
	ORDER	140	5	0.06	7	43	0.8	-	-	-	-	
EF-1, 2 & 3	DINING	1284	7.5	0.18	90	905	0.8	0.91	183	400	-	
	VESTIBULE 1	57	0	0.06	0	3	0.8		-	-	-	
	VESTIBULE 2	44	0	0.06	0	3	0.8		-	-	-	
	WOMEN'S	135	0	0.06	0	8	0.8		-	-	-	
	MEN'S	122	0	0.06	0	7	0.8		-	-	-	
EF-4	KITCHEN	714	-	0.7	-	-	-		927	1018	1330	
	WOMEN'S	135	-	-	-	-	-		-	-	100	
	MEN'S	122	-	-	-	-	-		-	-	100	
	JANITOR'S CLOSET	19	-	-	-	-	-		-	-	50	
									TOTAL:	750	2880	

* ZONE AIR DISTRIBUTION EFFECTIVENESS BASED ON ASHRAE 62.1 TABLE 6.2 FOR CEILING SUPPLY IF WARM AIR 15°F OR MORE ABOVE SPACE TEMPERATURE AND CEILING RETURN (IMC TABLE 403.3.12)
 ** VENTILATION SYSTEM EFFICIENCY BASED ON ASHRAE 62.1 TABLE 6.3 AND SECTION 6.2.5 (IMC SECTION 403.3.2.3 MZ)
 *** CORRECTED REQUIRED O/A INTAKE REQUIRED FOR SYSTEM CALCULATED BASED ON ASHRAE 62.1 SECTION 6.2 (IMC SECTION 403.3)

M19 PROVIDE AIR INTAKE AND FLUE EXHAUST PER MANUFACTURER'S INSTALLATION MANUAL. AIR INTAKE AND FLUE EXHAUST TO COMBINE WITH CONCENTRIC VENT KIT. REFER TO 6/P3.0 FOR FURTHER DETAILS.

AIR BALANCE SCHEDULE

UNIT	SUPPLY AIR	RETURN AIR	OUTDOOR AIR	EXHAUST AIR	PRESSURE
RTU-1	7600	6200	1400		1400
RTU-2	2300	1900	400		400
RTU-3	5000	3750	1250		1250
EF-1					1350
EF-2					575
EF-3					480
EF-4					400
EF-5					75
TOTALS	14900	11850	3050	2880	170


NOTES:


- BALANCING TOLERANCES ARE AS FOLLOWS:
 HOODS: 0% TO +10%
 OUTDOOR AIR: 0% TO +10%
 SUPPLY AND RETURN AIR DIFFUSERS: -10% TO +10%
 TOILET EXHAUST AIR: -10% TO +10%
- BALANCE ROOFTOP UNIT SUPPLY AND RETURN AIR PRIOR TO TURNING ON EXHAUST FANS.
- EXHAUST HOODS SHALL BE BALANCED WITH A 4" VANE ANEMOMETER.
- RTU BLOWER TO RUN CONTINUOUSLY DURING OCCUPIED HOURS. REFER TO SEQUENCE OF OPERATIONS ON M1.0 AND E3.2 FOR HOOD/FAN INTERLOCK DETAILS.

HEATING SCHEDULE

EQUIPMENT	INPUT (BTU/HR)	OUTPUT (BTU/HR)	REQUIRED HEAT (BTU/HR)
ROOFTOP UNIT (RTU-1)	260,000	208,000	99,852
ROOFTOP UNIT (RTU-2)	65,000	52,000	30,949
ROOFTOP UNIT (RTU-3)	169,000	135,000	92,585
TOTALS	494,000	395,000	223,386


BY	REV	DATE	DESCRIPTION
Robert D. Anderson, Inc.	1	04/01/2024	USRD OC PLAN REVIEW COMMENTS
MEP Engineering & Design Consultants			
HVAC Illumination/Plumbing/Power Distribution/Control			
Robert D. Anderson			
4403 Zinn Rd,			
Garland, TX 75043			
voice: 972-814-7204			
email: robert.d.anderson@bigslegal.net			
contact: Mark Swanson Project Manager			
voice: 817-556-0986			
email: mark@mcdesigns.com			
DRAWING IS DIAGRAMATIC, AND AS SUCH ADJUSTMENTS FOR EXACT CONSTRUCTION ARE NOT INDICATED. THIS DRAWING IS PREPARED FOR SPECIFIC USE ON THE DATE AND IN THE PROJECT FOR WHICH IT WAS ISSUED. THE PROJECT OWNER IS RESPONSIBLE FOR THE ACCURACY OF THE INFORMATION CONTAINED HEREIN. THIS DRAWING IS NOT TO BE USED IN ANY WAY WITHOUT THE EXPRESS WRITTEN CONSENT OF THE ORIGINAL DESIGNER.			
			
These drawings and specifications are the confidential and proprietary drawings and specifications of McDonald's USA, LLC and shall not be copied or reproduced without the express written consent of McDonald's USA, LLC. These drawings and specifications are issued on a specific site or in a specific location. They are not suitable for use on a different site or at a later time. Use of these drawings for reference or example on another project requires the services of properly licensed architects and engineers. Reproduction of these drawings on another project is not authorized.			
SHEET NO. M1.2 DUCTWORK PLAN			
TITLE 2023 STANDARD BUILDING - BB20			
DESCRIPTION 4597-WOOD/WOOD			
SITE ADDRESS SEC. OF S.H. LOOP 288 & HUMMINGBIRD LANE, DENTON, TEXAS			
DATE 03/08/24			
DRAWN BY MES PREPARED FOR:			
STD ISSUE DATE 2023 REVIEWED BY JAW DATE ISSUED 03/08/24			

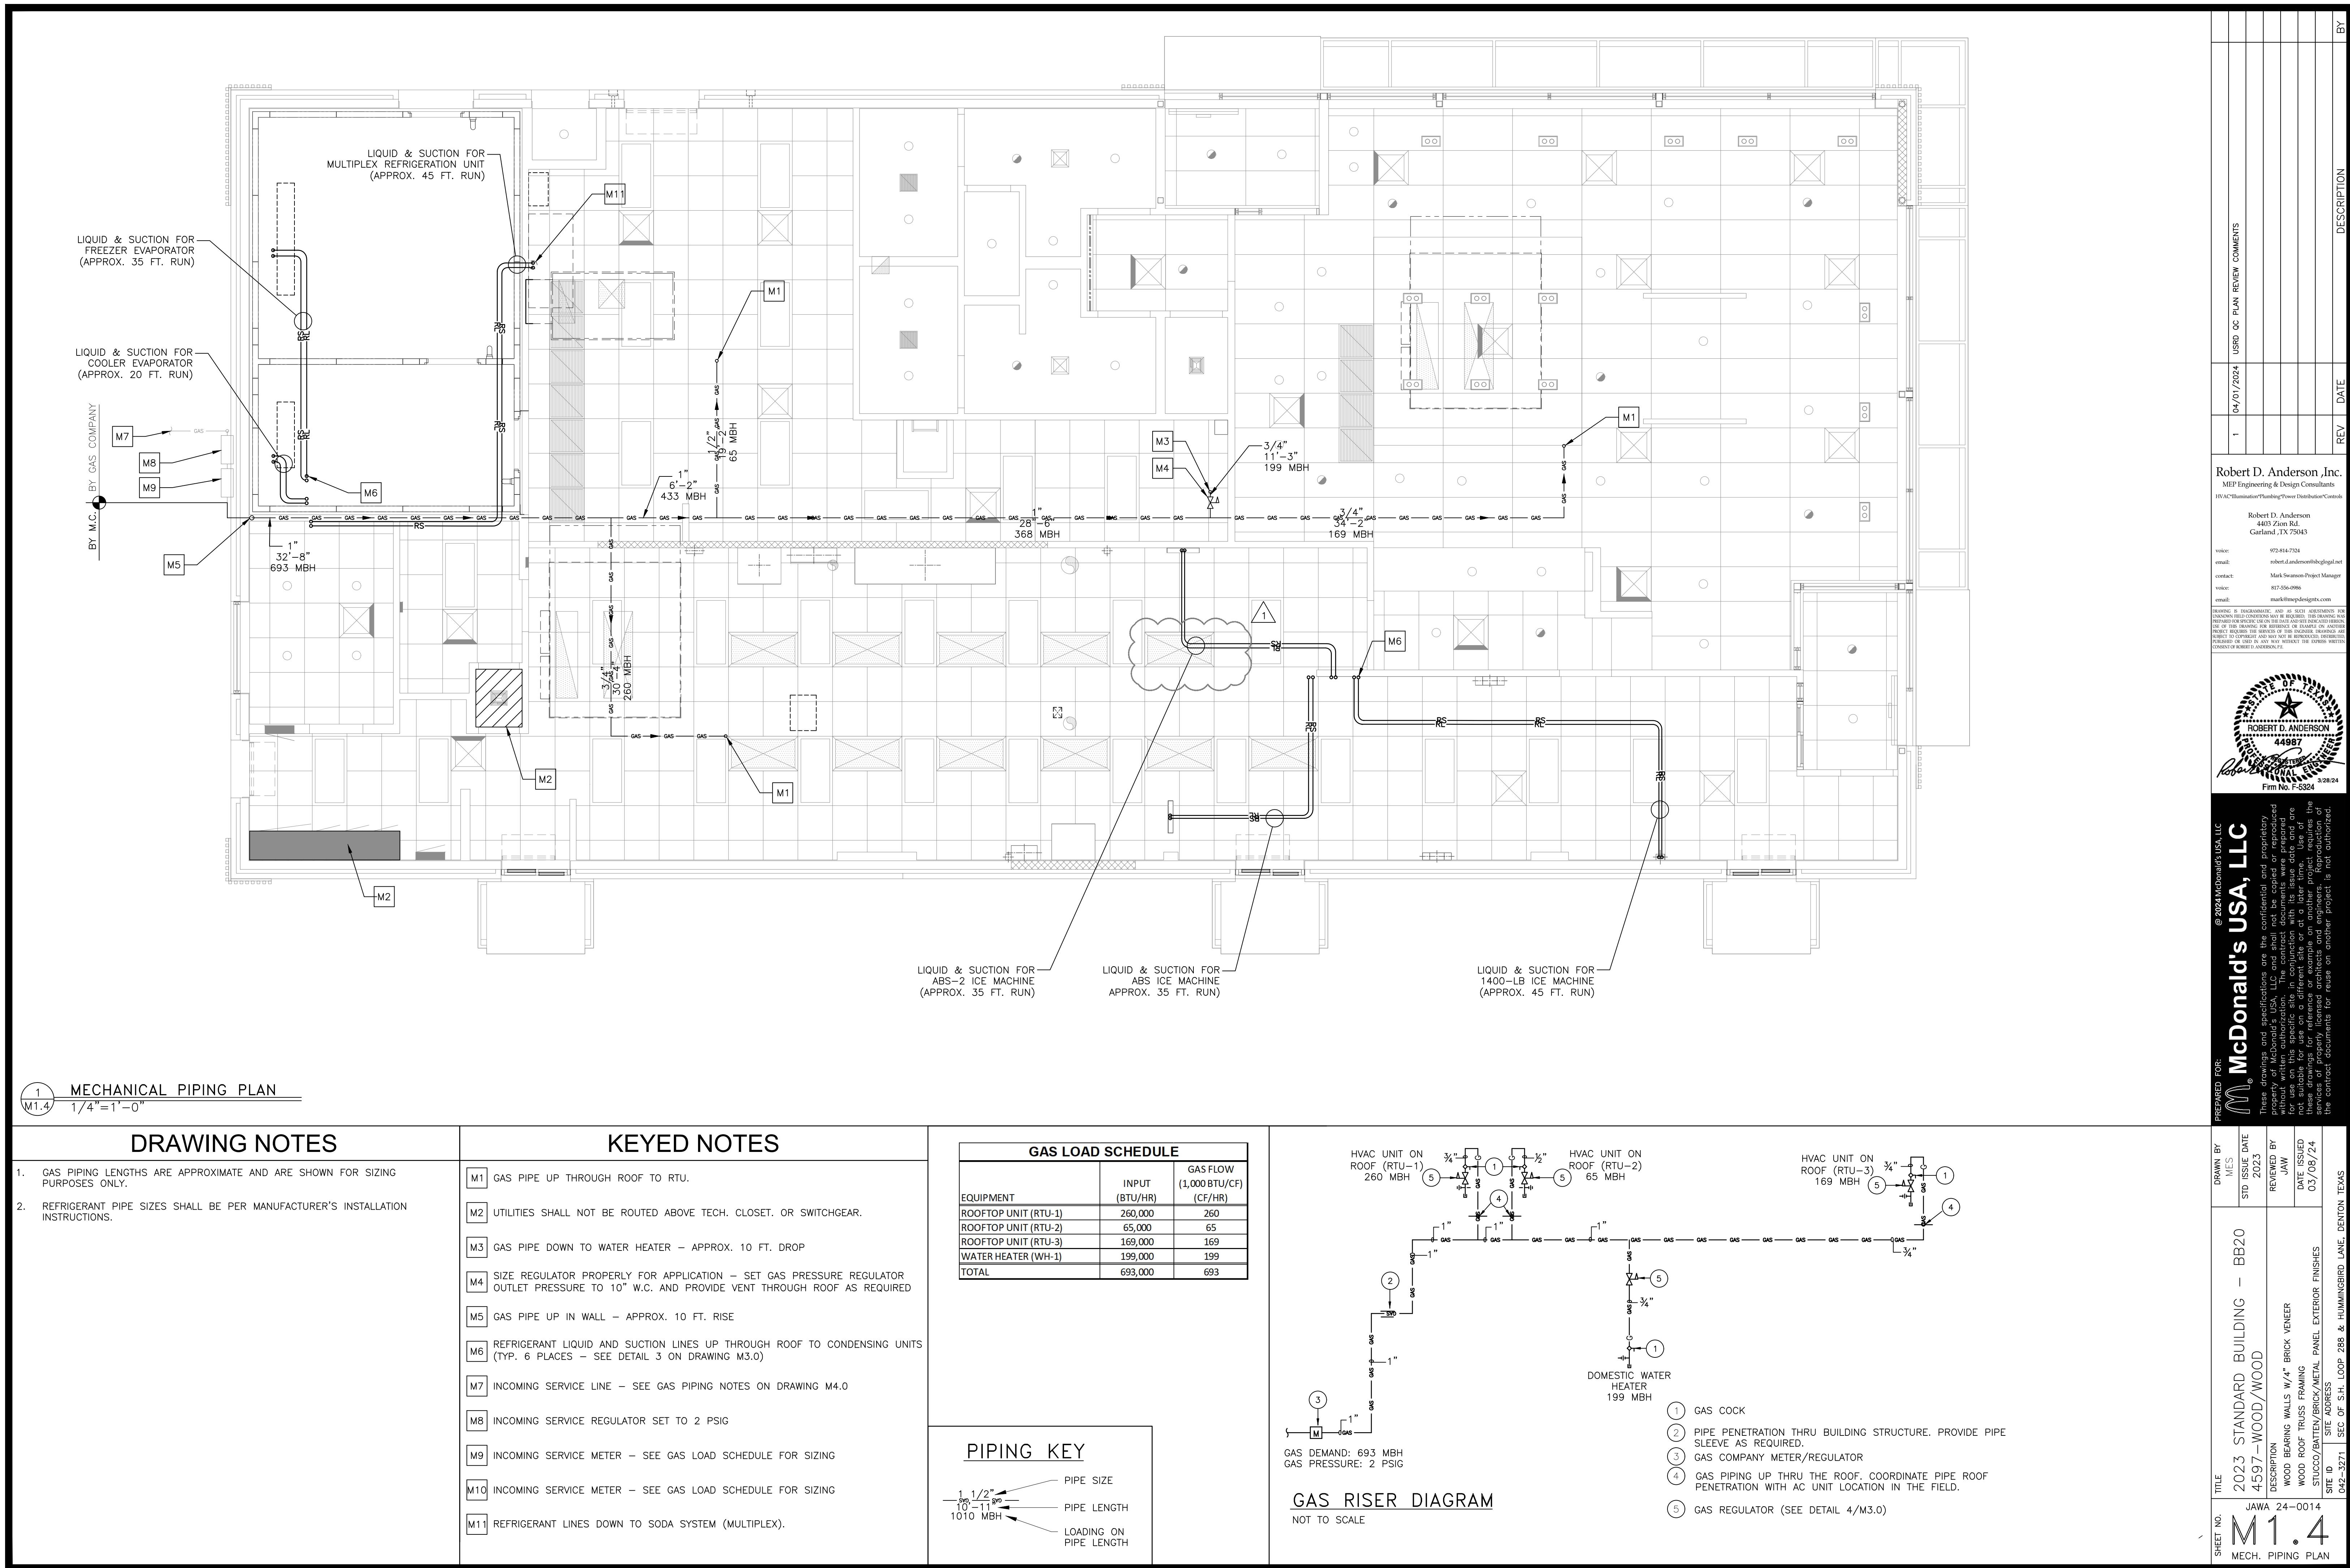

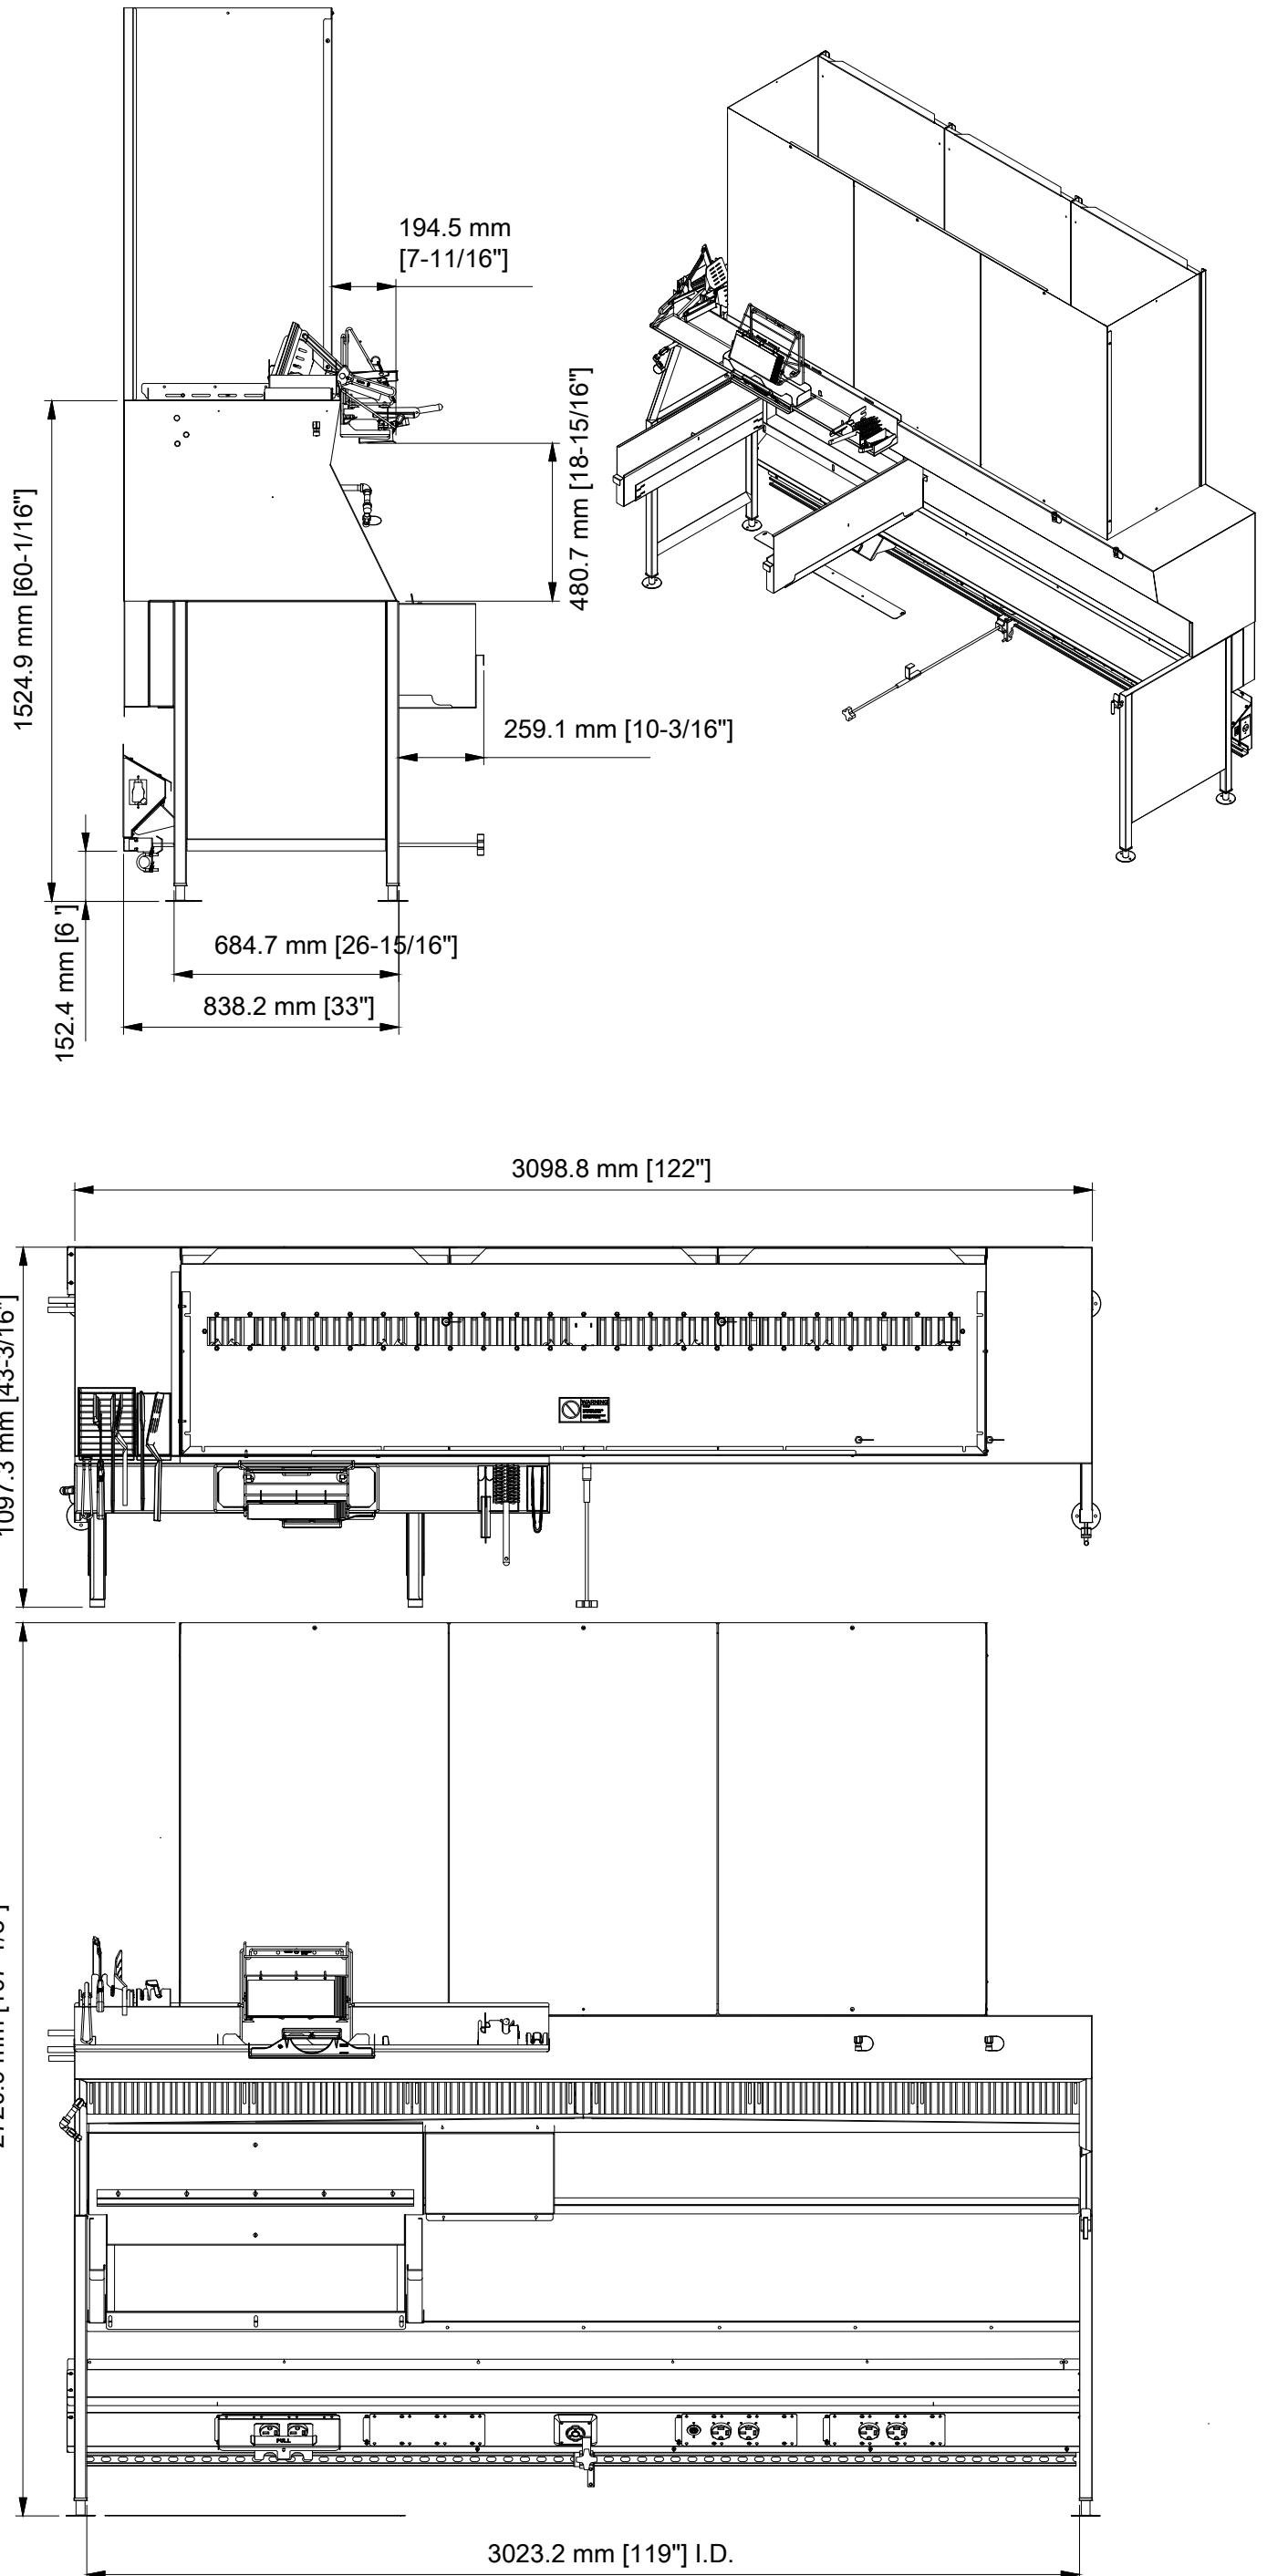


KITCHEN EXHAUST HOOD

TAG: KH-1 (SEE KITCHEN EXHAUST HOOD SCHEDULE)
SCALE: $\frac{1}{2}''=1'-0''$

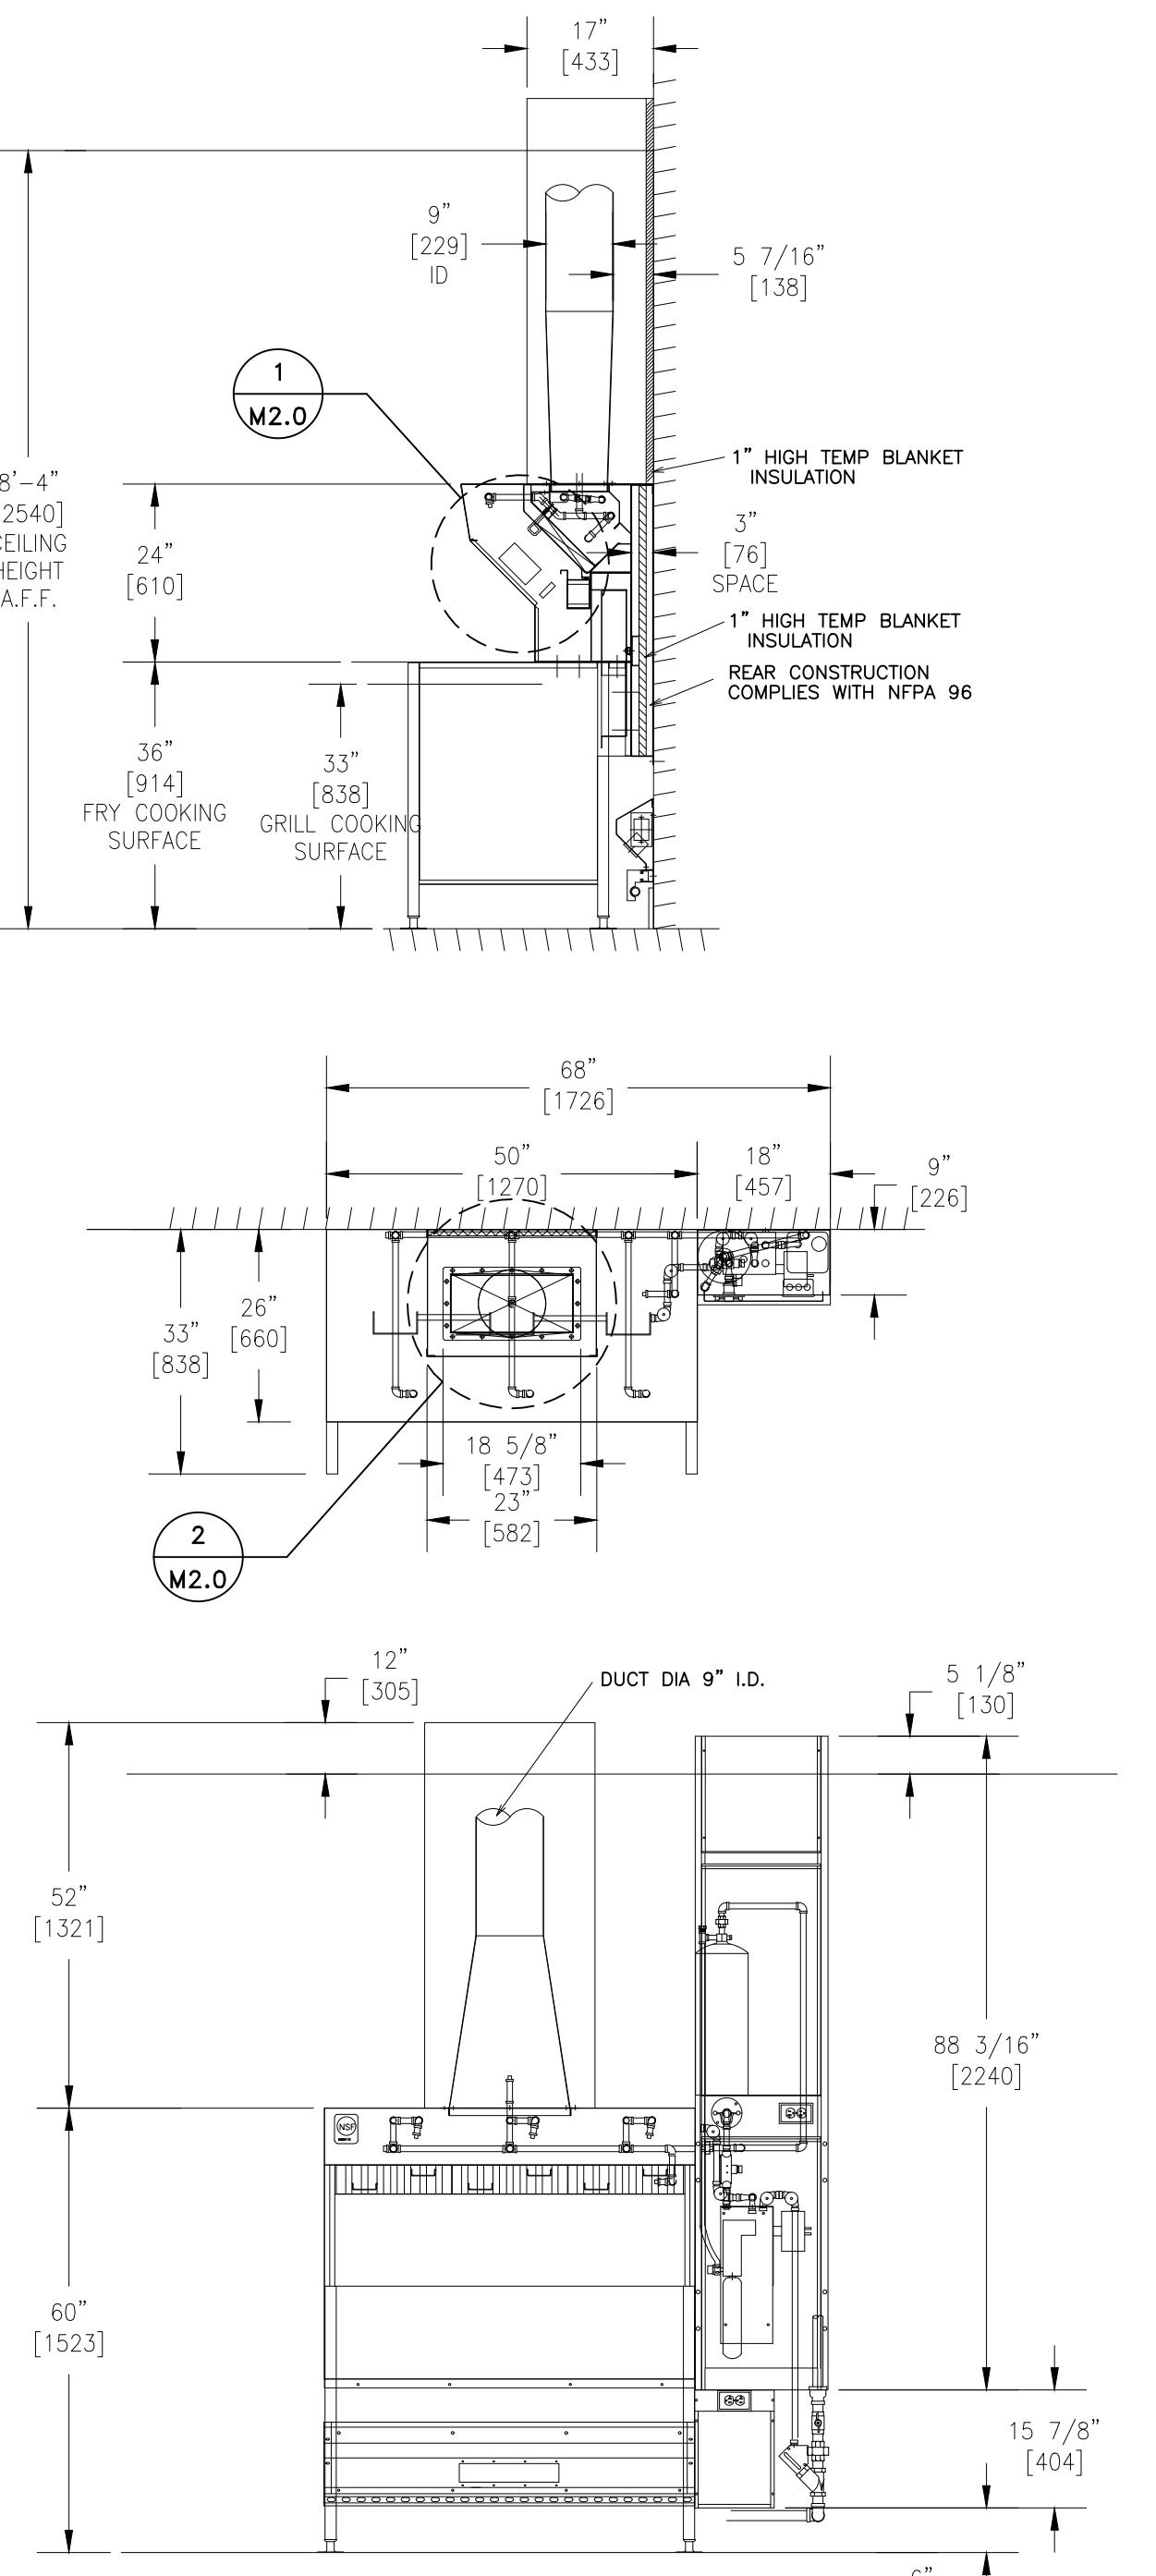

KITCHEN EXHAUST HOOD

TAG: KH-2 (SEE KITCHEN EXHAUST HOOD SCHEDULE)
SCALE: $\frac{1}{2}''=1'-0''$

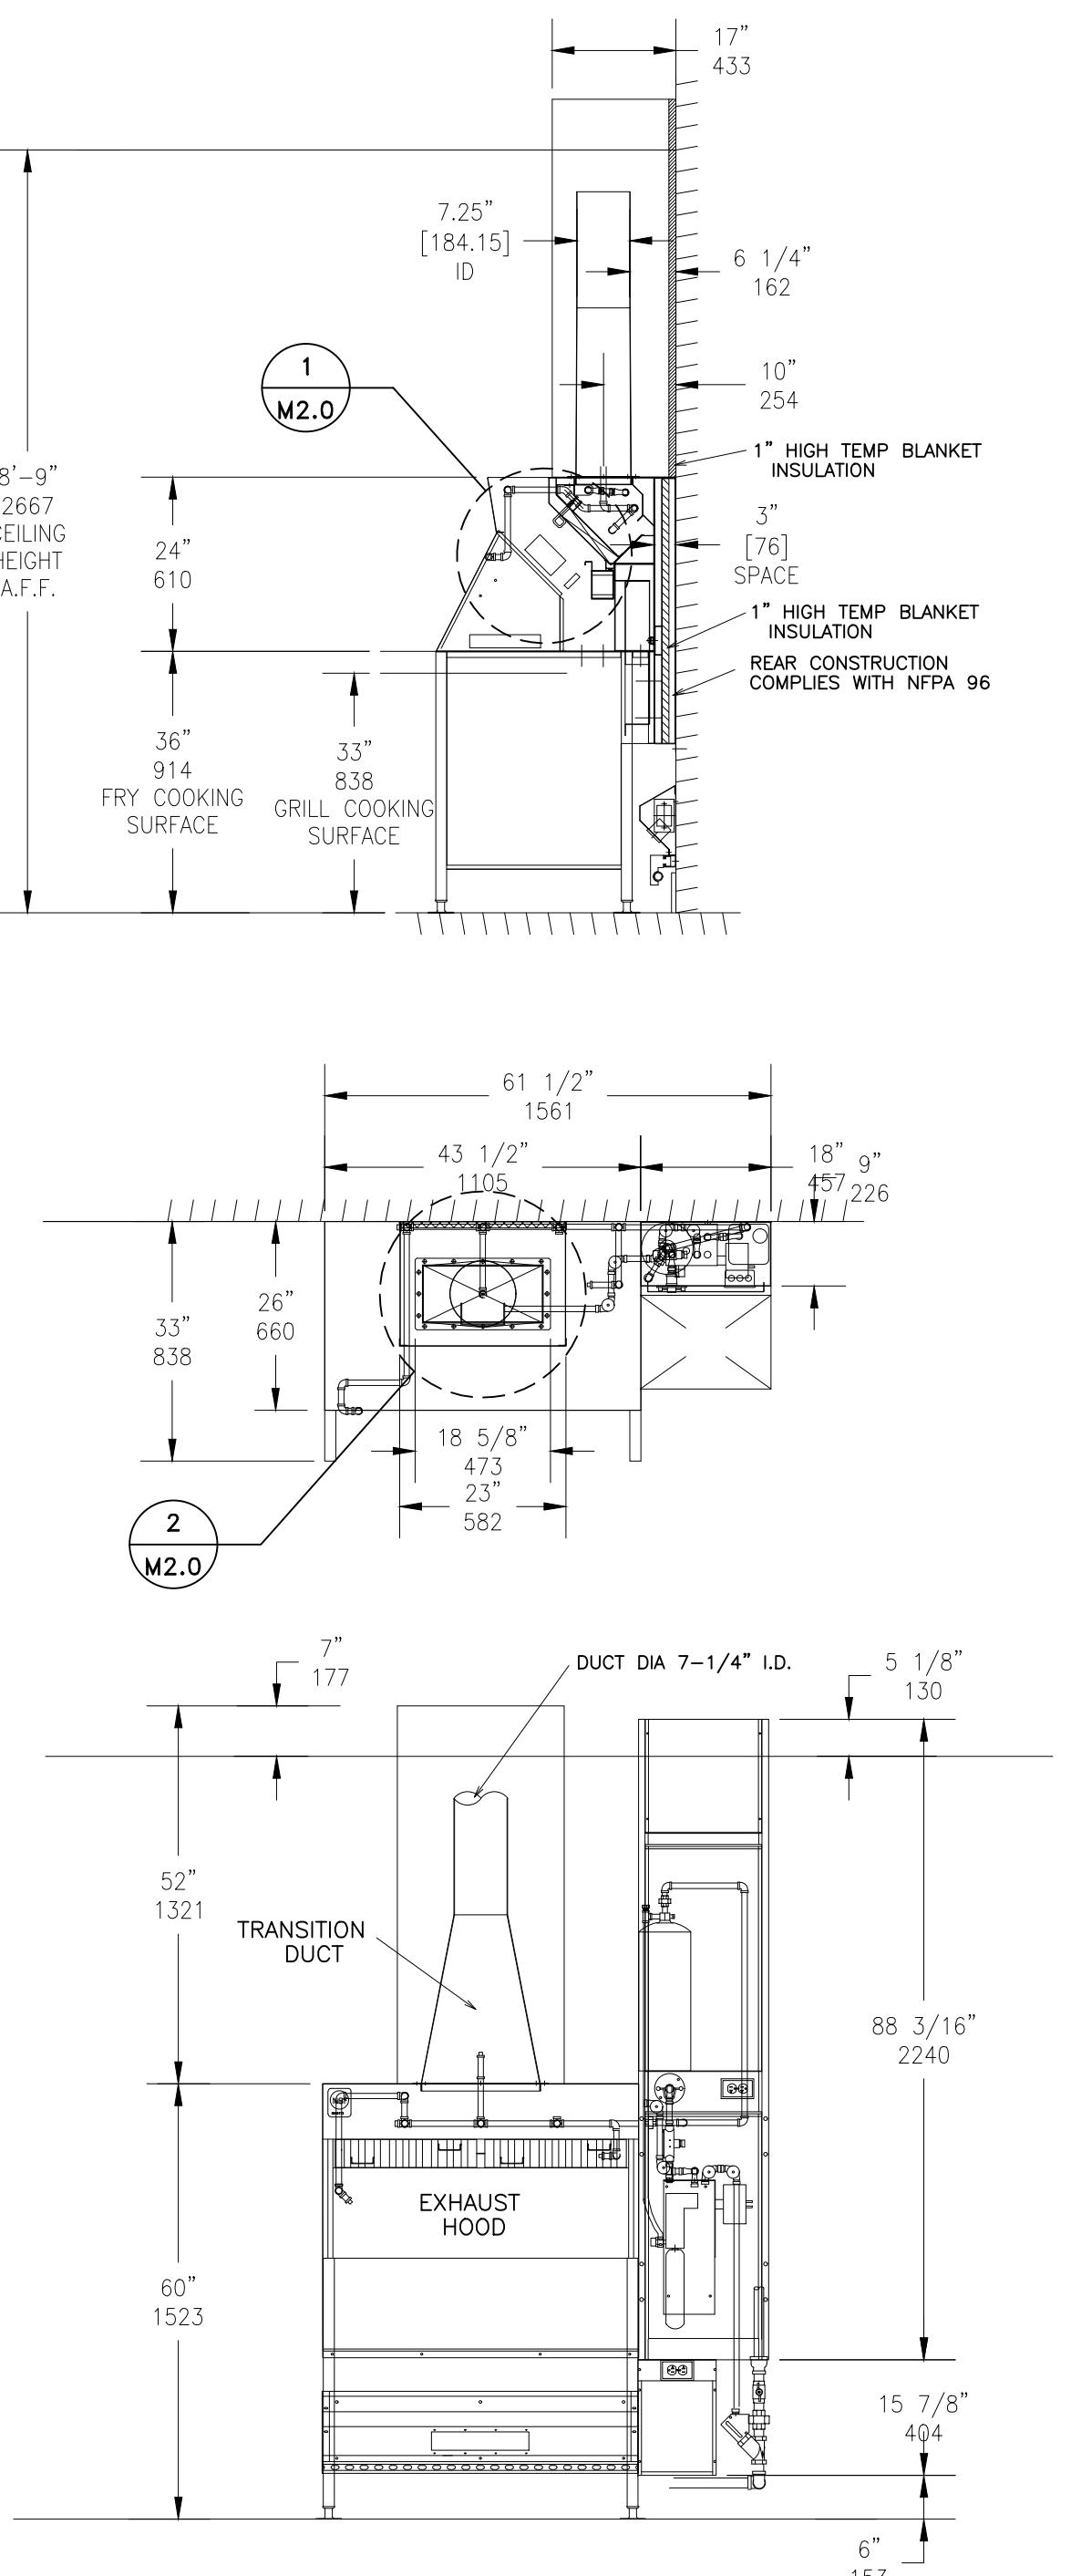

KITCHEN EXHAUST HOOD

TAG: KH-3 (SEE KITCHEN EXHAUST HOOD SCHEDULE)
SCALE: $\frac{1}{2}''=1'-0''$


McDONALD'S CORPORATION	
OAK BROOK, ILLINOIS 60521	
EQUIP. ID.	EXHAUST HOOD: UH SERIES
MANUF. ID.	RKD
MANUF. EQUIP. ID.	UH500808
SERIAL # 5512341	
MFG DATE 05/03/17	
LENGTH OF HOOD	MINIMUM DESIGN SURFACE AREA, CUBIC FT/HOUR, CUBIC FT/HOUR OF HOOD LENGTH W/DUCT
26' (88)	128 (12)
34.5' (88)	143 (13.3)
36-1/2' (88-310)	168 (15.5)
39.75' (89.7)	151 (14.0)
43.75' (93.7)	132 (12.3)

FOR USE OVER COMMERCIAL GAS OR ELECTRIC COOKING EQUIPMENT UP TO 400°F (204°C)
(EXCEPT UPPER PLATE OF 2-SIDED COOKER MAY BE UP TO 425°F (210°C)).
-2' (609mm) MAXIMUM CLEARANCE FROM COOKING SURFACE TO FRONT LOWER EDGE OF HOOD.
-16' (488mm) MINIMUM CLEARANCE FROM COOKING SURFACE TO FRONT LOWER EDGE OF HOOD.
-24" (610mm) MINIMUM SIDE HOOD OVERHAND FROM EDGE OF COOKING SURFACE.
-16" (412mm) MAXIMUM FRONT HOOD SETBACK FROM EDGE OF COOKING SURFACE.
-THESE HOODS ARE LISTED FOR DIRECT REAR MOUNTING ON A COMBUSTIBLE SURFACE.
-HOODS MAY BE INSTALLED WITH DUCTS OR ESP DIRECTLY ON TOP OF HOOD ASSEMBLY.
-HOODS CAN BE OPERATED UNDER THE HOOD, AN EXTENSION SIDE PANEL (REMOVABLE OR INTEGRAL) MUST BE MOUNTED AT WHOMEVER END(S) OF HOOD IS ADJACENT TO THE WALL(S).
-THESE HOODS ARE LISTED FOR USE OVER COMMERCIAL GAS OR ELECTRIC COOKING EQUIPMENT TESTED TO UL 106 STANDARDS.
-FOR USE w/GARLAND MODEL MEWE GRILL OR USE w/TAYLOR MODEL CR42 GRILL.
-ONLY THE REMOVABLE SIDESKIRTS WILL BE INDIVIDUALLY MARKED AS FOLLOWS: UH 500808.
-THESE HOODS ARE LISTED FOR COMPLIANCE WITH IBC, BOCA, AND SBCCI PER NFPA 5000.
-THESE HOODS MUST BE INSTALLED PER NFPA 26.

Intertek 4001095

DETAIL

UL LABEL
SCALE: NONE

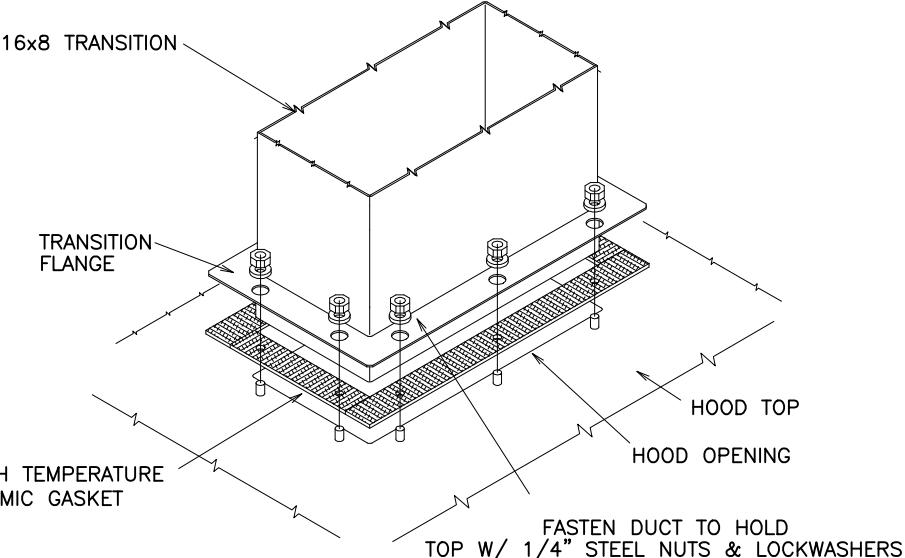

DETAIL

HOOD CONNECTION
SCALE: NONE

© 2024 McDonald's USA, LLC

McDonald's USA, LLC

These drawings and specifications are the confidential and proprietary property of McDonald's USA, LLC and shall not be copied or reproduced without the express written consent of McDonald's USA, LLC. These drawings and specifications are intended for specific use on the date and at the location indicated herein. They are not to be used for any other purpose. Any unauthorized use of these drawings and specifications may result in criminal and civil liability. No part of these drawings and specifications may be sold or otherwise distributed without the express written consent of McDonald's USA, LLC.

JAWA 24-0014
M2.0
EXHAUST HOODS

Robert D. Anderson, Inc.
MEP Engineering & Design Consultants
HVAC Illumination Plumbing Power Distribution Control
Robert D. Anderson
4403 Zinn Rd.
Garland, TX 75043
voice: 972-447-7024
email: robert.anderson@bigslegal.net
contact: Mark Swanson Project Manager
voice: 817-556-0986
email: mark@markswandersigns.com

DRAWING IS DIAGRAMATIC AND AS SUCH ADJUSTMENTS FOR EXACT CONSTRUCTION ARE THE RESPONSIBILITY OF THE CONTRACTOR. PREPARED FOR SPECIFIC USE ON THE DATE AND AT THE LOCATION INDICATED HEREIN. THESE DRAWINGS ARE THE PROPERTY OF THE CONTRACTOR. THIS PROJECT REQUIRES THE SERVICES OF THIS ENGINEER. DRAWINGS ARE NOT TO BE COPIED OR USED IN ANY WAY WITHOUT THE EXPRESS WRITTEN CONSENT OF THE CONTRACTOR.


ROBERT D. ANDERSON
4493
Firm No.: 5324
2/26/24

REV	DATE	DESCRIPTION

SHEET NO.	TITLE	DRAWN BY	REVIEWED BY	APPROVED BY
	2023 STANDARD BUILDING - BB20	MES	JAW	JAW
	4597-WOOD/WOOD	STD ISSUE DATE 2023	DATE ISSUED 03/08/24	
	DESCRIPTION WOOD BEARING WALLS W/4" BRICK VENEER			
	STUCCO/BATEN/BRICK/METAL PANEL EXTERIOR FINISHES			
SITE ID	SITE ADDRESS 288 & HUMMINGBIRD LANE, DENTON, TEXAS			
042-3271	SEC OF S.H. LOOP			

DRAWING NOTES

1. 16 GA. STAINLESS STEEL MATERIAL USED FOR HOOD CONSTRUCTION
2. FILTER BAFFLE:
UL FILE R14372, VOL. 1, SEC. 1
UL CONTROL NUMBER 5L65
MEA-446-92-M
3. EXHAUST HOOD:
UL FILE MH12755, VOL. 4
UL CONTROL NUMBER 78L1
4. UTILITY CHASE AND RACEWAY:
UL FILE E163328, VOL. 1, SEC.3
5. HIGH TEMP GASKET:
UL FILE MH12755, VOL. 2, SEC. 1, ILL. 710
6. HOOD CONSTRUCTION COMPLIES WITH NSF STANDARD 2
7. HOOD PERFORMANCE TESTED IN ACCORDANCE WITH UL 710
8. UL 300 AND NFPA 17A COMPLIANT R-102 WET CHEMICAL SYSTEM INCLUDED WITH HOOD INSTALLATION
9. ANSUL CONNECTIONS AND STARTUP BY APPROVED ANSUL REPRESENTATIVE
10. REFER E3.2 FOR HOOD/FAN INTERLOCK DETAILS
11. CAPTURE JET PLenums ARE TO BE ATTACHED WHEN CALLED OUT PER KITCHEN SCHEDULE.

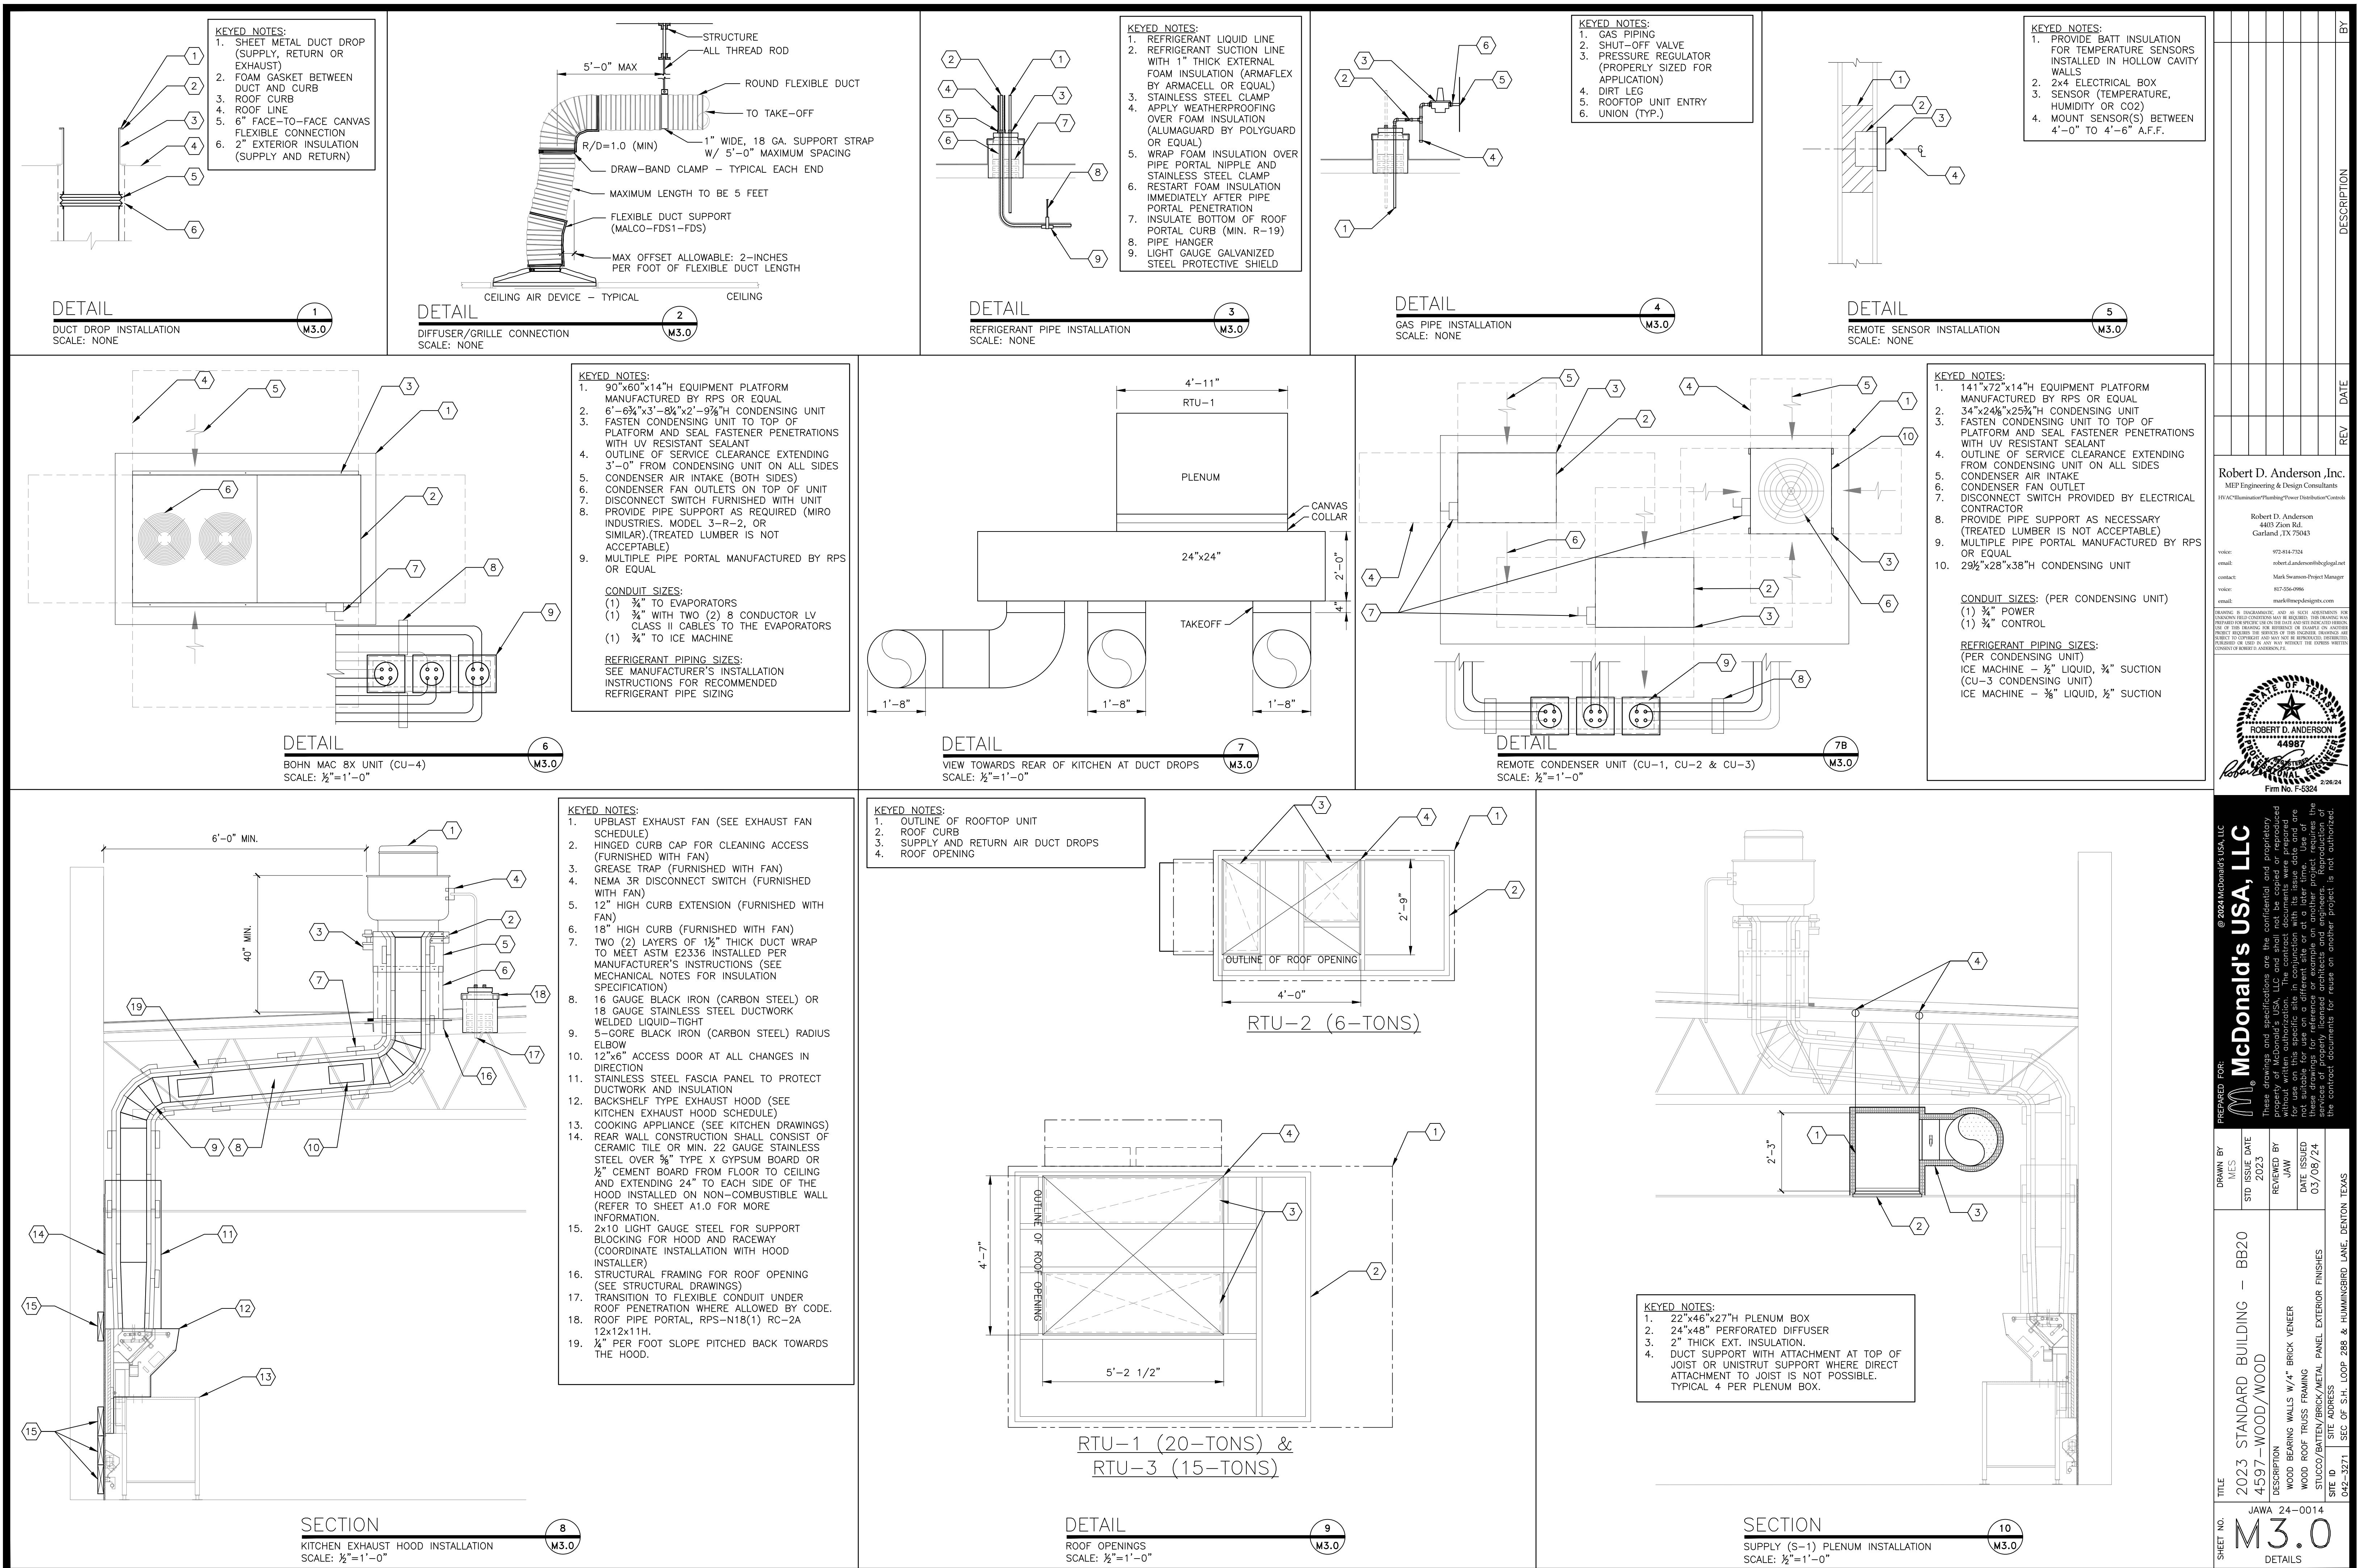

MECHANICAL NOTES

- GENERAL:**
- ALL WORK PERFORMED SHALL BE IN ACCORDANCE WITH ALL LOCAL CODES AND ACCEPTABLE TO THE AUTHORITY HAVING JURISDICTION.
 - ALL DIMENSIONS, CLEARANCES AND TOLERANCES SHALL BE VERIFIED PRIOR TO INSTALLATION.
 - ALL MATERIALS, FIXTURES AND EQUIPMENT USED SHALL BE IN ACCORDANCE WITH McDONALD'S SPECIFICATIONS. SPECIFICATIONS ARE CONTAINED WITHIN THESE DRAWINGS AND THE McDONALD'S PROJECT MANUAL. ANY CONTRACTOR IN NEED OF A COPY OF THE McDONALD'S PROJECT MANUAL SHALL CONTACT THE McDONALD'S AREA CONSTRUCTION MANAGER. ANY VARIANCE FROM THE McDONALD'S SPECIFICATIONS SHALL BE REVIEWED AND APPROVED BY THE ENGINEER-OF-RECORD.
 - ALL EQUIPMENT SHALL BE INSTALLED IN ACCORDANCE WITH ITS LISTING AND/OR THE MANUFACTURER'S INSTALLATION INSTRUCTIONS.
 - SEE COORDINATION SCHEDULE FOR ADDITIONAL SCOPE OF WORK.
 - PRIOR TO BUILDING TURNOVER, A COMPLETE START-UP, TEST, ADJUST AND BALANCE SHALL BE PERFORMED ON ALL MECHANICAL SYSTEMS. THIS WORK SHALL BE PERFORMED BY A CERTIFIED TEST AND BALANCE CONTRACTOR. A CERTIFIED TEST AND BALANCE CONTRACTOR CAN BE FOUND BY VISITING:
[HTTP://WWW.AABCQQ.COM/DIRECTORY](http://WWW.AABCQQ.COM/DIRECTORY)
[HTTP://WWW.NEBC.ORG/DIRECTORY.HTM](http://WWW.NEBC.ORG/DIRECTORY.HTM)
[HTTP://WWW.TABBCERTIFIED.ORG/SITE/CONTENT/CONTRACTORS/SEARCH](http://WWW.TABBCERTIFIED.ORG/SITE/CONTENT/CONTRACTORS/SEARCH)
 - UPON COMPLETION OF THE PUNCHLIST, THE MECHANICAL CONTRACTOR AND TEST AND BALANCE CONTRACTOR SHALL SUBMIT REDLINE OR AS-BUILT DRAWINGS ALONG WITH THE TEST AND BALANCE REPORT AND ALL EQUIPMENT OPERATION AND MAINTENANCE MANUALS TO THE McDONALD'S AREA CONSTRUCTION MANAGER. A MINIMUM OF TWO (2) COPIES SHALL BE PROVIDED, ONE (1) FOR REGIONAL RECORDS AND ONE (1) FOR THE RESTAURANT.
 - ALL PENETRATIONS OF FIRE-RATED WALLS SHALL BE FIRESTOPPED WITH AN APPROVED AND LISTED FIRESTOPPING SYSTEM.

VENTILATION SYSTEMS:

 - ALL SHEET METAL DUCTWORK SHALL BE FABRICATED AND INSTALLED IN ACCORDANCE WITH LOCAL CODES AND SMACNA STANDARDS.
 - ALL DUCTWORK DIMENSIONS ARE INTERNAL FREE AREA DIMENSIONS AND SIZED FOR 0.08" W.C. PER 100 FT. OF DUCT.
 - ALL SHEET METAL DUCTWORK SHALL BE CONSTRUCTED IN ACCORDANCE WITH SMACNA TABLES FOR 2" W.C. AND SHALL BE SUPPORTED WITH AN APPROVED HANGER AT INTERVALS NOT EXCEEDING 10 FT.
 - ALL DUCT DROPS INTO THE BUILDING SHALL BE INSTALLED WITH FLEXIBLE CONNECTIONS TO ISOLATE THE DUCTWORK SYSTEM FROM NOISE AND VIBRATION. FLEXIBLE CONNECTIONS SHALL BE TESTED IN ACCORDANCE WITH UL 181 AND LISTED AS CLASS 0 OR CLASS 1.
 - ALL DUCT DROPS INTO THE BUILDING SHALL BE OFFSET AS NECESSARY TO ALLOW FOR THE CLEAN INSTALLATION OF THE EXTERNAL DUCTWORK INSULATION.
 - ALL DUCTWORK BRANCHES THAT SERVE A SINGLE DIFFUSER SHALL BE SUPPLIED WITH A VOLUME DAMPER FOR BALANCING. BRANCHES THAT SERVE MULTIPLE DIFFUSERS, THE BALANCING IS HANDLED VIA REMOTE DAMPER INSTALLED NEAR THE DIFFUSER. REFER TO MT.2 FOR DAMPER LOCATIONS. VOLUME DAMPER SHALL HAVE A 2" OFFSET TO ACCOMMODATE EXTERNAL INSULATION.
 - TAKE-OFFS FROM RECTANGULAR TO ROUND DUCT SHALL BE DUCTMATE STRAIGHT-SIDED OR CENTER HIGH-EFFICIENCY TAKE-OFFS WITH A 2" DAMPER STAND-OFF TO ACCOMMODATE FOR EXTERNAL INSULATION.
 - ALL DUCTWORK JOINTS, LONGITUDINAL AND TRANSVERSE SEAMS SHALL BE SEALED WITH WELDS, GASKETS, MASTICS (ADHESIVES), TAPES, ETC. ALL SEALANT MATERIALS SHALL BE LISTED IN ACCORDANCE WITH UL 181A OR 181B.
 - ALL SUPPLY AND RETURN SHEET METAL DUCTWORK LOCATED WITHIN THE CEILING SPACE SHALL BE INTERNALLY INSULATED. INSULATION SHALL BE 2" THICK MICROLITE FSK-100 BY JOHNS MANVILLE OR EQUAL.
 - ALL SUPPLY AND RETURN SHEET METAL DUCTWORK LOCATED OUTSIDE OF THE BUILDING SHALL BE INTERNALLY LINED WITH A 1" THICK FIBERGLASS (MIN. R-4.2) AND EXTERNALLY INSULATED WITH A 2" THICK RIGID POLYSTYRENE, POLYURETHANE OR POLYISOCYANURATE BOARD (MIN. R-8 FOR CLIMATE ZONES 1 THROUGH 4, OR A 3" THICK (MIN. R-12 FOR CLIMATE ZONES 5 THROUGH 8). INTERNAL FIBERGLASS INSULATION SHALL BE LINATEX BY JOHNS MANVILLE OR EQUAL. EXTERNAL RIGID BOARD INSULATION SHALL BE THERMAPINK BY OWENS CORNING OR EQUAL.
 - FOR APPLICABLE SITUATIONS OR PLAYPLACE ADDITIONS: ALL EXPOSED SPIRAL DUCTWORK SHALL BE INTERNALLY INSULATED TO PREVENT CONDENSATION (MIN. R-4.3). INTERNAL INSULATION SHALL BE 1" THICK SPIRALOCUT PLUS BY JOHNS MANVILLE OR EQUAL.
 - ALL DUCTWORK PENETRATIONS THROUGH FIRE-RATED WALLS, BARRIERS OR PARTITIONS SHALL BE PROTECTED WITH A FIRE DAMPER. THE PERIMETER OF THE FIRE DAMPER SHALL BE FIRESTOPPED WITH AN APPROVED AND LISTED FIRESTOPPING MATERIAL.
 - ALL EXTERIOR SHEET METAL DUCTWORK SHALL BE EXTERNALLY WRAPPED WITH AN APPROVED WEATHERPROOFING MATERIAL TO PROTECT AGAINST WATER PENETRATION AND CORROSION. SIDES AND TOP OF EXTERNAL WEATHERPROOFING SHALL BE ALUMAGUARD 60 MIL UV BARRIER BY POLYGUARD OR EQUAL. BOTTOM OF EXTERNAL WEATHERPROOFING SHALL BE VAPORGUARD 5 MIL MEMBRANE BY POLYGUARD OR EQUAL.
 - ALL FLEXIBLE DUCTWORK, METALLIC AND NONMETALLIC, SHALL CONFORM TO THE FOLLOWING:
 A. 2" THICK INSULATION (R-6.0) SEE NOTE #9 AND TABLE(S) BELOW:

DUCT LOCATION: UNCONDITIONED SPACE	CLIMATE ZONES 1 THROUGH 8		
DUCTWORK CLASSIFICATION	PRESSURE	SEAL CLASS	INSULATION
SUPPLY	2.00" W.C.	A	TYPE A (R-6)
RETURN	-2.00" W.C.	A	TYPE A (R-6)
EXHAUST	-2.00" W.C.	A	(*)TYPE A (R-6)
HANGER SUPPORTS	EVERY 6 FT.		1" TYPE B

DUCT LOCATION: EXTERIOR (INCLUDES ATTICS ABOVE INSULATED CEILINGS AND CRAWL SPACES.)	CLIMATE ZONES 1 THROUGH 4	CLIMATE ZONES 5 THROUGH 8	
DUCTWORK CLASSIFICATION	PRESSURE	SEAL CLASS	INSULATION
SUPPLY	2.00" W.C.	A	TYPE A (R-8)
RETURN	-2.00" W.C.	A	TYPE A (R-8)
EXHAUST	-2.00" W.C.	A	(*)TYPE A (R-8)
HANGER SUPPORTS	EVERY 6 FT.		1" TYPE B

(*) EXHAUST DUCTWORK IS ONLY REQUIRED TO BE INSULATED WITHIN 2-FEET OF ROOF PENETRATION. REFER TO "COMMERCIAL KITCHEN EXHAUST SYSTEMS". NOTE #4 FOR FIRE WRAPPING REQUIREMENTS ON KITCHEN GREASE DUCTWORK.

B. INTEGRAL VAPOR BARRIER
 C. LISTED AND LABELED UL 181, CLASS 0 OR CLASS 1
 D. INSTALLED IN ACCORDANCE WITH:
 i. SMACNA STANDARDS
 ii. AIR DIFFUSION COUNCIL INSTALLATION GUIDELINES, AND/OR
 iii. MANUFACTURER'S INSTALLATION INSTRUCTIONS

14. FLEXIBLE DUCTWORK SHALL NOT PENETRATE WALLS. SHEET METAL DUCTWORK IS REQUIRED AT ALL FIRE-RATED AND DRAFTSTOP WALL PENETRATIONS.

- ALL COVERINGS, LININGS AND ADHESIVES (TAPES, ETC.) SHALL HAVE A FLAME-Spread INDEX NOT GREATER THAN 25 AND A SMOKE-DEVELOPED INDEX NOT GREATER THAN 50.
- DUCT-MOUNTED SMOKE DETECTORS, PROVIDED BY ROOFTOP UNIT MANUFACTURER, SHALL BE INSTALLED IN SYSTEMS WITH DESIGN CAPACITY GREATER THAN 2,000 CFM. SEE MECHANICAL DRAWINGS FOR LOCATIONS OF SMOKE DETECTORS. DUCT-MOUNTED SMOKE DETECTORS ARE NOT REQUIRED WHEN THE BUILDING IS PROTECTED THROUGHOUT BY AREA SMOKE DETECTORS CONNECTED TO A FIRE ALARM SYSTEM WHERE THE FIRE ALARM SYSTEM IS DESIGNED TO SHUT DOWN THE ROOFTOP UNITS.
- ALL SUPPLY AIR DIFFUSERS SHALL BE INSULATED TO PREVENT CONDENSATION.
- ALL AIR DEVICES LOCATED IN DRYWALL CEILINGS SHALL BE SUPPLIED WITH AN INTEGRAL VOLUME DAMPER ACCESSIBLE FROM THE AIR DEVICE FACE TO FACILITATE BALANCING.
- ALL OUTDOOR AIR INTAKES SHALL BE LOCATED A MINIMUM OF 10 FT. HORIZONTALLY FROM ANY SOURCE OF CONTAMINATION SUCH AS EXHAUST FANS, PLUMBING VENTS, WATER HEATER FLUES, ETC. WHERE A CONTAMINANT SOURCE IS LOCATED WITHIN 10 FT. OF AN INTAKE, THE INTAKE OPENING SHALL BE LOCATED A MINIMUM OF 2 FT. BELOW THE CONTAMINANT SOURCE.
- ALL ROOFTOP CONDENSING UNITS THAT DISCHARGE HORIZONTALLY SHALL BE ORIENTED SUCH THAT THE DISCHARGE DOES NOT BLOW IN THE DIRECTION OF AN OUTDOOR AIR INTAKE.

COMMERCIAL KITCHEN EXHAUST SYSTEMS:

 - ALL METAL DUCTWORK USED FOR THE CONVEYANCE OF GREASE-LADEN AIR SHALL BE CONSTRUCTED OF MINIMUM 18 GAUGE STAINLESS STEEL OR 16 GAUGE CARBON STEEL (BLACK IRON).
 - ALL GREASE EXHAUST DUCTWORK JOINTS SHALL BE EITHER TELESCOPING OR BELL TYPE. BUTT-WELDED JOINTS ARE PROHIBITED.
 - ALL GREASE EXHAUST DUCTWORK SEAMS AND JOINTS SHALL BE CONTINUOUSLY WELDED WATER-TIGHT ON THE EXTERNAL SURFACE OF THE DUCT SYSTEM. ALL WELDING SHALL BE PERFORMED BY A CERTIFIED WELDER.
 - ALL GREASE EXHAUST DUCTWORK SHALL BE EXTERNALLY INSULATED WITH A ASTM E2336 LISTED AND LABELED GREASE DUCT ENCLOSURE SYSTEM. INSULATION SHALL BE INSTALLED IN ACCORDANCE WITH ITS LISTING AND THE MANUFACTURER'S INSTALLATION INSTRUCTIONS.
 - ACCESS PANELS SHALL BE PROVIDED AT ALL CHANGES IN DIRECTION OF THE GREASE EXHAUST DUCTWORK SYSTEM. ACCESS PANELS SHALL BE INSTALLED IN ACCORDANCE WITH THE INSULATION MANUFACTURER'S INSTALLATION INSTRUCTIONS AND SHALL BE LABELED AS FOLLOWS: "ACCESS PANEL - DO NOT OBSTRUCT".
 - ALL HORIZONTAL GREASE EXHAUST DUCTWORK SHALL BE INSTALLED WITH A MINIMUM $\frac{1}{4}$ " PER FOOT SLOPE AND SHALL BE PITCHED BACK TOWARD THE HOOD.
 - UPBLAST KITCHEN EXHAUST FANS SHALL BE LOCATED A MINIMUM OF 6 FT. FROM ANY PARAPET WALL OR ADJACENT STRUCTURE AND SHALL TERMINATE A MINIMUM OF 40 INCHES ABOVE THE FINISHED ROOFING MATERIAL.

REFRIGERANT PIPING:

 - ALL REFRIGERATION WORK SHALL BE PERFORMED BY A CERTIFIED REFRIGERATION CONTRACTOR.
 - ALL REFRIGERANT PIPING SHALL BE SEAMLESS COPPER TUBING OF TYPE L IN ACCORDANCE WITH ASTM B 88 AND ALL JOINTS SHALL BE SOLDERED.
 - ALL REFRIGERATOR SUCTION LINES SHALL BE INSULATED WITH A MINIMUM 1" FOAM PIPE INSULATION. PIPE INSULATION INSTALLED OUTDOORS SHALL BE PROTECTED WITH AN APPROVED WEATHERPROOFING MATERIAL.
 - ALL SUSPENDED REFRIGERANT PIPING SHALL BE SUPPORTED AS FOLLOWS:

MATERIAL	MAX. HORIZ. SPACING	MAX. VERT. SPACING
COPPER TUBING $\leq \frac{1}{4}$ "	6 FT.	10 FT.
COPPER TUBING $\geq \frac{1}{2}$ "	10 FT.	10 FT.
 - ALL REFRIGERANT PIPING SHALL BE SIZED PER EQUIPMENT MANUFACTURER'S RECOMMENDATIONS.
 - PRE-CHARGED LINESETS ARE NOT PERMITTED AS LINES WILL MOST LIKELY NEED TO BE CUT TO FIT THE APPLICATION AND REFRIGERANT WILL NEED TO BE RECLAIMED.
 - ALL PIPE INSULATION SHALL BE PROTECTED FROM DAMAGE FROM PIPE HANGERS. PROTECTION SHALL BE LIGHT GAUGE GALVANIZED STEEL OR EQUAL.
 - ALL REFRIGERANT PIPING SYSTEMS SHALL BE PRESSURE TESTED FOR LEAKS PRIOR TO START-UP. ALL LEAKS SHALL BE REMEDIED PRIOR TO BUILDING TURNOVER.
 - ALL PIPING SHALL MEET MINIMUM INSULATION THICKNESS PER THE TABLE BELOW:

PIPING	MINIMUM INSULATION THICKNESS (IN INCHES) PER NOMINAL PIPE OR TUBE SIZE
NOMINAL PIPE SIZE	<1 1 TO 1.5 1.5 TO <4 4 TO <8 >8
LIQUID (REFRIGERATION) (<40°F)	0.5 1.0 1.0 1.0 1.5
SUCTION (REFRIGERATION) (<40°F)	0.5 1.0 1.0 1.0 1.5

CO2 DETECTION EQUIPMENT:

 - THE CO2 DETECTOR SHALL BE HARD-WIRED TO PREVENT TAMPERING AND SHALL BE INSTALLED AT 12' A.F.F. WITHIN A 5 FT. RADIUS OF THE CO2 STORAGE TANKS.
 - ONE (1) AUDIBLE AND ONE (1) VISUAL ALARM SHALL BE INSTALLED A MINIMUM OF 7 FT. A.F.F., IN PLAIN SIGHT IN THE SAME ROOM AS THE CO2 STORAGE TANKS.
 - ONE (1) AUDIBLE AND ONE (1) VISUAL ALARM SHALL BE INSTALLED A MINIMUM OF 7 FT. A.F.F., AT THE BACK OF THE KITCHEN AND IN PLAIN SIGHT FROM THE MAIN SIDE OF THE PREP LINE.
 - THE CO2 EXTERIOR STROBE SHALL BE INSTALLED AS SHOWN ON SHEET A.2, (DETAIL 2) AND ON SHEET E.1.1. THE INSIDE AUDIBLE AND VISUAL ALARM SHALL BE INSTALLED INSIDE THE CO2 CLOSET, AND IN THE SUPPORT/BACK-OF-THE-HOUSE LOCATION AS SHOWN ON SHEETS E.1.1 AND E.3.0.

NATURAL GAS SYSTEMS:

 - ALL GAS PIPING, WATER HEATER VENTS, INTAKES AND FLUES SHALL CONFORM TO THE CURRENT VERSION OF NFPA 54, NATIONAL GAS CODE, AND ANY LOCAL CODE REQUIREMENTS.
 - THE NATURAL GAS MAIN PIPE SIZING IS BASED ON THE FOLLOWING:
 A. MINIMUM SUPPLY PRESSURE AT THE METER OF 2 PSIG
 B. 1 PSIG PRESSURE DROP FROM REGULATOR TO FARTHEST APPLIANCE
 C. 1,000 BTU PER CU. FT. OF NATURAL GAS
 - GAS PIPING RUN-OUTS TO EQUIPMENT ARE SIZED BASED ON THE FOLLOWING:
 A. SUPPLY PRESSURE AT THE REGULATOR OF 10" W.C. (2 PSIG)
 B. 0.5" W.C. PRESSURE DROP FROM REGULATOR TO FARTHEST APPLIANCE
 C. 1,000 BTU PER CU. FT. OF NATURAL GAS
 - ALL NATURAL GAS PIPE SHALL BE SCHEDULE 40 CARBON STEEL PIPE WITH MALLEABLE IRON FITTINGS AND SHALL BE COMPLY TO ONE OF THE FOLLOWING STANDARDS: ASME B36.10, 10M; ASTM A 53; OR ASTM A 106.
 - NATURAL GAS PRESSURE REGULATORS SHALL BE MAXITROL 325 SERIES OR EQUAL.

6. ALL SUSPENDED STEEL PIPING SHALL BE SUPPORTED AS FOLLOWS:		
SIZE	MAX. HORIZ. SPACING	MAX. VERT. SPACING
$\frac{1}{2}$ "	6 FT.	6 FT.
$\frac{3}{4}$ " TO 1"	8 FT.	8 FT.
$\geq \frac{1}{2}$ "	10 FT.	10 FT.

- GAS PIPING SHALL NOT PENETRATE ANY FIRE-RATED CHASE OR SHAFT, DUCTWORK OR PLENUM.
- ALL NATURAL GAS PIPING INSTALLED OUTDOORS SHALL BE COATED WITH A CORROSION RESISTANT PAINT. PAINT COLOR SHALL BE ORANGE OR YELLOW.
- ALL INTAKE AND VENT PIPING FOR SEALED-COMBUSTION WATER HEATERS SHALL BE PVC OR ABS. SHALL BE SIZED AND INSTALLED IN ACCORDANCE WITH THE MANUFACTURER'S INSTRUCTIONS AND SHALL BE INSTALLED BY THE PLUMBING CONTRACTOR.
- ALL WATER HEATER VENTS SHALL BE LOCATED A MINIMUM OF 10 FT. HORIZONTALLY FROM ANY OUTDOOR AIR INTAKE, WHERE A WATER HEATER VENT IS LOCATED WITHIN 10 FT. OF AN INTAKE, THE FLUE OR VENT SHALL TERMINATE A MINIMUM OF 2 FT. ABOVE THE INTAKE.
- UPON COMPLETION OF INSTALLATION, THE GAS PIPING SYSTEM SHALL BE PURGED OF DELETERIOUS MATERIAL AND SHALL BE PRESSURE TESTED. PRESSURE TESTING SHALL BE PERFORMED WITH THE EQUIPMENT SHUT-OFF VALVES IN THE CLOSED POSITION TO PROTECT EQUIPMENT FROM DAMAGE DUE TO EXCESSIVE PRESSURE.

- AFTER THE PRESSURE TEST HAS BEEN COMPLETED AND ANY LEAKS REMEDIED, THE INSTALLING CONTRACTOR SHALL MEASURE AND VERIFY THE FOLLOWING GAS PRESSURES WHILE EQUIPMENT IS IN OPERATION:
 A. GRILL - 6" W.C. NATURAL, 14" W.C. L.P.
 B. FRYER - 6" W.C. NATURAL, 14" W.C. L.P.
 C. WATER HEATER - 6" W.C. NATURAL, 14" W.C. L.P.
 D. HVAC UNIT - 7" W.C. NATURAL, 14" W.C. L.P.

- IF THE MINIMUM PRESSURES ARE NOT MET, THIS SHALL BE IMMEDIATELY REPORTED TO THE McDONALD'S AREA CONSTRUCTION MANAGER.

CONDENSATE PIPING:


- CONDENSATE PIPING SHALL BE GALVANIZED STEEL, COPPER OR PVC.
- PVC PIPE SHALL BE PAINTED WITH WATER BASED LATEX PAINTING TO RESIST DEGRADATION FROM ULTRAVIOLET EXPOSURE.
- PIPE SUPPORTS SHALL BE RPS MODEL PMP-2 OR EQUAL. QUANTITY AS REQUIRED DEPENDANT UPON PIPING MATERIAL.
- PIPING SHALL BE SUPPORTED AS FOLLOWS:

MATERIAL	MAX. HORIZ. SPACING	MAX. VERT. SPACING
COPPER PIPE	12 FT.	10 FT.
GALVANIZED STEEL	12 FT.	15 FT.
PVC	4 FT.	15 FT.

- CONDENSATE PIPING SHALL SLOPE A MINIMUM OF $\frac{1}{8}$ " PER FOOT.

- CONDENSATE PIPING SHALL BE SIZED BASED ON THE FOLLOWING:

TOTAL TONS SERVED BY PIPE	MINIMUM PIPE SIZE
<20 TONS	$\frac{3}{4}$ "
>20 TONS, <40 TONS	1"

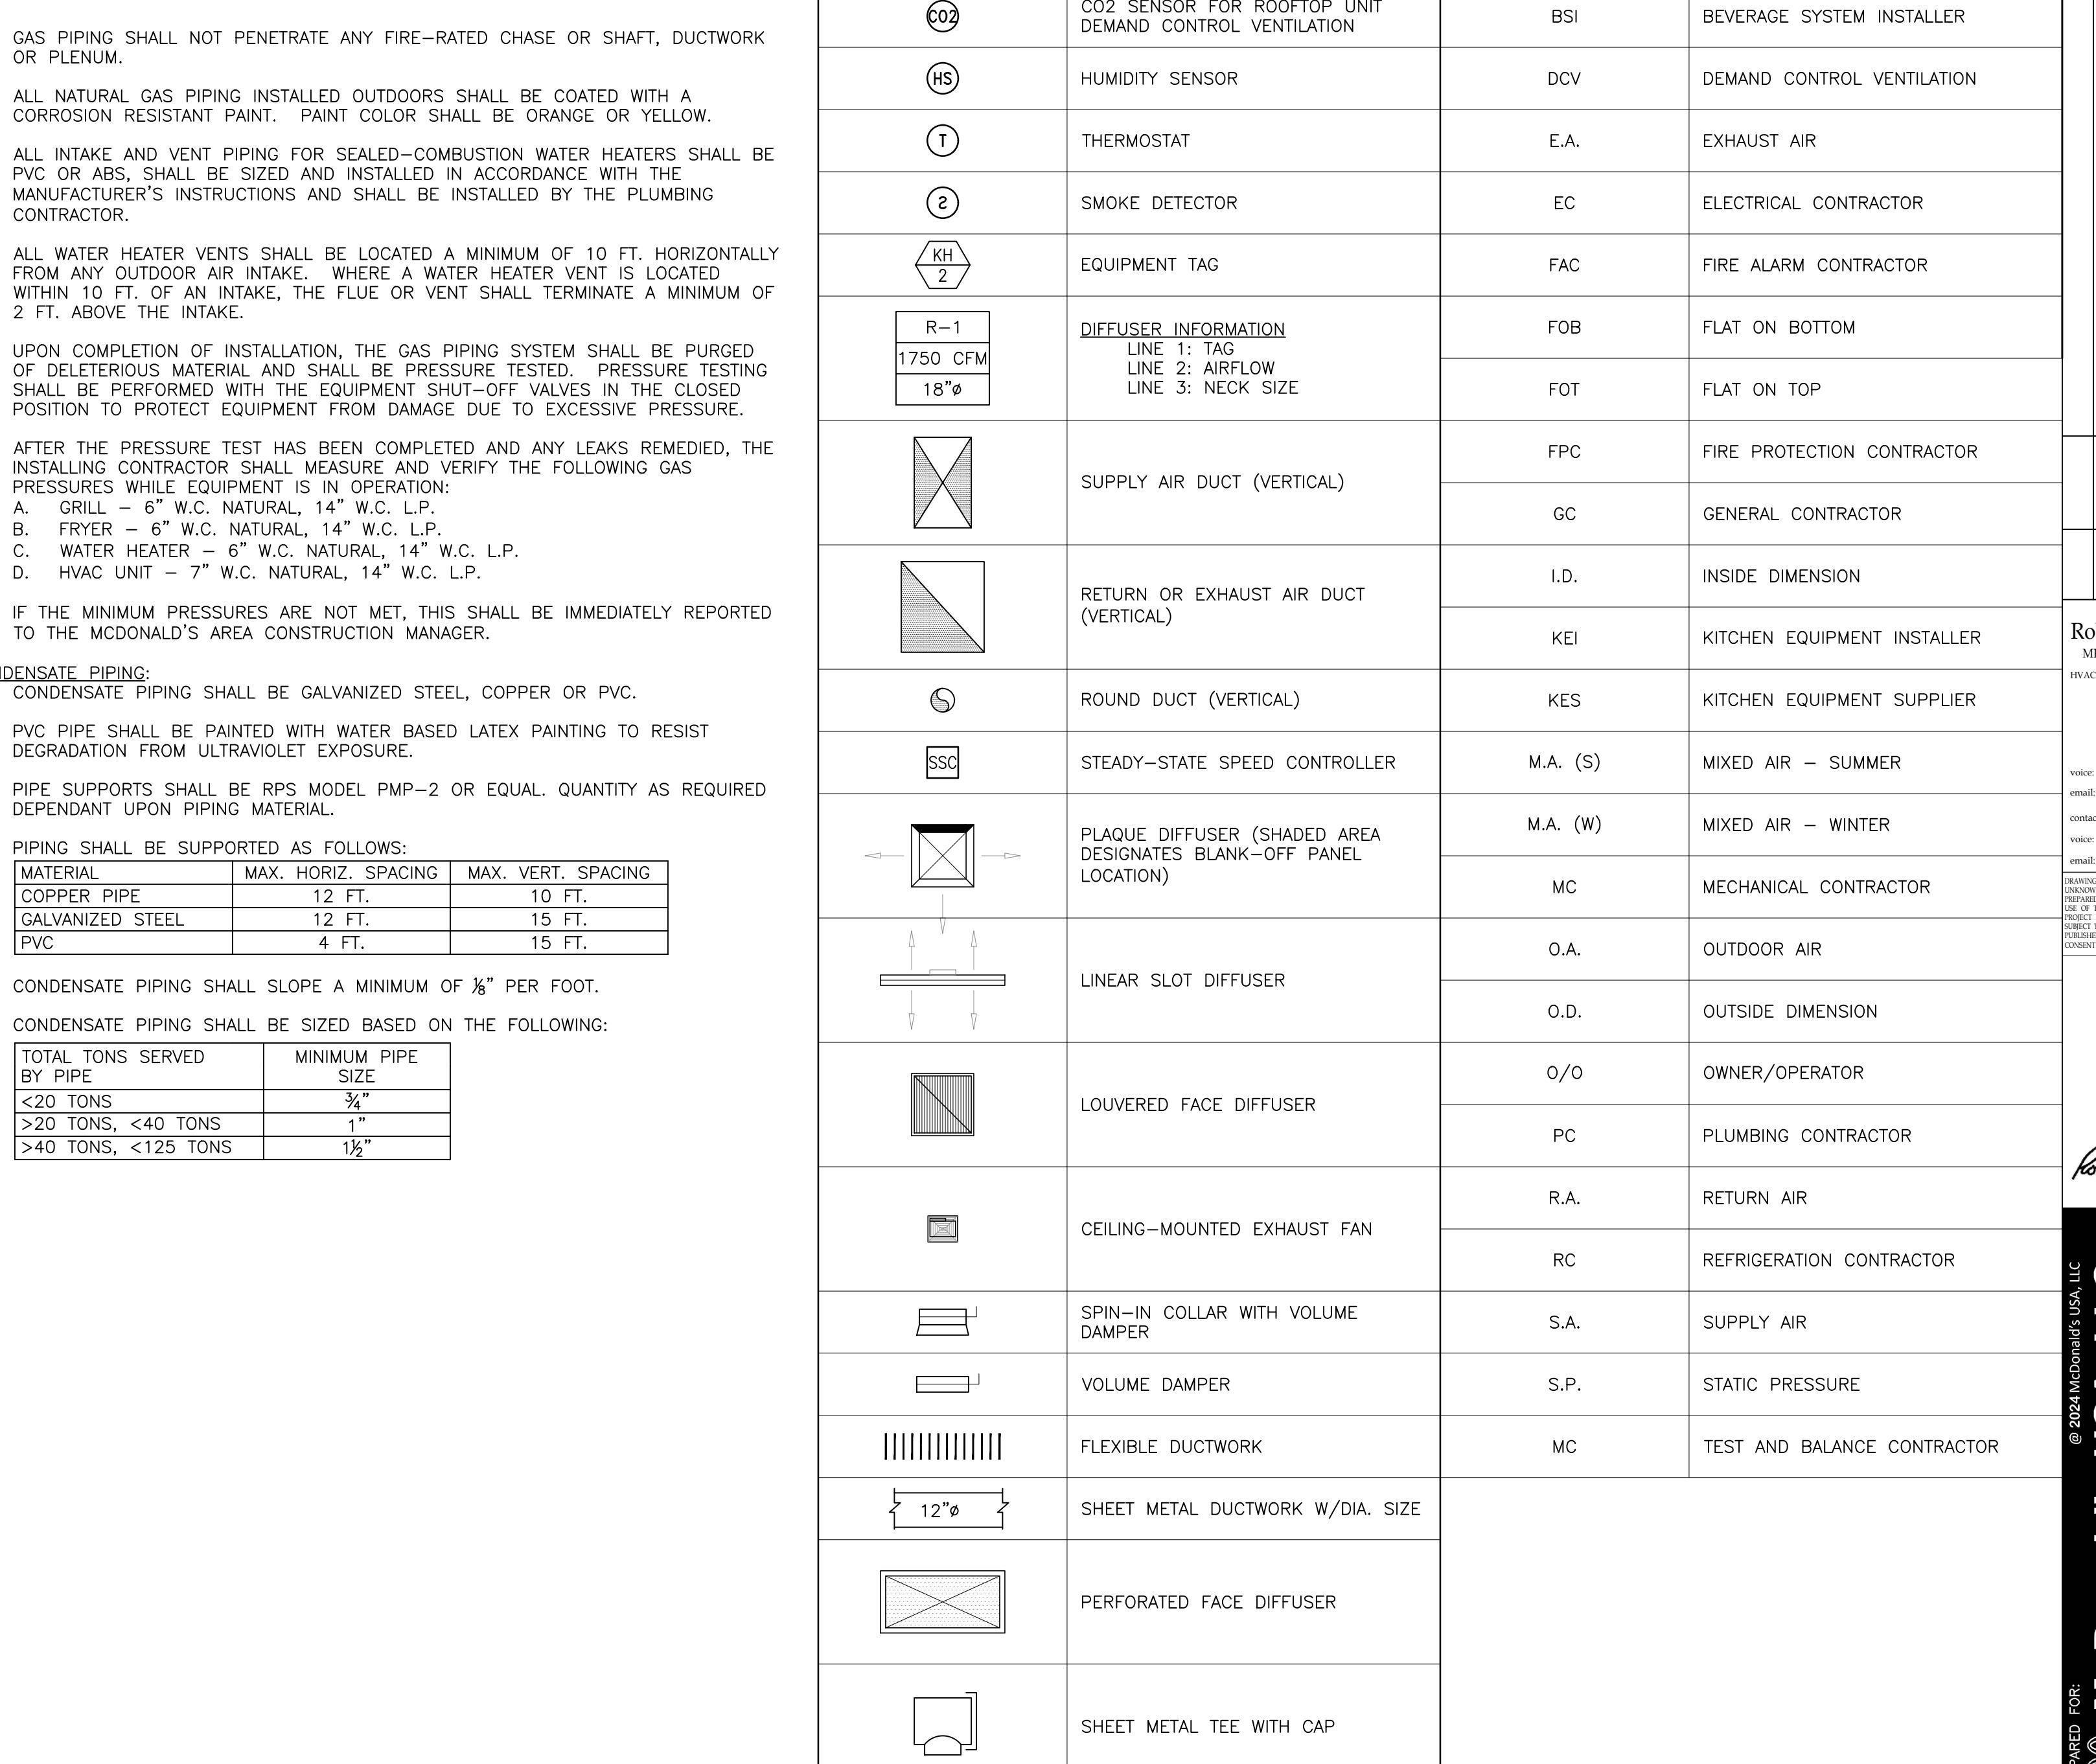


McDonald's USA, LLC

PREPARED FOR: McDonald's USA, LLC

These drawings and specifications are the confidential and proprietary property of McDonald's USA, LLC and shall not be copied or reproduced without the express written consent of McDonald's USA, LLC. These drawings and specifications are issued in confidence and shall not be copied or reproduced for specific use on the job and shall indicate which drawing or detail is to be used on the job. Use of these drawings and specifications in construction shall be limited to the project for which they were prepared. These drawings and specifications are not suitable for use on a different site or on another project or for reference or example on another project or for other purposes. Reproduction of these drawings and specifications by anyone other than the project architect or engineer is not authorized.

DRAWN BY	MES
STD ISSUE DATE	2023
REVIEWED BY	JAW
DATE ISSUED	03/08/24
SHEET NO.	2023 STANDARD BUILDING - BB20
DESCRIPTION	WOOD BEARING WALLS W/4" BRICK VENEER
	STUCCO/BATEN/BRICK/METAL PANEL EXTERIOR FINISHES
SITE ID	SEC OF S.H. LOOP 288 & HUMMINGBIRD LANE, DENTON, TEXAS
SEC	JAWA 24-0014
GENERAL NOTES	M 4.0

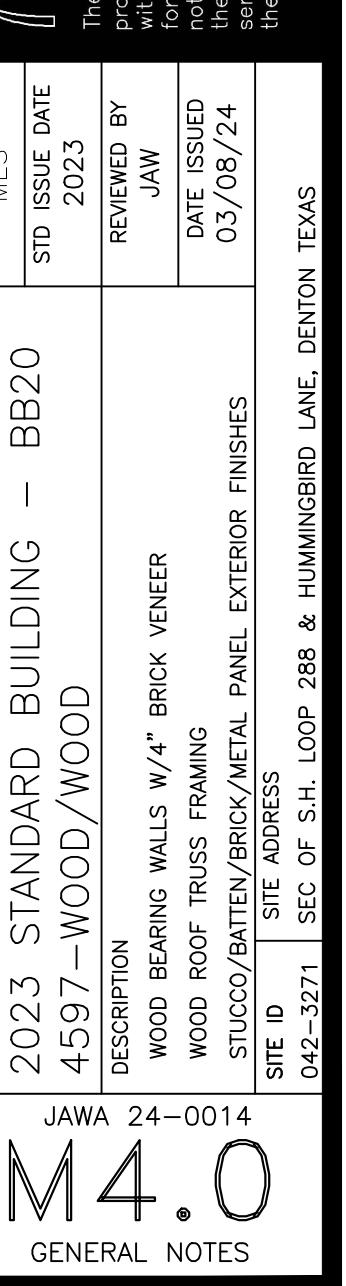

BY

REV

DATE

REVISION


DESCRIPTION

COORDINATION SCHEDULE

	FURNISH	INSTALL	FINAL CONNECTION	NOTES
GENERAL REQUIREMENTS				
MECHANICAL PERMIT	MC			1-3
HOT WORK (WELDING) PERMIT (IF APPLICABLE)	KES			1-3
REFRIGERATION PERMIT (IF APPLICABLE)	MC			1-3
PLUMBING PERMIT	PC			1-3
ELECTRICAL PERMIT	EC			1-3
FIRE SPRINKLER PERMIT (IF APPLICABLE)	FPC			1-3
FIRE ALARM PERMIT (IF APPLICABLE)	FAC			1-3
CONTRACTOR COORDINATION REQUIREMENTS				
HEATING & AIR-CONDITIONING				
ROOFTOP UNITS, INTAKE AND RELIEF	MCD CP	MC		1-5, 17, 22
ROOF CURBS	MCD CP	MC		1-3, 20, 22
GAS PIPING AND GAS PIPE KIT	PC	PC	PC	1-3, 14, 22-23
CONTROLS WIRING	MC	EC	EC	1-3, 19, 22, 24
POWER WIRING	EC	EC	EC	1-3, 19, 22, 24
CONDENSATE TRAP	MC	PC		1-3, 22-23
CONDENSATE PIPING (IF APPLICABLE)	PC	PC		1-3, 22-23
DUCT-MOUNTED SMOKE DETECTOR	MC	MC	EC	1-3, 22, 24
GENERAL EXHAUST SYSTEMS				
EXHAUST FANS	MCD CP	MC		1-3, 17, 22
ROOF CURBS	MCD CP	MC		1-3, 22
CONTROLS (WHERE APPLICABLE)	MC	EC	EC	1-3, 22, 24
POWER WIRING	EC	EC	EC	1-3, 22, 24
TEMPERATURE CONTROLS				
BUILDING AUTOMATION SYSTEM	MCD CP	MC	EC	1-3, 22, 24
REMOTE SENSORS (RH AND/OR TEMPERATURE)	MC	MC	EC	1-3, 22, 24
CONTROLS WIRING (WHERE APPLICABLE)	MC	EC	EC	1-3, 22, 24
POWER WIRING	EC	EC	EC	1-3, 22, 24
DUCTWORK AND ACCESSORIES				
GALVANIZED SHEET METAL DUCTWORK	MC	MC		1-3, 22
EXTERNAL INSULATION	MC	MC		1-3, 22
INTERNAL INSULATION (IF APPLICABLE)	MC	MC		1-3, 22
WEATHERPROOFING (IF APPLICABLE)	MC	MC		1-3, 22
SPIN-IN COLLARS	MC	MC		1-3, 22
FLEXIBLE DUCTWORK	MC	MC		1-3, 22
VOLUME/BALANCING DAMPERS	MC	MC		1-3, 22
FIRE DAMPERS (IF APPLICABLE)	MC	MC		1-3, 22
FIRESTOPPING (IF APPLICABLE)	MC	MC		1-3, 22
AIR DEVICES AND ACCESSORIES				
PLUMBING SYSTEMS				
WATER HEATERS	MCD CP	PC	PC	1-3, 11-12, 23
HOT AND COLD WATER PIPE	PC	PC	PC	1-3, 23
VENTS AND INTAKES	PC	PC	PC	1-3, 23
THERMOSTATIC MIXING VALVE	PC	PC	PC	1-3, 23
POWER AND CONTROL WIRING	EC	EC	EC	1-3, 23-24
KITCHEN EXHAUST SYSTEMS				
MCDONALD'S BACKSHLF EXHAUST HOODS	KES	KEI		1-3, 6, 22, 27
CANOPY EXHAUST HOODS (IF APPLICABLE)	KES	KEI		1-3, 6, 22, 27
BLACK IRON DUCTWORK	KES	KEI		1-3, 6, 22
STAINLESS STEEL DUCTWORK (IF APPLICABLE)	KES	KEI		1-3, 6, 22
ALUMINUM DUCTWORK (IF APPLICABLE)	KES	KEI		1-3, 6, 22
UL LISTED DUCT WRAP	MC	MC		1-3, 6, 22
FIRE-RATED DUCT ENCLOSURE (IF APPLICABLE)	GC	GC		1-3, 6, 20, 22
EXHAUST FANS	MCD CP	MC		1-3, 6, 17, 22
ROOF CURBS	MCD CP	MC		1-3, 6, 20, 22
CURB EXTENSIONS	MC	MC		1-3, 6, 22
CONTROLS (WHERE APPLICABLE)	EC	EC	EC	1-3, 6, 22, 24
POWER WIRING	EC	EC	EC	1-3, 6, 22, 24
FIRE SUPPRESSION SYSTEM	KES	KES	KES	1-3, 16, 22, 27
KITCHEN EQUIPMENT				
COOLER/FREEZER	KES	GC		1-3, 27
EVAPORATOR COILS	KES	MC		1-3, 27
CONDENSATE PIPING	PC	PC	PC	1-3, 23, 27
REMOTE CONDENSING UNIT (MAC)	KES	MC		1-3, 22, 27
ROOF CURBS	MC	MC		1-3, 22
REFRIGERANT PIPING	KES	MC		1-3, 22, 27
POWER WIRING	EC	EC	EC	1-3, 22, 24, 27
CONTROL WIRING	EC	EC	EC	1-3, 24, 27
PIPE PORTALS	MC	MC		1-3, 22
ICE MACHINES	KES	KEI		1-3, 27
WATER SUPPLY PIPING	KES	KEI	BSI	1-3, 27
REMOTE CONDENSING UNITS	KES	MC		1-3, 22, 27
ROOF CURBS	MC	MC		1-3, 22, 27
REFRIGERANT PIPING	KES	MC		1-3, 22, 27
POWER WIRING	EC	EC	EC	1-3, 22, 24, 27
CONTROL WIRING	KES	EC	EC	1-3, 24, 27
PIPE PORTALS	MC	MC		1-3, 22
GRILLS	KES	KES		1-3, 27
GAS PIPING (IF APPLICABLE)	PC	PC	PC	1-3, 23, 27
POWER WIRING	EC	EC	EC	1-3, 24, 27
CONTROL CABLE (6' CLAMSHELL ONLY)	MC	EC	EC	1-3, 23, 24, 27
FRYERS	KES	KES		1-3, 27
GAS PIPING (IF APPLICABLE)	PC	PC	PC	1-3, 23, 27
POWER WIRING	EC	EC	EC	1-3, 24, 27
3-COMPARTMENT SINK	KES	KES		1-3, 12, 27
FAUCETS AND PRE-RINSE SPRAYER	KES	KES		1-3, 27
WATER SUPPLY PIPING	PC	PC	PC	1-3, 23, 27
SANITARY DRAIN PIPING	PC	PC		1-3, 23, 27
HAND SINKS	MCD CP	PC		1-3, 23, 27
FAUCET	MCD CP	PC		1-3, 23, 27
WATER SUPPLY PIPING	PC	PC		1-3, 23, 27
SANITARY DRAIN PIPING	PC	PC		1-3, 23, 27
WASHING MACHINE	KES	KES		1-3, 23, 27
WATER SUPPLY PIPING	PC	PC		1-3, 23, 27
SANITARY DRAIN PIPING	PC	PC		1-3, 23, 27
WARE WASHER	KES	KES		1-3, 23, 27
WATER SUPPLY PIPING	PC	PC		1-3, 23, 27
SANITARY DRAIN PIPING	PC	PC		1-3, 23, 27
MISCELLANEOUS ITEMS				
FIRE SPRINKLER SYSTEMS	FPC	FPC	FPC	1-3, 15, 25
HVAC EQUIPMENT START-UP	MC			1-3, 22
TEST, ADJUST AND BALANCE HVAC SYSTEMS	TAB			1-3, 22
DOOR GRILLES (IF APPLICABLE)	MC	GC		1-3, 20, 22
ROOF/WALL OPENINGS	GC			1-3, 20-24
APPLIANCE BACKFLOW PREVENTION	KES/BSI	PC	PC	1-3, 23, 27
CO2 DETECTION SYSTEM	KES/BSI	EC/BSI	EC/BSI	1-3, 22, 27

COORDINATION SCHEDULE

NOTES:				
1. THIS SCHEDULE IS INTENDED AS A GUIDE FOR THE WORK TO BE PERFORMED. ALL WORK SHALL BE COORDINATED BETWEEN THE McDONALD'S AREA CONSTRUCTION MANAGER AND ALL GC AND O/O SUBCONTRACTORS.				
2. ONE (1) COPY OF THE DECOR PACKAGE DRAWINGS SHALL BE SUPPLIED TO THE GENERAL CONTRACTOR AND EACH OF THE SUBCONTRACTORS. IT SHALL BE THE RESPONSIBILITY OF THE GENERAL CONTRACTOR AND THE SUBCONTRACTORS TO INSURE THAT THEY HAVE RECEIVED THE DECOR PACKAGE DRAWINGS.				
3. FOR ANY WORK NOT CLARIFIED IN THIS SCHEDULE OR IN THE NOTES AND SPECIFICATIONS, PLEASE CONSULT THE McDONALD'S CONSTRUCTION MANAGER FOR SCOPE OF WORK.				
4. ALL ROOFTOP UNIT EQUIPMENT SUPPLIED BY THE MECHANICAL CONTRACTOR AND THE KITCHEN EQUIPMENT SUPPLIER SHALL BE ON SITE AT THE SAME TIME FOR A SINGLE CRANE LIFT. EQUIPMENT SITE ARRIVAL DATE SHALL BE COORDINATED BETWEEN THE CONSTRUCTION MANAGER, MECHANICAL CONTRACTOR AND KITCHEN EQUIPMENT SUPPLIER.				
5. ALL ROOFTOP UNITS INSTALLED IN McDONALD'S RESTAURANTS SHALL BE HIGH EFFICIENCY EQUIPMENT. THE INSTALLATION OF STANDARD EFFICIENCY ROOFTOP UNITS IS PROHIBITED. PLEASE REFER TO THE LATEST EDITION OF IECC FOR HVAC EQUIPMENT PERFORMANCE REQUIREMENTS.				
6. ALL KITCHEN EQUIPMENT REQUIRING EXHAUST SHALL BE INSTALLED IN ACCORDANCE WITH THESE PLANS. ANY VARIATION FROM THESE PLANS SHALL BE REPORTED TO THE CONSTRUCTION MANAGER AND THE ENGINEER-OF-RECORD.				
7. WHERE GYPSUM BOARD CEILINGS ARE INSTALLED, THE MECHANICAL CONTRACTOR SHALL SUPPLY DRYWALL MOUNTING FRAMES FOR LAY-IN TYPE DIFFUSERS.				
8. ALL WORK SHOWN ON P1.6 DRAWING(S) SHALL BE COMPLETED BY THE BEVERAGE SYSTEM INSTALLER (OR K.E.S.) UNLESS OTHERWISE NOTED IN THE PLUMBING DRAWINGS.				
9. ALL WORK ON P1.0 & P1.2 DRAWING(S) SHALL BE BY THE PLUMBING CONTRACTOR.				
10. THE BEVERAGE SYSTEM INSTALLER FURNISHES, RUNS AND CONNECTS ALL FLEXIBLE WATER AND SYRUP LINES FOR ALL AFFECTED EQUIPMENT INCLUDING THE FOLLOWING:				
A. HOT CHOCOLATE				
B. COFFEE BREWER				
C. ICE MACHINE				
D. O.J.				
E. SODA TOWERS				
11. ALL WATER HEATERS INSTALLED IN McDONALD'S RESTAURANTS SHALL BE HIGH EFFICIENCY SEALED-COMBUSTION WATER HEATERS. THE INSTALLATION OF STANDARD EFFICIENCY GRAVITY-VENTED WATER HEATERS IS PROHIBITED. PLEASE REFER TO THE LATEST EDITION OF IECC FOR SERVICE WATER-HEATING EQUIPMENT PERFORMANCE REQUIREMENTS.				
12. THE CONSTRUCTION MANAGER, PLUMBING CONTRACTOR AND KITCHEN EQUIPMENT SUPPLIER SHALL COORDINATE WHICH SOILED DISHWASHER (3-COMPARTMENT SINK) IS BEING INSTALLED IN THE RESTAURANT.				
13. ALL GAS PIPING FOR COOKING EQUIPMENT SHALL TERMINATE IN THE CEILING PRIOR TO THE INSTALLATION OF THE PIPING CHASE. UPON INSTALLATION OF THE CHASE, THE GAS PIPING SHALL THEN BE CONTINUED IN THE CHASE FOR FINAL CONNECTION TO THE APPLIANCE.				
14. ALL GAS PIPING FOR ROOFTOP EQUIPMENT SHALL BE BROUGHT UP THROUGH THE BASE OF THE UNIT TO MINIMIZE ROOF PENETRATIONS. WHERE THIS IS NOT POSSIBLE, THE PLUMBING CONTRACTOR SHALL PROVIDE THE NECESSARY PIPE PORTALS ON ROOF.				
15. ALL FIRE PROTECTION DRAWINGS CONTAINED WITHIN THIS SET ARE STRICTLY FOR REFERENCE ONLY. FIRE SPRINKLER DRAWINGS SHALL BE DESIGNED AND PERMITTED BY A FIRE PROTECTION CONTRACTOR.				
16. ALL R-102 WET CHEMICAL FIRE SUPPRESSION SYSTEMS FOR TYPE I HOODS SHALL BE DESIGNED AND INSTALLED BY A LOCAL ANSUL AGENT. THE USE OF DRY CHEMICAL SYSTEMS IS PROHIBITED. THE LOCAL ANSUL AGENT CONTRACT IS HANDLED THROUGH THE KITCHEN EQUIPMENT SUPPLIER.				
17. ALL ROOFTOP UNITS AND EXHAUST FANS ARE SUPPLIED WITH A FACTORY-INSTALLED DISCONNECT SWITCH.				
18. ELECTRICAL CONTRACTOR SHALL PROVIDE DISCONNECT SWITCHES FOR REMOTE CONDENSING UNITS.				
19. ALL ELECTRICAL CONDUITS FOR ROOFTOP EQUIPMENT SHALL BE BROUGHT UP THROUGH THE BASE OF THE UNIT TO MINIMIZE ROOF PENETRATIONS. WHERE THIS IS NOT POSSIBLE, THE ELECTRICAL CONTRACTOR SHALL PROVIDE THE NECESSARY PIPE PORTALS ON ROOF.				

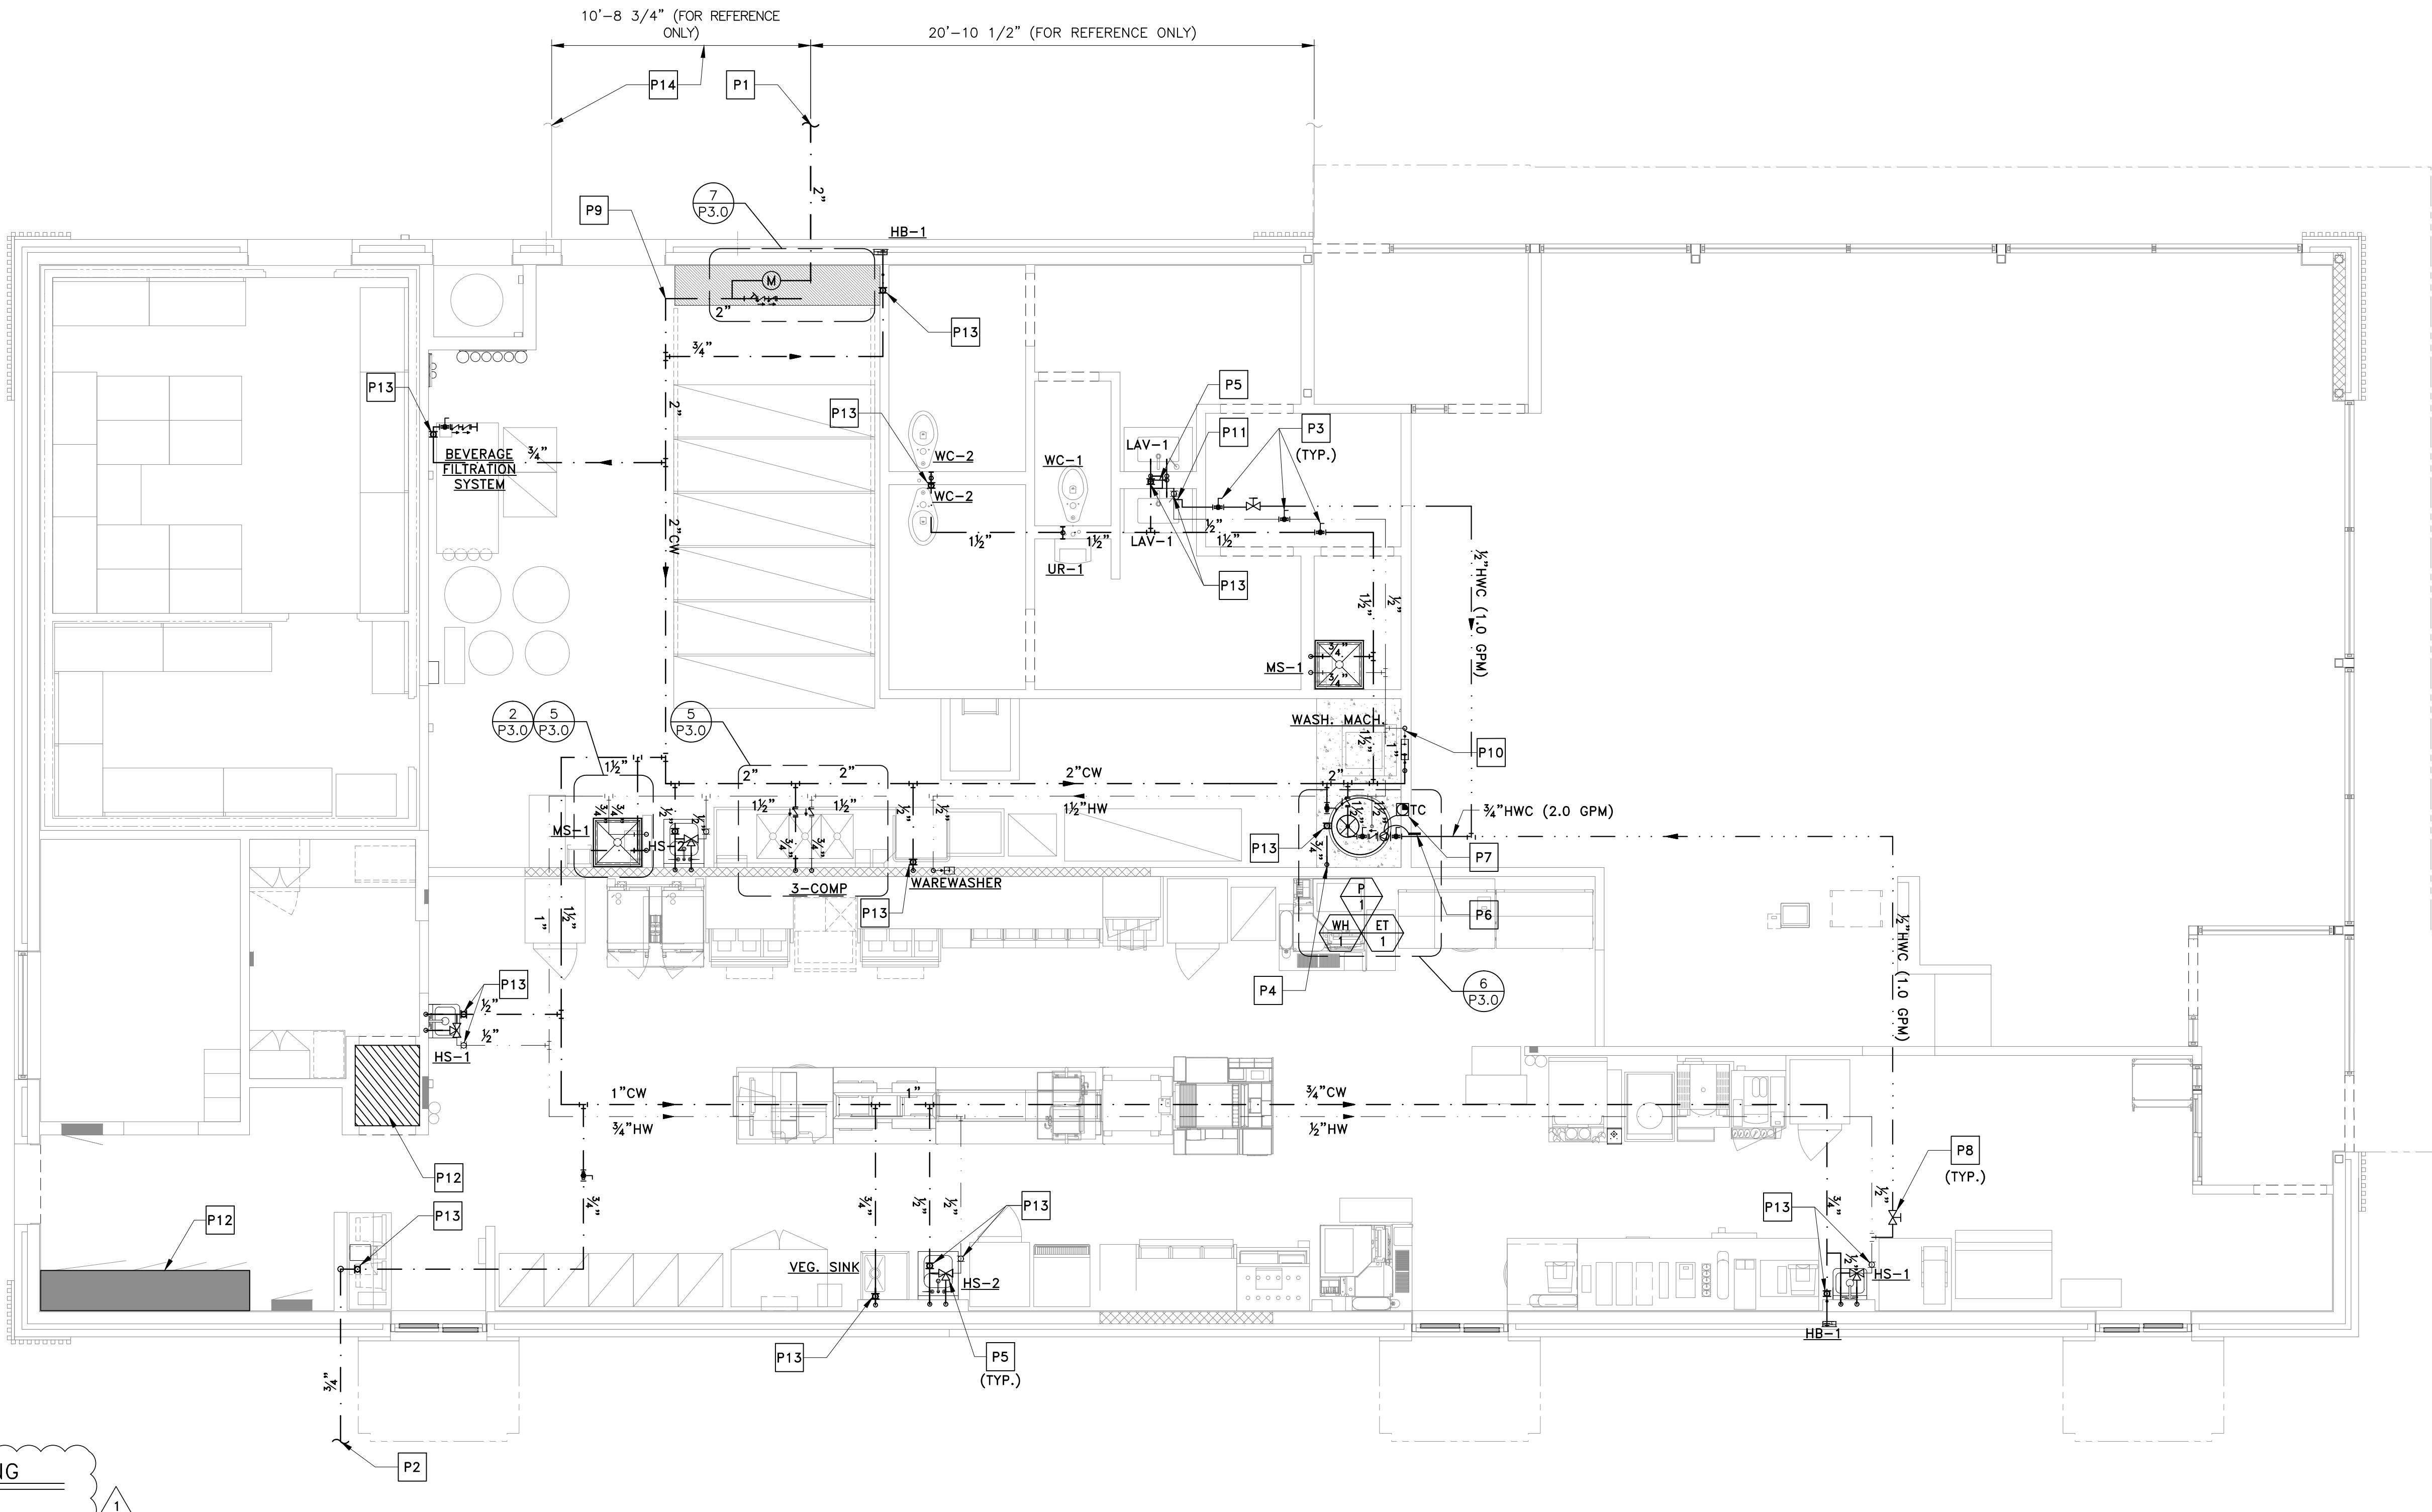

DRAWING NOTES

- PIPING ROUTES AS SHOWN ARE GENERAL AND MAY VARY DUE TO FIELD CONDITIONS. COORDINATE ALL PIPE ROUTES WITH OTHER TRADES. MAKE SURE HOT WATER MAIN LOOP REMAINS WITHIN 10 FT OF FIXTURE FOR ENERGY CODE PURPOSE.
- ALL WATER DISTRIBUTION PIPING SHALL BE INSULATED. INSULATION NOT SHOWN FOR CLARITY. SEE PLUMBING NOTES FOR INSULATION REQUIREMENTS, SHEET M4.0, "DOMESTIC SUPPLY SYSTEMS", NOTE 18.

KEYED NOTES

- P1 INCOMING UNDERGROUND WATER SERVICE (SEE SITE PLAN FOR CONTINUATION). WATER PIPING FROM THIS POINT TO CEILING PENETRATION INSIDE BUILDING SHALL BE COPPER.
- P2 COLD WATER UNDERGROUND TO YARD HYDRANT (HB-2) IN TRASH CORRAL. SEE SITE PLAN FOR CONTINUATION.
- P3 SHUT-OFF VALVE FOR RESTROOM ISOLATION. SEE VALVE SCHEDULE. ALL SHUT-OFF VALVES SHALL BE LOCATED OVER SUSPENDED CEILINGS FOR ACCESSIBILITY. DO NOT LOCATE IN AREAS WITH DRYWALL CEILINGS.
- P4 3/4" COLD WATER UP TO ROOF HYDRANT.
- P5 FOR MIXING VALVE LOCATIONS AND INSTALLATION DETAILS ON PUBLIC LAVATORIES, SEE DETAIL 3 ON DRAWING P3.0 FOR PRIVATE HAND SINKS OR LAVS, MIXING VALVES FOR INFORMATIONAL PURPOSES.
- P6 PIPE-MOUNTED AQUASTAT TO SHUT PUMP DOWN WHEN RECIRCULATION TEMPERATURE REACHES 140°F. SEE DETAIL 6 ON DRAWING P3.0.
- P7 TIME CLOCK TO SHUT PUMP AND WATER HEATER DOWN DURING UNOCCUPIED HOURS. SEE ELECTRICAL DRAWINGS FOR WIRING DETAIL.
- P8 BALANCING VALVE FOR RECIRCULATION SYSTEM. SEE VALVE SCHEDULE. ALL BALANCING VALVES SHALL BE LOCATED OVER SUSPENDED CEILINGS FOR ACCESSIBILITY. DO NOT LOCATE IN AREAS WITH DRYWALL CEILINGS.
- P9 WATER PIPING AFTER CEILING PENETRATION CAN TRANSITION TO CPVC OR PEX WHERE PERMITTED BY CODE.
- P10 PROPERLY SEAL ALL PIPE PENETRATIONS THROUGH DRAFT STOP WALL (TYP.)
- P11 HOT WATER RECIRCULATION SHALL CONNECT WITHIN 6" OF SUPPLY STUB OUT TO FIXTURE.
- P12 UTILITIES SHALL NOT BE ROUTED ABOVE THE TECH. CLOSET AND THE SWITCHGEAR.
- P13 INSTALL WATER-HAMMER ARRESTOR WHERE QUICK-CLOSING VALVES ARE UTILIZED. WATER-HAMMER ARRESTORS SHALL BE INSTALLED IN ACCORDANCE WITH THE MANUFACTURER'S INSTRUCTIONS. WATER-HAMMER ARRESTORS SHALL CONFORM TO ASSE 1010.
- P14 MAINTAIN A MINIMUM OF 10'-0" CLEARANCE FROM THE INCOMING DOMESTIC WATER TO THE GREASE WASTE AND SANITARY LINES.

HOT OR COLD WATER SUPPLY
PDI SIZE "A"
SINGLE FIXTURE
INSTALL PER PDI STANDARDS AND MANUFACTURER'S INSTRUCTIONS
IF HORIZONTAL BRANCH IS LESS THAN 20'
LONG, PROVIDE ONE WHA AT END OF LINE
PROVIDE ANOTHER WHA IN MIDDLE, EACH
SIZED FOR HALF THE FIXTURE UNITS

MULTIPLE FIXTURES
FIXTURE UNIT TABULATION
PDI SIZE PIPE SIZE FIXTURE UNIT LOAD

PDI SIZE	PIPE SIZE	FIXTURE UNIT LOAD
A	1/2"	1-11
B	3/4"	12-32

PC TO PROVIDE WATER HAMMER ARRESTERS BY SIOUX CHIEF,
PRECISION PLUMBING PRODUCTS, WATTS OR APPROVED
EQUIVALENT WITH PISTON AND O-RING CONSTRUCTION, HAVING
PDI #WH-201, ASSE #1010 AND ANSI #A112.26.1M
CERTIFICATION. INSTALL IN HORIZONTAL OR VERTICAL POSITION,
BUT NEVER UPSIDE DOWN. INSTALL IN LINE WITH WATER FLOW
DIRECTION IF POSSIBLE. SIZE THE UNITS AS SHOWN ON THE
DRAWINGS AND/OR PER THE TABLES SHOWN ABOVE.

DETAIL

WATER-HAMMER ARRESTER (TYP.)
NOT TO SCALE

Fixture Count - IPC

NO.	Fixture Description	SUPPLY CONNECTIONS			DRAWN BY MES	STD ISSUE DATE 2023
		WSFU	COLD	HOT		
1	VEGETABLE PREP SINK	4	3/4"	-	4	
2	HAND SINK	1	1/2"	1/2"	2	
4	HOSE BIBB	3	3/4"	-	12	
1	SODA FACTORY	10	1"	-	10	
1	KITCHEN SINK (3-COMP)	4	3/4"	3/4"	4	
2	MOP SINK	2	3/4"	3/4"	4	
2	LAVATORY	1	1/2"	1/2"	2	
1	URINAL	5	1"	-	5	
(*) CW FOR VAPOR VENT						TOTAL: 66
						(55 GPM)


McDonald's USA, LLC


These drawings and specifications are the confidential and proprietary property of McDonald's USA, LLC and shall not be copied or reproduced without the express written consent of McDonald's USA, LLC. These drawings and specifications are intended for use in construction of buildings and structures. They are not to be used for other purposes or for reference or example on another site or at a later time. Use of these drawings by others is unauthorized. Reproduction of these drawings by others is unauthorized. Reproduction of these drawings by others is unauthorized.

REVIEW DATE	DESCRIPTION
04/01/2024	USRD OC PLAN REVIEW COMMENTS
1	Robert D. Anderson, Inc. MEP Engineering & Design Consultants HVAC/R/Plumbing/Piping/Distribution/Controls Robert D. Anderson 4405 Zinn Rd. Garland, TX 75043 voice: 972-447-7204 email: robert.anderson@boglegal.net contact: Mark Swanson, Project Manager voice: 817-556-0986 email: mark@mjdesigns.com DRAWING IS DIAGRAMATIC AND AS SUCH STATEMENTS FOR EXACTNESS, ACCURACY, AND COMPLETENESS ARE NOT MADE. THIS DRAWING IS PREPARED FOR SPECIFIC USE ON THE SITE AND NOT INDICATED HEREIN AS BEING APPLICABLE TO ANY OTHER SITE. THE PROJECT OWNER OR ARCHITECT IS RESPONSIBLE FOR DETERMINING WHETHER THIS DRAWING IS APPROPRIATE FOR THE PROJECT. THIS DRAWING IS THE PROPERTY OF THE PROJECT OWNER AND IS NOT TO BE COPIED, REPRODUCED, OR USED IN ANY WAY WITHOUT THE EXPRESS WRITTEN CONSENT OF PROJECT OWNER.

McDonald's USA, LLC
4490 Zinn Rd., Garland, TX 75043
Firm No.: 5324
3/28/24

PREPARED FOR:
McDonald's USA, LLC

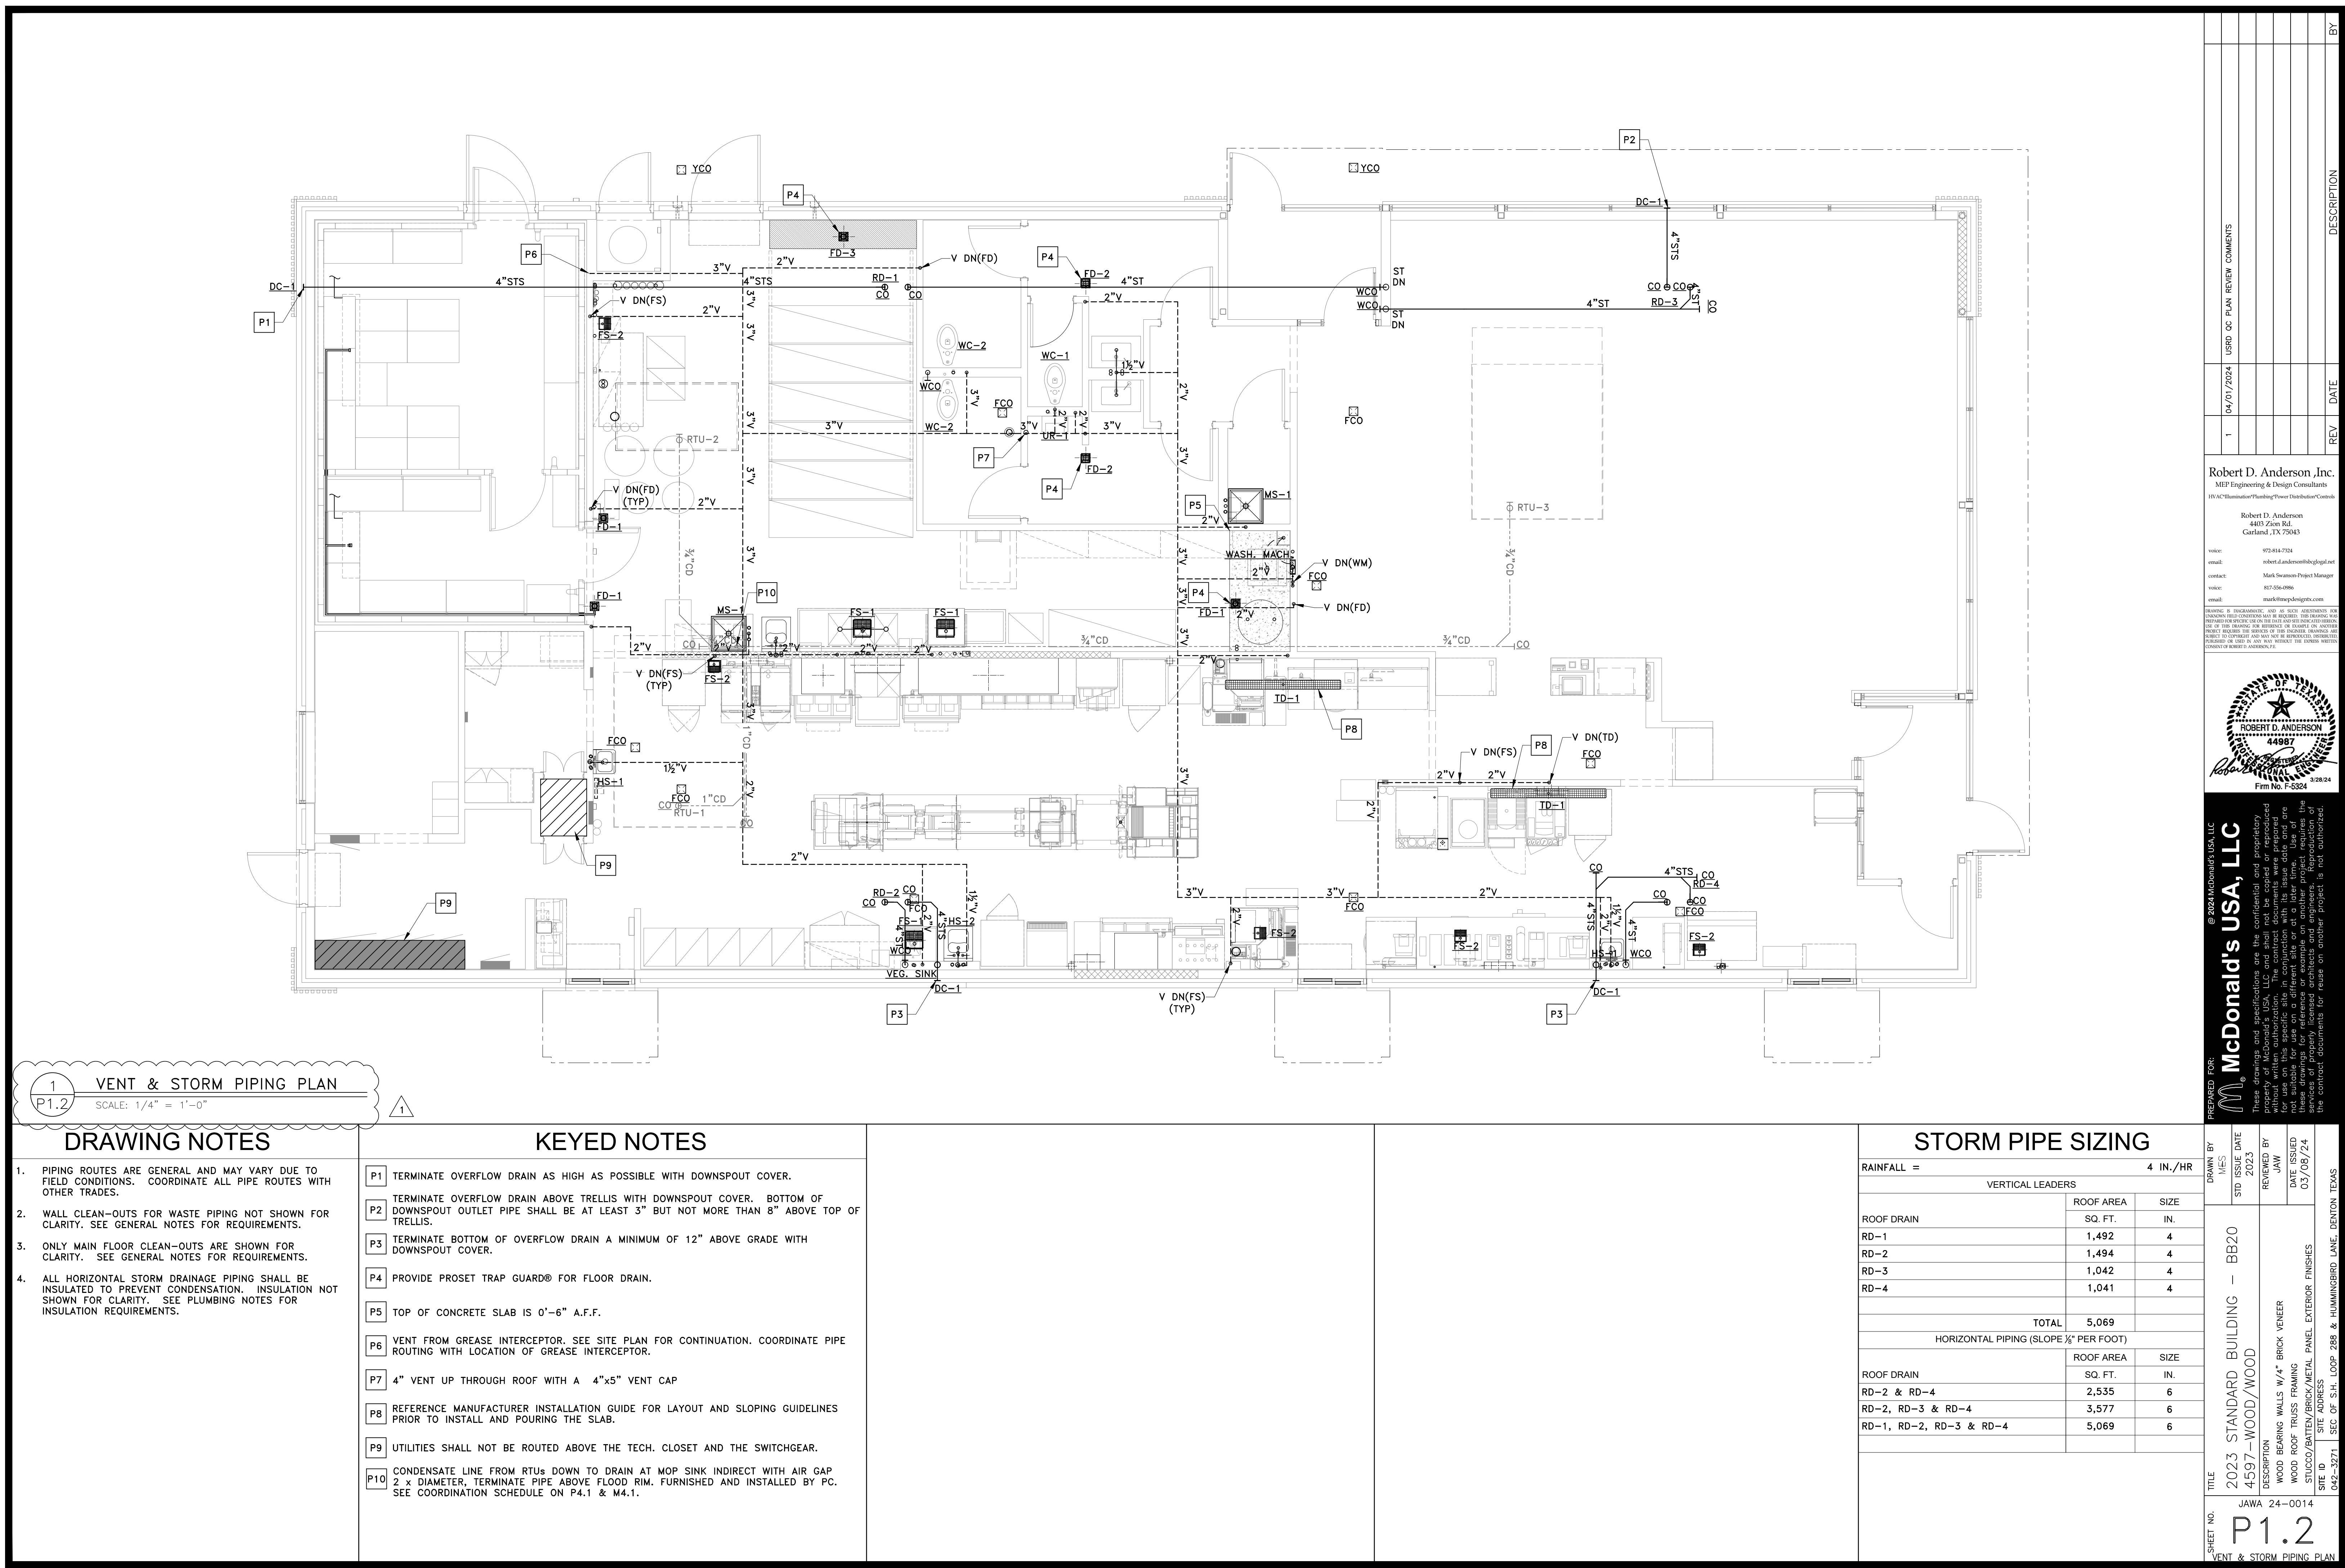

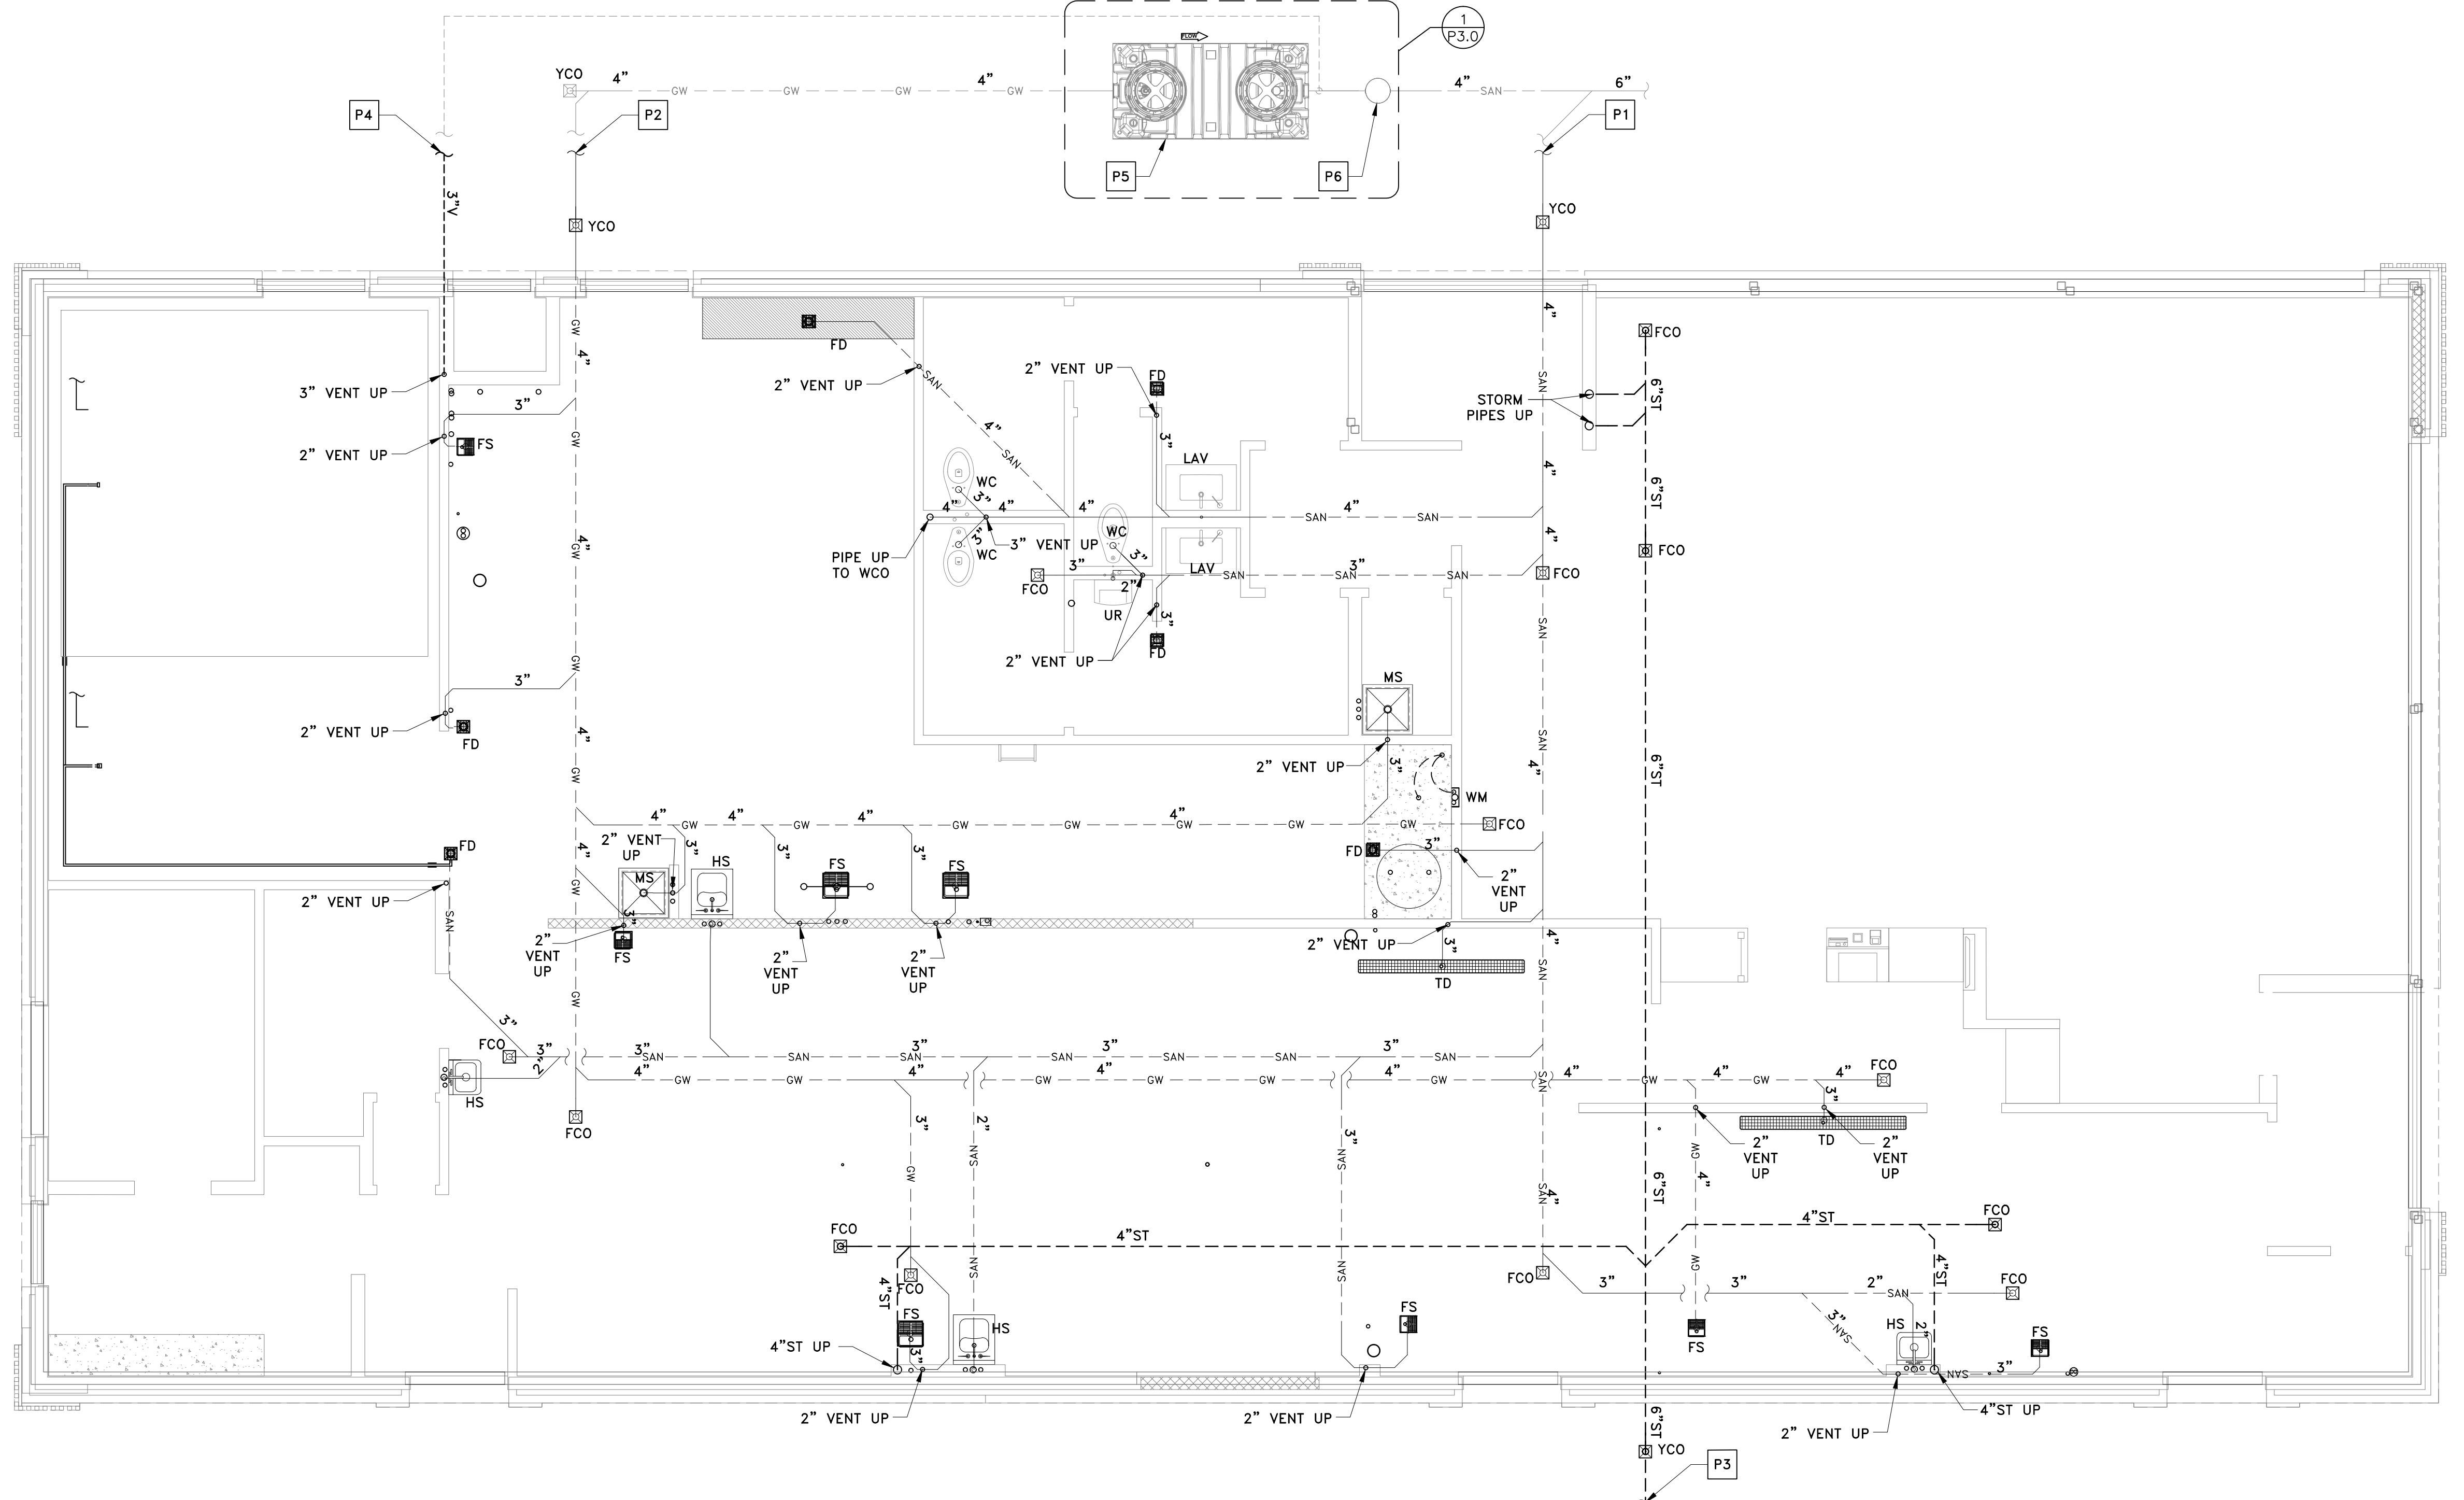

1
P1.3

UNDERFLOOR PLUMBING PLAN

SCALE: 1/4" = 1'-0"

SCALE: 1/4" = 1'-0"

DRAWING NOTES

1. PIPING ROUTES ARE GENERAL AND MAY VARY DUE TO FIELD CONDITIONS. COORDINATE ALL PIPE ROUTES WITH OTHER TRADES.
 2. WALL CLEAN-OUTS FOR WASTE PIPING NOT SHOWN FOR CLARITY. SEE GENERAL NOTES FOR REQUIREMENTS.
 3. ONLY MAIN FLOOR CLEAN-OUTS ARE SHOWN FOR CLARITY. SEE GENERAL NOTES FOR REQUIREMENTS.

P1 SANITARY LINE TO SANITARY SEWER. SEE SITE PLAN FOR CONTINUATION.

P2 GREASE LINE TO EXTERIOR GREASE INTERCEPTOR. SEE SITE PLAN FOR CONTINUATION

P3 STORM LINE TO STORM SYSTEM. SEE SITE PLAN FOR CONTINUATION.

P4 VENT FROM GREASE INTERCEPTOR. SEE SITE PLAN FOR CONTINUATION. COORDINATE PIPE ROUTING WITH LOCATION OF GREASE INTERCEPTOR.

P5 GREASE INTERCEPTOR LOCATION SHOWN FOR REFERENCE ONLY. COORDINATE GREASE INTERCEPTOR LOCATION WITH CIVIL ENGINEER AND SITE CONTRACTOR.

P6 INSTALL SAMPLING PORT (IF REQUIRED) SCHIER, MODEL SV10 FOR SCHIER HYDROMECHANICAL GREASE INTERCEPTOR.

KEYED NOTES

WASTE PIPE SIZING - IPC

STORM PIPE SIZING

Fixture Type	Trap Size	DFU	Quantity
URINAL	2 IN.	4	1
WATER CLOSET	3 IN.	4	3
LAVATORY	1½ IN.	1	2
WASH SINK (HAND SINK)	1½ IN.	2	4
FLOOR DRAIN OR SINK	3 IN.	5	5
FLOOR DRAIN OR SINK	4 IN.	6	1
EMERGENCY FLOOR DRAIN (BATHROOMS)	3 IN.	0	2

VERTICAL LEADERS		4 IN.
IN	ROOF AREA	SIZ
	SQ. FT.	IN
	1,492	4
	1,494	4
	1,042	4
	1,041	4

GREASE PIPE SIZING - IPC

SERVICE SINK (MOP SINK)	3 IN.	3	2
FLOOR DRAIN OR SINK	3 IN.	5	7
FLOOR DRAIN OR SINK	4 IN.	6	1
WASHING MACHINE	2 IN.	3	1
TOTAL			TOTAL


	ROOF AREA	SIZ
	SQ. FT.	IN
IN		
RD-4	2,535	6
-3 & RD-4	3,577	6
-2, RD-3 & RD-4	5,069	6


PREPARED FOR:

McDonald's USA, LLC

SHEET NO.	TITLE		DRAWN BY MES	
	2023 STANDARD BUILDING – BB20		STD ISSUE DATE 2023	
	4597-WOOD/WOOD		REVIEWED BY JAW	
	DESCRIPTION		DATE ISSUED 03/08/24	
	WOOD BEARING WALLS W/4" BRICK VENEER WOOD ROOF TRUSS FRAMING STUCCO/BATTEN/BRICK/METAL PANEL EXTERIOR FINISHES			
	SITE ID	SITE ADDRESS		
	042-3271	SEC OF S.H. LOOP 288 & HUMMINGBIRD LANE, DENTON TEXAS		
JAWA 24-0014		 13 UNDERGROUND PLUMBING		

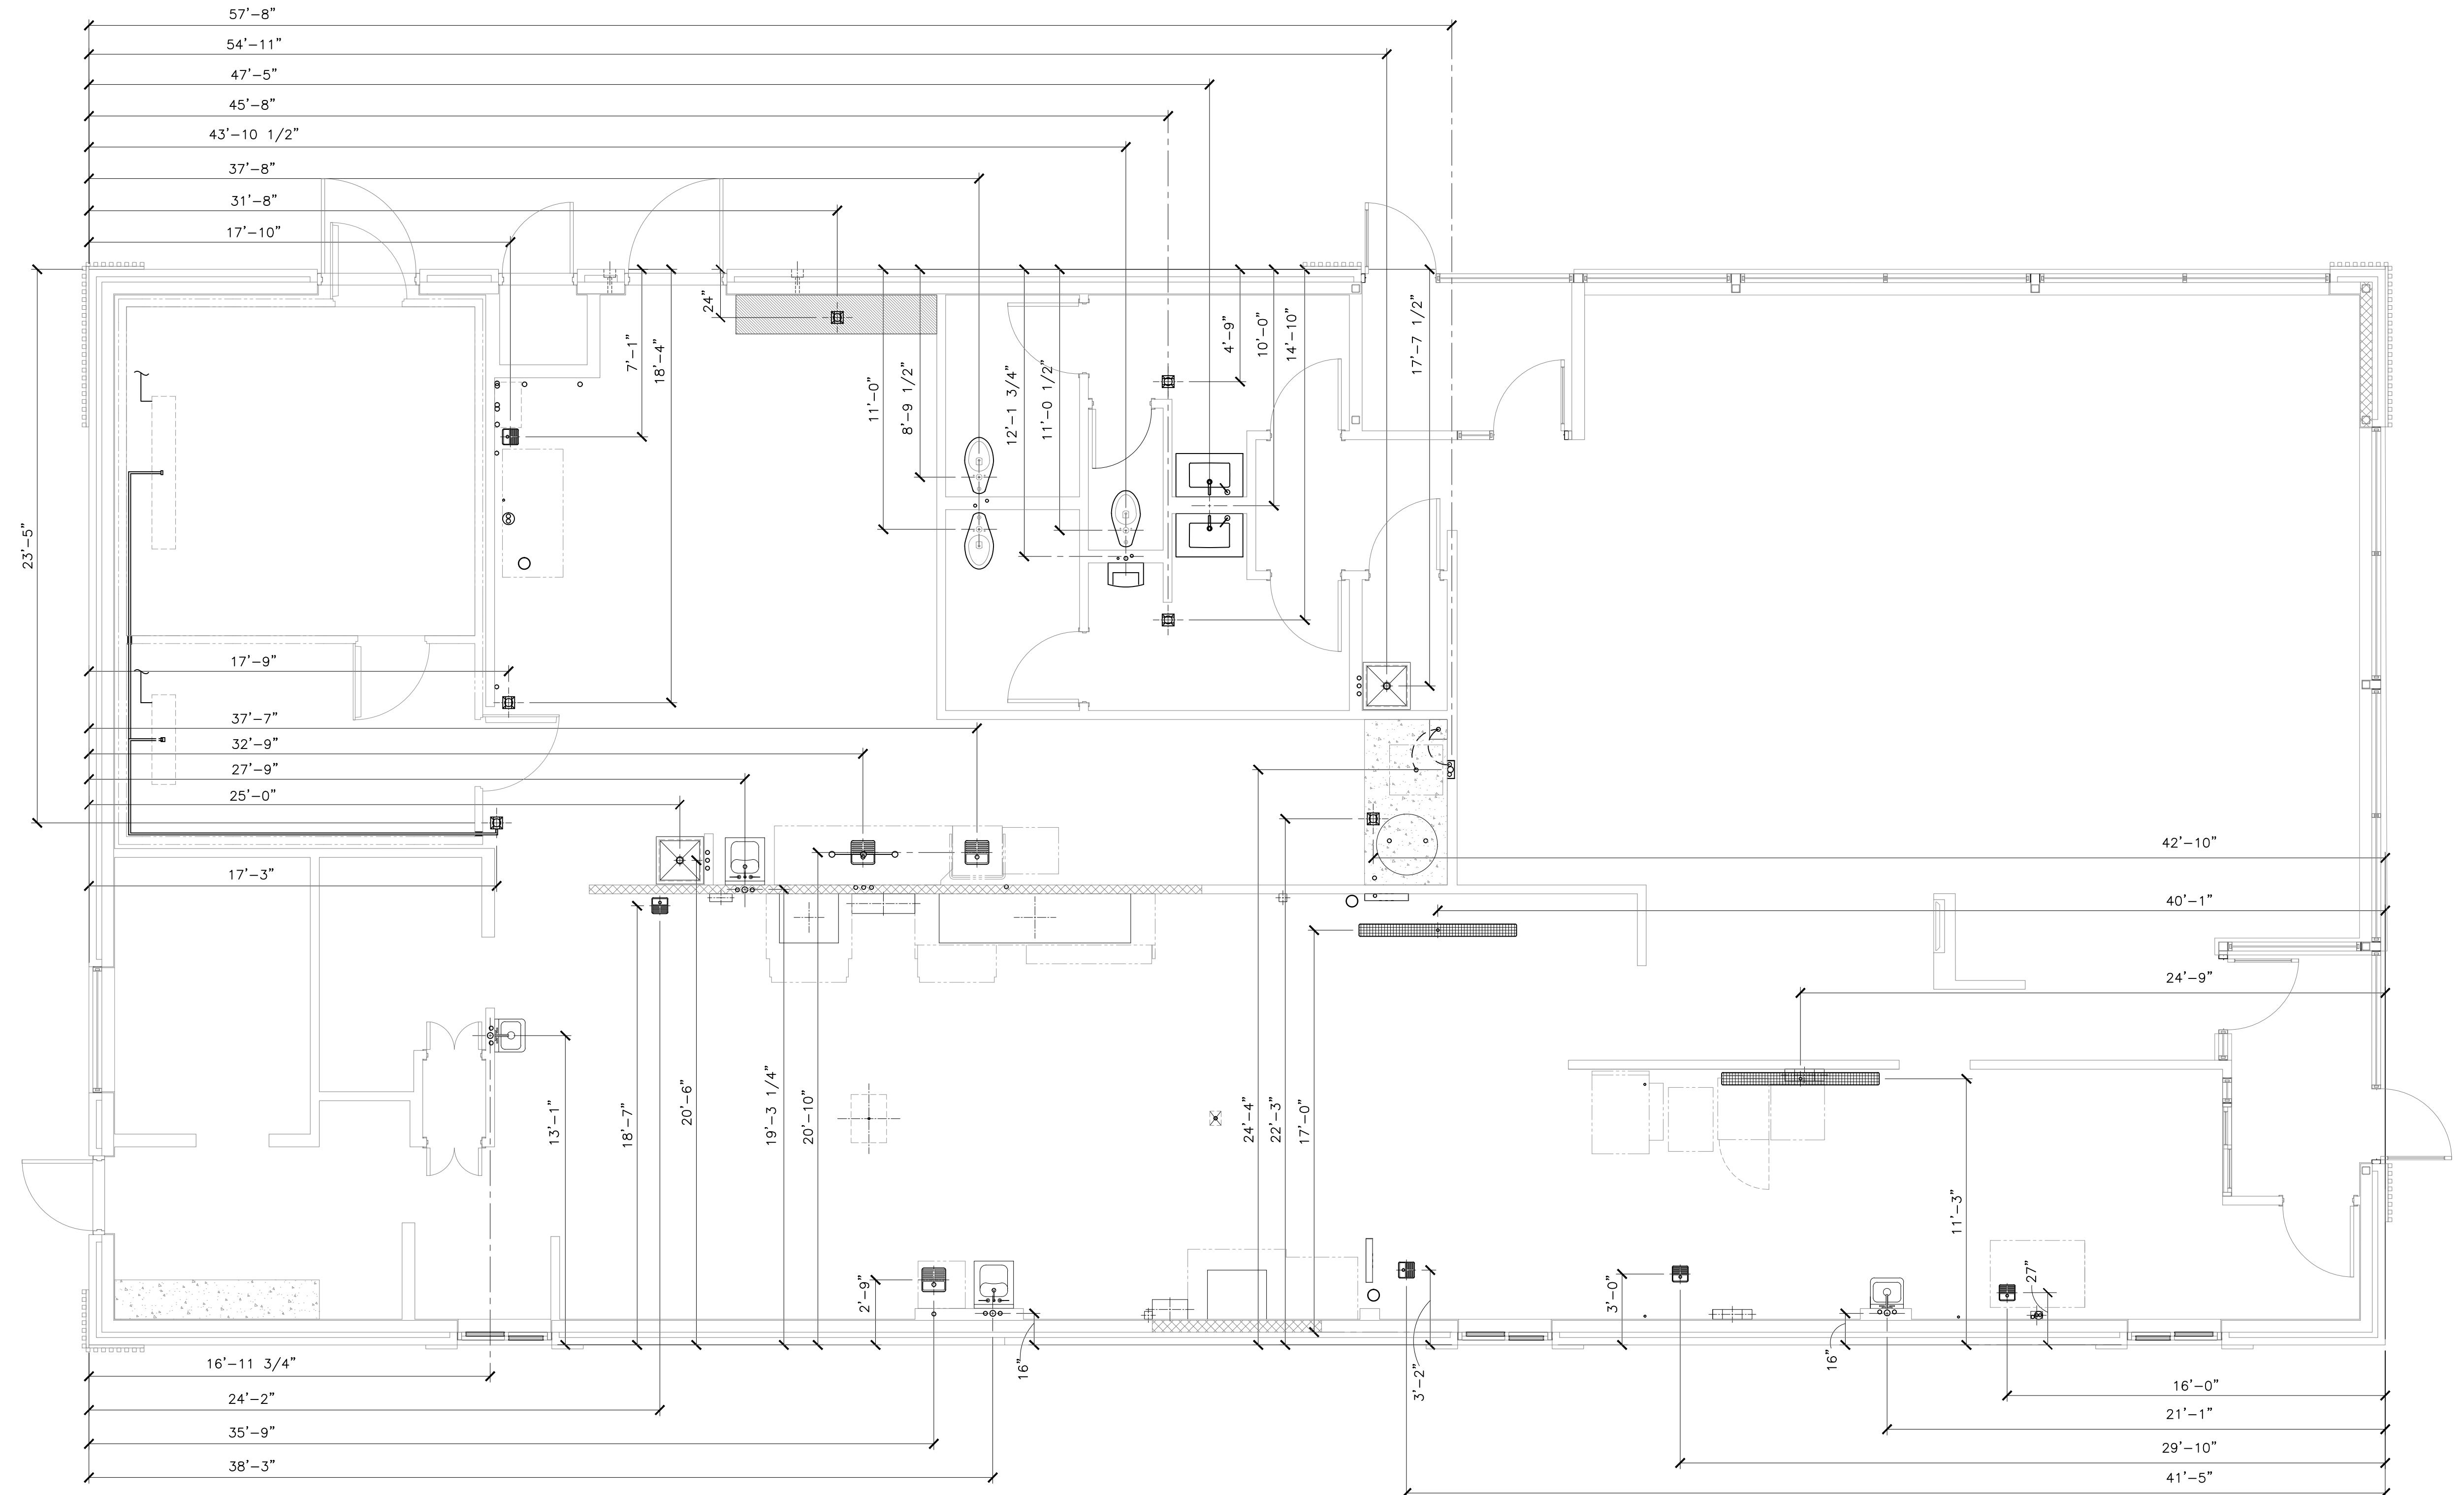

1 UNDERGROUND ROUGH-IN
P1.4 SCALE: 1/4" = 1'-0"


DRAWING NOTES

1. THIS PLAN IS PROVIDED AS A GUIDE FOR THE PLUMBING CONTRACTOR. ALL DIMENSIONS ARE ROUNDED TO THE NEAREST $\frac{1}{4}$ " AND ARE TAKEN FROM THE OUTSIDE EDGE OF THE FOUNDATION WALL TO CENTERLINE OF SLAB PENETRATION.

Robert D. Anderson, Inc.
MEP Engineering & Design Consultants
C* Illumination* Plumbing* Power Distribution* Controls

Robert D. Anderson
4403 Zion Rd.
Garland ,TX 75043

: 972-814-7324
l: robert.d.anderson@sbcglocal.net
ct: Mark Swanson-Project Manager

: 817-556-0986
: mark@mepdesigntx.com

FIELD CONDITIONS MAY BE REQUIRED; THIS DRAWING WAS
ED FOR SPECIFIC USE ON THE DATE AND SITE INDICATED HEREON.
THIS DRAWING FOR REFERENCE OR EXAMPLE ON ANOTHER
REQUIRES THE SERVICES OF THIS ENGINEER. DRAWINGS ARE
TO COPYRIGHT AND MAY NOT BE REPRODUCED, DISTRIBUTED,
ED OR USED IN ANY WAY WITHOUT THE EXPRESS WRITTEN
T OF ROBERT D. ANDERSON, P.E.

STATE OF TEXAS


Proprietary
reproduced
prepared
and are
use of
requires the
duction of
uthorized.

A, LL
ential and pro
ccped or r
ments were pr
ss issue date
er time. U
er project re
ans. Reprod
ct is not a

The confident
will not be
able to act docume
ntation with its
or at a lat
e on another
and enginee
another projec

ald's
tations are t
LLC and s
The contr
in conjunc
different site
e or exempl
architects
reuse on a

Donald's USA,
Authorization
specific site
use on a d
or reference
licensed
documents for

MCD[®] drawings
written on
this
sheet
are
not
suitable for
use in
drawings
of prop-
erly
contract doc-

The proposed without for us not these services the o

MES TTD ISSUE DATE
2023
REVIEWED BY JAW
DATE ISSUED
03/08/24
TEXAS

S E, DENTON

DR FINISHES
NGBIRD LAN

BUILDING
K VENEER
EXTERIOR
888 & HUMM

ARD BU
WOOD W/4" BRIC
RAMMING K/METAL PA
LESS H. LOOP 28


**STANDA
WOOD /**

WALLS	TRUSS F	BRICK
SHARING	OF	MATTEN/
J		SITE ADDR
		SEC OF S

2023	DESCRIPTION	STUCCO/E
4597-	WOOD BEA	
	WOOD RO	
		SITE ID
		042-3271

JAWA 24-0014

UNDERGROUND ROUGH-IN

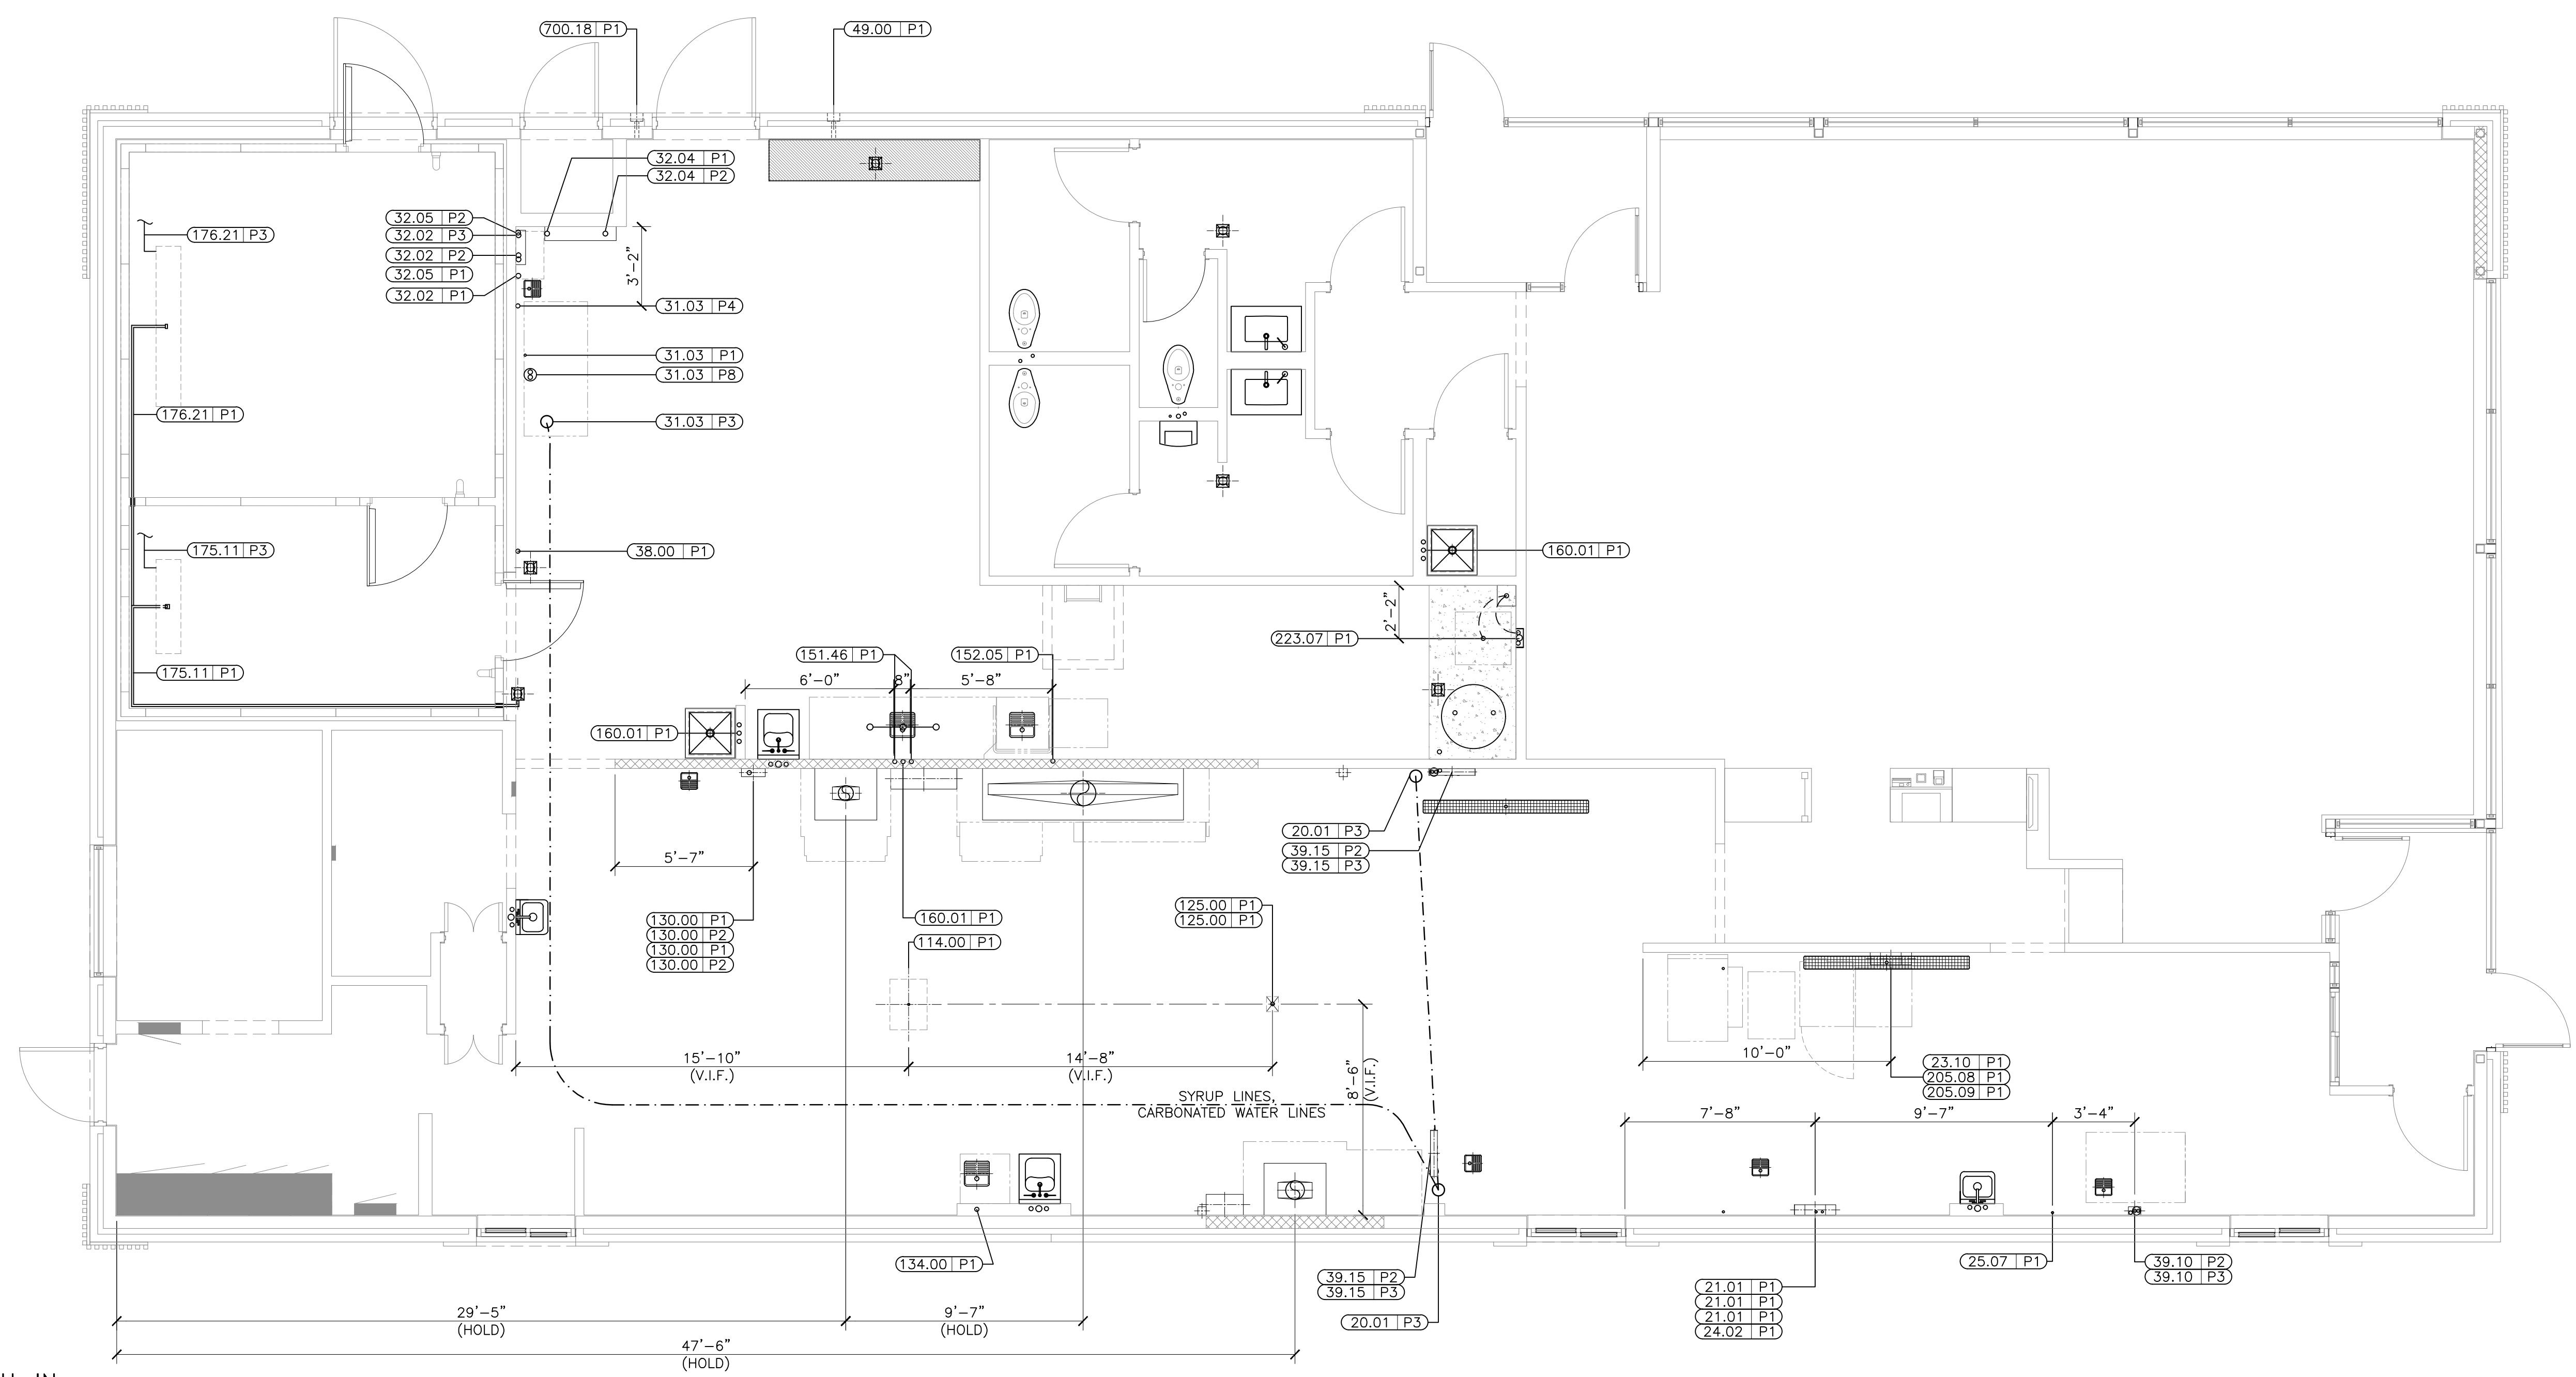

OVERHEAD ROUGH-IN

SCALE: 1/4" = 1'-0"

P1.6

VIF = Verify in Field
PC = Plumbing Contractor
BSI = Beverage System Installer

PLUMBING SCHEDULE

TAG #	QTY	DESCRIPTION	GAS TYPE	GAS BTU	GAS SIZE	HW	CW	MISC PLBG	HGT AFF	DRAIN	REQUIREMENTS & REMARKS
D20.01P3	2	AUTOMATED BEVERAGE SYSTEM 2.0	-	-	-	-	-	SODA BUNDLE	SEE RMKS	-	DN CHASE FROM SODA SYSTEM - "T" FROM D/T - BSI TO MAKE FINAL CONNECTIONS PER LOCAL CODES
D21.01P1	3	COFFEE BREWER (GLASS DECANTERS)	-	-	-	-	1/4"	-	SEE RMKS	-	DN CHASE FROM SODA SYSTEM - IF NO CHASE RUN IN 2"COND TO JB - BSI TO CONN CW LINE PER LOCAL CODES. 1/4" R.O. WATER OPTIONAL
D23.10P1	1	ESPRESSO BREWER	-	-	-	-	3/8"	-	SEE RMKS	3/8" IND	DN CHASE FROM R.O. SYSTEM - IF NO CHASE RUN IN 2"COND TO JB - BSI TO CONN CW LINE PER LOCAL CODES
D24.02P1	1	JUICE DISPENSER	-	-	-	-	1/2" FLTR	-	SEE RMKS	-	-
D25.07P1	1	INFUSION TEA BREWER - MIS	-	-	-	-	1/2"	3/8" CO2	SEE RMKS	-	DN CHASE FROM SODA SYSTEM - IF NO CHASE RUN IN 2"COND TO JB - BSI TO CONN CW LINE PER LOCAL CODES
D31.03P1	1	SODA SYSTEM PACKAGE B.I.B. (RECIRCULATING- 3 TOWERS)	-	-	-	-	-	3/8" OUTLET	SEE RMKS	-	FLEX LINE OVERHEAD TO VARIOUS EQUIP. BSI TO MAKE FINAL CONN PER LOCAL CODES
D31.03P3	1	SODA SYSTEM PACKAGE B.I.B. (RECIRCULATING- 3 TOWERS)	-	-	-	-	-	SODA BUNDLE	SEE RMKS	-	OVERHEAD TO SODA TOWER CHASE(S) - BSI TO MAKE FINAL CONNECTIONS PER LOCAL CODES
D31.03P4	1	SODA SYSTEM PACKAGE B.I.B. (RECIRCULATING- 3 TOWERS)	-	-	-	-	3/4"	-	SEE RMKS	3/4" IND	BSI TO MAKE CONNECTION FROM BACKFLOW PREVENTER (VERIFY HEIGHT IN FIELD)
D31.03P8	1	SODA SYSTEM PACKAGE B.I.B. (RECIRCULATING- 3 TOWERS)	-	-	-	-	-	REFRIG LINES	SEE RMKS	-	FROM REMOTE CONDENSING UNIT
D32.02P1	1	REVERSE OSMOSIS WATER FILTRATION SYSTEM - TANKLESS	-	-	-	-	3/8" FLTR	-	SEE RMKS	-	FLEX LINE OVERHEAD FROM SODA SYSTEM - BSI TO MAKE FINAL CONN PER LOCAL CODES
D32.02P2	1	REVERSE OSMOSIS WATER FILTRATION SYSTEM - TANKLESS	-	-	-	-	3/8" OUTLET	SEE RMKS	-	SEE RMKS	FLEX LINE OVERHEAD TO RAPID STEAMER, ESPRESSO, AND COFFEE (OPT.) - BSI TO MAKE FINAL CONN PER LOCAL CODES
D32.02P3	1	REVERSE OSMOSIS WATER FILTRATION SYSTEM - TANKLESS	-	-	-	-	-	1/4" WASTE	-	-	DN CHASE IF NO CHASE RUN IN 2"COND TO JB - BSI TO MAKE FINAL CONN PER LOCAL CODES
D32.04P1	1	WATER FILTRATION SYSTEM	-	-	-	-	3/4" INLET	6'-0"	-	SEE RMKS	3/4" GHT RINSE CONN. FLEX LINE OVHD. TO RAPID STEAMER, ESPRESSO, & COFFEE (OPT.) - BSI TO MAKE FINAL CONN PER LOCAL CODE
D32.04P2	1	WATER FILTRATION SYSTEM	-	-	-	-	3/4" OUTLET	-	-	SEE RMKS	SEE RMKS
D32.05P1	1	WATER FILTRATION SYSTEM	-	-	-	-	3/4" INLET	SEE RMKS	-	SEE RMKS	FLEX LINE OVERHEAD FROM R.O. SYSTEM - BSI TO MAKE FINAL CONN PER LOCAL CODES
D32.05P2	1	WATER FILTRATION SYSTEM	-	-	-	-	3/4" OUTLET	SEE RMKS	-	SEE RMKS	FLEX LINE OVERHEAD TO COMBI OVENS AND STAGING CABINET - BSI TO MAKE FINAL CONN PER LOCAL CODES
D38.00P1	1	CLEAN IN PLACE PANEL	-	-	-	-	1/2" FLTR	-	SEE RMKS	-	FOR CLEANING BULK COKE TANKS. INSTALL HEIGHT TO BOTTOM OF UNIT
D39.10P2	1	ICE MACHINE - 1400 LB.	-	-	-	-	1/2" FLTR	-	SEE RMKS	3/4" IND	WATER LINE OVERHEAD FROM SODA SYSTEM - BSI TO MAKE FINAL CONNECTIONS PER LOCAL CODES

PLUMBING SCHEDULE

TAG #	QTY	DESCRIPTION	GAS TYPE	GAS BTU	GAS SIZE	HW	CW	MISC PLBG	HGT AFF	DRAIN	REQUIREMENTS & REMARKS
O39.10P3	1	ICE MACHINE - 1400 LB.	-	-	-	-	-	-	-	-	REFRIGERATION LINES OVERHEAD FROM REMOTE CONDENSING UNIT
O39.15P2	2	ICE MACHINE - 1000 LB.	-	-	-	-	-	-	1/2"	-	SEE RMKS 3/4" IND
O39.15P3	2	ICE MACHINE - 1000 LB.	-	-	-	-	-	-	-	-	REFRIGERATION LINES OVERHEAD FROM REMOTE CONDENSING UNIT
O49.00P1	1	CO2 FILL BOX	-	-	-	-	-	-	-	-	HEIGHT IS TO BOTTOM OF FILL BOX; SUPPLIED BY MANUFACTURER; INSTALLED BY G.C. SEE BUILDING ELEVATIONS.
114.00P1	1	HUMIDIFIED HOLDING CABINET	-	-	-	-	-	3/8" R.O.	-	-	SEE RMKS - BSI EXTENDS CW LINE OVERHEAD FROM R.O. SYSTEM & TERM. W/QUICK DISCONN. AND SHUTOFF.
125.00P1	2	RAPID BUN STEAMER	-	-	-	-	-	3/8" R.O.	-	-	SEE RMKS - BSI EXTENDS CW LINE FROM R.O. SYSTEM & TERM. W/QUICK DISCONN.
130.00P1	2	COMBI OVEN	-	-	-	-	-	1/2" FLTR	-	-	SEE RMKS 1 1/2" IND BSI EXTENDS CW LINE OVERHEAD FROM SODA SYSTEM & TERM. W/QUICK DISCONN. AND SHUTOFF.
130.00P2	2	COMBI OVEN	-	-	-	-	-	3/8" R.O.	-	-	SEE RMKS - BSI EXTENDS CW LINE OVERHEAD FROM R.O. SYSTEM & TERM. W/QUICK DISCONN. AND SHUTOFF.
134.00P1	1	VEGETABLE SINK	-	-	-	-	-	3/4"	-	-	1' - 10" 1 - 1/2" IND
151.46P1	1	SOILED DISHABLE - RIGHT HAND - 90.5" WIDE	-	-	-	-	-	3/4" 3/4"	-	-	PC MAKES FINAL CONNECTIONS PER LOCAL CODE
152.05P1	1	WAREWASHER (WITH VAPOR VENT) - UPRIGHT	-	-	-	-	1/2"	1/2"	-	-	SEE RMKS 2" INDIRECT PC TO PROVIDE HW, CW, INDIRECT DRAIN PIPING AND MAKE ALL FINAL CONNECTIONS. HW @ 5'-2" AFF, CW @ 4'-10" AFF, DRAIN @ 9"
160.01P1	3	CHEMICAL SYSTEM	-	-	-	-	-	3/4"	-	-	SEE RMKS - PC TO PROVIDE 3/4" MHT. FINAL CONNECTIONS BY EQUIPMENT INSTALLER PER LOCAL CODE. SEE SHEET 3 FOR INSTALLATION HEIGHT.
175.08P1	1	COOLER EVAPORATOR	-	-	-	-	-	-	-	-	3/4" COND. PC TO ROUTE CONDENSATE DRAIN LINE TO FLOOR DRAIN. PC TO LIQUID-TIGHT SEAL OPENING FOR LINE EXITING BOX. HEAT TAPE BY REFRIG. CONTRACTOR
175.08P3	1	COOLER EVAPORATOR	-	-	-	-	-	-	-	-	SEE RMKS 1" IND PC TO ROUTE CONDENSATE DRAIN LINE TO FLOOR DRAIN. PC TO LIQUID-TIGHT SEAL OPENING FOR LINE EXITING BOX. HEAT TAPE BY REFRIG. CONTRACTOR
176.19P1	1	FREEZER EVAPORATOR	-	-	-	-	-	-	-	-	3/4" COND. PC TO ROUTE CONDENSATE DRAIN LINE TO FLOOR DRAIN. PC TO LIQUID-TIGHT SEAL OPENING FOR LINE EXITING BOX. HEAT TAPE BY REFRIG. CONTRACTOR
176.19P3	1	FREEZER EVAPORATOR	-	-	-	-	-	-	-	-	SEE RMKS 1" IND PC TO ROUTE CONDENSATE DRAIN LINE TO FLOOR DRAIN. PC TO LIQUID-TIGHT SEAL OPENING FOR LINE EXITING BOX. HEAT TAPE BY REFRIG. CONTRACTOR
205.08P1	1	BIC MACHINE	-	-	-	-	-	1/2" FLTR	-	-	SEE RMKS 1" IND DN CHASE. IF NO CHASE RUN IN 2"COND TO JB - BSI TO CONNECT LINES PER LOCAL CODES.
205.09P1	1	FROZEN BEVERAGE DISPENSER	-	-	-	-	-	1/2" FLTR	3/8" CO2	SEE RMKS -	DN CHASE. IF NO CHASE RUN IN 2"COND TO JB - BSI TO CONNECT LINES PER LOCAL CODES.
223.07P1	1	WASHER	-	-	-	-	-	3/4"	3/4"	-	4'-0" 1 1/2" D SEE PLUMBING DWGS FOR WALL BOX. INSTALL HEIGHT IS TO BOTTOM OF THE BOX
700.18P1	1	BULK OIL FILL BOX	-	-	-	-	-	-	-	-	HEIGHT IS TO BOTTOM OF FILL BOX; SUPPLIED BY MANUFACTURER; INSTALLED BY G.C. SEE BUILDING ELEVATIONS.


McDonald's USA, LLC


These drawings and specifications are the confidential and proprietary property of McDonald's USA, LLC and shall not be copied or reproduced without the express written consent of McDonald's USA, LLC. These drawings and specifications are for the use of the architect and engineer in connection with the design and construction of the project. They are not to be reproduced for reference or example on another project or for other licensed architects and engineers. Reproduction of these drawings and specifications is not authorized.

PREPARED FOR: **McDonald's USA, LLC**
DRAWN BY: MES DRAWN DATE: 2023-07-20
STD ISSUE DATE: 2023-07-20
REV JAW REVIEWED BY: JAW DATE ISSUED: 2023-07-24
SHEET NO.: 042-3271 SITE ADDRESS: SEC OF S.H. LOOP 288 & HUMMINGBIRD LANE, DENTON, TEXAS
TITLE: 2023 STANDARD BUILDING - BB20
DESCRIPTION: WOOD BEARING WALLS W/4" BRICK VENEER
STUCCO/BATEN/BRICK METAL PANEL EXTERIOR FINISHES
SITE ID: P1.6
SHEET NO.: 042-3271 SEC OF S.H. LOOP 288 & HUMMINGBIRD LANE, DENTON, TEXAS
TITLE: P1.6
DESCRIPTION: OVERHEAD ROUGH-IN

Robert D. Anderson, Inc.
MEP Engineering & Design Consultants
HVAC/Illumination/Plumbing/Power Distributor/Control
Robert D. Anderson
4405 Zinn Rd.
Garland, TX 75043
voice: 972-814-7224
email: robert.anderson@bigslegal.net
contact: Mark Swanson Project Manager
voice: 817-556-0986
email: mark@mtdesigns.com
DRAWING IS DIAGRAMATIC AND AS SUCH ADJUSTMENTS FOR EXACT CONSTRUCTION ARE NOT MADE. THIS DRAWING IS PREPARED FOR SPECIFIC USE ON THE DATE AND IN THE LOCATION INDICATED. IT IS THE RESPONSIBILITY OF THE USER TO CHECK THE DRAWINGS FOR ACCURACY AND FOR CONFORMITY WITH APPLICABLE CODES AND STANDARDS. THIS DRAWING IS THE PROPERTY OF THE DESIGNER AND IS PROVIDED FOR THE USE OF THE CONTRACTOR. THE CONTRACTOR IS NOT TO REPRODUCE THESE DRAWINGS OR ANY PORTION THEREOF WITHOUT THE EXPRESS WRITTEN CONSENT OF THE DESIGNER.



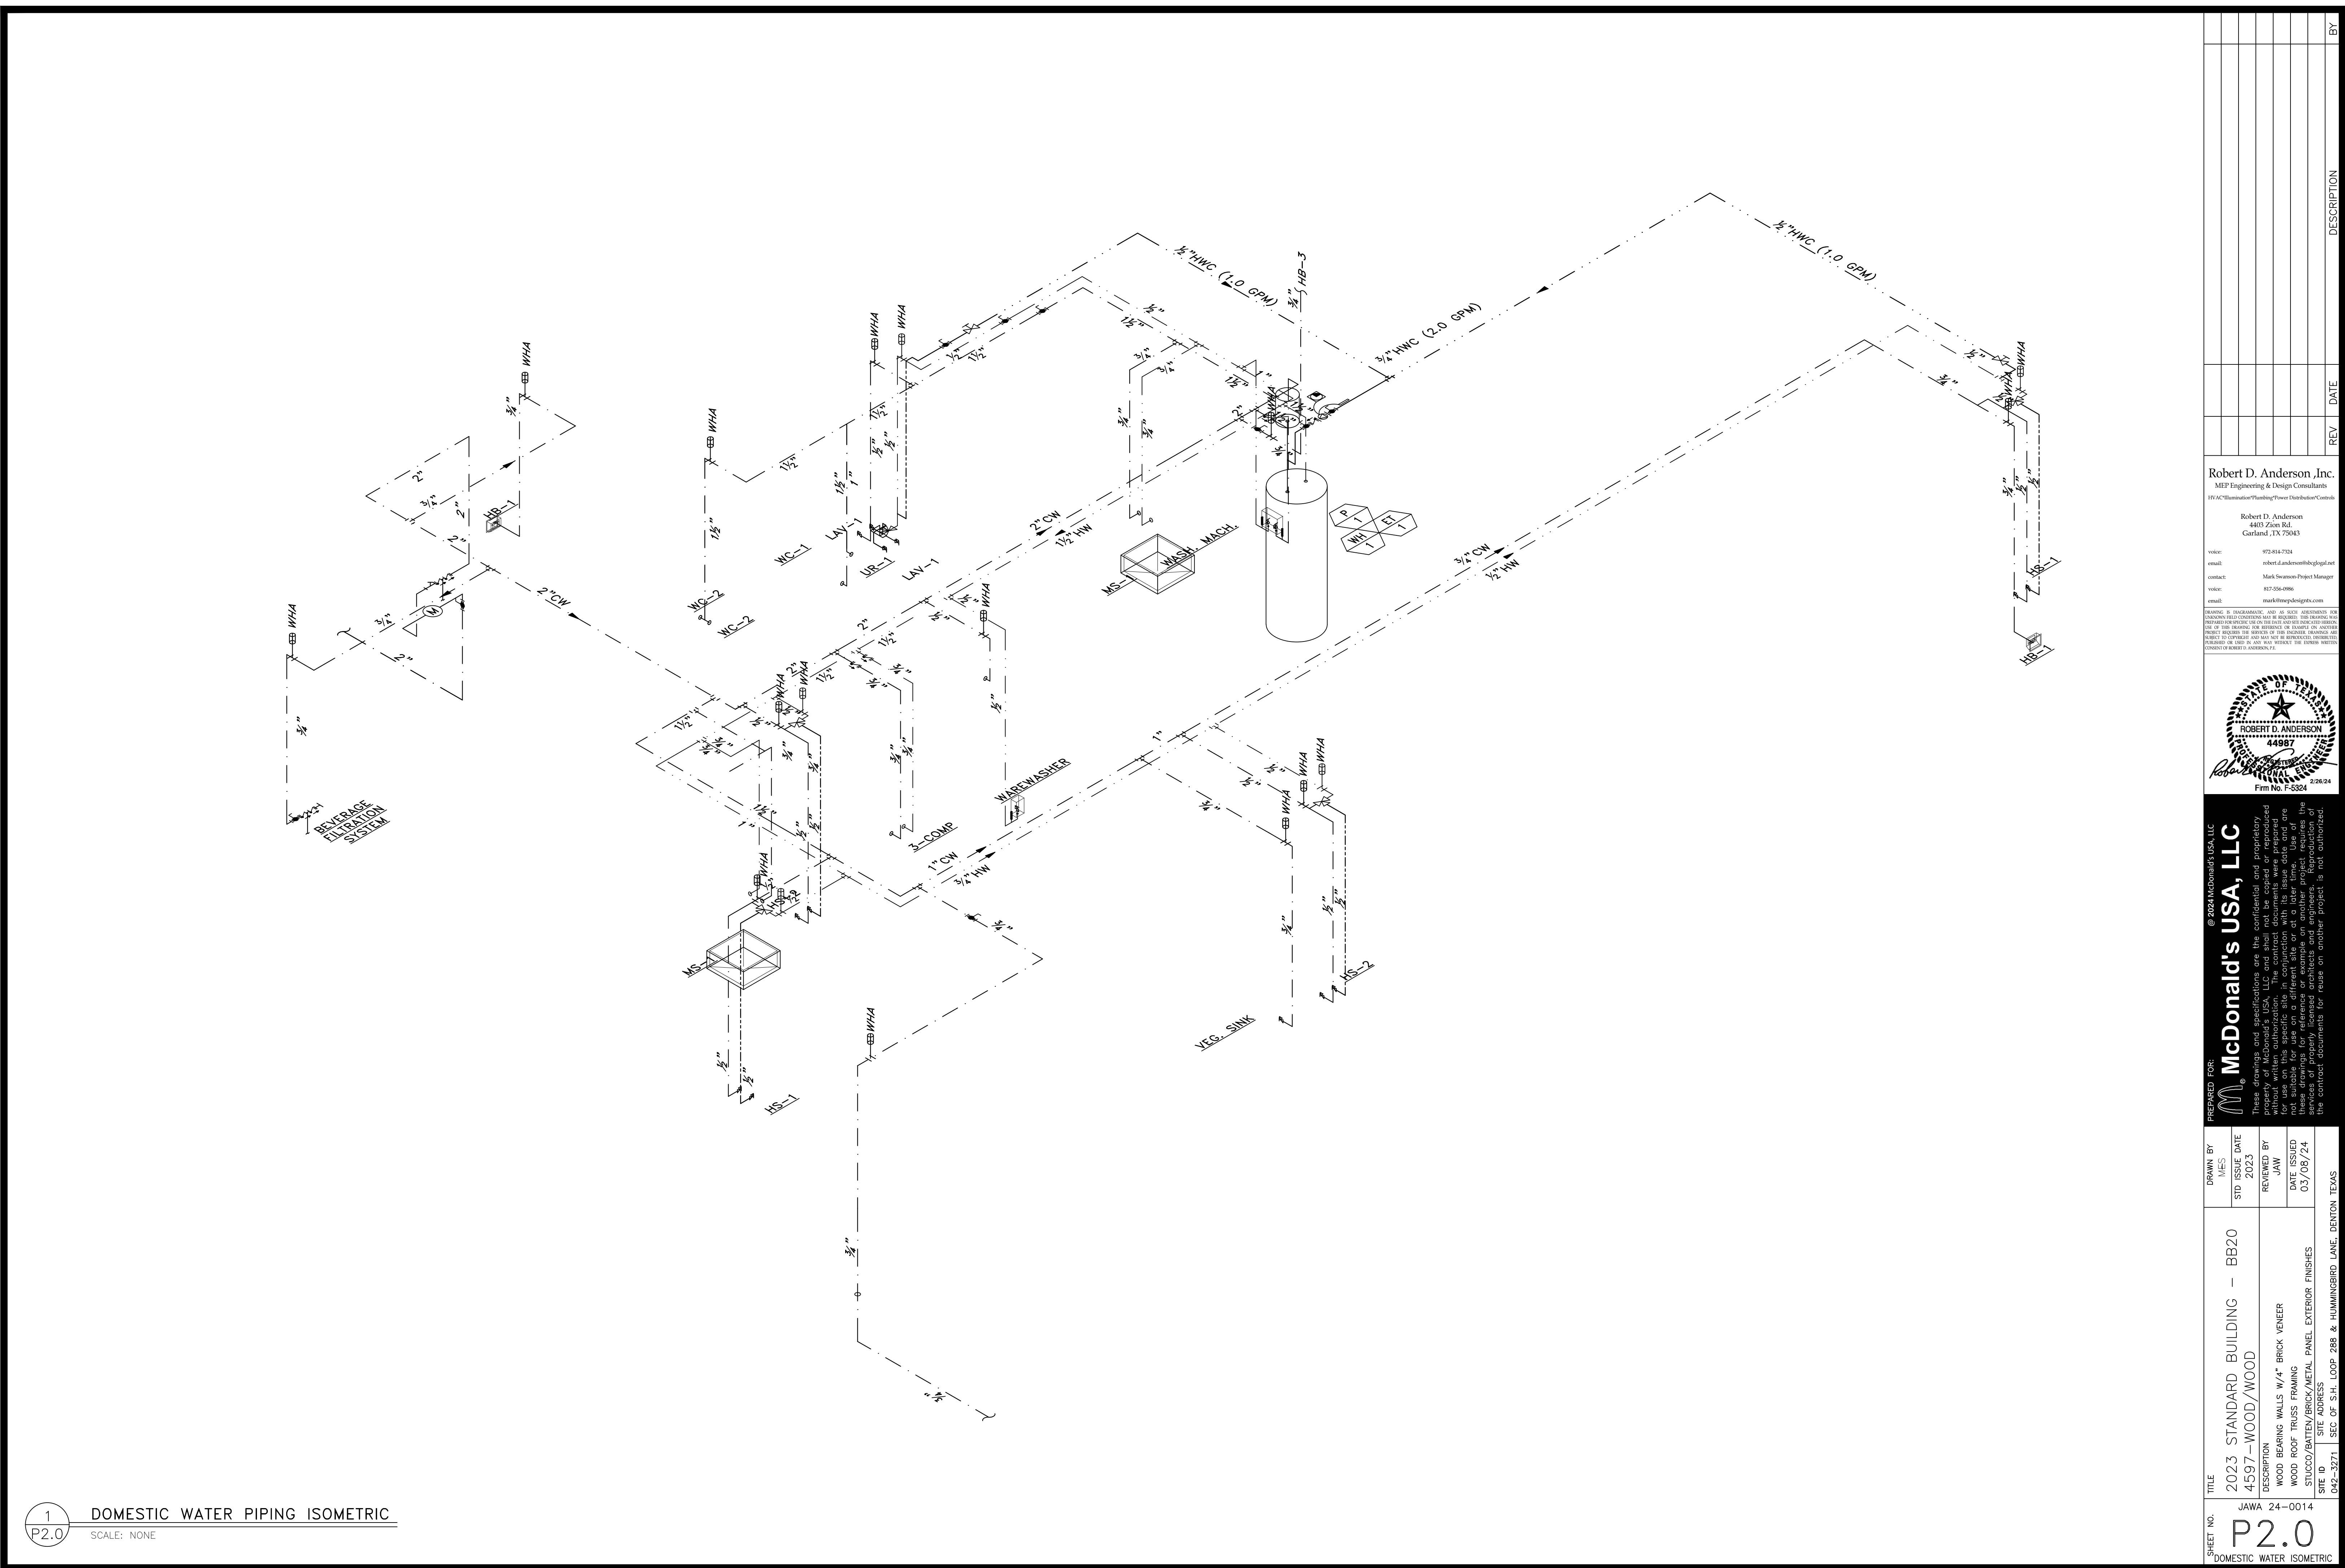


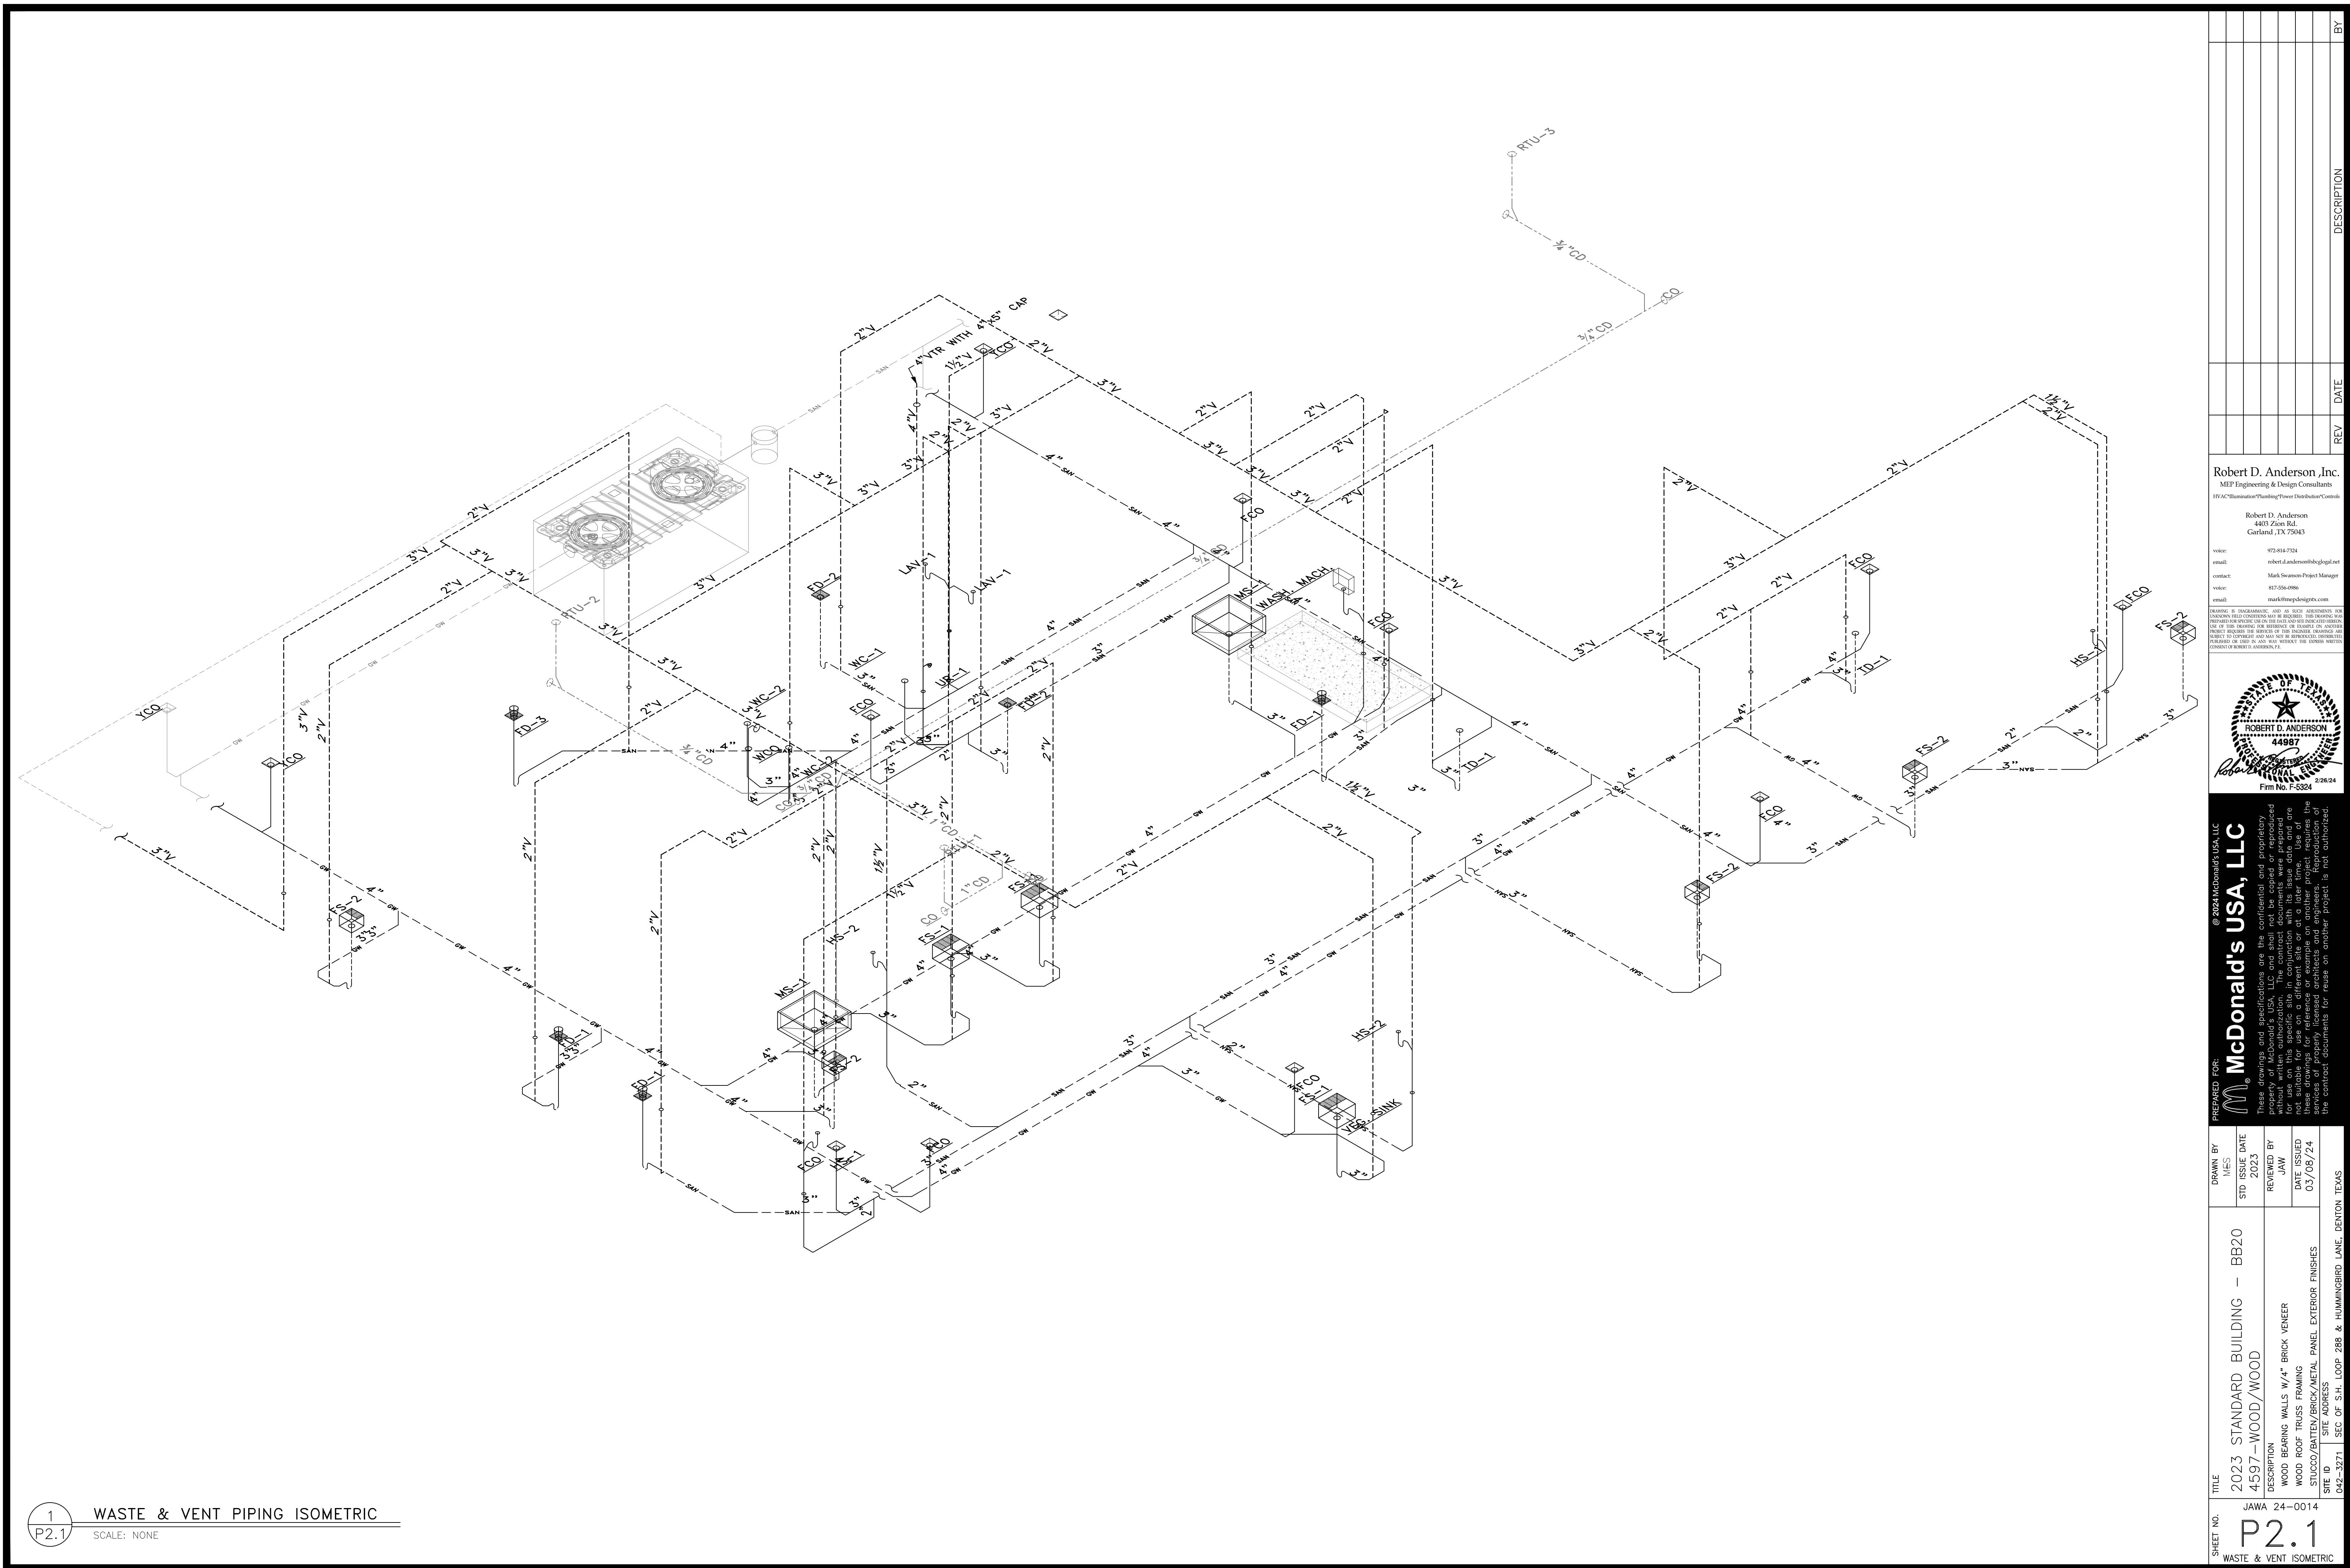


STORM PIPING ISOMETRIC

SHEET NO.	TITLE		
	2023 STANDARD BUILDING – BB20 4597-WOOD/WOOD		
	PREPARED FOR:		
	 McDonald®		
	These drawings and specifications are property of McDonald's USA, LLC and without written authorization. The drawings for use on this specific site in conjunction with other documents or services may be not suitable for use on a different site. These drawings for reference or examination services of properly licensed architect or the contract documents for reuse or modification.		
	DRAWN BY MES	STD ISSUE DATE 2023	REVIEWED BY JAW
	DESCRIPTION WOOD BEARING WALLS W/4" BRICK VENEER WOOD ROOF TRUSS FRAMING STUCCO/BATTEN/BRICK/METAL PANEL EXTERIOR FINISHES	DATE ISSUED 03/08/24	SITE ID 042-3271 SITE ADDRESS JAWA 24-0014 2023 STORM ISOMETRIC
			

The image shows the official logo for McDonald's USA, LLC. It features a large, stylized lowercase 'm' on the left, followed by the words 'McDonald's' in a bold, serif font, and 'USA, LLC' in a smaller, sans-serif font. A registered trademark symbol (®) is positioned at the bottom right of the 'LLC' text.

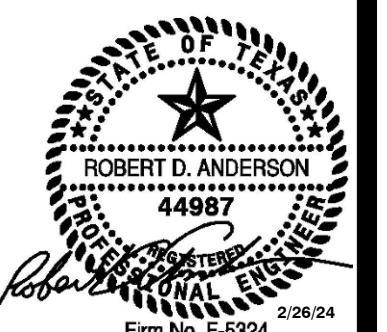

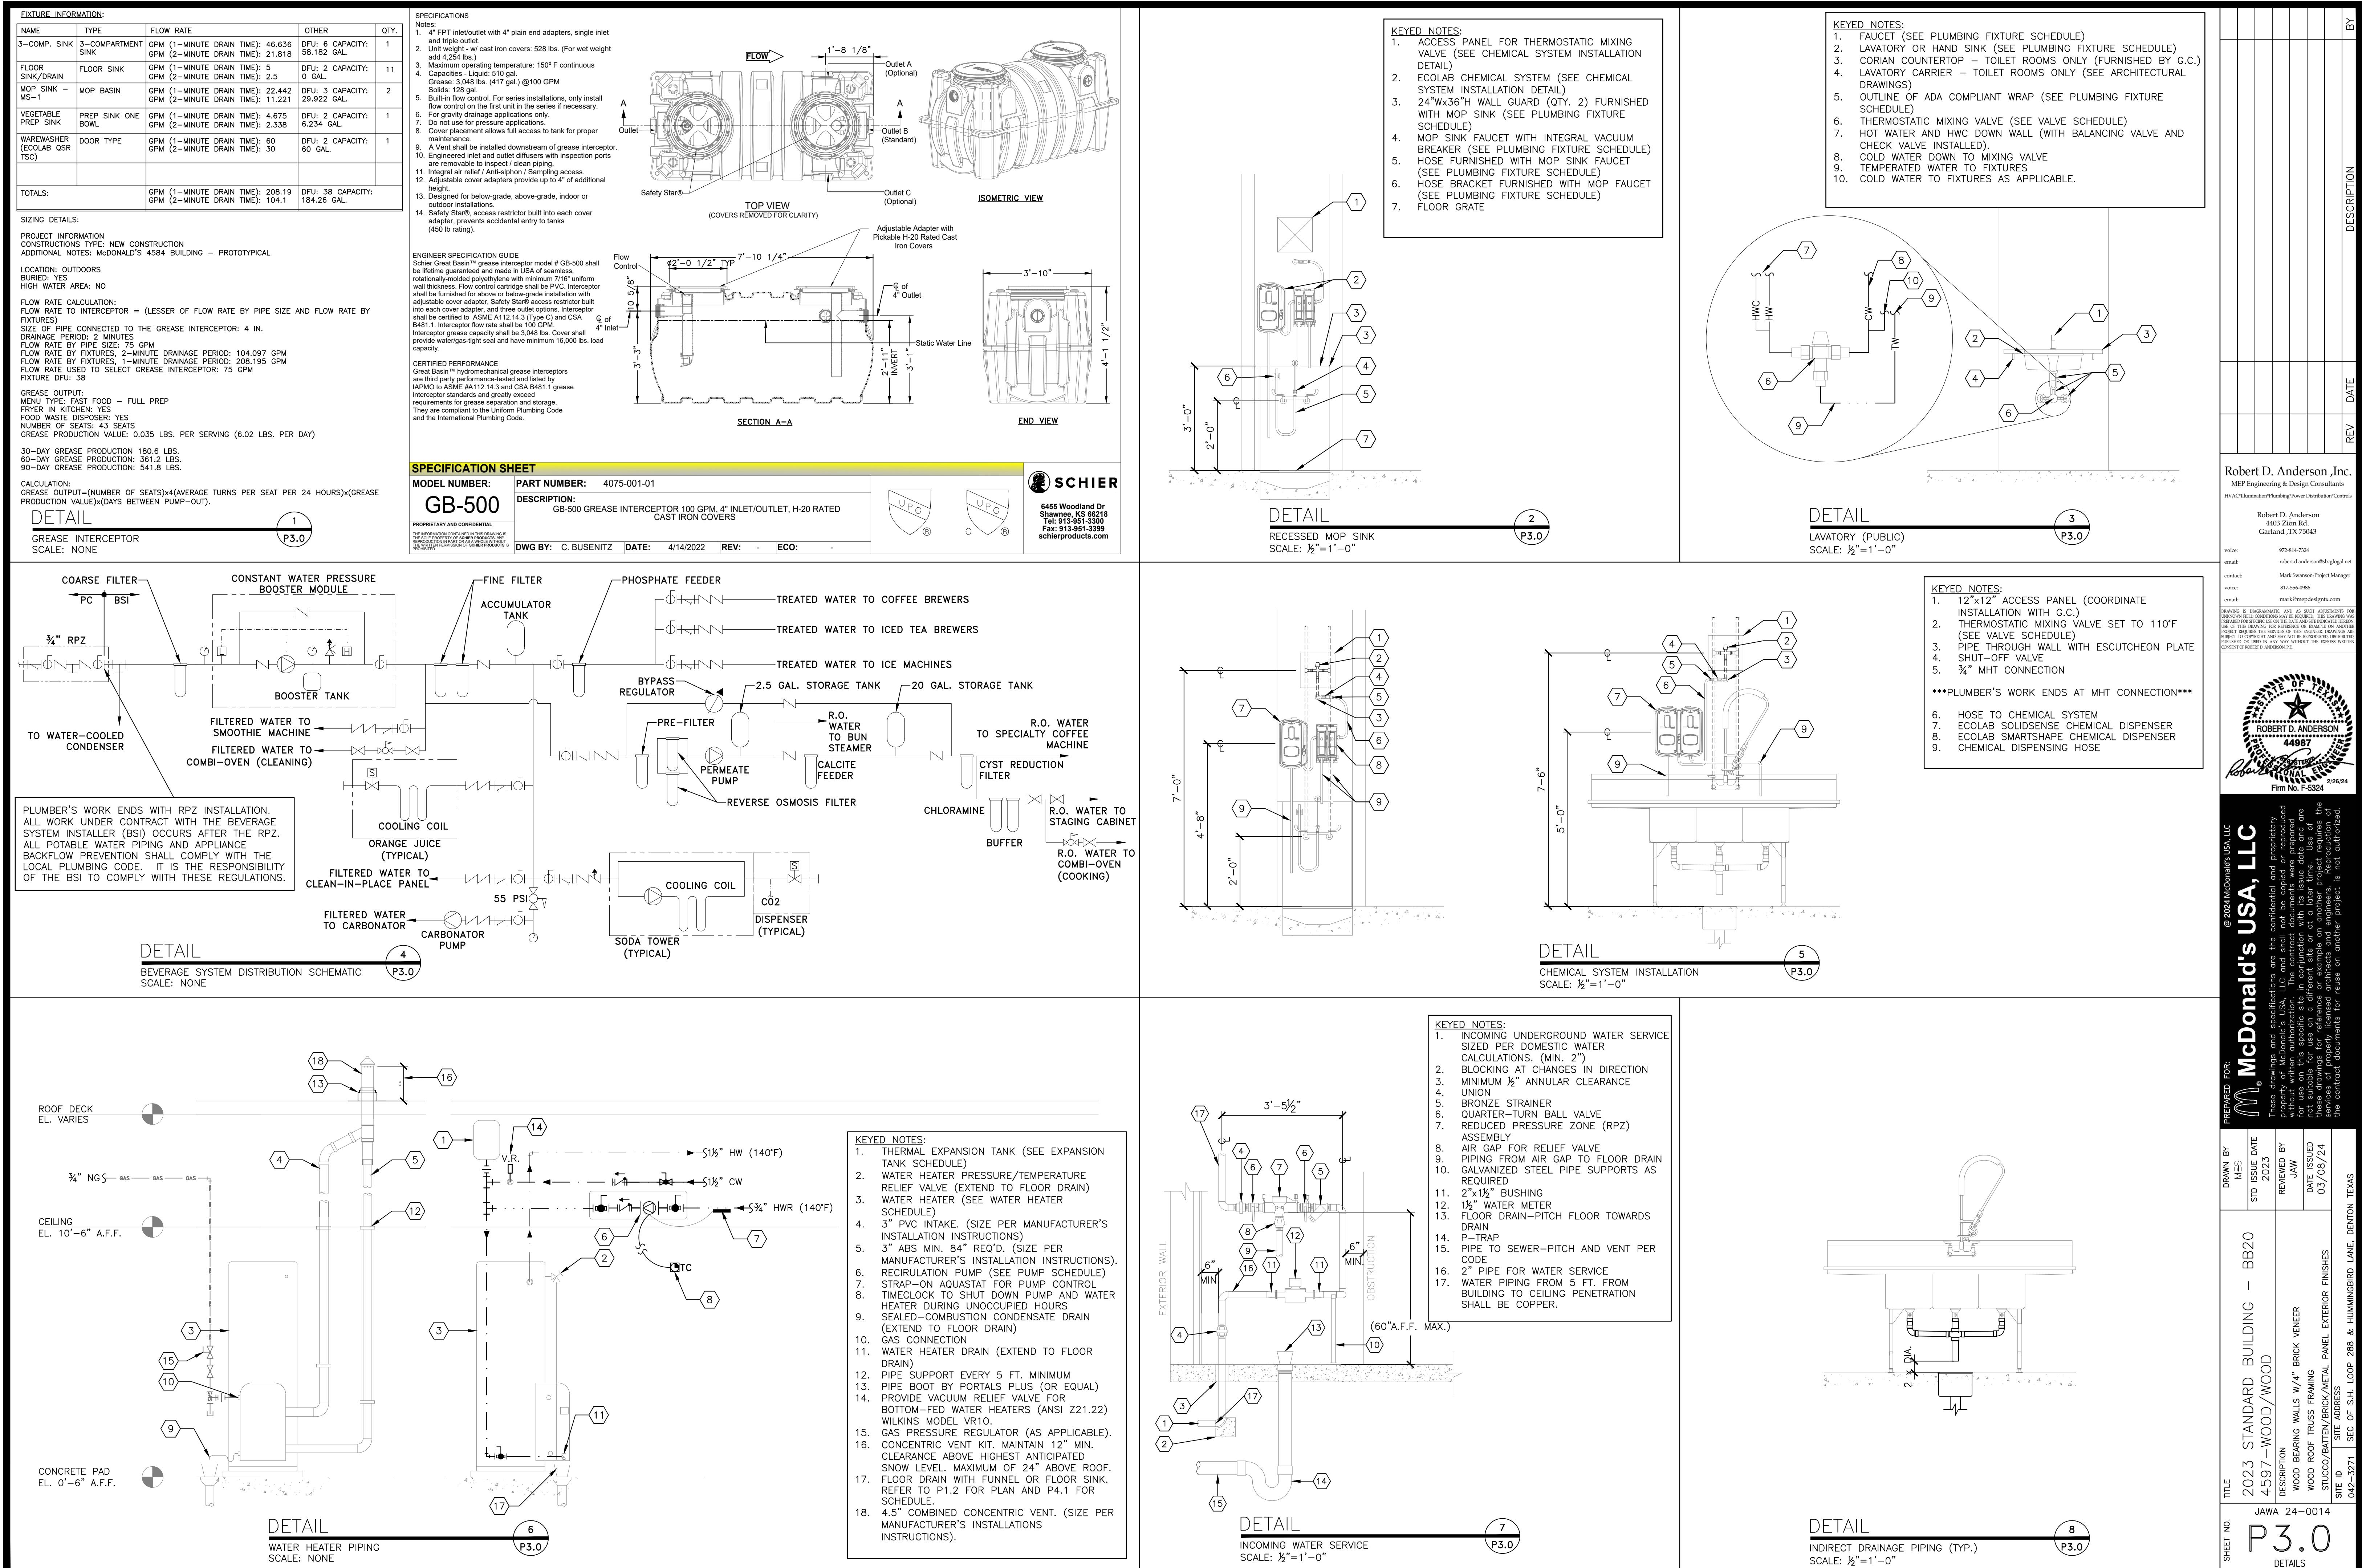

GENERAL PLUMBING NOTES

- GENERAL:**
- ALL WORK PERFORMED SHALL BE IN ACCORDANCE WITH ALL LOCAL CODES AND ACCEPTABLE TO THE AUTHORITY HAVING JURISDICTION.
 - ALL PLUMBING WORK SHALL BE PERFORMED BY A LICENSED PLUMBER.
 - ALL DIMENSIONS, CLEARANCES AND TOLERANCES SHALL BE VERIFIED PRIOR TO INSTALLATION. ALL ROUGH-IN LOCATIONS SHALL BE COORDINATED WITH THE MANUFACTURER'S SUBMITTAL INFORMATION.
 - ALL DIMENSIONAL INFORMATION IS AS FOLLOWS (UNLESS NOTED OTHERWISE):
 - UNDERGROUND PIPE IS TO FOUNDATION
 - OVERHEAD PIPE IS TO FINISHED WALL
 - ELEVATIONS ARE TO FINISHED FLOOR
 - ALL MATERIALS, FIXTURES AND EQUIPMENT USED SHALL BE IN ACCORDANCE WITH McDONALD'S SPECIFICATIONS. SPECIFICATIONS ARE CONTAINED WITHIN THESE DRAWINGS AND THE McDONALD'S PROJECT MANUAL. ANY CONTRACTOR IN NEED OF A COPY OF THE McDONALD'S PROJECT MANUAL SHALL CONTACT THE McDONALD'S AREA CONSTRUCTION MANAGER. ANY VARIANCE FROM THE McDONALD'S SPECIFICATIONS SHALL BE REVIEWED AND APPROVED BY THE ENGINEER-OF-RECORD.
 - SEE COORDINATION SCHEDULE FOR ADDITIONAL SCOPE OF WORK.
 - ALL EQUIPMENT SHALL BE INSTALLED IN ACCORDANCE WITH ITS LISTING AND/OR THE MANUFACTURER'S INSTALLATION INSTRUCTIONS.
 - WHERE POOR SOIL CONDITIONS EXIST OR WHERE SUBSTANTIAL SETTLEMENT OF EITHER THE PIPING, THE BUILDING OR ADJACENT WALKS, PLANTERS, ETC., MAY OCCUR, THE CONTRACTOR SHALL PROVIDE ADEQUATE UNDERSLAB STAINLESS STEEL PIPE HANGERS OR APPROVED OTHER SUPPORT.
 - ALL PIPE SLEEVES SHALL BE PROPERLY SEALED AND INSULATED TO PREVENT HEAT LOSS AND SEEPAGE.
 - ALL PIPE INSULATION SHALL BE PROTECTED FROM DAMAGE FROM PIPE HANGERS. PROTECTION SHALL BE LIGHT GAUGE GALVANIZED STEEL OR EQUAL.
 - ALL PENETRATIONS OF FIRE-RATED WALLS SHALL BE FIRESTOPPED WITH AN APPROVED AND LISTED FIRESTOPPING SYSTEM.

SANITARY AND VENT SYSTEMS:

- THE BUILDING SANITARY PIPE SHALL BE LOCATED A MINIMUM OF 10 FT. FROM THE INCOMING WATER SERVICE. WHERE A 10 FT. SEPARATION IS NOT POSSIBLE, THE BOTTOM OF THE WATER SERVICE PIPE SHALL BE A MINIMUM OF 12 IN. ABOVE THE TOP OF THE HIGHEST POINT OF THE SANITARY PIPE.
- ALL SANITARY AND VENT PIPE SHALL BE PVC TYPE DWV, ABS OR CAST-IRON WHERE REQUIRED BY CODE.
- ALL HORIZONTAL SANITARY PIPE SHALL BE INSTALLED WITH A MINIMUM PITCH AS FOLLOWS:

PIPE SIZE	MIN. SLOPE
2½" OR LESS	¼" PER FT.
3" TO 6"	⅜" PER FT.
8" OR LARGER	⅜" PER FT. (MIN.)

- CLEANOUTS SHALL BE INSTALLED IN ALL HORIZONTAL DRAINAGE PIPE AND SHALL BE LOCATED NOT MORE THAN 100 FT. APART. (UNLESS OTHERWISE dictated BY LOCAL CODES).
- CLEANOUTS SHALL BE INSTALLED AT ALL CHANGES OF DIRECTION GREATER THAN 45 DEGREES. WHERE MORE THAN ONE CHANGE OF DIRECTION OCCURS IN A SINGLE PIPE RUN, ONLY ONE (1) CLEANOUT SHALL BE REQUIRED FOR EVERY 40 FEET OF DEVELOPED LENGTH.
- CLEANOUTS SHALL BE INSTALLED ON PIPES PRIOR TO ANY SLAB PENETRATION.
- WHERE PIPING IS LOCATED WITHIN WALL CAVITIES, ACCESS TO THE CLEANOUTS SHALL BE PROVIDED.
- CLEANOUTS ON 6-IN. AND SMALLER PIPES SHALL BE PROVIDED WITH A CLEARANCE OF NOT LESS THAN 18 IN. CLEANOUTS ON 8-IN. AND LARGER PIPE SHALL BE PROVIDED WITH A CLEARANCE OF NOT LESS THAN 36 IN.
- ALL SUSPENDED SANITARY AND VENT PIPE SHALL BE SUPPORTED AS FOLLOWS:

MATERIAL	MAX. HORIZ. SPACING	MAX. VERT. SPACING
ABS	4 FT.	10 FT.
PVC (TYPE DWV)	4 FT.	10 FT.
CAST-IRON (<10 FT. PIPE SECTIONS)	5 FT.	15 FT.
CAST-IRON (10 FT. PIPE SECTIONS)	10 FT.	15 FT.

- ALL PLUMBING FIXTURES SHALL BE VENTED AND THE MAXIMUM DISTANCE FROM THE FIXTURE TRAP TO THE VENT SHALL BE AS FOLLOWS:

TRAP SIZE	SLOPE	DISTANCE
1½"	¼" PER FT.	2'-6"
1½"	¼" PER FT.	3'-6"
2"	¼" PER FT.	5'-0"
3"	⅜" PER FT.	6'-0"
4" & LARGER	⅜" PER FT.	10'-0"

- ALL PLUMBING VENTS THROUGH THE ROOF SHALL TERMINATE A MINIMUM OF 12 INCHES ABOVE THE ROOF AND SHALL BE LOCATED A MINIMUM OF 8 FT. FROM ANY PARAPET WALL. WHERE A VENT TERMINATES WITHIN 8 FT. OF A PARAPET WALL, THE VENT SHALL TERMINATE A MINIMUM OF 6 INCHES ABOVE THE PARAPET.
- ALL PLUMBING VENTS SHALL TERMINATE A MINIMUM OF 10 FT. HORIZONTALLY FROM ANY OUTDOOR AIR INTAKE. WHERE A PLUMBING VENT IS LOCATED WITHIN 10 FT. OF AN INTAKE, THE VENT SHALL TERMINATE A MINIMUM OF 2 FT. ABOVE THE INTAKE.
- ALL SIDE WALL VENT TERMINATIONS SHALL BE PROTECTED TO PREVENT BIRDS OR RODENTS FROM ENTERING OR BLOCKING THE VENT OPENING.
- ALL FLOOR DRAINS THAT DO NOT SERVE EQUIPMENT SHALL BE PROTECTED AGAINST DRYING OUT EITHER THROUGH THE INSTALLATION OF A TRAP PRIMER, DEEP SEAL TRAP OR GROSTET TRAP GUARD. ALL TRAPS SHALL BE FILLED WITH AN INITIAL LAYER OF COOKING OIL.
- ALL APPLIANCES SHALL DRAIN TO AN APPROVED SANITARY WASTE RECEPTOR (FLOOR SINK OR FLOOR DRAIN WITH FUNNEL). INDIRECT DRAINAGE FROM AN APPLIANCE SHALL MAINTAIN AN AIR GAP BETWEEN THE PIPE OUTLET AND THE TOP OF THE RECEPTOR. THE MINIMUM DISTANCE BETWEEN THE PIPE OUTLET AND THE TOP OF THE RECEPTOR SHALL BE TWICE THE DIAMETER OF THE APPLIANCE DRAIN PIPE.

- GREASE INTERCEPTORS:**
- SEE SITE PLAN FOR THE SIZE AND LOCATION OF THE GREASE INTERCEPTOR.
 - THE GREASE INTERCEPTOR SHALL BE INSTALLED IN A LOCATION THAT IS ACCESSIBLE FOR PUMPING.
 - THE GREASE INTERCEPTOR SHALL BE CONSTRUCTED OF FIBERGLASS OR ROTATIONALLY-MOLDED POLYETHYLENE. GREASE INTERCEPTOR CONSTRUCTION SHALL CONFORM TO ALL LOCAL CODES. CONCRETE GREASE INTERCEPTORS ARE NOT PERMITTED UNLESS REQUIRED BY THE LOCAL AHJ.
 - GREASE INTERCEPTORS SHALL BE GRAVITY OR HYDROMECHANICAL TYPE, SIZED FOR THE APPLICATION LISTED.

- THE GREASE INTERCEPTOR SHALL BE VENTED.
- ACCESS TO THE GREASE INTERCEPTOR SHALL BE PROVIDED WITH TWO (2) 24-IN. MANHOLES. COVER SHALL PROVIDE WATER/GAS-TIGHT SEAL AND HAVE A MINIMUM 16,000 LBS. LOAD CAPACITY. ALL SURFACE WATER MUST DRAIN AWAY FROM MANHOLES.
- PIPING INLET AND OUTLET SIDES SHALL BE CLEARLY LABELED ON THE TOP OF THE GREASE INTERCEPTOR TO INSURE PROPER INSTALLATION.

DOMESTIC SUPPLY SYSTEMS:

- THE INCOMING WATER SERVICE PIPE SHALL BE LOCATED A MINIMUM OF 10 FT. FROM THE EXITING SANITARY PIPE. WHERE A 10 FT. SEPARATION IS NOT POSSIBLE, THE BOTTOM OF THE WATER SERVICE PIPE SHALL BE A MINIMUM OF 12 IN. ABOVE THE TOP OF THE HIGHEST POINT OF THE SANITARY PIPE.
- ALL UNDERGROUND SITE PLUMBING SHALL CONFORM TO NSF 61, SHALL BE TYPE K COPPER TUBING OR COPPER PIPE, POLYETHYLENE (PE), PEX OR CPVC. IF CPVC IS USED, FOAM INSULATION SHALL BE INSTALLED AT ALL CHANGES OF DIRECTION TO ACCOUNT FOR EXPANSION AND CONTRACTION.
- IF PEX PIPING IS USED, ALL MAINS SHALL BE UPSIZED BY 0.5" DIAMETER.
- INCOMING WATER SERVICE PRESSURE SHOULD BE BETWEEN 50 AND 55 PSI STATIC. WHERE WATER PRESSURE SERVICE EXCEEDS 80 PSI STATIC, AN APPROVED WATER-PRESSURE REDUCING VALVE WITH STRAINER CONFORMING TO ASSE 1003 SHALL BE INSTALLED. WHERE INCOMING WATER PRESSURE IS BELOW 50 PSI STATIC, A PRESSURE BOOSTER SYSTEM SHALL BE INSTALLED.
- IF THE RESTAURANT HAS A COMBINED WATER AND FIRE SPRINKLER SERVICE, THE INCOMING WATER SERVICE SHALL BE SIZED BASED ON THE FIRE SPRINKLER CONTRACTOR'S HYDRAULIC CALCULATIONS.
- PROVIDE A MINIMUM ½" ANNUAL CLEARANCE AROUND ALL PIPE SLAB PENETRATIONS.
- A REDUCED PRESSURE PRINCIPLE BACKFLOW PREVENTER (RPZ) SHALL BE INSTALLED AT THE INCOMING SERVICE WHERE REQUIRED BY CODE. (MIN. 60" A.F.F.)
- AN EXPANSION TANK SHALL BE INSTALLED ON THE COLD WATER LINE INLET TO THE WATER HEATER. SEE EXPANSION TANK SCHEDULE.

- ALL WATER SUPPLY PIPE WITHIN 5 FT. OF THE BUILDING AND INSIDE THE BUILDING SHALL COMPLY WITH NSF 61 AND SHALL BE TYPE L COPPER TUBING, COPPER PIPE, PEX OR CPVC PIPE.
- CPVC PIPE SHALL BE FLOWGUARD GOLD OR FLOWGUARD BENDABLE AS MANUFACTURED BY LUBRIZOL.
- CPVC PIPE SHALL BE CONNECTED WITH FLOWGUARD GOLD YELLOW LOW-VOC SOLVENT CEMENT AS MANUFACTURED BY IPS WELD-ON OR OATEY.
- ALL CPVC PIPE SHALL BE INSULATED TO PREVENT EXPOSURE TO GREASE.

- ALL SUSPENDED PIPE SHALL BE SUPPORTED AS FOLLOWS:
- | MATERIAL | MAX. HORIZ. SPACING | MAX. VERT. SPACING |
|-------------------------------------|---------------------|--------------------|
| COPPER PIPE | 12 FT. | 10 FT. |
| COPPER TUBING $\leq 1\frac{1}{2}$ " | 6 FT. | 10 FT. |
| COPPER TUBING $> 1\frac{1}{2}$ " | 10 FT. | 10 FT. |
| CPVC $\leq 1"$ | 3 FT. | 10 FT. |
| CPVC $\geq 1\frac{1}{4}"$ | 4 FT. | 10 FT. |
| PEX $\leq 1"$ | 3 FT. | 10 FT. |
| PEX $\geq 1\frac{1}{4}"$ | 4 FT. | 10 FT. |

- A REDUCED PRESSURE PRINCIPLE BACKFLOW PREVENTER (RPZ) SHALL BE INSTALLED AT THE INLET TO THE WATER FILTRATION SYSTEM. ALL PIPING DOWNSTREAM OF THE RPZ SHALL BE COPPER OR CROSS-LINKED POLYETHYLENE (PEX).
- ALL DEVICES, APPLIANCES, AND APPARATUS INTENDED TO SERVE SOME SPECIAL FUNCTION (EX.: SODA MACHINE, COFFEE MACHINE, BEVERAGE DISPENSERS, ETC.) SHALL BE PROVIDED WITH PROTECTION AGAINST BACKFLOW AND CONTAMINATION OF THE WATER SUPPLY SYSTEM. ALL BACKFLOW PREVENTION DEVICES SHALL BE ASSE LISTED AND APPROVED FOR THE DEVICE OR APPLIANCE THEY SERVE.
- ALL WATER SUPPLY LINES SHALL BE PROVIDED WITH A QUARTER-TURN SHUT-OFF VALVE BEFORE FINAL CONNECTION TO EQUIPMENT.
- QUARTER-TURN SHUT-OFF VALVES SHALL BE INSTALLED UPSTREAM OF ANY INLINE BACKFLOW PREVENTION DEVICE.
- ALL VALVES AND BACKFLOW PREVENTION DEVICES SHALL BE INSTALLED WITH FITTINGS THAT FACILITATE REMOVAL IN CASE OF FAILURE.

- ALL OVERHEAD WATER LINES SHALL BE INSULATED PER SCHEDULE THIS SHEET WITH EXTERNAL JACKETED INSULATION AND A MINIMUM INSTALLED R-VALUE OF 3.7.
- PRIOR TO BUILDING TURNOVER, THE DOMESTIC WATER SUPPLY SYSTEM SHALL BE PURGED OF DELETERIOUS MATERIAL AND DISINFECTED. DISINFECTION SHALL BE DONE IN ACCORDANCE WITH THE LOCAL HEALTH CODE, PLUMBING CODE OR IN ACCORDANCE WITH AWWA C651 OR AWWA C652.

- STORM DRAINAGE SYSTEMS:**
- ALL ROOF DRAINS SHALL BE SIZED IN ACCORDANCE WITH LOCAL CODES AND SHALL CONFORM TO ASME A112.21.2M OR A112.3.1.
 - ALL STORM DRAINAGE PIPING SHALL BE ABS, PVC TYPE DWV OR CAST-IRON WHERE REQUIRED BY CODE.
 - ALL SUSPENDED STORM DRAINAGE PIPE SUPPORT REQUIREMENTS SHALL BE THE SAME AS THE SANITARY AND VENT REQUIREMENTS.
 - ALL HORIZONTAL STORM DRAINAGE PIPE PITCH REQUIREMENTS SHALL BE THE SAME AS THE SANITARY AND VENT REQUIREMENTS.
 - ALL HORIZONTAL STORM DRAINAGE PIPE SHALL BE INSULATED WITH 1" THICK EXTERNAL JACKETED INSULATION AND A MINIMUM INSTALLED R-VALUE OF 3.7 TO PROTECT AGAINST CONDENSATION.
 - CLEANOUTS SHALL BE INSTALLED IN ALL HORIZONTAL DRAINAGE PIPE AND SHALL BE LOCATED NOT MORE THAN 100 FT. APART.
 - CLEANOUTS SHALL BE INSTALLED AT ALL CHANGES OF DIRECTION GREATER THAN 45 DEGREES. WHERE MORE THAN ONE CHANGE OF DIRECTION OCCURS IN A SINGLE PIPE RUN, ONLY ONE (1) CLEANOUT SHALL BE REQUIRED FOR EVERY 40 FEET OF DEVELOPED LENGTH.
 - CLEANOUTS SHALL BE INSTALLED ON PIPES PRIOR TO ANY SLAB PENETRATION.
 - WHERE PIPING IS LOCATED WITHIN WALL CAVITIES, ACCESS TO THE CLEANOUTS SHALL BE PROVIDED.
 - ROOF DRAINS AND OVERFLOW ROOF DRAINS SHALL BE PIPED INDEPENDENTLY. OVERFLOW ROOF DRAINS SHALL NOT BE CONNECTED TO THE PRIMARY ROOF DRAINAGE SYSTEM.

11. MINIMUM PIPING INSULATION THICKNESS HEATING AND HOT-WATER SYSTEMS (STEAM, STEAM CONDENSATE, HOT-WATER HEATING AND DOMESTIC WATER SYSTEMS). PLEASE REFER TO THE LATEST EDITION OF IECC FOR MINIMUM PIPE INSULATION THICKNESS (TABLE C403.12.3)


PIPING	MINIMUM INSULATION THICKNESS (IN INCHES) PER NOMINAL PIPE OR TUBE SIZE					
NOMINAL PIPE SIZE	<1	1 TO 1.5	1.5 TO <4	4 TO <8	>8	≥8
DOMESTIC COLD WATER (40°F TO 60°F)	0.5	0.5	1.0	1.0	1.0	
TEMPERATE HOT WATER (105°F TO 140°F)	1.0	1.0	1.5	1.5	1.5	
HOT WATER (141°F TO 200°F)	1.5	1.5	2.0	2.0	2.0	
STORM DRAIN (HORIZONTAL)	-	-	1.0	1.0	1.0	

LEGEND

— — — — —	COLD WATER PIPING	ACM	AREA CONSTRUCTION MANAGER
— — — — —	TEMPERED WATER PIPING (110°F)	AVB	ATMOSPHERIC VACUUM BREAKER
— — — — —	HOT WATER PIPING (140°F)	BSI	BEVERAGE SYSTEM INSTALLER
— — — — —	RECIRCULATED HOT WATER PIPING	CO	CLEAN-OUT
— — — — —	OVERHEAD LINES (BY P.C.)	DC	DOWNSPOUT COVER
— — SAN — —	UNDERGROUND SANITARY PIPING	DFU	DRAINAGE FIXTURE UNIT(S)
— — GW — —	UNDERGROUND GREASE WASTE PIPING	EC	ELECTRICAL CONTRACTOR
— — — — —	VENT PIPING	FAC	FIRE ALARM CONTRACTOR
— — ST — —	ABOVE GROUND PRIMARY STORM PIPING	FCO	FLOOR CLEAN-OUT
— — ST — —	UNDERGROUND PRIMARY STORM PIPING	FD	FLOOR DRAIN
— — STS — —	ABOVE GROUND SECONDARY STORM PIPING	FPC	FIRE PROTECTION CONTRACTOR
— — CD — —	CONDENSATE PIPING	FS	FLOOR SINK
♀	HOSE BIBB	GC	GENERAL CONTRACTOR
↑	CHECK VALVE	GI	GREASE INTERCEPTOR
⊕	BALL VALVE	GPF	GALLONS PER FLUSH
☒	THERMOSTATIC MIXING VALVE	GPM	GALLONS PER MINUTE
□	FLOOR DRAIN	GW	GREASE WASTE
☒	CLEAN-OUT (FLOOR OR YARD)	HS	HAND SINK
□	FLOOR SINK	I.P.S.	IRON PIPE SIZE (ALSO NPS)
○	PRESSURE GAUGE	KEI	KITCHEN EQUIPMENT INSTALLER
□	LOW PRESSURE SWITCH	KES	KITCHEN EQUIPMENT SUPPLIER
□	HIGH PRESSURE SWITCH	LAV	LAVATORY
§	SOLENOID VALVE	MC	MECHANICAL CONTRACTOR
☒	THREE-WAY VALVE	MHT	MALE HOSE THREADS
☒	PRESSURE REGULATOR	MS	MOP SINK
☒	DUAL CHECK VALVE OR RPZ	NPS	NATIONAL PIPE THREAD STANDARD
☒	DUAL CHECK VALVE WITH ATMOSPHERIC VENT	NPT	NATIONAL PIPE THREAD TAPERED
☒	STRAINER	O/O	OWNER/OPERATOR
☒	RELIEF VENT	OH	OVERHEAD
●	WATER-HAMMER ARRESTOR	P	PUMP
PC	PLUMBING CONTRACTOR		
RC	REFRIGERATION CONTRACTOR		
RPZ	REDUCED PRESSURE PRINCIPLE BACKFLOW PREVENTER		
SS	SANITARY SEWER		
ST STS	STORM SEWER (PRIMARY) STORM SEWER (SECONDARY)		
SVB	ANTI-SIPHON, SPILL RESISTANT VACUUM BREAKER		
TAB	TEST AND BALANCE CONTRACTOR		
UG	UNDERGROUND		
UR	URINAL		
V	VENT		
WC	WATER CLOSET		

COORDINATION SCHEDULE					EXPANSION TANK SCHEDULE					WATER HEATER SCHEDULE																
GENERAL REQUIREMENTS		FURNISH	INSTALL	FINAL CONNECTION	NOTES	NOTES:					TAG		MANUFACTURER	MODEL	TOTAL VOL.	CONNECTION	ACCESSORIES	TAG		MANUFACTURER	MODEL	SIZE	HEATING	RECOV.		
MECHANICAL PERMIT		MC			1-3	1. THIS SCHEDULE IS INTENDED AS A GUIDE FOR THE WORK TO BE PERFORMED. ALL WORK SHALL BE COORDINATED BETWEEN THE McDONALD'S AREA CONSTRUCTION MANAGER AND ALL GC AND O/O SUBCONTRACTORS.					ET-1	AMTROL	ST-12	4.4 GAL.	%"	-	WH-1	BRADFORD-WHITE	EF-100T-199E-3N	100	GAS	239	120	1	60	<20
HOT WORK (WELDING) PERMIT (IF APPLICABLE)		KES			1-3	2. ONE (1) COPY OF THE DECOR PACKAGE DRAWINGS SHALL BE SUPPLIED TO THE GENERAL CONTRACTOR AND EACH OF THE SUBCONTRACTORS. IT SHALL BE THE RESPONSIBILITY OF THE GENERAL CONTRACTOR AND THE SUBCONTRACTORS TO INSURE THAT THEY HAVE RECEIVED THE DECOR PACKAGE DRAWINGS.					NOTES:					1. SEE DETAIL 6 ON DRAWING P3.0					NOTES:					
REFRIGERATION PERMIT (IF APPLICABLE)		MC			1-3	3. FOR ANY WORK NOT CLARIFIED IN THIS SCHEDULE OR IN THE NOTES AND SPECIFICATIONS, PLEASE CONSULT THE McDONALD'S CONSTRUCTION MANAGER FOR SCOPE OF WORK.					NOTES:					1. CONCENTRIC VENT KIT.					1. MINIMUM THERMAL EFFICIENCY 97%					
PLUMBING PERMIT		PC			1-3	4. ALL ROOFTOP UNIT EQUIPMENT SUPPLIED BY THE MECHANICAL CONTRACTOR AND THE KITCHEN EQUIPMENT SUPPLIER SHALL BE ON SITE AT THE SAME TIME FOR A SINGLE CRANE LIFT. EQUIPMENT SITE ARRIVAL DATE SHALL BE COORDINATED BETWEEN THE CONSTRUCTION MANAGER, MECHANICAL CONTRACTOR AND KITCHEN EQUIPMENT SUPPLIER.					NOTES:					2. DESIGN: 2 GPM, 7 FT. HEAD					2. SEE DETAIL 6 ON DRAWING P3.0					
ELECTRICAL PERMIT		EC			1-3	5. ALL ROOFTOP UNITS INSTALLED IN McDONALD'S RESTAURANTS SHALL BE HIGH EFFICIENCY EQUIPMENT. THE INSTALLATION OF STANDARD EFFICIENCY ROOFTOP UNITS IS PROHIBITED. PLEASE REFER TO THE LATEST EDITION OF IECC FOR HVAC EQUIPMENT PERFORMANCE REQUIREMENTS.					NOTES:					3. SEE ELECTRICAL DRAWINGS FOR TIMECLOCK WIRING					3. SEE DETAIL 6 ON DRAWING P3.0					
FIRE SPRINKLER PERMIT (IF APPLICABLE)		FPC			1-3	6. ALL KITCHEN EQUIPMENT REQUIRING EXHAUST SHALL BE INSTALLED IN ACCORDANCE WITH THESE PLANS. ANY VARIATION FROM THESE PLANS SHALL BE REPORTED TO THE CONSTRUCTION MANAGER AND THE ENGINEER-OF-RECORD.					NOTES:					4. SEE DETAIL 6 ON DRAWING P3.0					4. SEE DETAIL 6 ON DRAWING P3.0					

THE PURPOSE OF THIS SHEET IS TO PROVIDE A CHECKLIST AND VISUAL GUIDE SO THE INSTALLING EC CAN VERIFY THE WORK IS IN COMPLIANCE WITH MCDONALD'S SPECIFICATIONS THAT ARE CRITICAL TO THE PROPER FUNCTIONING OF OUR POINT OF SALE (POS) COMPUTER SYSTEMS.

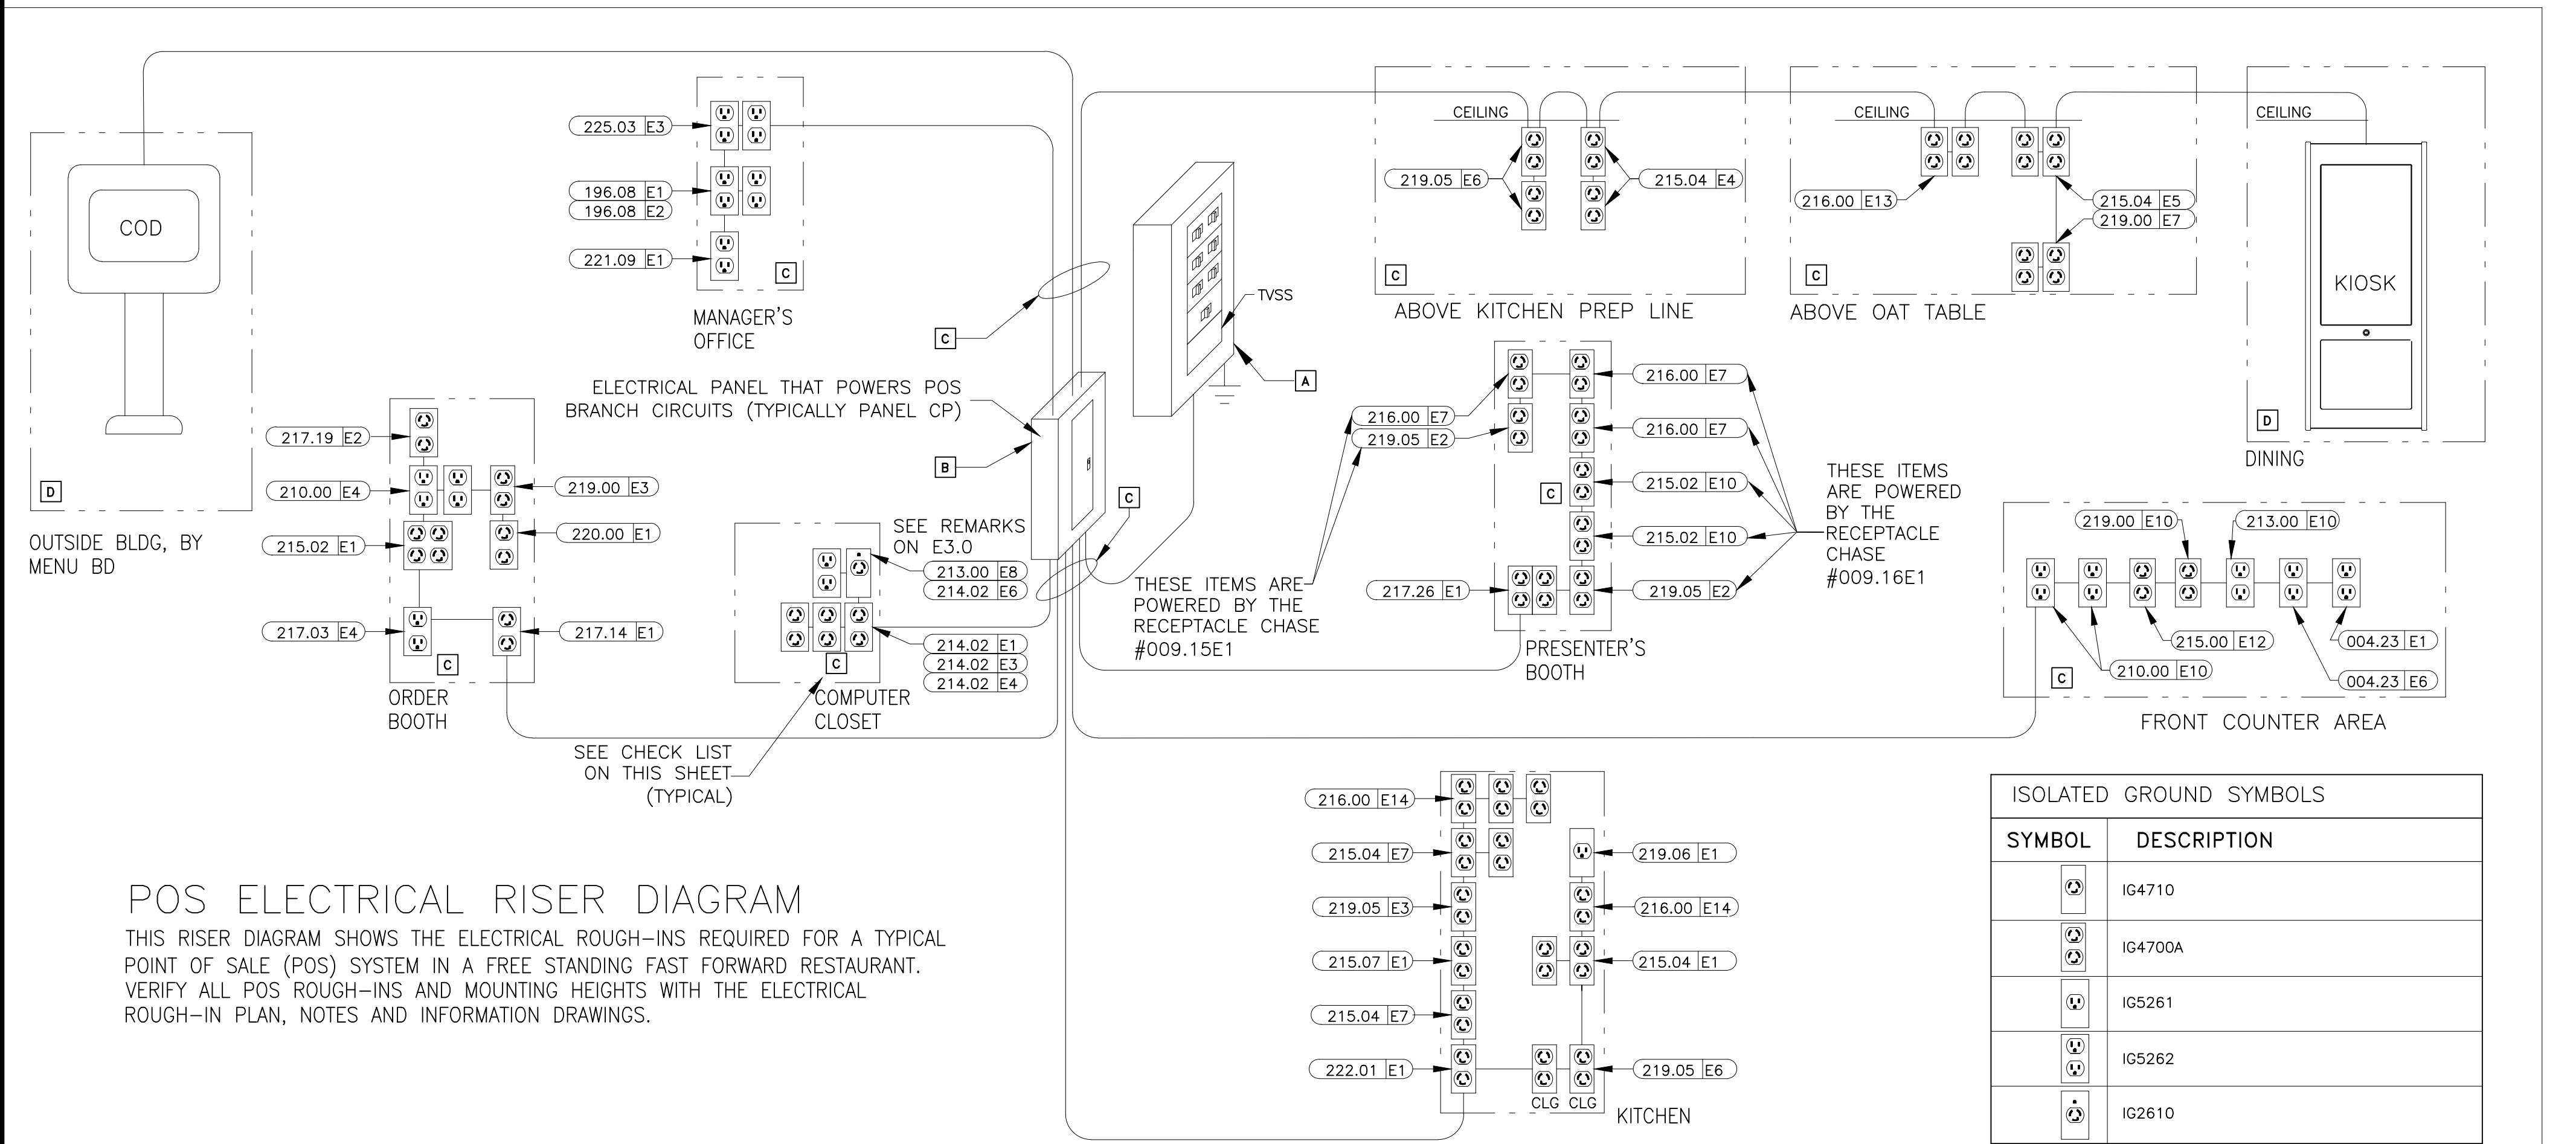

LOW VOLTAGE CABLE MANAGEMENT SPECIFICATION

GENERAL/MATERIALS

1. THE GC OR EC SHALL FURNISH AND INSTALL A COMPLETE LOW VOLTAGE CABLE MANAGEMENT SYSTEM UTILIZING CADDY-ERICO TYPE CAT-32 J-HOOK SUPPORTS (2-INCH DIAMETER LOOP MINIMUM). ALL J-HOOKS SHALL;
 - HAVE A MINIMUM BEARING SURFACE OF $1\frac{3}{8}$ "
 - HAVE FLARED EDGES TO PREVENT DAMAGE TO HIGH PERFORMANCE CABLES,
 - HAVE AN ELECTRO-GALVANIZED FINISH,
 - HAVE $\frac{3}{8}$ " WIDE CABLE RETAINING STRAPS,
 - BE UL LISTED AND LABELED,
 - BEAR THE UL SYMBOL MARKING ON THE PART FOR IDENTIFICATION
 - BE INSTALLED PER THE MANUFACTURERS INSTALLATION INSTRUCTIONS.
 2. THE ENTIRE INSTALLATION SHALL BE IN COMPLIANCE WITH THE NATIONAL ELECTRICAL CODE (NEC), NEC SECTION 800, BICSI STANDARDS 568 & 569, ALL APPLICABLE NATIONAL, STATE, LOCAL, AND SAFETY CODES, AND McDONALD'S SPECIFICATIONS.

INSTALLATION

1. LOW VOLTAGE J-HOOK CABLE PATHWAY (FOR POS CABLING SYSTEM) SHALL BE PROVIDED FROM THE MANAGERS OFFICE (OR COMPUTER CLOSET) DATA CONDUIT STUB-UP LOCATION TO THE FOLLOWING DATA CONDUIT STUB-UP LOCATIONS (AS APPLICABLE):

- FRONT COUNTER.
- PRESENTERS BOOTH.

- CASHIERS BOOTH.
- THIRD DRIVE-THRU WINDOW(IF PRESENT).
- CREW ROOM.
- VALENCE WALL.
- REMOTE ORDERING STATIONS.
- NETPOP TELEPHONE PANEL LOCATION.
- KIOSK
- DIGITAL MERCHANDISER

CABLE SUPPORTS SHALL BE PROVIDED WITHIN 24 INCHES OF THESE STUB-UP LOCATIONS.
ALL STUB-UP CONDUITS SHALL BE PROVIDED WITH AN INSULATED RUSHING TO PROTECT

ELECTRICAL POS CERTIFICATION

AS OF THE DATE BELOW, I HEREBY CERTIFY THAT ALL ELECTRICAL WORK, ELECTRICAL SERVICE AND ELECTRICAL SYSTEMS, MATERIALS AND LABOR RELATED TO THE POS ELECTRICAL INSTALLATION IN WHICH THE UNDERSIGNED ARE DIRECTLY OR INDIRECTLY RESPONSIBLE HAVE BEEN PROPERLY INSTALLED IN FULL COMPLIANCE WITH ALL CONSTRUCTION DOCUMENTS AND ALL NFPA, BUILDING, ELECTRICAL AND OTHER APPLICABLE CODES, ALONG WITH ALL OF THE REQUIREMENTS OUTLINED ON THIS DRAWING. I FURTHER CERTIFY THAT THE ELECTRIC SERVICE POWERING THE POS SYSTEM HAS BEEN PROPERLY INSTALLED BY A QUALIFIED ELECTRICIAN, SKILLED, KNOWLEDGEABLE AND TRAINED TO INSTALL ALL THE REQUIRED ELECTRICAL DISTRIBUTION COMPONENTS NECESSARY TO POWER THE POINT OF SALE (POS) SYSTEM.

GENERAL CONTRACTOR:

ELECTRICAL CONTRACTOR:

BY:




DATE:

ALL WORK IS NOT CONSIDERED TO MEET MCDONALD'S
SPECIFICATIONS UNTIL THE INSTALLED ELECTRICAL
SYSTEM SUPPORTS A "YES" ANSWER FOR ALL
QUESTIONS ASKED

AS PART OF THIS PROCESS, THE EC AND THE GC WILL BE REQUIRED TO SIGN THE ELECTRICAL CERTIFICATION DOCUMENT INDICATING THAT THE INSTALLED ELECTRICAL SYSTEM MEETS MCDONALD'S SPECIFICATIONS

NOTICE:
CHANGES SHALL NOT BE MADE TO THE POS
ELECTRICAL SYSTEM AFTER THE POS EQUIPMENT
HAS BEEN INSTALLED WITHOUT FIRST NOTIFYING
THE POS VENDOR.

CHANGES ARE MADE TO THE POS
ELECTRICAL SYSTEM AFTER THE CERTIFICATION
PROCESS HAS BEEN COMPLETED, THEN A
SYSTEM RE-CERTIFICATION SHALL BE REQUIRED.

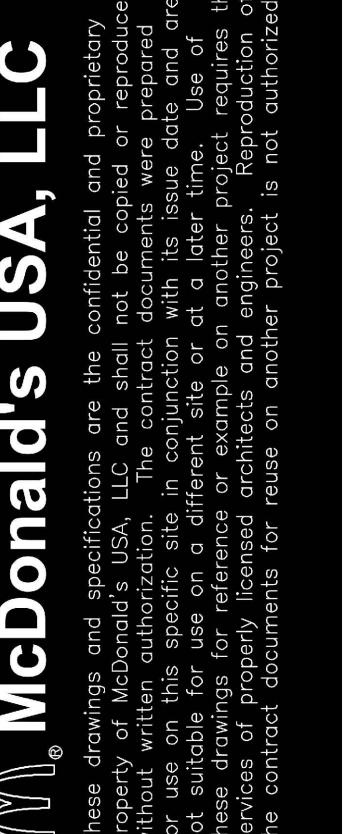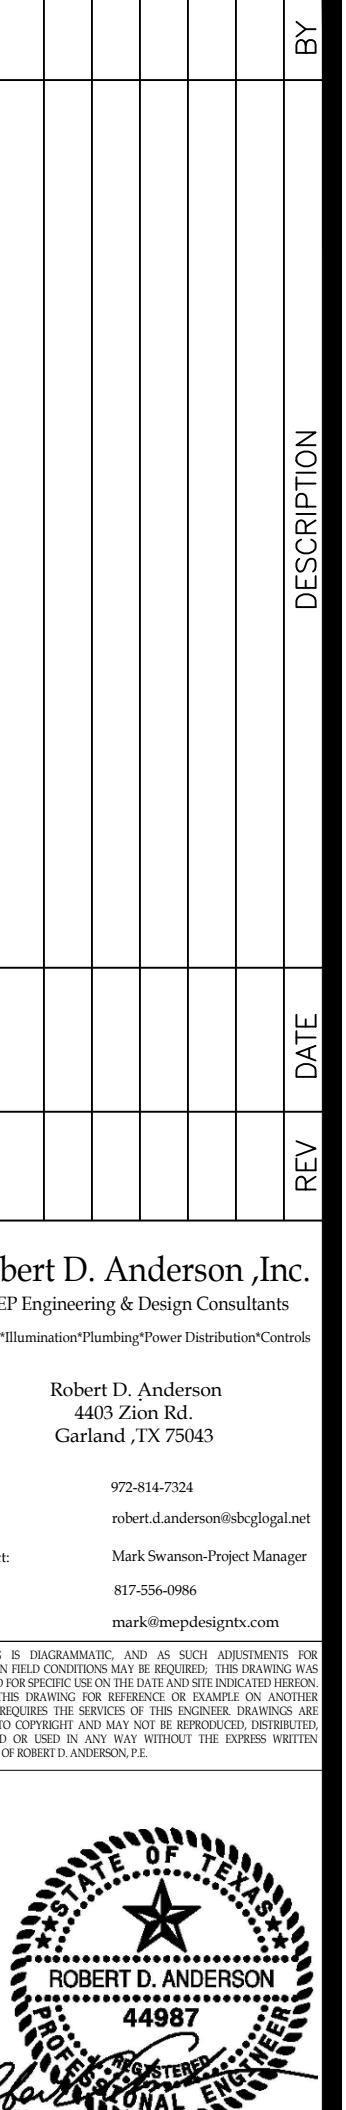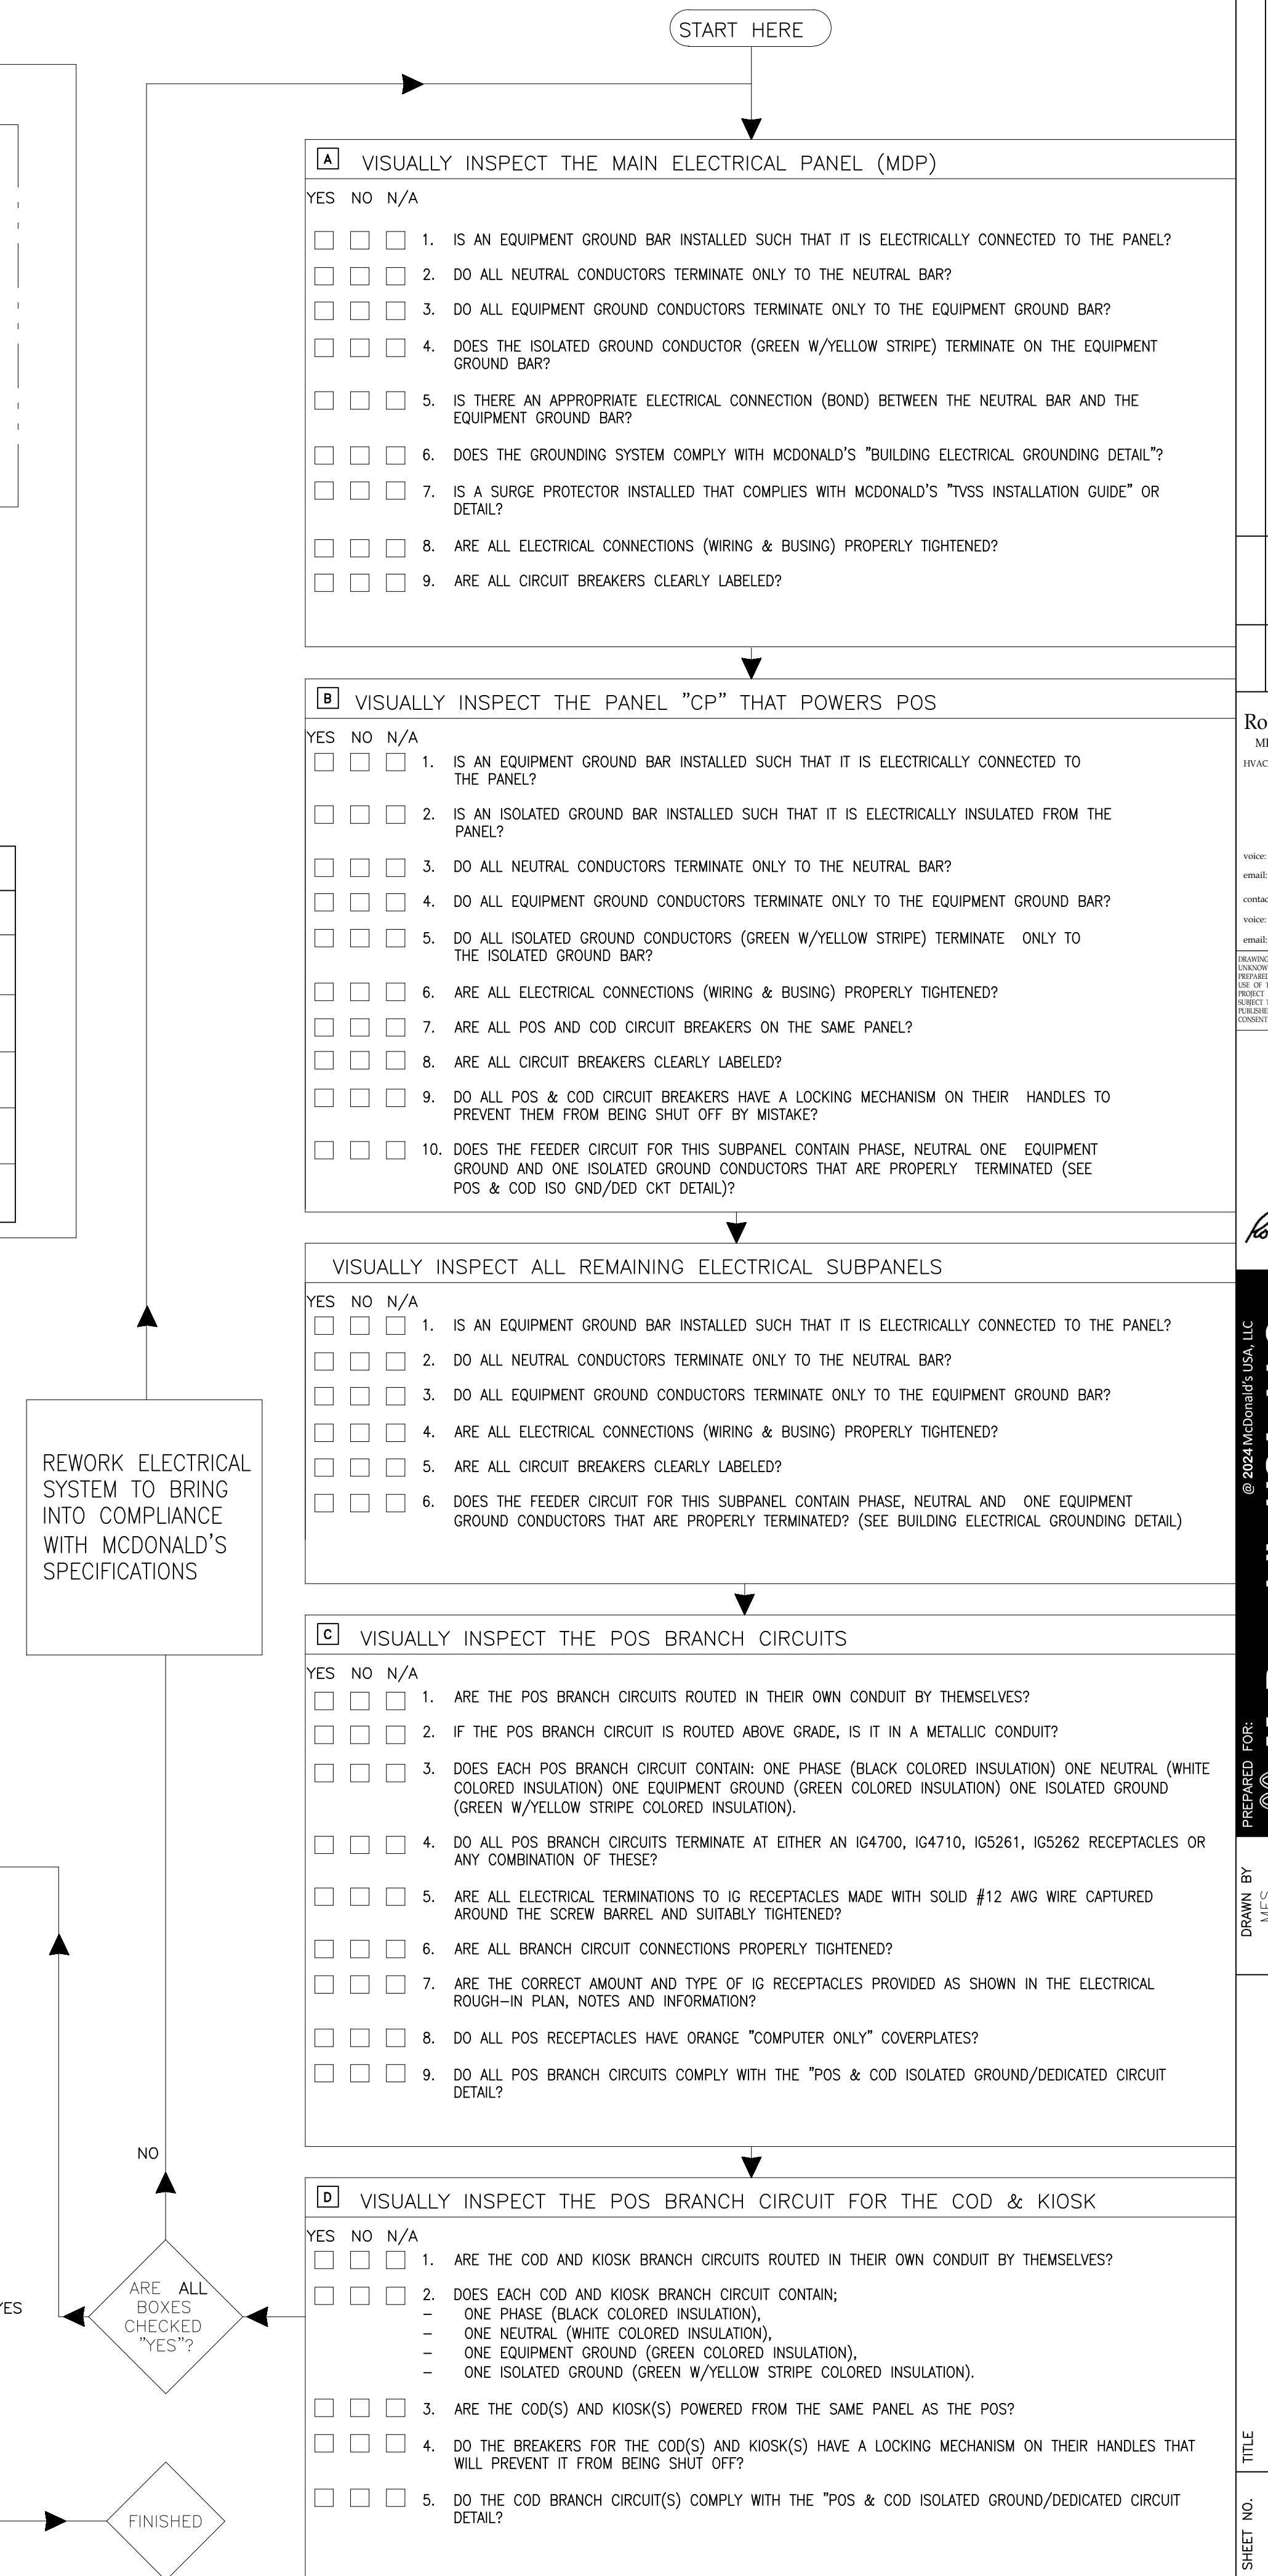

2023 STANDARD BUILDING - BB20		STD ISSUE DATE 2023	REVIEWED BY JAW	DATE ISSUED 03/08/24
<p>DESCRIPTION</p> <p>WOOD BEARING WALLS W/4" BRICK VENEER WOOD ROOF TRUSS FRAMING STUCCO/BATTEN/BRICK/METAL PANEL EXTERIOR FINISHES</p>				
SITE ID 042-3271	SITE ADDRESS SEC OF S.H. LOOP 288 & HUMMINGBIRD LANE, DENTON TEXAS			
JAWA 24-0014				
 				
POS RISER DIAGRAM				


TRASH CORRAL POWER:
3/4C-#10 & 1#10 GND TO A
30A-2P AND A 20A-1P CB IN PANEL
AP-2 FOR TRASH COMPACTOR AND WP
GFCI DOD. PROVIDE 30A-2P NFCA
DISCONNECT FOR TRASH COMPACTOR.
VERIFY EXACT LOCATION AND ALL
REQUIREMENTS OF TRASH CORRAL IN
FIELD.


COMPLETE INSTALLATION OF THE
SECONDARY DETECTOR LOOPS &
C.O.D. CONDUIT FOR CURRENT &
ANY FUTURE D/T EQUIPMENT. IF
SECONDARY D/T IS NOT INSTALLED,
EXTEND INTO LANDSCAPED AREA
BEHIND BUILDING, STUB, & CAP
FOR FUTURE ACCESS.


EXTEND 2" CONDUIT TO
DT CAMERA MOUNTED ON
LIGHT POLE OR OTHER
POLE. COORDINATE
STUB-UP LOCATION WITH
ACM AND DT CAMERA
INSTALLER
EXTEND CONDUITS TO
OUTDOOR MENU BOARDS FOR
DATA CONNECTIONS. REFER
TO DRIVE THRU DIAGRAM ON
SHEET E4.0

(2) 1-1/2" CONDUIT TO
SECONDARY SPEAKER FOR
DATA & LOOP DETECTOR
SEE CIVIL DRAWINGS
(217.10 E1)

(2) 1-1/2" CONDUIT TO
PRIMARY SPEAKER FOR
DATA & LOOP DETECTOR
SEE CIVIL DRAWINGS
(217.10 E1)

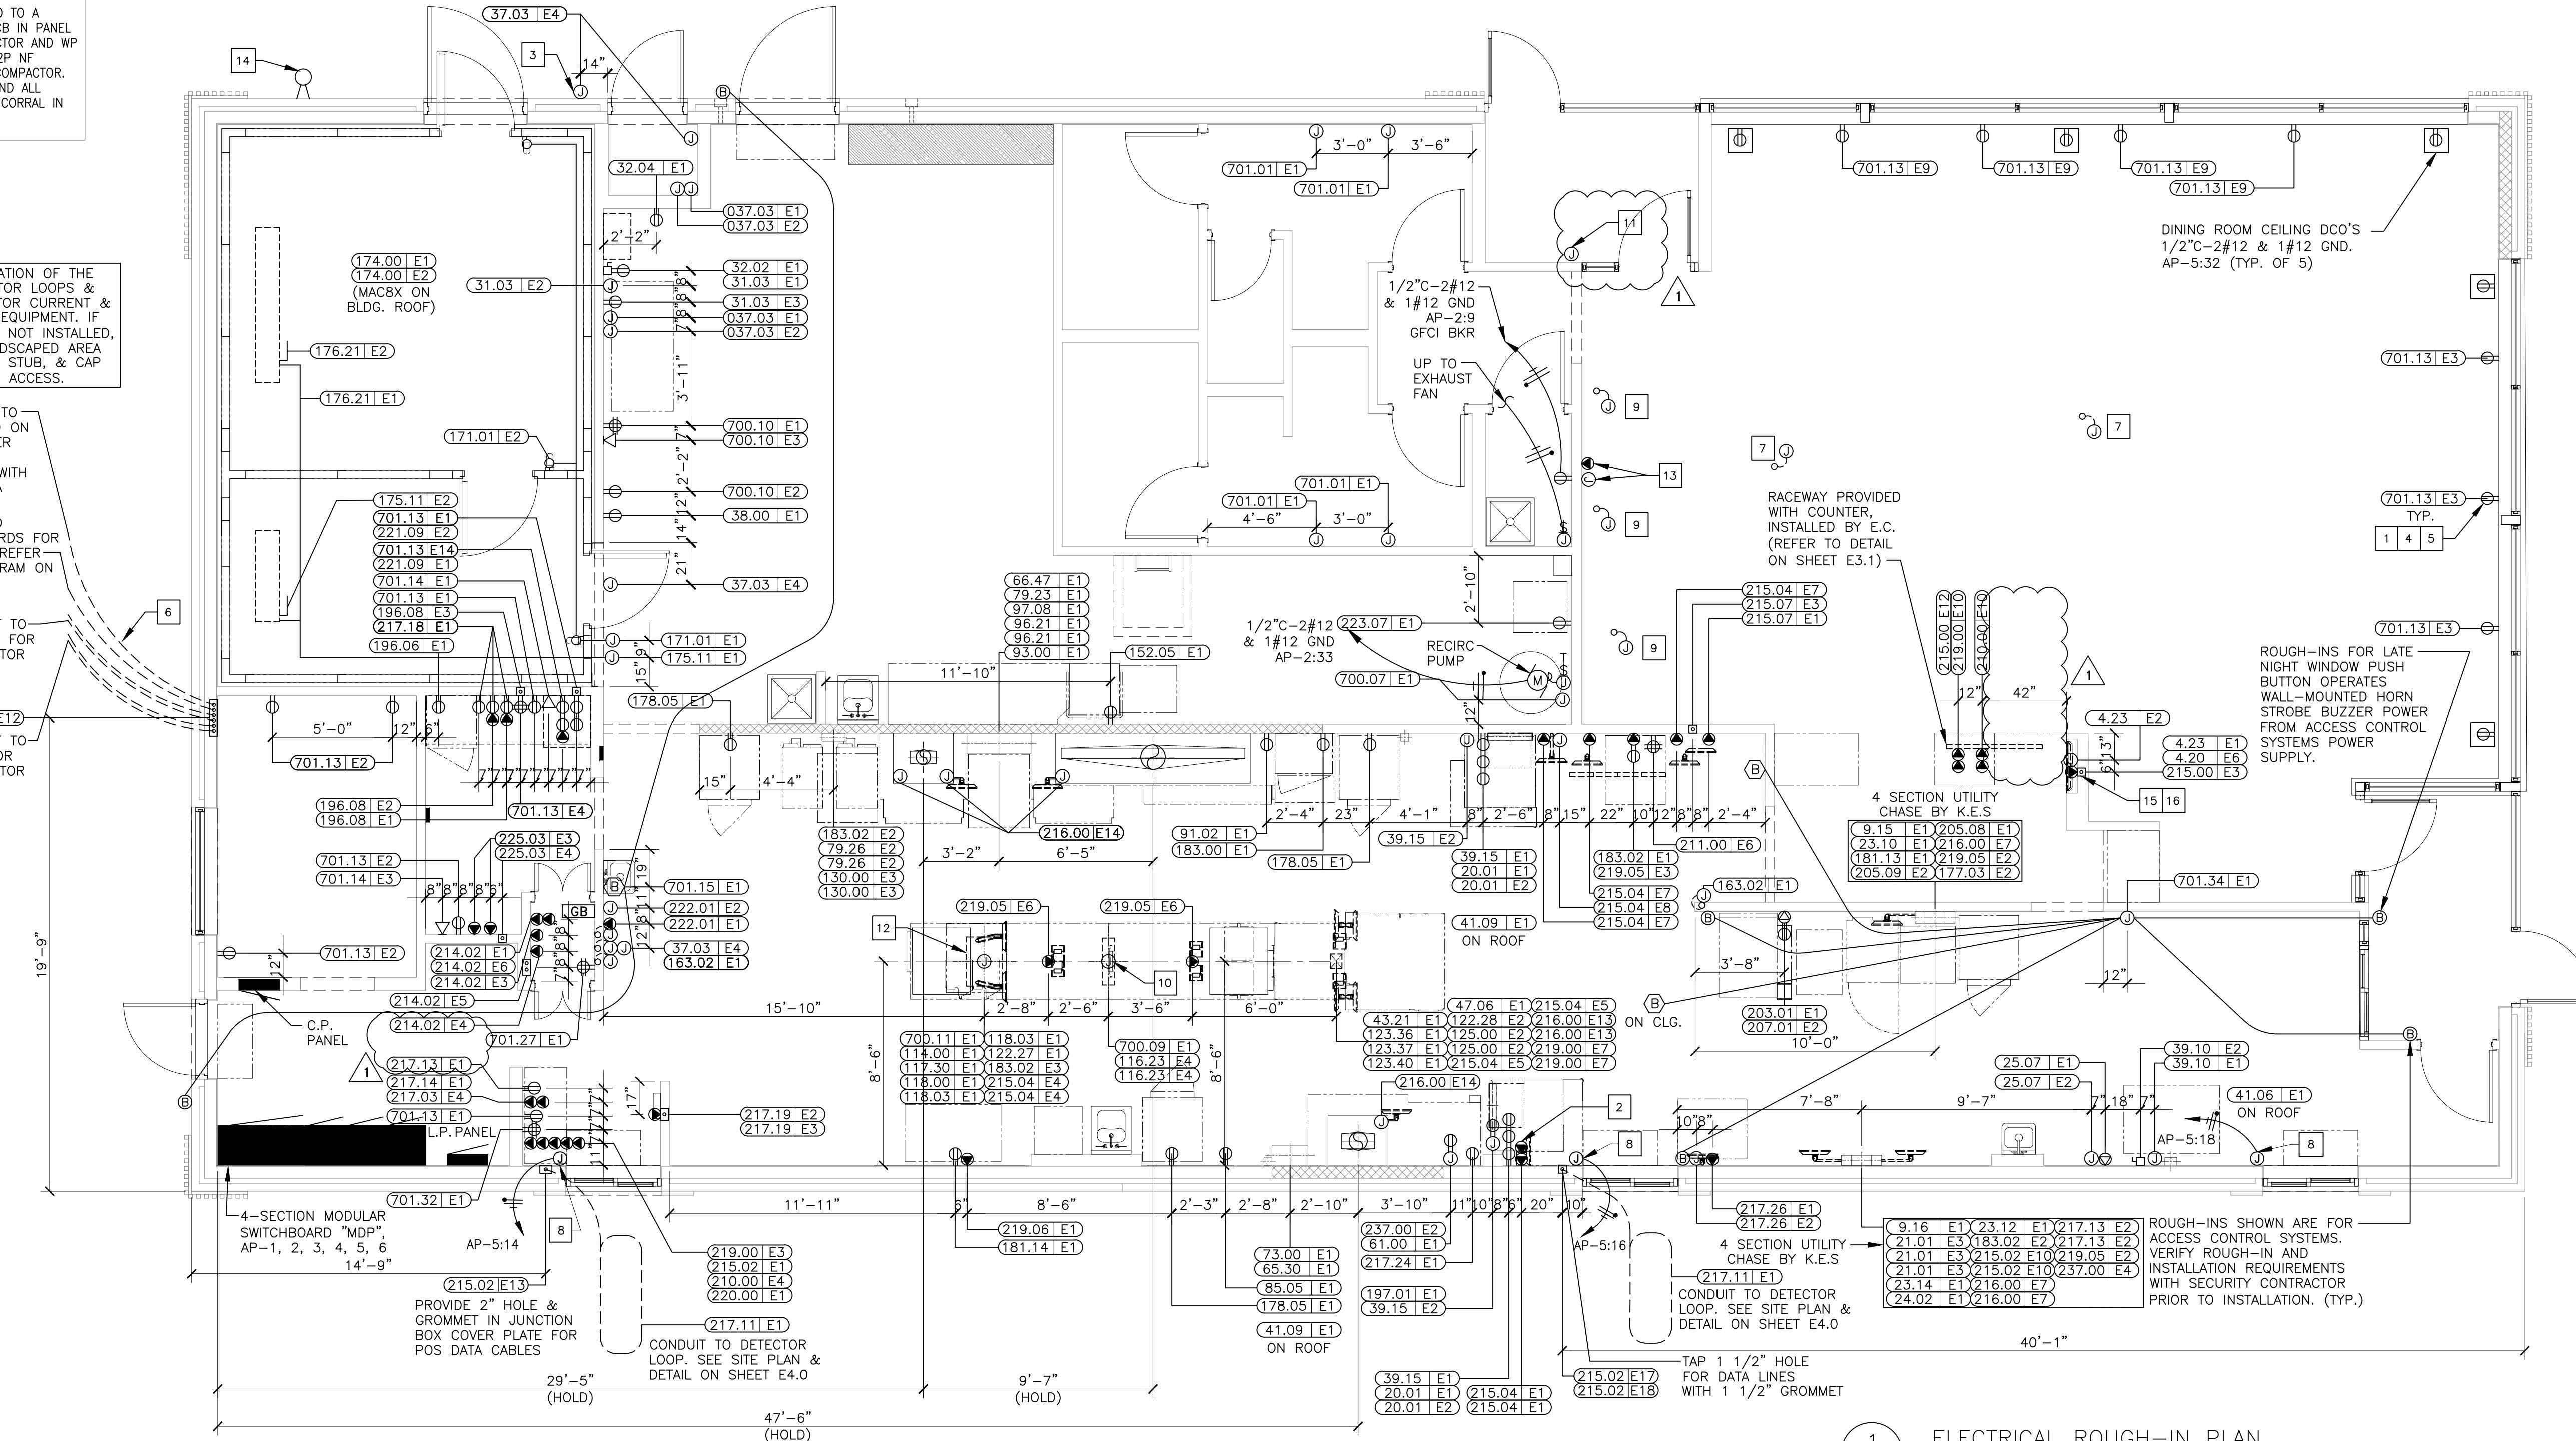

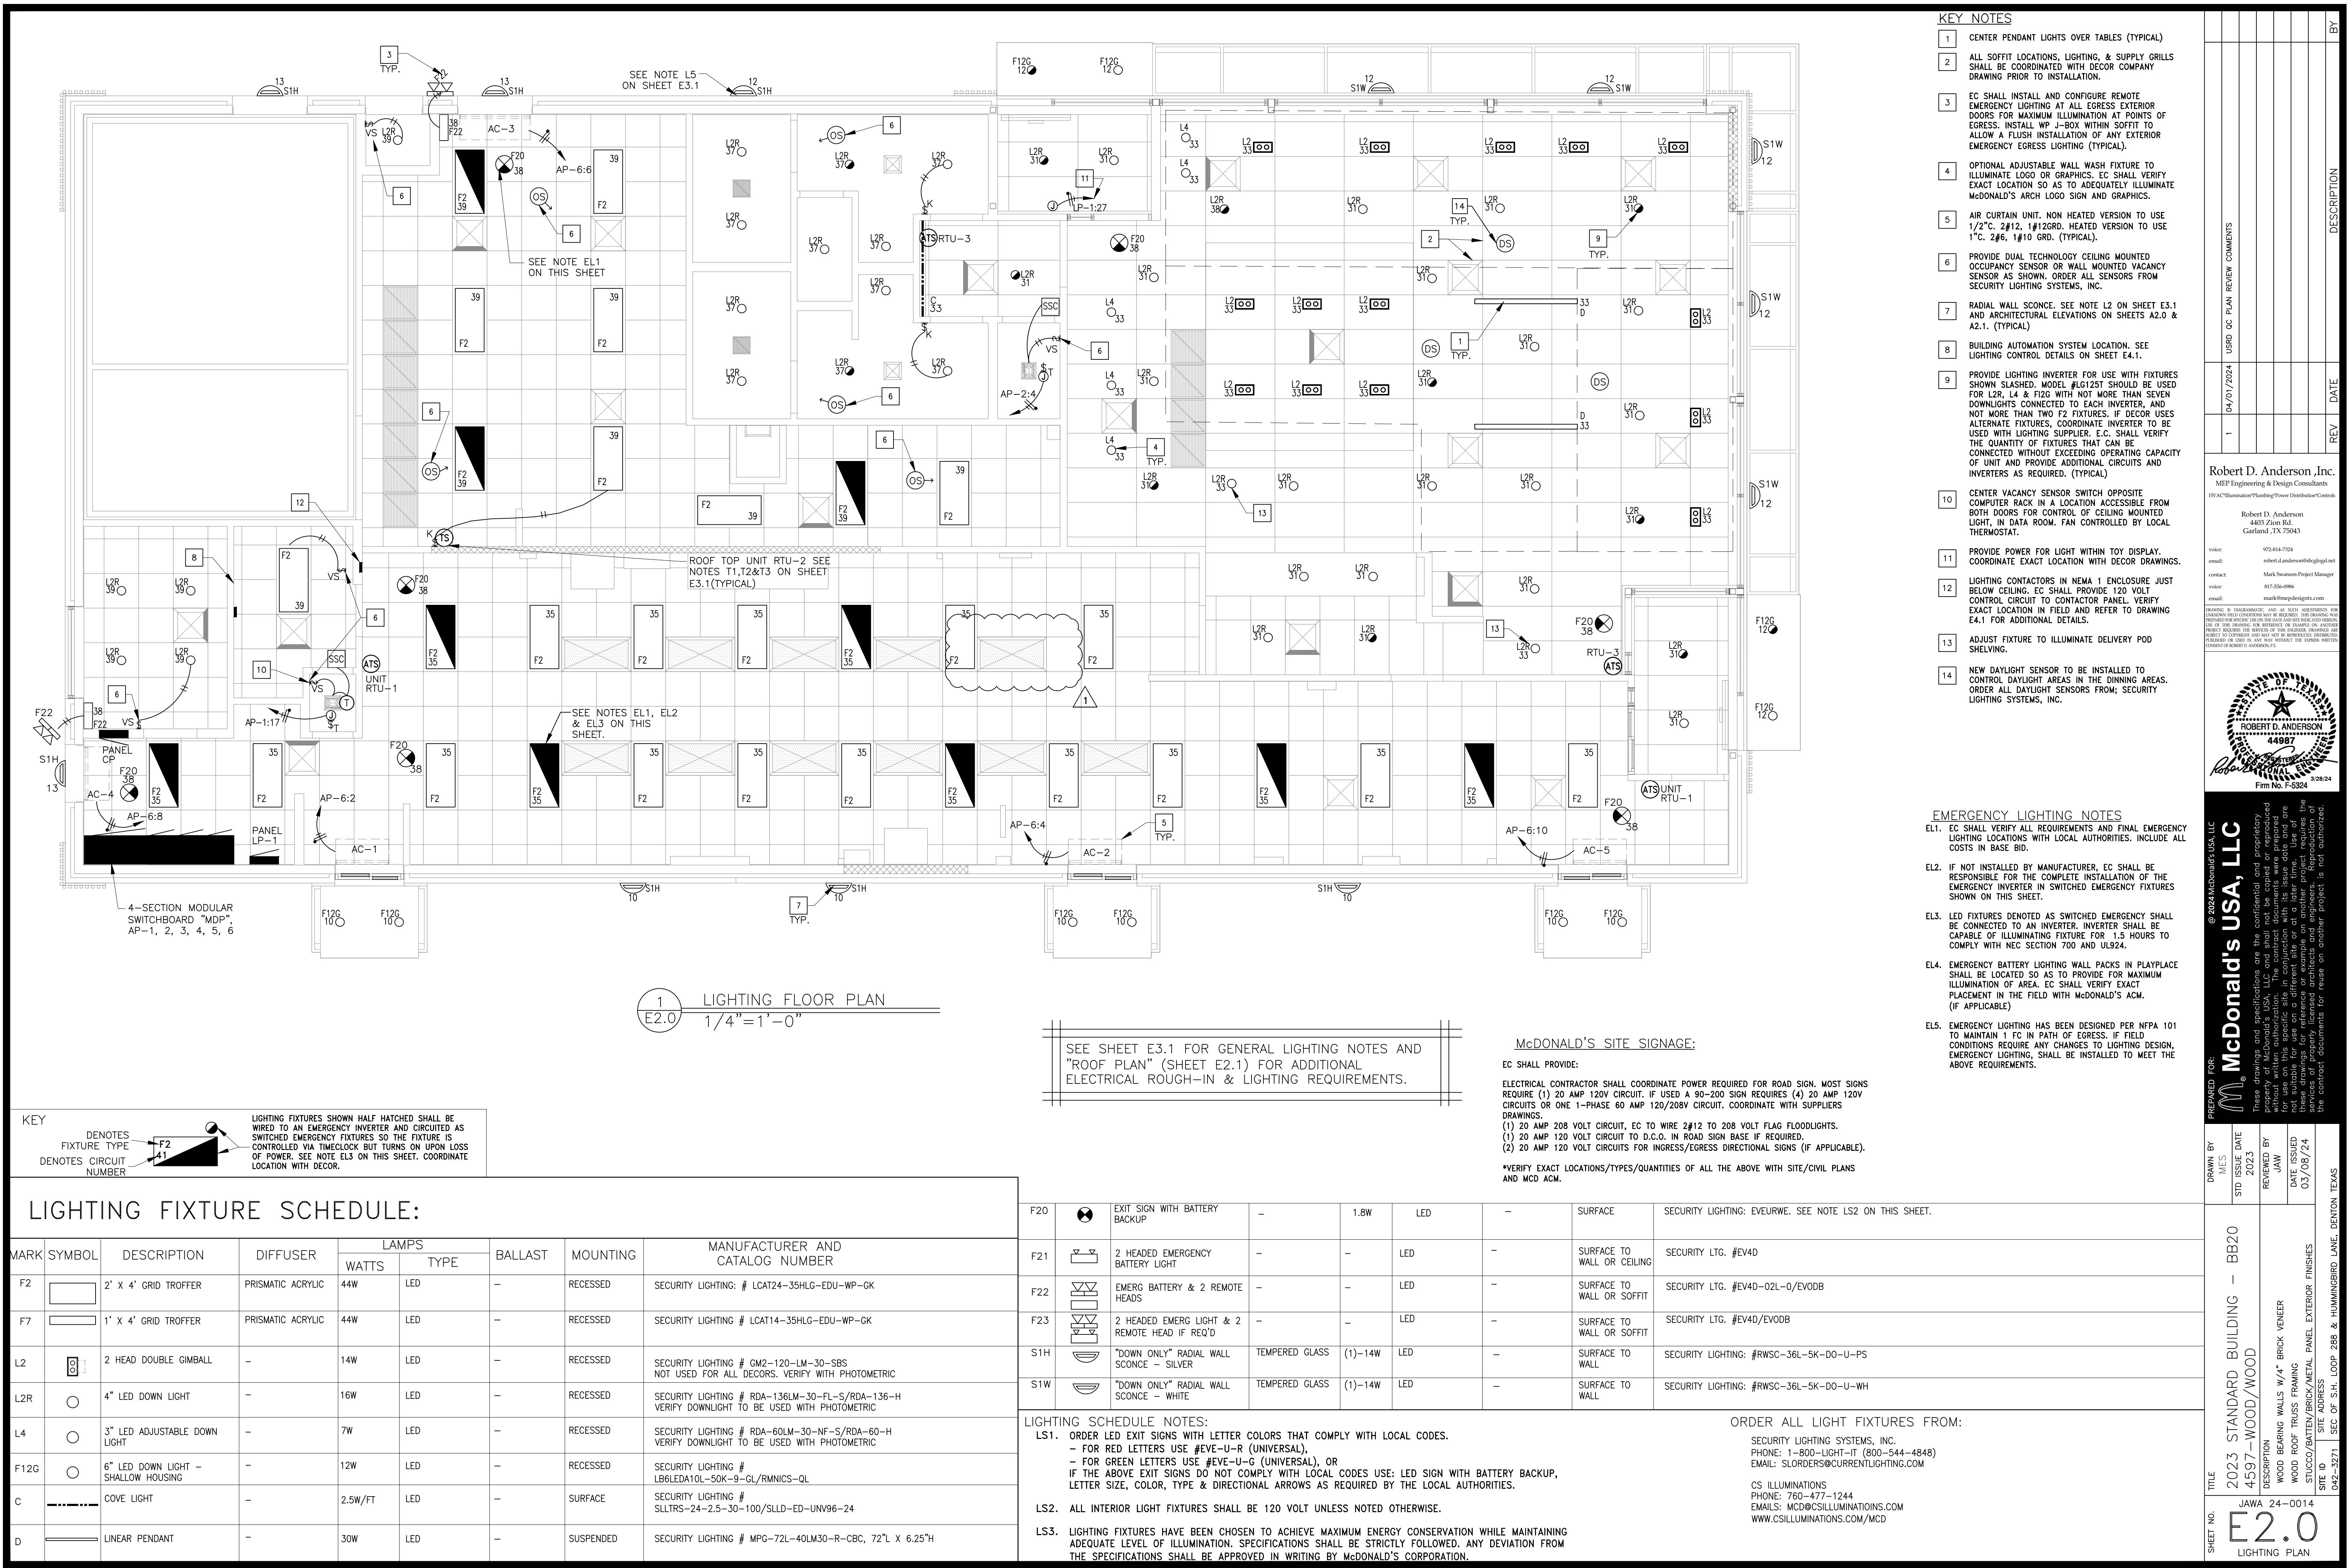

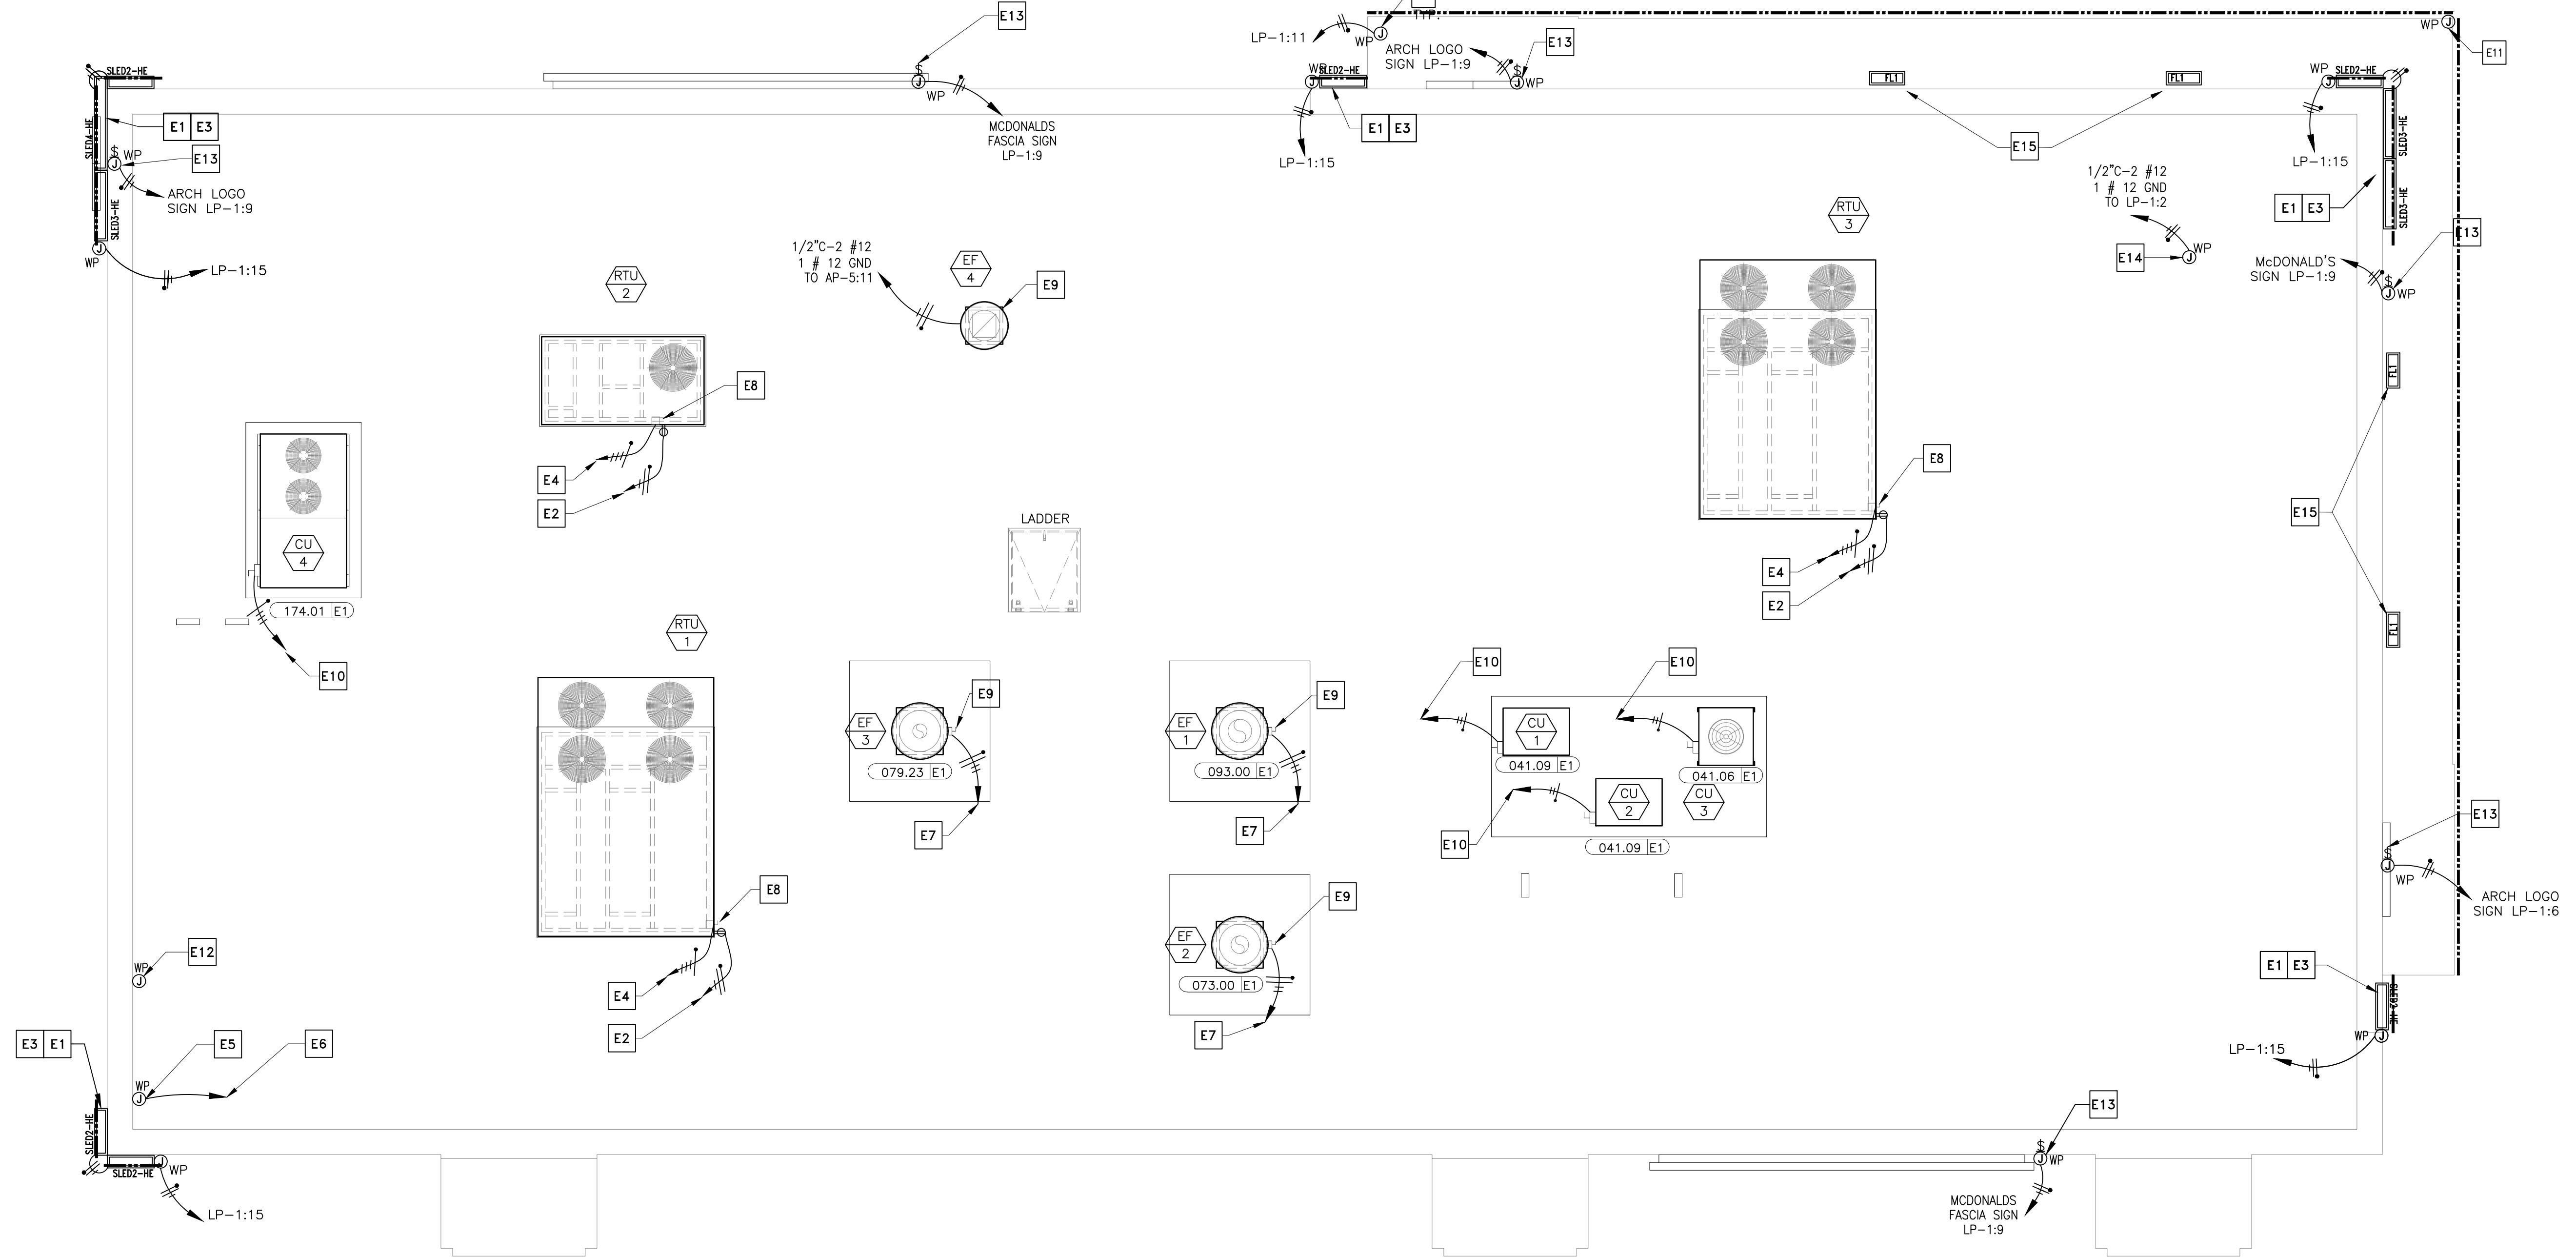

ELECTRICAL ROOF PLAN

SCALE: 1/4"=1'-0"

KEYED NOTES

- E1** EVERY LINEAR RUN OF SLED FIXTURES REQUIRES A DEDICATED WHIP KIT PROVIDED WITH FIXTURE. CONTRACTOR TO FIELD VERIFY FIXTURE MOUNTING HEIGHT, LOCATION, QUANTITY, FIXTURE LENGTHS, AND ALL ELECTRICAL CONNECTION REQUIREMENTS WITH SECURITY LIGHTING PRIOR TO ORDERING AND INSTALLATION (TYPICAL).

E2 WEATHER PROOF RECEPTACLES WITH GFCI PROTECTION ARE PROVIDED AND MOUNTED WITHIN MOTOR HOUSING LOCATIONS PER NEC ARTICLE 210.63. CIRCUIT SHALL EMANATE FROM PANEL AP-5,CCT.#13.(TYPICAL).

E3 SMOOTH BRACING IS REQUIRED FOR LED FIXTURE INSTALLATION UNDER COPING/FLASHING.(TYPICAL)

E4 REFER TO SHEET E4.0 FOR CONDUIT AND WIRE SIZE.(TYPICAL)

E5 E.C SHALL PROVIDE A WEATHER-PROOF J-BOX ON INSIDE FACE OF PARAPET, MOUNTED 6" BELOW TOP OF PARAPET FOR LIGHTING CONTROL PANEL PHOTOCELL. (PHOTOCELL FURNISHED BY OTHERS AND INSTALLED BY EC). REFER TO LIGHTING CONTROL DETAILS ON E4.1

E6 TO LIGHTING ENCLOSURE W/ TIMER. COORDINATE WITH LIGHTING CONTROL DETAILS ON SHEET E4.1

E7 COOKING EQUIPMENT EXHAUST FANS. SEE SHEET E3.0 FOR ELECTRICAL REQUIREMENTS. SEE SHEET E3.2 FOR EXHAUST FAN INTERLOCK WIRING DIAGRAMS. (TYPICAL)

E8 PROVIDE NEMA 3R DISCONNECT WITH CURRENT LIMITING FUSES TO COMPLY WITH NEC 110 AND 440. ELECTRICAL CONTRACTOR SHALL STUB UP THRU RACEWAY IN CURB TO ELIMINATE CONDUIT PENETRATION OF ROOFING. (TYPICAL)

E9 EXTERNAL NEMA 3R MOUNTED ON SIDE OF FAN BY MANUFACTURER. ELECTRICAL CONTRACTOR SHALL STUB-UP THRU ROOF AND PROVIDE FLEXIBLE WEATHERPROOF CONDUIT FROM ROOF PENETRATION TO DISCONNECT (TYPICAL).

E10 REMOTE CONDENSING UNITS. SEE SHEET E3.0 FOR WIRING AND CIRCUITRY REQUIREMENTS.

E11 CANOPY LIGHT. LP-1:11 EC SHALL VERIFY EXACT SPECIFICATIONS AND LOCATION WITH MANUFACTURER. VERIFY EXACT INFEED REQUIREMENTS IN THE FIELD. SEE NOTE L5 ON SHEET E3.1. (TYPICAL)

E12 E.C. SHALL PROVIDE A WEATHER-PROOF JUNCTION BOX WITH $\frac{3}{4}$ "C STUB DOWN TO CEILING SPACE WITH BUSHING FOR ROOF-TOP CAMERA OR SATELLITE. VERIFY EXACT LOCATION(S) WITH MCD AREA CONSTRUCTION MANAGER PRIOR TO INSTALLATION.

E13 E.C. SHALL PROVIDE A JUNCTION BOX FOR ARCH LOGO / McDonald's FASCIA / PLAY-PLACE SIGN. SEE NOTE L1 ON SHEET E3.1. COORDINATE EXACT LOCATION IN FIELD WITH ACM. ALL SIGNS PROVIDED WITH INTEGRAL DISCONNECT SWITCH FROM MANUFACTURER.(TYPICAL)

E14 E.C. SHALL PROVIDE A JUNCTION BOX FOR ROOF-TOP FLAG POLE LIGHTING. VERIFY LOCATION(S) WITH MCD PROJECT MANAGER PRIOR TO INSTALLATION.

E15 FLOOD LIGHT MOUNTED ABOVE CANOPY. LP-1:11 EC SHALL VERIFY EXACT SPECIFICATIONS AND LOCATION WITH ARCHITECTURAL ELEVATIONS. VERIFY EXACT INFEED REQUIREMENTS IN THE FIELD. SEE FLOOD LIGHT DETAIL ON SHEET E3.1. (TYPICAL)

DRAWING NOTES

1. SEE DRAWING M-4.0 FOR GENERAL MECHANICAL NOTES.
 2. SEE DRAWINGS M-3.0 AND M-4.1 FOR MECHANICAL EQUIPMENT SCHEDULES AND DETAILS.
 3. SEE DRAWING M-4.0 FOR MECHANICAL LEGEND.
 4. SEE DRAWING K-2.1 FOR REMOTE CONDENSER AND MAC UNIT INFORMATION.
 5. SEE ELECTRICAL DRAWINGS FOR ADDITIONAL INFORMATION.

LED GENERAL NOTES

- PLACE LED FIXTURE AT DESIRED LOCATION AND ATTACH POWER SUPPLY AND MOUNTING BRACKET AS RECOMMENDED BY MANUFACTURER.

EC SHALL CONNECT NEW FIXTURES TO A 120V CIRCUIT AND MAKE ALL ELECTRICAL CONNECTIONS AS REQUIRED FOR A COMPLETE OPERATING SYSTEM.

POWER SUPPLY SHALL ALWAYS BE INSTALLED TO THE LEFT SIDE OF FIXTURE WHEN FACING BRAND WALL.

LED FIXTURE SCHEDULE:

RK	SYMBOL	DESCRIPTION	DIFFUSER	LAMPS		BALLAST	MOUNTING	MANUFACTURER AND CATALOG NUMBER
				WATTS	TYPE			
02-HE		DOWN ONLY ACCENT LIGHTING (SEE PLAN)	TEMPERED GLASS	1-10W PER Fixture	LED	-	SURFACE	SECURITY LIGHTING: SLED-HE-24-DO-U-IO CUSTOM BUILT FOR EXTERIOR ACCENT CHANNELS.
03-HE		DOWN ONLY ACCENT LIGHTING (SEE PLAN)	TEMPERED GLASS	1-14W PER Fixture	LED	-	SURFACE	SECURITY LIGHTING: SLED-HE-36-DO-U-IO CUSTOM BUILT FOR EXTERIOR ACCENT CHANNELS.
04-HE		DOWN ONLY ACCENT LIGHTING (SEE PLAN)	TEMPERED GLASS	1-19W PER Fixture	LED	-	SURFACE	SECURITY LIGHTING: SLED-HE-48-DO-U-IO CUSTOM BUILT FOR EXTERIOR ACCENT CHANNELS.
		UP ONLY ACCENT LIGHTING (SEE PLAN)	TEMPERED GLASS	1-16W PER Fixture	LED	-	SURFACE	SECURITY LIGHTING: EL218-W-5-8L-5K-UV-IO-JWIO

Robert D. Anderson ,Inc.

MEP Engineering & Design Consultants

HVAC*Illumination*Plumbing*Power Distribution*Controls






PREPARED FOR:

McDonald's USA, LLC


SHEET NO.	TITLE		DRAWN BY MESS	
	2023 STANDARD BUILDING – BB20		STD ISSUE DATE 2023	
	DESCRIPTION WOOD BEARING WALLS W/4" BRICK VENEER WOOD ROOF TRUSS FRAMING STUCCO/BATTEN/BRICK/METAL PANEL EXTERIOR FINISHES		REVIEWED BY JAW	
	SITE ID 042-3271	SITE ADDRESS SEC OF S.H. LOOP 288 & HUMMINGBIRD LANE, DENTON TEXAS	DATE ISSUED 03/08/24	
 ELEC. ROOF PLAN JAWA 24-0014 2 ® 1				

ELECTRICAL SCHEDULE													ELECTRICAL SCHEDULE												
PB	Pullbox	VIF	Verify in Field	JB	Junction Box	VIF	Verify in Field	EC	Electrical Contractor	PB	Pullbox	VIF	Verify in Field	JB	Junction Box	VIF	Verify in Field	EC	Electrical Contractor						
PB = Pullbox JB = Junction Box EC = Electrical Contractor	PB = Pullbox JB = Junction Box EC = Electrical Contractor																								
TAG #	QTY	DESCRIPTION	VOLT/PH	FLA	BRK SIZE	COND/WIRE	PNL/CCT	RECEP TYPE	HGT AFF	REQUIREMENTS & REMARKS	TAG #	QTY	DESCRIPTION	VOLT/PH	FLA	BRK SIZE	COND/WIRE	PNL/CCT	RECEP TYPE	HGT AFF	REQUIREMENTS & REMARKS				
D04.20E6	1	DIGITAL MERCHANTISER	120/1 ISOLATED	2.6	20A	1/2C-2#12G	CP:6	IG5262	6'-5"	-	205.09E2	1	FROZEN BEVERAGE DISPENSER	208/1	20.0	30A	1/2C-2#10	AP-5:(17,19)	SEE RMKS	SEE RMKS	RECEP L6-30R IN CHASE BY KES, EC MAKES FINAL CONN				
D04.23E1	1	DIGITAL MERCHANTISER - MEDIA PLAYER	120/1 ISOLATED	1.0	20A	1/2C-2#12G	CP:6	IG5262	6'-5"	USE SAME RECEPTACLE AS 4.20E6	207.01E2	1	BLENDER - MCFLURRY - RAIL MOUNT	120/1	1.2	20A	1/2C-2#12	AP-2:	5-20R	4"-0"	-				
D04.23E2	1	DIGITAL MERCHANTISER - MEDIA PLAYER	DATA CABLE	-	-	-	-	JB	6'-5"	JB W/ 1" C. TO FULL HEIGHT WALL AND TO ABOVE CEILING W/BUSHINGS. FOR DATA CABLES, SUPPLY W/GROMMETED OPENING IN COVER PLATE.	210.00E10	1	CASH RECYCLER	120/1 ISOLATED	4.4	20A	1/2C-2#12G	CP:27	(2) IG5262	SEE RMKS	PROVIDE RECEP. IN COUNTER-MOUNTED RACEWAY				
D09.15E1	1	UTILITY CHASE - FFDT INTERIOR WALL	-	-	-	-	-	-	SEE RMKS	UTILITY CHASE AND RECEPTACLES PROVIDED BY K.E.S.	210.00E4	1	CASH RECYCLER	120/1 ISOLATED	4.4	20A	1/2C-2#12G	CP:24	(2) IG5262	2'-10"	-				
D09.16E1	1	UTILITY CHASE - FFDT EXTERIOR WALL	-	-	-	-	-	-	SEE RMKS	UTILITY CHASE AND RECEPTACLES PROVIDED BY K.E.S.	211.00E6	1	DELIVERY TABLETS	120/1	3.0	20A	1/2C-2#12	AP-5:21	(2) 5-20R	5"-0"	-				
D20.01E1	2	AUTOMATED BEVERAGE SYSTEM 2.0	120/1	5.0	20A	1/2C-2#12	AP-1:12, AP-2:24	5-20R	2"-0"	-	1														
D20.01E2	2	AUTOMATED BEVERAGE SYSTEM 2.0	120/1	14.9	20A	1/2C-2#12	AP-1:6, AP-2:26	5-20R	3"-10"	FOR PRE-COOLER	214.02E1	1	TECHNOLOGY RACK	120/1 ISOLATED	5.0	20A	1/2C-2#12G	CP:11	IG4700	7"-6"	FOR SWITCHES, HUBS AND RADIUS				
D21.01E3	3	COFFEE BREWER (THERMAL POTS)	120-208/1	15.5	20A	1/2C-3#12	AP-1:(2,4)(14,16), AP-6:(11,13)	BY KES	SEE RMKS	EC TO EXTEND CIRCUIT TO L14-20R RECEPTACLE IN CHASE	214.02E3	1	TECHNOLOGY RACK	120/1 ISOLATED	10.0	20A	1/2C-2#12G	CP:15	IG4700	3"-0"	FOR CASHLESS DEVICE UPS				
D23.10E1	1	ESPRESSO BREWER	208/1	21.6	30A	1/2C-2#10	AP-1:(19,21)	BY KES	SEE RMKS	EC TO EXTEND CIRCUIT TO L6-30R RECEPTACLE IN CHASE	214.02E4	1	TECHNOLOGY RACK	120/1 ISOLATED	12.0	20A	1/2C-2#12G	CP:17	IG4700	3"-0"	FOR POS SYSTEM UPS AND ORB CONTROLLER				
D23.12E1	1	COFFEE CREAM DISPENSER	120/1	1.0	20A	1/2C-2#12	AP-1:8	BY KES	SEE RMKS	EC TO EXTEND CIRCUIT TO 5-20R RECEPTACLE IN CHASE	214.02E5	1	TECHNOLOGY RACK	120/1 ISOLATED	14.0	30A	1/2C-2#10G	CP:12	8x6x4 PB	7"-6"	EXTEND (2) 2 1/2" CONDUIT ABOVE CLG. W/BUSHING FOR DATA CABLES				
D23.14E1	1	SUGAR/SWEETENER DISPENSER	120/1	1.5	20A	1/2C-2#12	AP-1:8	BY KES	SEE RMKS	EC TO EXTEND CIRCUIT TO 5-20R RECEPTACLE IN CHASE	214.02E6	1	TECHNOLOGY RACK	120/1 ISOLATED	14.0	30A	1/2C-2#10G	CP:12	IG4700	3"-0"	FOR POS SYSTEM UPS				
D24.02E1	1	JUICE DISPENSER	120/1	4.5	20A	1/2C-2#12	AP-1:8	5-20R	SEE RMKS	EC TO EXTEND CIRCUIT TO 5-20R RECEPTACLE IN CHASE	215.00E12	1	POS REGISTER - FRONT COUNTER	120/1 ISOLATED	3.0 EA.	-	3/4C-2#12G	CP:19	IG4700	SEE RMKS	PROVIDE IO RECEP. IN COUNTER-MOUNTED RACEWAY				
D25.07E1	1	INFUSION TEA BREWER - MIS	120-208/1	13.0	20A	1/2C-3#12	AP-2:(32,34)	L14-20R	2"-3"	JB	215.00E3	1	POS REGISTER - FRONT COUNTER	120/1 ISOLATED	3.0 EA.	-	4x4x4 PB	10"	4x4x4 PB	10"	EXTEND 2" CONDUIT TO ABOVE CEILING FOR POS DATA CABLES				
D25.07E2	1	INFUSION TEA BREWER - MIS	-	-	-	-	-	-	SEE RMKS	FOR WATER LINE TO ICED TEA BREWER IF CHASE IS NOT SPECIFIED. (SEE P1.6)	215.00E13	1	POS REGISTER - FRONT COUNTER	120/1 ISOLATED	3.0 EA.	-	4x4x4 PB	10"	4x4x4 PB	10"	IN BATHROOM, CONNECT TO CP-7 - IF INCLUDED IN PRESENTERS BOOTH, CONNECT TO CP-8				
D31.03E1	1	SODA SYSTEM PACKAGE - B.I.B. (RECIRCULATING- 3 TOWERS)	208/3	26.0	30A	3/4C-3#10	AP-2:(37,39,41)	SEE RMKS	3"-0"	EC SUPPLIES 30A-3P NF DISC SW MTD 9" BELOW CEILING PER NEC SEC. 404.8(A)	215.02E10	2	POS REGISTER - 2 WINDOW D/T	120/1 ISOLATED	3.0 EA.	20A	1/2C-2#12G	CP:1	BY KES	SEE RMKS	EC TO EXTEND CIRCUIT TO IG4700 RECEPTACLE IN CHASE				
D31.03E2	1	SODA SYSTEM PACKAGE - B.I.B. (RECIRCULATING- 3 TOWERS)	120/1	(2) 6.8	20A	1/2C-2#12	AP-2:35	5-20R	6'-6"	FOR WATER BOOSTER SYSTEM AND OPTIONAL AIR COMPRESSOR	215.02E12	1	POS REGISTER - 2 WINDOW D/T	-	-	-	-	18x12x4 PB	10"	REFER TO D/T LOW VOLTAGE CONDUIT DIAGRAM FOR CONDUITS UNDER SLAB AND EXTEND (2) 2 1/2" C. TO ABOVE CLG.					
D32.02E1	1	REVERSE OSMOSIS WATER FILTRATION SYSTEM - TANKLESS	120/1	4.0	20A	1/2C-2#12 EA	AP-2:23	5-20R	6"-0"	-	215.02E13	1	POS REGISTER - 2 WINDOW D/T	-	-	-	-	4x4x4 PB	10"	EXTEND 1 1/2" C. UNDER SLAB TO 217.11E1 AND 2 1/2" C. TO ABOVE CEILING FOR POS DATA CABLES					
D32.04E1	1	WATER FILTRATION SYSTEM	120/1	0.08	20A	1/2C-2#12 EA	AP-2:23	5-20R	6"-0"	-	215.02E17	1	POS REGISTER - 2 WINDOW D/T	-	-	-	-	4x4x4 PB	10"	EXTEND 1 1/2" C. UNDER SLAB TO 217.11E1 AND 2 1/2" C. TO ABOVE CEILING FOR POS DATA CABLES					
D37.03E1	1	C02 SAFETY SYSTEM - DETECTOR	120/1	1.0	20A	1/2C-2#12	AP-1:10	JB	SEE RMKS	PROVIDE LOCKOUT CB. SEE MECHANICAL DRAWINGS	215.02E18	1	POS REGISTER - 2 WINDOW D/T	-	-	-	-	4x4x4 PB	5"-0"	EXTEND 2 1/2" C. BELOW TO 215.02E17 AND 2 1/2" C. TO ABOVE CEILING FOR POS DATA CABLES					
D37.03E2	2	C02 SAFETY SYSTEM - C02 DETECTOR AV ALARM	-	-	-	-	-	-	SEE RMKS	FOR LV WIRES. STUB 3/4" ABV. CLG. SEE MECHANICAL DRAWINGS	215.04E1	2	POS - KVS MONITOR	120/1 ISOLATED	1.5 EA.	20A	1/2C-2#12G	CP:8	IG4700	FLUSH ON CLG	-				
D37.03E4	4	C02 SAFETY SYSTEM - C02 DETECTOR AV ALARM	-	-	-	-	-	-	SEE RMKS	SEE RMKS	215.04E4	2	POS - KVS MONITOR	120/1 ISOLATED	1.5 EA.	20A	1/2C-2#12G	CP:26	SEE RMKS	EC TO EXTEND CIRCUIT TO IG4700 RECEPTACLE IN OEP					
D38.00E1	1	CLEAN IN PLACE PANEL	120/1	1.0	20A	1/2C-2#12	AP-2:21	5-20R	5"-6"	-	215.04E5	2	POS - KVS MONITOR	120/1 ISOLATED	1.5 EA.	20A	1/2C-2#12G	CP:3	SEE RMKS	SEE RMKS	SEE RMKS	SEE RMKS	SEE RMKS	SEE RMKS	
D39.10E1	1	ICE MACHINE - 1400 LB.	208/3	12.8	20A	1/2C-3#12	AP-2:(1,3,5)	SEE RMKS	SEE RMKS	EC SUPPLIES 30A-3P NF DISC SW MTD 9" BELOW CEILING PER NEC 404.8(A) EX-2 VERIFY W/ AHJ	215.04E7	3	POS - KVS MONITOR	120/1 ISOLATED	1.5 EA.	20A	1/2C-2#12G	CP:23	IG4700	5"-6"	-				
D39.10E2	1	ICE MACHINE - 1400 LB.	-	-	-	-	-	-	SEE RMKS	CONTROL WIRES TO REMOTE CONDENSER	215.04E8	1	POS - KVS MONITOR	120/1 ISOLATED	1.5 EA.	20A	1/2C-2#12G	CP:26	4x4x4 PB	4"-0"	EXTEND 2" CONDUIT ABOVE CEILING. CABLE FURNISHED AND INSTALLED BY POS SYSTEM SUPPLIER				
D39.15E1	2	ICE MACHINE - 1000 LB.	120/1	1.1	15A	1/2C-2#12	AP-1:37,39	5-20R	SEE RMKS	MOUNT 9" BELOW CEILING - CIRCUIT BREAKERS SHALL BE HACR TYPE	215.07E1	1	POS REGISTER - DELIVERY	120/1 ISOLATED	3.0	20A	1/2C-2#12G	CP:23	IG4700	3"-6"	-				
D39.15E2	2	ICE MACHINE - 1000 LB.	-	-	-	1/2C	-	-	SEE RMKS	MOUNT 9" BELOW CEILING - CONTROL WIRES TO REMOTE CONDENSER	215.07E3	1	POS REGISTER - DELIVERY	-	-	-	-	4x4x4 PB	3"-6"	EXTEND 2" CONDUIT DOWN GRILL HOOD SHROUD AND PROVIDE IG4700 RECEPTACLE					
D41.06E1	1	ICE MACHINE REMOTE CONDENSER - 1400 LB.	208/1	1.0	20A	1/2C-3#12	AP-1:(26,28)	SEE RMKS	SEE RMKS	EC TO PROVIDE WP-30A-2P NF DISC AT UNIT ON ROOF - CIRCUIT BREAKER SHALL BE HACR TYPE	215.07E4	1	POS - VIDEO MONITOR	120/1 ISOLATED	1.5 EA.	20A	1/2C-2#12G	CP:9	SEE RMKS	SEE RMKS	SEE RMKS	SEE RMKS	SEE RMKS	SEE RMKS	
D41.09E1	2	ICE MACHINE REMOTE CONDENSER - 1000 LB.	208/3	11.1	15A	1/2C-3#12	AP-1:(32,34,36)(38,40,42)	SEE RMKS	SEE RMKS	EC TO PROVIDE WP-30A-3P NF DISC AT UNIT ON ROOF - CIRCUIT BREAKERS SHALL BE HACR TYPE	216.00E14	4	POS - VIDEO MONITOR	120/1 ISOLATED	1.5 EA.	20A	1/2C-2#12G	CP:9	IG4700	SEE RMKS	EXTEND CONDUIT DOWN GRILL HOOD SHROUD AND PROVIDE IG4700 RECEPTACLE				
D43.21E1	1	OPTIMIZED ORDER AS																							

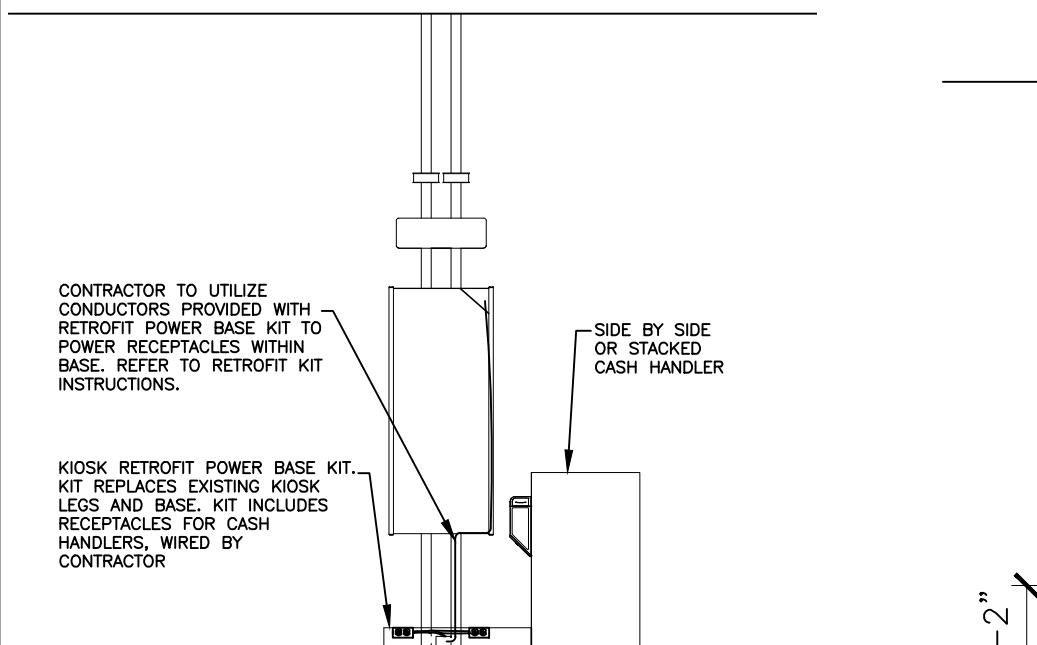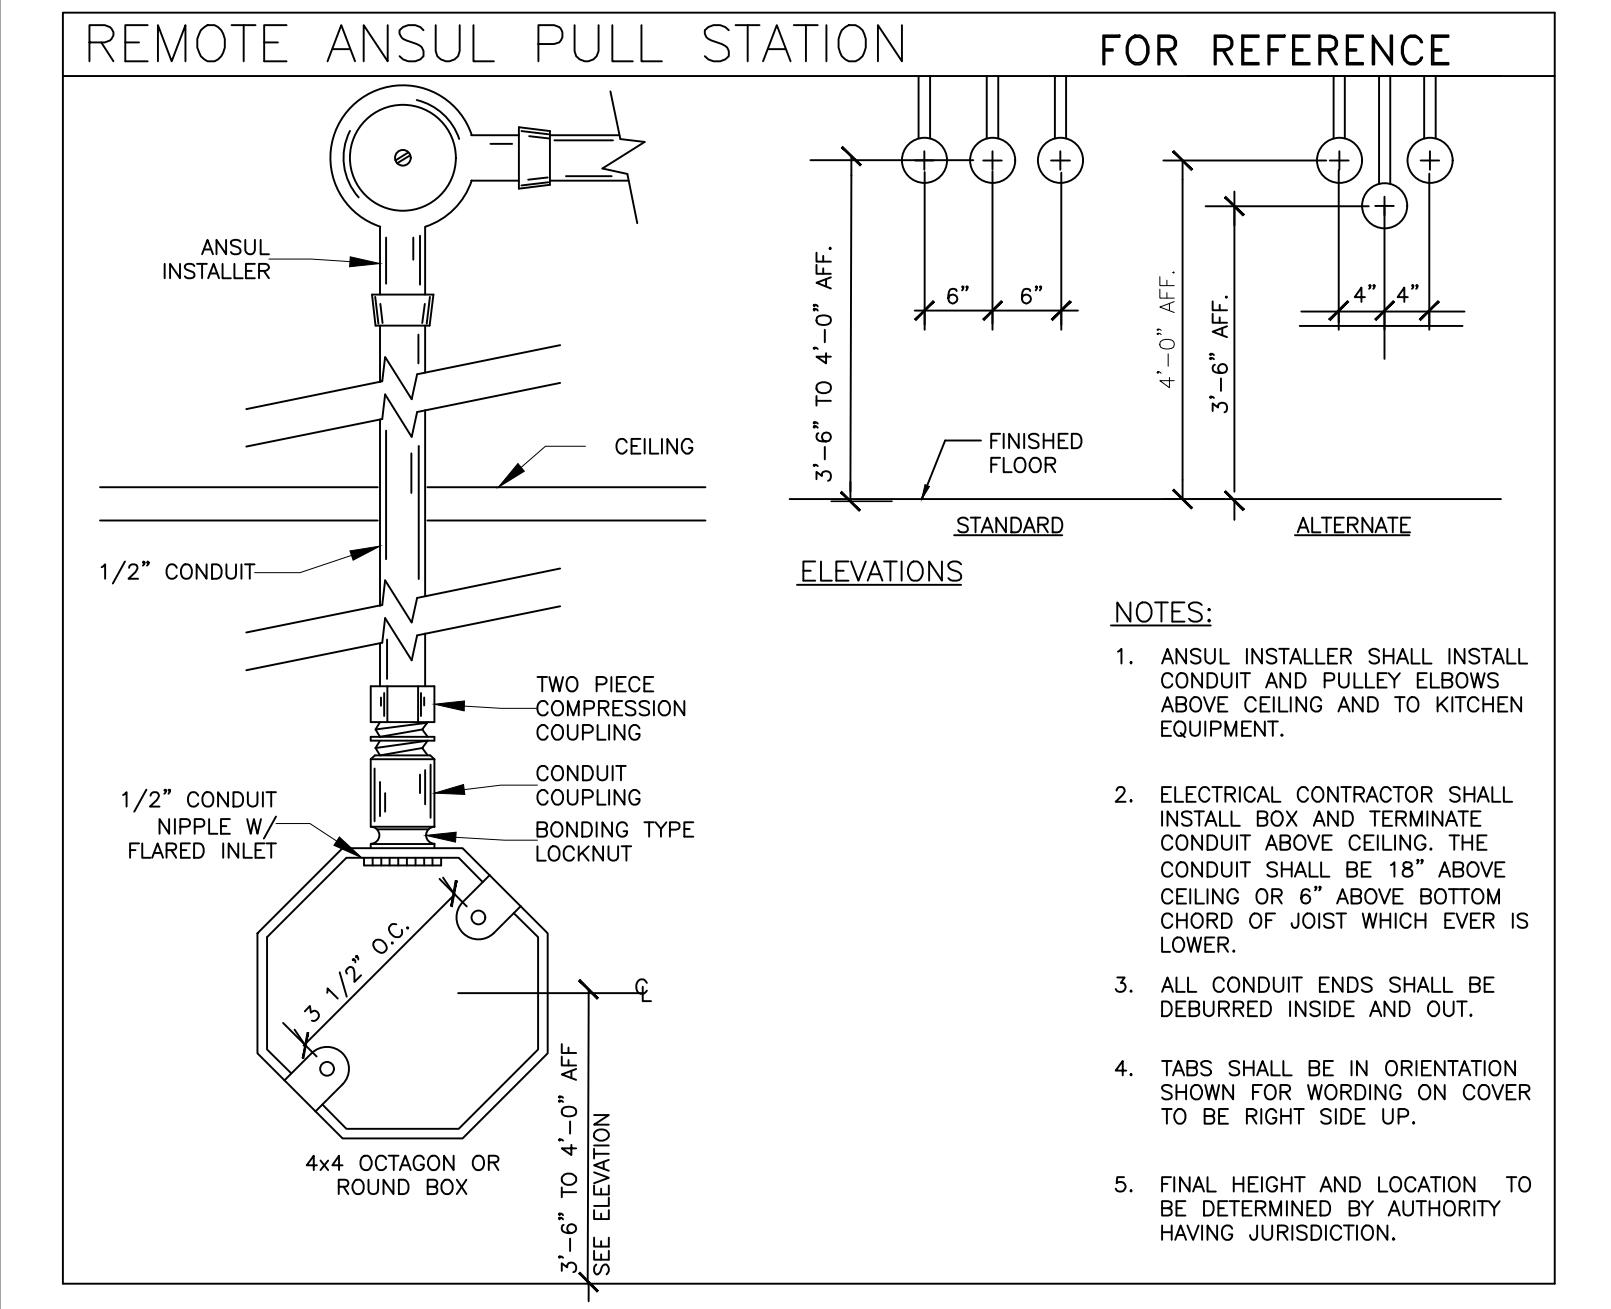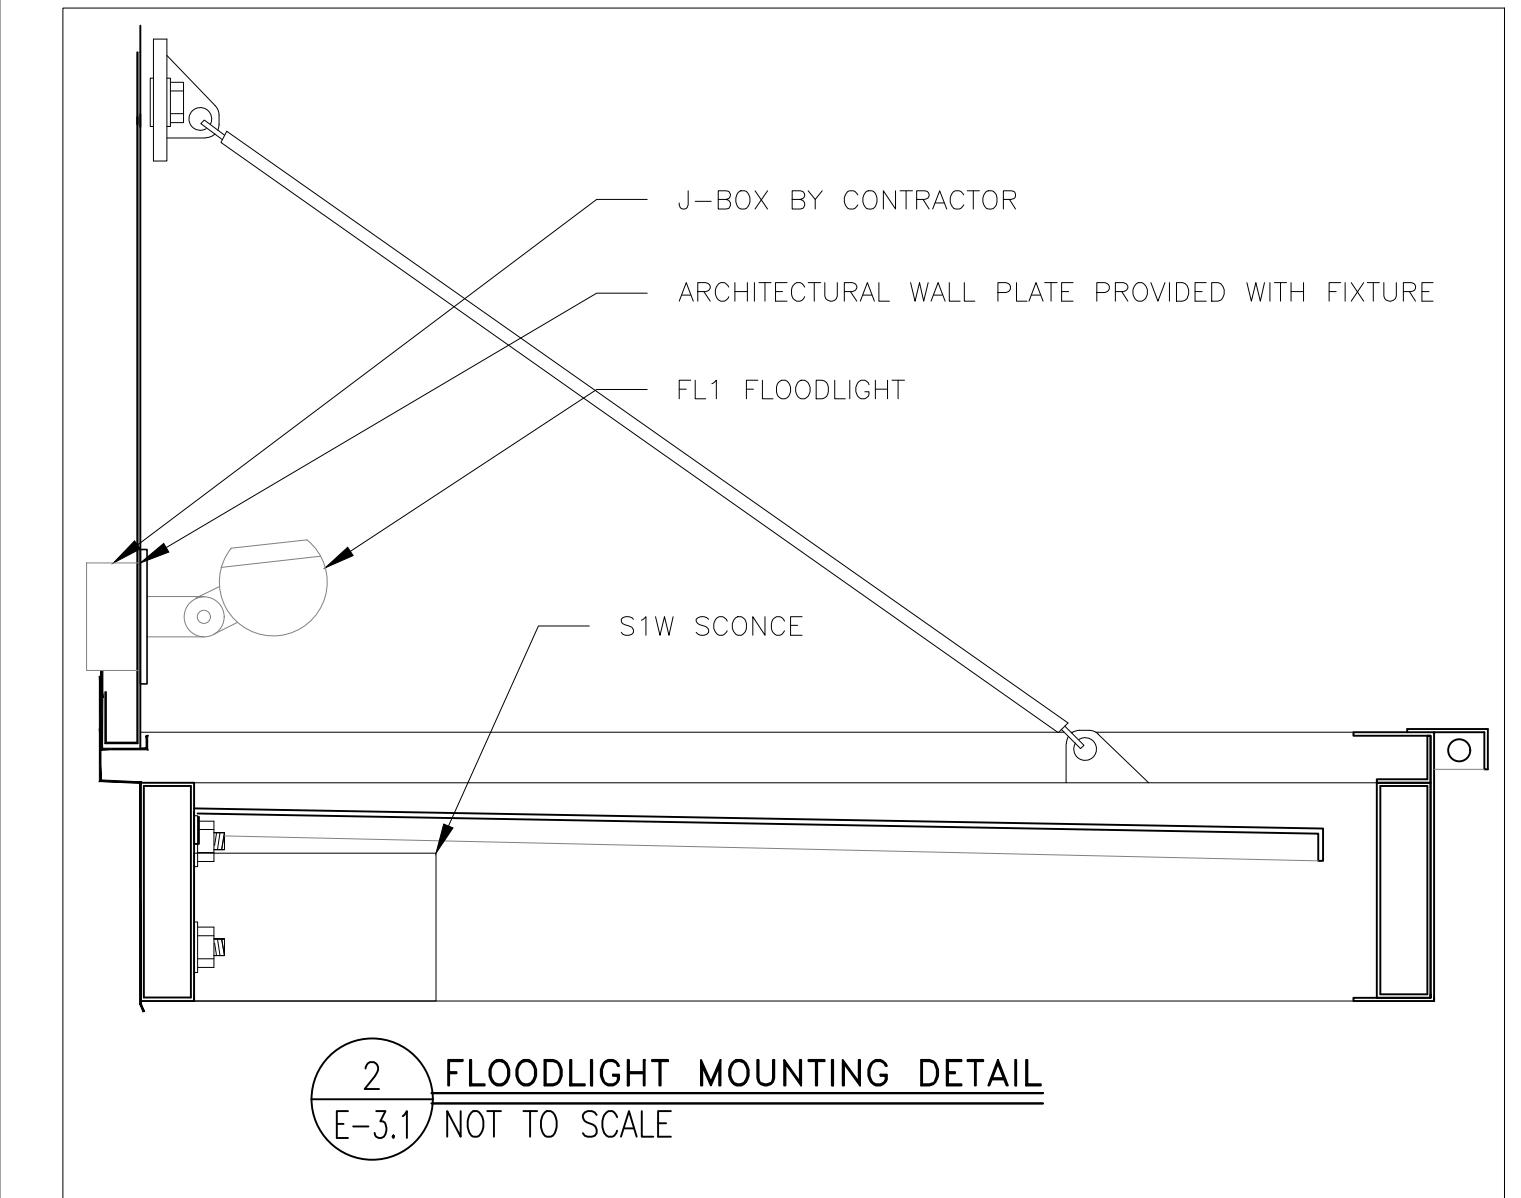


NOTES:
1. THIS EXAMPLE IS FOR A SIDE BY SIDE CASH HANDLER THAT DOES NOT HAVE A RETROFIT KIT PROVIDED BY THE CASH HANDLER.
2. EACH SIDE BY SIDE CASH HANDLER UTILIZES 3 PLUGS AND ADDS 4.4 AMPS OF LOAD.
3. EACH STACKED CASH HANDLER UTILIZED 2 PLUGS AND ADDS 3.6 AMPS OF LOAD.
4. ONE SIDE BY SIDE CAN BE CONNECTED TO A KIOSK, HOWEVER TWO STACKED UNITS CAN BE CONNECTED. REFER TO DECOR PLANS FOR EXACT CONFIGURATIONS.

5 TYP. CASH HANDLER POWER DETAIL
E-3.1 NOT TO SCALE

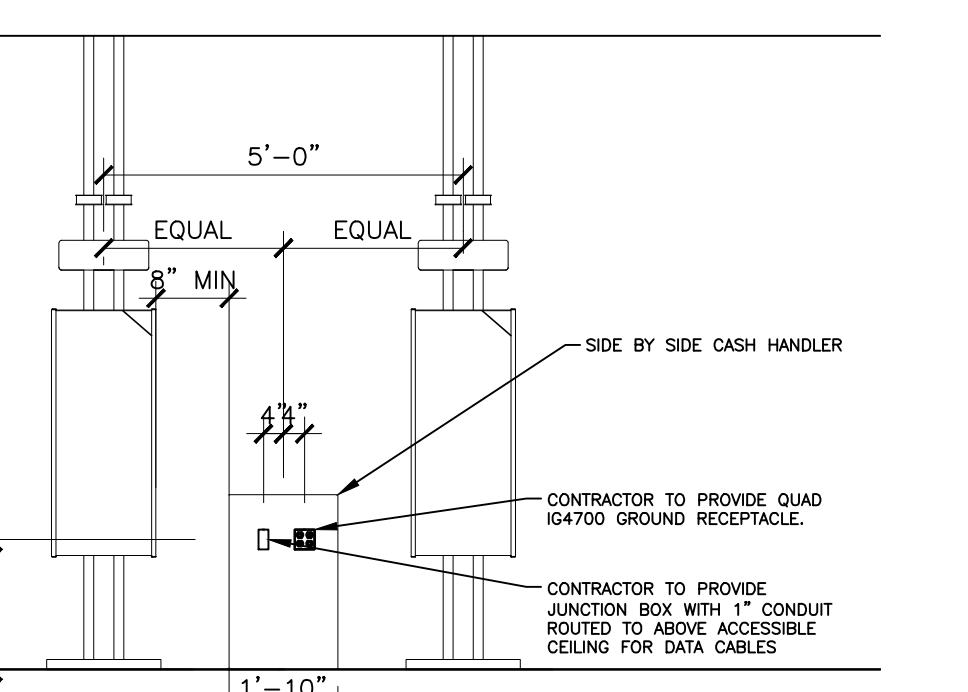

NOTES:
1. THIS EXAMPLE IS FOR A SIDE BY SIDE CASH HANDLER WITH THE REAR OF THE UNIT FACING A FULL HEIGHT GO BUILT WALL.
2. EACH SIDE BY SIDE CASH HANDLER UTILIZED 3 PLUGS AND ADDS 4.4 AMPS OF LOAD.
3. EACH STACKED CASH HANDLER UTILIZED 2 PLUGS AND ADDS 3.6 AMPS OF LOAD.
4. ONE SIDE BY SIDE CAN BE CONNECTED TO A KIOSK, HOWEVER TWO STACKED UNITS CAN BE CONNECTED. REFER TO DECOR PLANS FOR EXACT CONFIGURATIONS.


4 CASH HANDLER POWER DETAIL W/REAR TO WALL
E-3.1 NOT TO SCALE

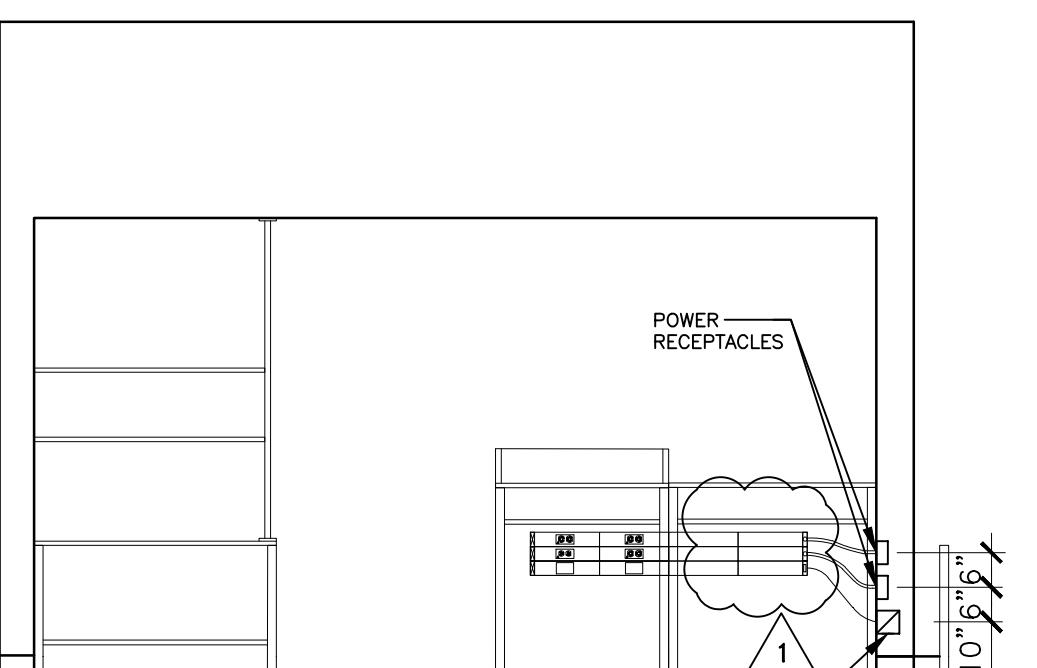

SYMBOL	CATALOG #	DESCRIPTION	J-BOX(S) FOR DATA
■	HBLALU570R & IG4700	RECEPTACLE COVERPLATE WITH ORANGE, DUPLEX RECEPTACLE	
■	HBLALU570R & S-20R FOR BAKED GOODS AND IG5562 FOR CASH	RECEPTACLE COVERPLATE WITH STRAIGHT BLADE RECEPTACLE	
■	HBLALU71PB	COMMUNICATIONS COVERPLATE	
■	HBLALU720B02V290	2' SECTION OF RACEWAY, INCLUDES COUPLERS	
■	HBLALU720B03V290	3' SECTION OF RACEWAY, INCLUDES COUPLERS	
■	HBLALU710R2M2	SERVICE ENTRANCE FITTING & BUSHING FOR DATA CABLES	
■	HBLALU710E	BLANK END FITTING	
N/A	HBLALU5701	COUPLER (INCLUDED WITH RACEWAY SECTION)	
N/A	HBLALU5709	GROUND ADAPTER	

NOTES:
1. REFER TO SERVICE POD MANUFACTURER INSTRUCTIONS FOR EXACT PLACEMENT OF RACEWAY
2. RACEWAY AND RECEPTACLES TO BE PROVIDED WITH SERVICE POD, INSTALLED BY CONTRACTOR.
3. DETAIL SHOWN IS A TYPICAL CONFIGURATION ONLY. SITE SPECIFICS MIGHT CAUSE DEVIATIONS.
4. PART NUMBERS SHOWN REFLECT HUBBELL, SOME SUPPLIERS MAY USE WIREMOLE EQUIVALENT.

1 SERVICE POD RACEWAY DETAIL
E-3.1 NOT TO SCALE

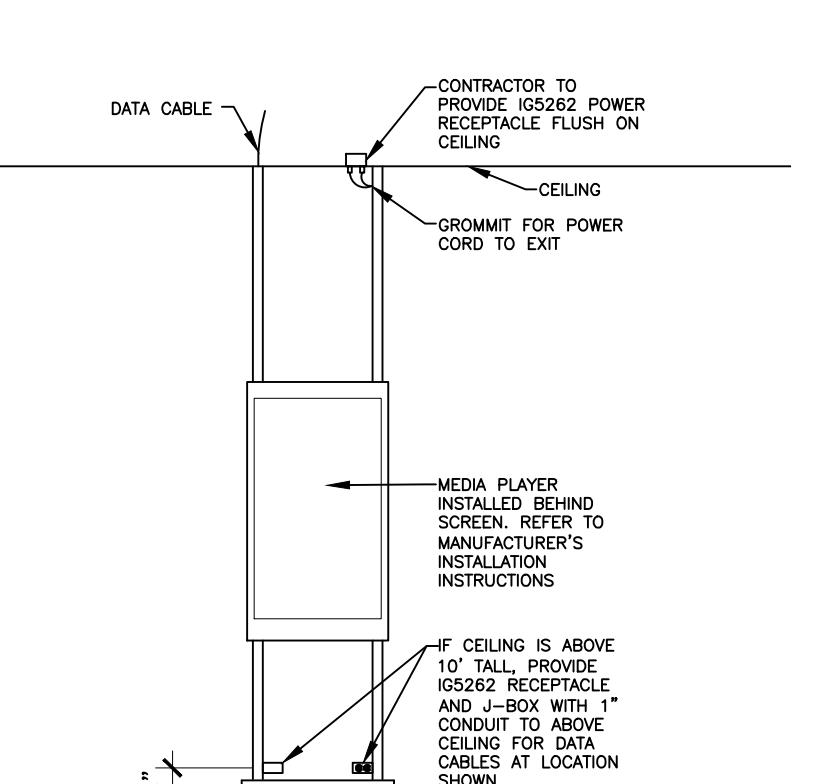

NOTES:
1. DIGITAL MERCHANDISE CHANNELS ARE DESIGNED TO REACH UP TO A 10' CEILING. IF CEILING IS TALLER, EXTENDER KIT CAN BE ORDERED TO REACH 15'.

3 FREESTANDING MERC POWER DETAIL
E-3.1 NOT TO SCALE

GENERAL ELECTRICAL NOTES:

INSTALLATION METHODS:

- M1. ALL ELECTRICAL MATERIAL USED ON THIS PROJECT SHALL BE "UL" LISTED AND LABELED.
- M2. ALL DIMENSIONS SHOWN ARE TAKEN FROM FACE OF GYP BOARD/PLYWOOD. THE EC SHALL MAKE NECESSARY DIMENSIONAL ALLOWANCES. ALL DIMENSIONS SHOWN ARE TO CENTER LINE OF OUTLET BOX AND/OR RECEPTACLE UNLESS NOTED OTHERWISE.
- M3. ALL J-BOXES, DCO's, AND OTHER ELECTRICAL DEVICES SHOWN SHALL BE RECESSED INTO A WALL, FLOOR OR CEILING UNLESS SPECIFICALLY NOTED OTHERWISE.
- M4. ALL RECEPTACLES (EXCEPT SPECIFIED HUBBELL PIN & SLEEVE TYPES) SHALL BE FURNISHED BY THE EC. THE RECEPTACLES INCLUDING PIN AND SLEEVE TYPE SHALL BE INSTALLED BY THE EC.
- M5. EC SHALL PROVIDE STAINLESS STEEL COVER PLATES ON ALL RECEPTACLES AND J-BOXES. ADDITIONALLY, EC SHALL PROVIDE ORANGE NYLON COVER PLATES MARKED "COMPUTER ONLY" ON ALL ISOLATED GROUND/DEDICATED CIRCUIT RECEPTACLES. PURCHASE P80C (ONE DUPLEX) OR PJ82C (TWO DUPLEX) FROM HUBBELL.
- M6. ROUGH-IN FOR OPTIONAL EQUIPMENT ARE SHOWN ON THESE SHEETS. EC SHALL VERIFY WITH McDONALD'S PROJECT MANAGER WHICH OPTIONAL EQUIPMENT IS TO BE INCLUDED AND INSTALL OPTIONAL ROUGH-INS AS REQUIRED. PRICING FOR OPTIONAL ROUGH-INS SHALL BE INCLUDED IN BID AND CALLED OUT AS OPTIONAL.
- M7. EC SHALL COORDINATE WITH KITCHEN EQUIPMENT SUPPLIER, MECHANICAL CONTRACTOR AND GC FOR FINAL LOCATIONS AND CONNECTION REQUIREMENTS OF ALL EQUIPMENT PRIOR TO INSTALLATION OF ANY CONDUIT AND/OR STUB-UP LOCATIONS.
- M8. CEILING MOUNTED ECONOMY OEP BOX IS FURNISHED BY McDONALD'S, AND INSTALLED BY THE GC. CORD AND PLUG SET FURNISHED BY KES AND INSTALLED BY THE EC.
- M9. FOR GRILLS, FRYERS, AND ANSUL SYSTEMS, EC SHALL EXTEND CONDUIT AND CONDUCTORS DOWN CHASE OR WALL TO TERMINAL BLOCK MOUNTED ON EQUIPMENT AND MAKE FINAL CONNECTIONS TO TERMINAL BLOCKS.
- M10. ALL HOLES IN THE FRONT COUNTER FOR THE POS CORDS AND CABLES SHALL BE LOCATED BY OWNER AND DRILLED BY GC.
- M11. ALL ELECTRICAL CONDUCTORS SHALL BE CONNECTED TO RECEPTACLES USING ONLY THE TERMINAL SCREWS. RECEPTACLE BACK WIRE/QUICK CONNECTIONS SHALL NOT BE USED.
- M12. EC SHALL PROVIDE 208V HEAT TRACE ON THE FREEZER EVAPORATOR CONDENSATE DRAIN LINE. HEAT TRACE SHALL OPERATE CONTINUOUSLY. EC SHALL WIRE HEAT TRACE TO FREEZER EVAPORATOR POWER SUPPLY. A SEPARATE CIRCUIT FOR HEAT TRACE IS NOT REQUIRED. VERIFY HEAT TRACE REQUIREMENTS WITH EVAPORATOR MANUFACTURER.
- M13. POWER AND CONTROL CORDS ARE FURNISHED WITH KITCHEN APPLIANCES. THE EC SHALL CONNECT CORD SETS TO APPLIANCES AS REQUIRED.

- M14. GC SHALL NOT INSTALL CEILING TILE IN AREAS OF THE BEVERAGE BAR REFRIGERATION LINES AND EQUIPMENT PENETRATION LOCATIONS UNTIL THE LINES HAVE BEEN INSTALLED. THE CEILING TILE INSTALLER SHALL RETURN AND INSTALL THE TILES AFTER THE REFRIGERATION LINES HAVE BEEN INSTALLED AND TESTED.

UTILITIES:

- U1. INCOMING SERVICE SHALL BE 208V/120V, 3 PHASE, 4 WIRE. ANY DEVIATIONS TO THIS SERVICE TYPE SHALL NOT BE PERMITTED UNLESS APPROVED IN WRITING BY McDONALD'S.
- U2. THE EC SHALL ARRANGE WITH THE ELECTRIC, TELEPHONE, AND OTHER UTILITY COMPANIES FOR INCOMING SERVICE REQUIREMENTS AND SHALL INCLUDE ALL COSTS IN BASE BID.
- U3. THE EC SHALL VERIFY EXACT METHODS AND REQUIREMENTS FOR ELECTRICAL SERVICE WITH LOCAL UTILITY COMPANY. CURRENT TRANSFORMERS SHALL BE INSTALLED OUTSIDE RESTAURANT, LOCATE INSIDE ONLY IF REQUIRED BY UTILITY COMPANY OR LOCAL AUTHORITIES.
- U4. PROVIDE CONCRETE PAD IF TRANSFORMER IS LOCATED ON GRADE AND PROVIDE SECONDARY SERVICE FEEDER AND CONDUITS TO PANEL MDP AS PER LOCAL UTILITY REQUIREMENTS.
- U5. THE EC/GC/ACM SHALL OBTAIN AVAILABLE SHORT CIRCUIT CURRENT FROM THE LOCAL UTILITY COMPANY. THE EC/GC/ACM SHALL ADVISE IN WRITING (FAX SUPPLIER THE UTILITY LETTER) THE AVAILABLE AMOUNT OF FAULT CURRENT. THE PANELBOARD SUPPLIER SHALL BE RESPONSIBLE TO VERIFY THAT THE ELECTRICAL EQUIPMENT SHIPPED HAS APPROPRIATE ELECTRICAL RATINGS WHICH ARE EQUAL TO OR GREATER THAN THE AVAILABLE AMOUNT OF FAULT CURRENT AT THE SITE.

- U6. EC AND ACM OR OWNER/OPERATOR AND ACM SHALL COORDINATE WITH LOCAL PHONE COMPANY TO PROVIDE A 4 PAIR (OR MORE) COPPER TELEPHONE CABLE FROM THE TELEPHONE UTILITY EASEMENT TO THE RESTAURANT TELEPHONE DEMARCAION POINT. IF THE TELEPHONE PANEL/BOX IS LOCATED INSIDE THE RESTAURANT, EC SHALL PROVIDE (2) EMPTY 3/4" CONDUITS FROM THE TELEPHONE PANEL/BOX UP TO ABOVE THE CEILING FOR FUTURE TELEPHONE CABLE INSTALLATION. ADDITIONALLY, THE EC SHALL PROVIDE AN EMPTY 3/4" CONDUIT FROM THE TELEPHONE PANEL/BOX TO THE LOCATION OF THE FUTURE INTERNET SERVER (VERIFY LOCATION WITH PM). EC SHALL CONNECT, INSTALL AND INCOPORATE ALL OTHER REQUIREMENTS NECESSARY FOR COMPLETE AND OPERATIONAL TELEPHONE SYSTEM(S) FOR THIS SITE. THE REMAINING UNUSED TELEPHONE CONDUCTOR PAIRS SHALL BE CAPPED AND LEFT IN PLACE FOR FUTURE USE. THE TELEPHONE PANEL/BOX SHALL BE GROUNDED AS SHOWN IN THE "BUILDING ELECTRICAL GROUNDING DETAIL".
- U7. EC SHALL PROVIDE A 4" SCHEDULE 40/80 PVC CONDUIT THAT IS SUITABLE FOR DIRECT BURIAL FROM BUILDING TO UTILITY EASEMENT/ROW IN UTILITY CABLING/CONDUIT TRENCH PROVIDED BY GC. CONDUIT SHALL RUN FROM INCOMING TELCOM LOCATION AT BUILDING TO TELECOM PEDESTAL LOCATION IN UTILITY EASEMENT/ROW. VERIFY EXACT LOCATIONS IN FIELD WITH AREA CONSTRUCTION MANAGER AND TELECOM UTILITY PROVIDER PRIOR TO INSTALLATION.

INSTALLATION NOTES:

- I1. IF TELCOM CONDUIT IS TERMINATED WITHIN BUILDING, PVC SHALL TRANSITION TO HWG/RMC TYPE CONDUIT PRIOR TO RISING ABOVE FINISHED SLAB.
- I2. PROVIDE THERMOPLASTIC BUSHINGS AT BOTH ENDS OF CONDUIT FOR CABLING PROTECTION.
- I3. IF 90 DEGREE BENDS ARE REQUIRED, CONTRACTOR SHALL PROVIDE WIDE SWEEPING BENDS TO PREVENT BENDING/DAMAGE TO CABLE.
- I4. ALL COMMUNICATIONS CABLING SHALL BE PULLED VIA THIS CONDUIT.
- I5. INSTALL A MINIMUM OF 6 PULL WIRES IN CONDUIT TO ALLOW FOR THE INSTALLATION OF FUTURE CABLING. USE NON-DEGRADING POLYPROPYLENE OR MONOFILAMENT PLASTIC LINE OR #12 AWG SOLID COPPER CONDUCTORS WITH NOT LESS THAN 200 LB TENSILE STRENGTH. PROVIDE AT LEAST 12 INCHES OF SLACK AT EACH END OF PULL WIRE.
- I6. AFTER INSTALLATION OF COMMUNICATIONS CABLING AND PULLSTRINGS/WIRES, CONTRACTOR SHALL SEAL BOTH ENDS OF CONDUIT TO PREVENT INTRUSION FROM WEATHER, RODENTS, DEBRIS, ETC. SEAL SHALL BE OF TYPE TO ALLOW FOR REMOVAL FOR INSTALLATION OF FUTURE CABLING.

CONDUT AND WIRE:

- W1. THE FOLLOWING WIRING METHODS SHALL NOT BE USED: NON-METALLIC SHEATHED CABLE (ROMEX, NM, NMC, & NMS), ARMORED CABLE TYPE AC (BX), ELECTRICAL NON-METALLIC TUBING, TYPE ENT (SMUR-TUBE).

- W2. CONDUIT RUNS MAY BE COMBINED EXCEPT WHERE ISOLATED GROUNDS ARE USED. IG CIRCUITS SHALL BE RUN IN SEPARATE CONDUITS. ALL HOME RUNS SHALL BE SIZED BASED ON DERATED CONDUCTOR AMPACITIES AND INCREASE CONDUIT AND WIRE SIZE AS REQUIRED BY NEC SECTION 310 REQUIREMENTS.

- W3. CONDUIT SHALL HAVE A MAXIMUM OF 4 BENDS WITHOUT A JUNCTION BOX TO PREVENT DAMAGE TO CABLE DURING PULLING. THE EC SHALL PIGTAIL #12 PULL WIRE AT EACH END FOR INSTALLER TO PULL CABLE. ALL LOW VOLTAGE CONDUIT STUB-UPS SHALL BE PROVIDED WITH A BUSHING.

- W4. MINIMUM WIRE SIZE SHALL BE #12 AWG COPPER UNLESS NOTED OTHERWISE. MINIMUM CONDUIT SIZE SHALL BE 1/2" UNLESS NOTED OTHERWISE. WIRES INSTALLED UNDERGROUND OR OUTDOORS SHALL BE THW.

- W5. CONDUCTORS #10 AWG AND SMALLER SHALL BE SOLID COPPER. CONDUCTORS #8 AND LARGER SHALL BE STRANDED COPPER. ALUMINUM CONDUCTORS SHALL NOT BE UTILIZED FOR FEEDER OR BRANCH CIRCUIT DISTRIBUTION.

- W6. RACEWAYS SHALL BE ANY OF THE FOLLOWING MATERIALS, INSTALLED IN ACCORDANCE WITH ALL APPLICABLE CODES:

OUTDOORS: (FOR SPECIFIC APPLICATIONS AND APPROPRIATE FITTINGS, SEE TABLE W6)

- O1. EXPOSED: RMC, IMC.
- O2. CONCEALED: RMC, IMC.
- O3. BELOW GRADE, SINGLE RUN: RNC, RMC.
- O4. BELOW GRADE, GROUPED: RNC, RMC.
- O5. CONNECTION TO VIBRATING EQUIPMENT (INCLUDING TRANSFORMERS AND HYDRAULIC, PNEUMATIC, ELECTRIC SOLENOID, OR MOTOR-DRIVEN EQUIPMENT): LFMC.
- O6. BOXES AND ENCLOSURES: NEMA 250, TYPE 3R OR 4.

INDOORS: (FOR SPECIFIC APPLICATIONS AND APPROPRIATE FITTINGS, SEE TABLE W6)

- I1. EXPOSED: EMT, IMC.
- I2. CONCEALED: EMT, IMC.
- I3. (CONTINUED ON TOP)

3. CONNECTION TO VIBRATING EQUIPMENT (INCLUDING TRANSFORMERS AND HYDRAULIC, PNEUMATIC, ELECTRIC SOLENOID, OR MOTOR-DRIVEN EQUIPMENT): FMC; EXCEPT USE LFMC IN DAMP OR WET LOCATIONS.
4. DAMP OR WET LOCATIONS: RIGID STEEL CONDUIT.
5. BOXES AND ENCLOSURES: NEMA 250, TYPE 1, EXCEPT AS FOLLOWS: A. DAMP, WET OR KITCHEN LOCATIONS: NEMA 250, TYPE 4, STAINLESS STEEL.

TABLE W6:

LOCATION	208V.	480V.	LOW ENERGY*
EXPOSED			
INDOORS	< 1" EMT COMPRESS. FTGS >1.25" IMC THREADED FTGS	IMC THREADED FTGS	EMT COMP. FTGS
OUTDOORS	RMC OR IMC THREADED FTGS	RMC OR IMC THREADED FTGS	RMC OR IMC THREADED FTGS
CONCEALED			
WALLS	<2" EMT SET SCREW FTGS >2.5" IMC THREADED FTGS	<2" EMT SET SCREW FTGS >2.5" IMC THREADED FTGS	EMT 1/2"- 2" SET SCREW FTGS 2.5"- 4" COMPR. FTGS
AIR HANDLING CEILING/SPACE	<2" EMT COMP. FTGS >2.5" IMC THREADED. FTGS	<2" EMT COMP. FTGS >2.5" IMC THREADED. FTGS	EMT COMP. FTGS
NON AIR HANDLING CEILING/SPACE	<2" EMT SET SCREW FTGS >2.5" IMC THREADED. FTGS	<2" EMT COMP. FTGS >2.5" IMC THREADED. FTGS	EMT 1/2"- 2" SET SCREW FTGS 2.5"- 4" COMPR. FTGS
BELLOW GRADE			
INTERIOR	IMC THREADED FTGS OR SCHEDULE 40 OR 80 PVC	IMC THREADED FTGS	IMC THREADED FTGS SCHEDULE 40 OR 80 PVC
EXTERIOR	SCHEDULE 40 OR 80 PVC OR RMC THREADED FTGS	SCHEDULE 40 OR 80 PVC OR RMC THREADED FTGS	SCHEDULE 40 OR 80 PVC OR RMC THREADED FTGS

- W7. ALL CONDUITS PENETRATING THE FREEZER/COOLER BOX SHALL BE SEALED IN COMPLIANCE NEC SECTION 300 AND THE FREEZER/COOLER BOX MANUFACTURERS REQUIREMENTS.
- W8. PROVIDE THREE (3) 3/4" EMPTY CONDUITS FROM PANEL LP-1 UP TO THE CEILING SPACE AND CAP FOR FUTURE USE.

GROUNDING:

- G1. ALL BRANCH AND FEEDER CIRCUITS SHALL BE GROUNDED BY TWO METHODS. THE FIRST METHOD SHALL INCLUDE AN INSULATED COPPER EQUIPMENT GROUNDBUS CONDUCTOR CONTAINED WITHIN THE SAME CONDUIT AS THE PHASE CIRCUIT CONDUCTORS AND SIZED PER NEC SECTION 250 REQUIREMENTS. THIS INSULATED CONDUCTOR GROUNDBUS SHALL HAVE ONE END PROPERLY TERMINATED TO THE EQUIPMENT GROUND BUS IN THE CORRESPONDING GROUND BREAKER PANEL AND THE OTHER END TERMINATED AT THE GROUNDING CONTACT OF A GROUNDING RECEPTACLE AND TO THE JUNCTION BOX OR TO AN EQUIPMENT CABINET AS APPLICABLE. THE SECOND METHOD PROVIDES EQUIPMENT GROUNDBUS VIA METALLIC CONDUIT THAT IS CONNECTED AND TERMINATED IN FITTINGS LISTED FOR GROUNDBUS PER NEC SECTION 250 REQUIREMENTS. BOTH GROUNDBUS SHALL BE INSTALLED WHERE INDICATED ON PLAN AND AS SHOWN IN POS ISOLATED GROUNDED/DEDICATED CIRCUIT DETAIL ON SHEET E4.2.
- G2. THE BUILDING GROUNDSYSTEM SHALL COMPLY WITH NEC ARTICLE 250. McDONALD'S SPECIFICATIONS, AND SHEET E4.2. CAUTION: IT IS A SAFETY HAZARD AND AN NEC VIOLATION TO HAVE ANY NEUTRAL TO GROUND CONNECTIONS BEYOND THE MAIN ELECTRICAL DISCONNECT MEANS. McDONALD'S GROUNDSYSTEM PURPOSELY EXCEED THOSE GIVEN BY THE NEC. THE EC SHALL PROVIDE A BUILDING GROUNDSYSTEM MEETING NEC SECTION 250 REQUIREMENTS AS WELL AS McDONALD'S STANDARDS.
- G3. EC SHALL REFER TO "POS ISOLATED GROUNDED/DEDICATED CIRCUIT DETAIL, SHEET E4.2, FOR REQUIRED WIRING REQUIREMENTS OF COMPUTER PANEL CP.
- G4. METAL RACEWAYS CONTAINING A GROUNDED ELECTRODE CONDUCTOR SHALL BE BONDED AT BOTH ENDS AS REQUIRED BY NEC SECTION 250 REQUIREMENTS.

TEMPERATURE CONTROLS:

- T1. REMOTE TEMPERATURE SENSORS: EC SHALL PROVIDE 1/2" CONDUIT FROM JUNCTION BOX ABOVE CEILING DOWN TO SENSOR MOUNTED AT 4'-0" TO 4'-6" AFF.
- T2. SEE DETAIL ON SHEET M.3. FOR SENSOR MOUNTING DETAIL. LOCATION OF WALL MOUNTED TEMPERATURE SENSORS ARE SHOWN ON SHEET M.1 AND E.20.
- T3. WHEN WIRING FOR PROGRAMMABLE THERMOSTATS AND REMOTE SENSORS IS NOT IN A CONDUIT, THE WIRING SHALL BE RUN TO THE UNDERSIDE OF THE ROOF DECK. NONE OF THE WIRING SHALL BE ROUTED OVER FLUORESCENT BALASTS, POWER BOXES OR IN A CONDUIT WITH LINE VOLTAGE WIRING AS ELECTRICAL INTERFERENCE (NOISE) WILL CAUSE ERRATIC CONTROL OPERATION. ALL THERMOSTATS SHALL BE MOUNTED 4'-0" AFF.

FLAT PANEL TELEVISIONS:

- TV1. EC SHALL PROVIDE A DUPLEX RECEPTACLE AND A LOW VOLTAGE BROADBAND CONNECTION FOR THE INSTALLATION OF FLAT PANEL TELEVISIONS. COORDINATE EXACT LOCATIONS WITH DECOR COMPANY FOR BROAD

SEQUENCE OF OPERATION:

1. TURNING "ON" ANY PIECE OF COOKING EQUIPMENT UNDER A HOOD WILL TURN ON THE EXHAUST FAN AND ASSOCIATED RTU PROVIDING MAKEUP AIR FOR THAT HOOD.
 2. TURNING "OFF" THE LAST PIECE OF COOKING EQUIPMENT UNDER A HOOD WILL TURN OFF THE EXHAUST FAN FOR THAT HOOD.
 3. IF THE ANSUL SYSTEM SHOULD DISCHARGE WHILE THE COOKING EQUIPMENT AND EXHAUST FAN ARE OPERATING, THE COOKING EQUIPMENT WILL BE SHUT OFF, BUT THE EXHAUST FAN WILL CONTINUE TO RUN AND WILL FORCE THE ROOFTOP UNITS INTO A "SCHEDULED" MODE
 4. THE ANSUL SYSTEM MUST BE RECHARGED AND MANUALLY RESET BEFORE THE COOKING EQUIPMENT WILL AGAIN BE ABLE TO OPERATE.
 5. THE ON/OFF SWITCH ON THE EXHAUST FAN IS NORMALLY KEPT IN THE "ON" POSITION. IF IT IS TURNED OFF FOR SERVICE, THE COOKING EQUIPMENT WILL TURN OFF AND NOT BE ABLE TO OPERATE UNTIL THE EXHAUST FAN ON/OFF SWITCH IS AGAIN TURNED ON.

INTERLOCK DIAGRAM LEGEND

- TERMINAL BLOCK IN CHASE

CTB - CHASE TERMINAL BLOCK. PROVIDED AND INSTALLED BY KITCHEN EQUIPMENT SUPPLIER

ETB - EQUIPMENT TERMINAL BLOCK

EFCR - EXHAUST FAN CONTROL RELAY. PROVIDED BY CONTRACTOR.

IGR - INTERNAL GRILL RELAY PROVIDED WITHIN GARLAND GRILLS

MS - ANSUL MICROSWITCH PROVIDED BY KITCHEN EQUIPMENT SUPPLIER


>> CONTROL CORD PLUG & RECEPTACLE

— FIELD WIRING

— CONTROL CORD/INTERNAL WIRING

--- FACTORY WIRING

— EQUIPMENT OR ENCLOSURE

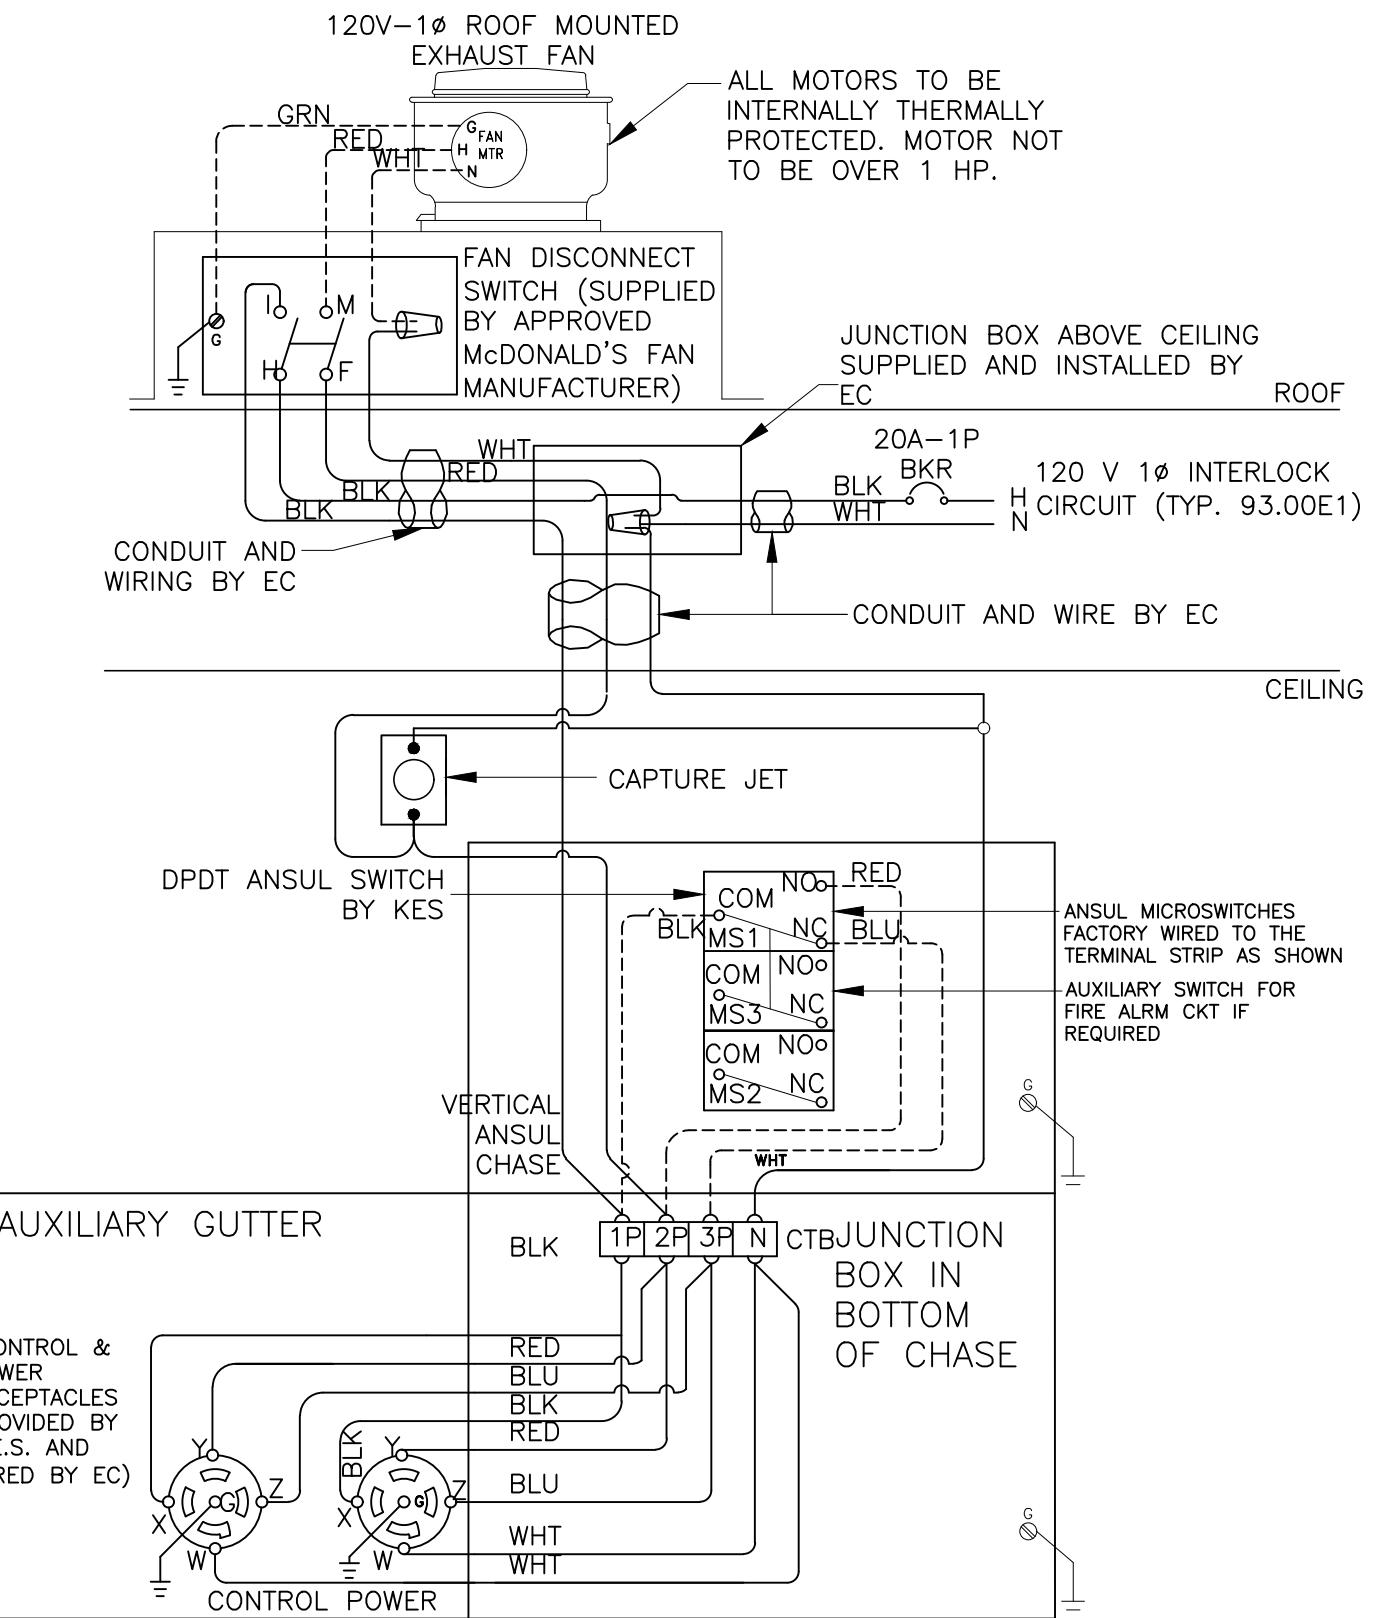


2 INTERLOCK WIRING DIAGRAM FOR EXHAUST FAN AND COOKING EQUIPMENT
-3.2 FOR REFERENCE ONLY

REVISED: 6/18

COOKING EQUIPMENT EXHAUST FAN	MAKE UP PROVIDED BY
EF/1	RTU-3
EF/2	RTU-1
EF/3	RTU-2


NOTE
RTU # ASSOCIATED WITH EACH EXHAUST FAN BASED ON PROTOTYPICAL VALUES ONLY. VERIFY THAT EXHAUST FAN ACTIVATES THE CORRESPONDING RTU TO PROVIDE AN ADEQUATE AMOUNT OF MAKEUP AIR.

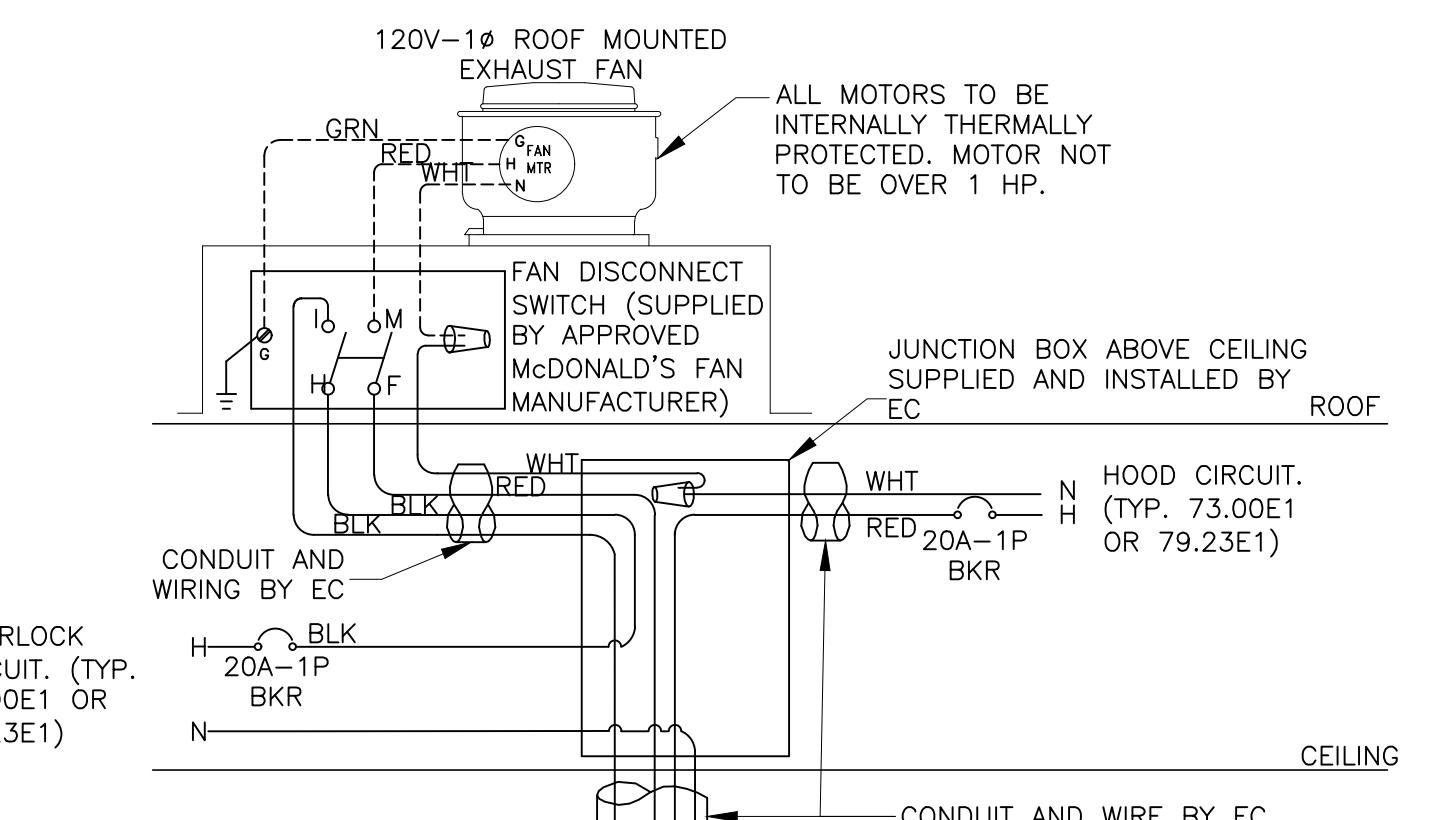

1 TYPICAL MAKEUP AIR RTU EXHAUST FAN SCHEDULE

E-3.2 FOR REFERENCE ONLY


REVISED: 6/18

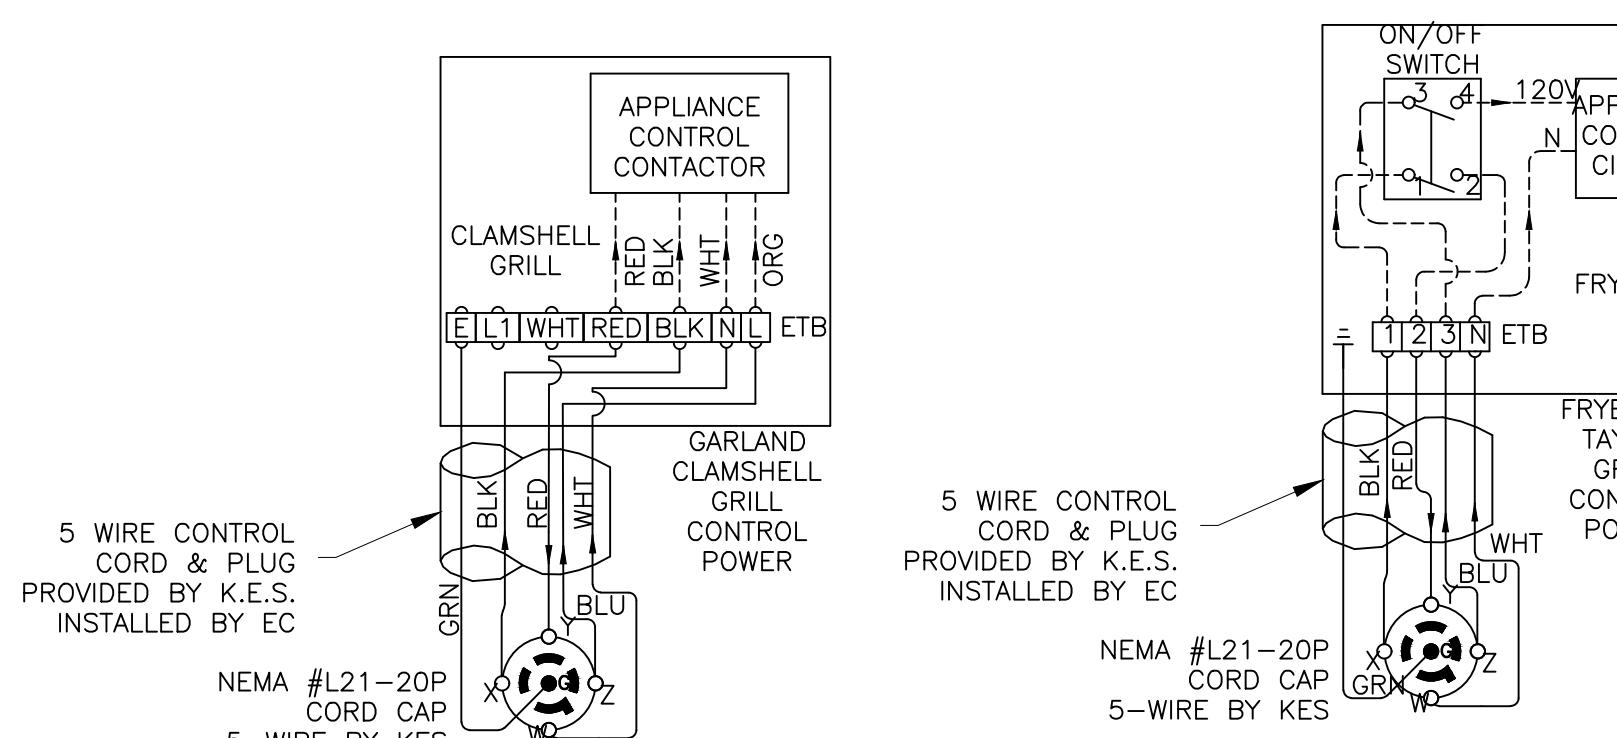

4 CONTROL CORD CONNECTION


E-3.2 FOR REFERENCE ONLY

REVISED: 6/18

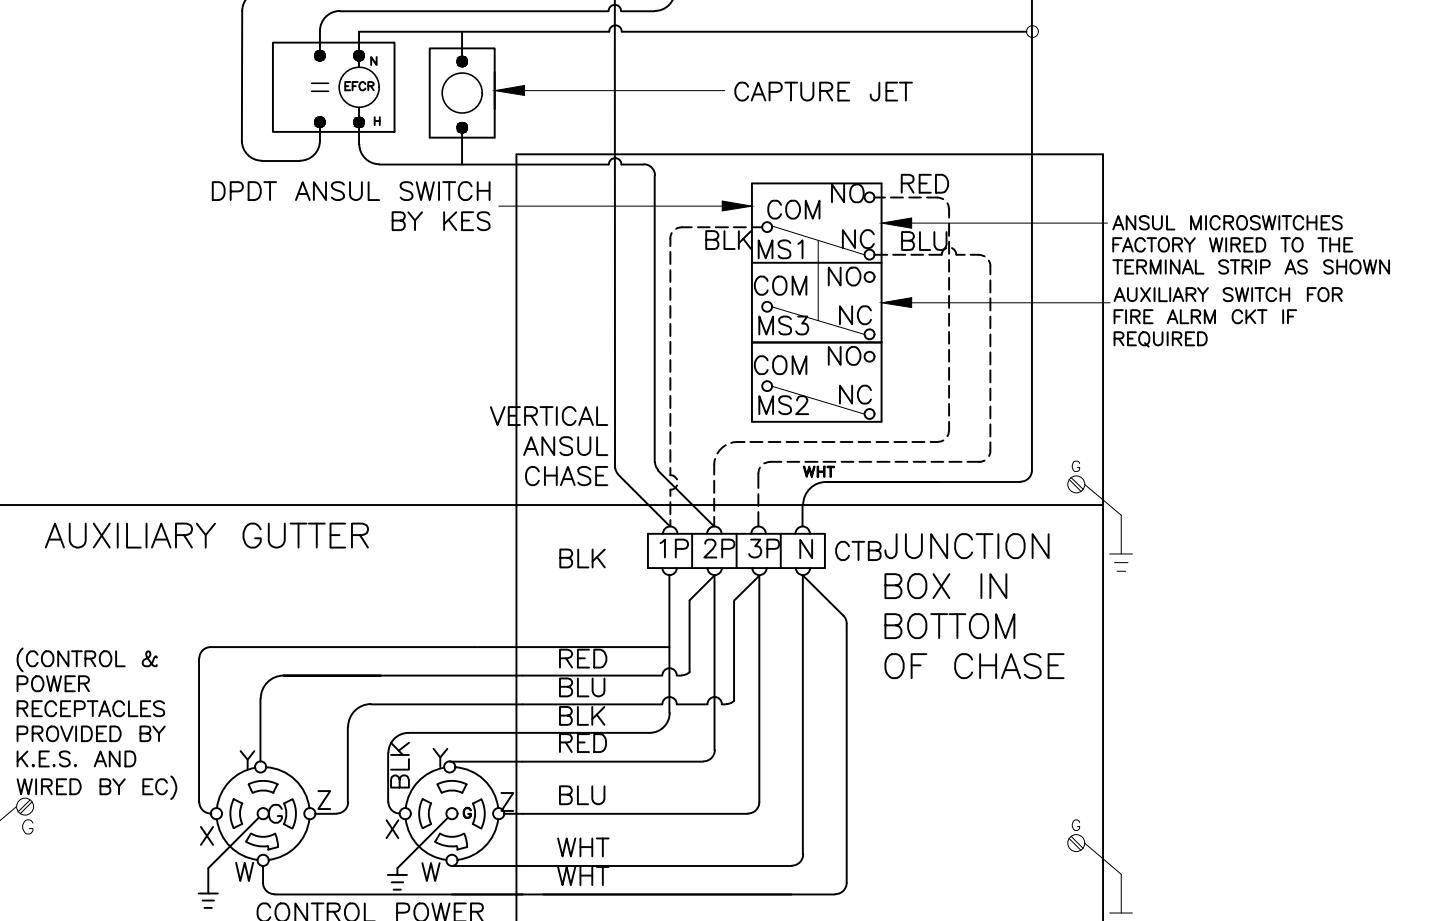

5 INTERLOCK WIRING DIAGRAM FOR EXHAUST FAN AND COOKING EQUIPMENT
-3.2 FOR REFERENCE ONLY


REVISED: 6/18

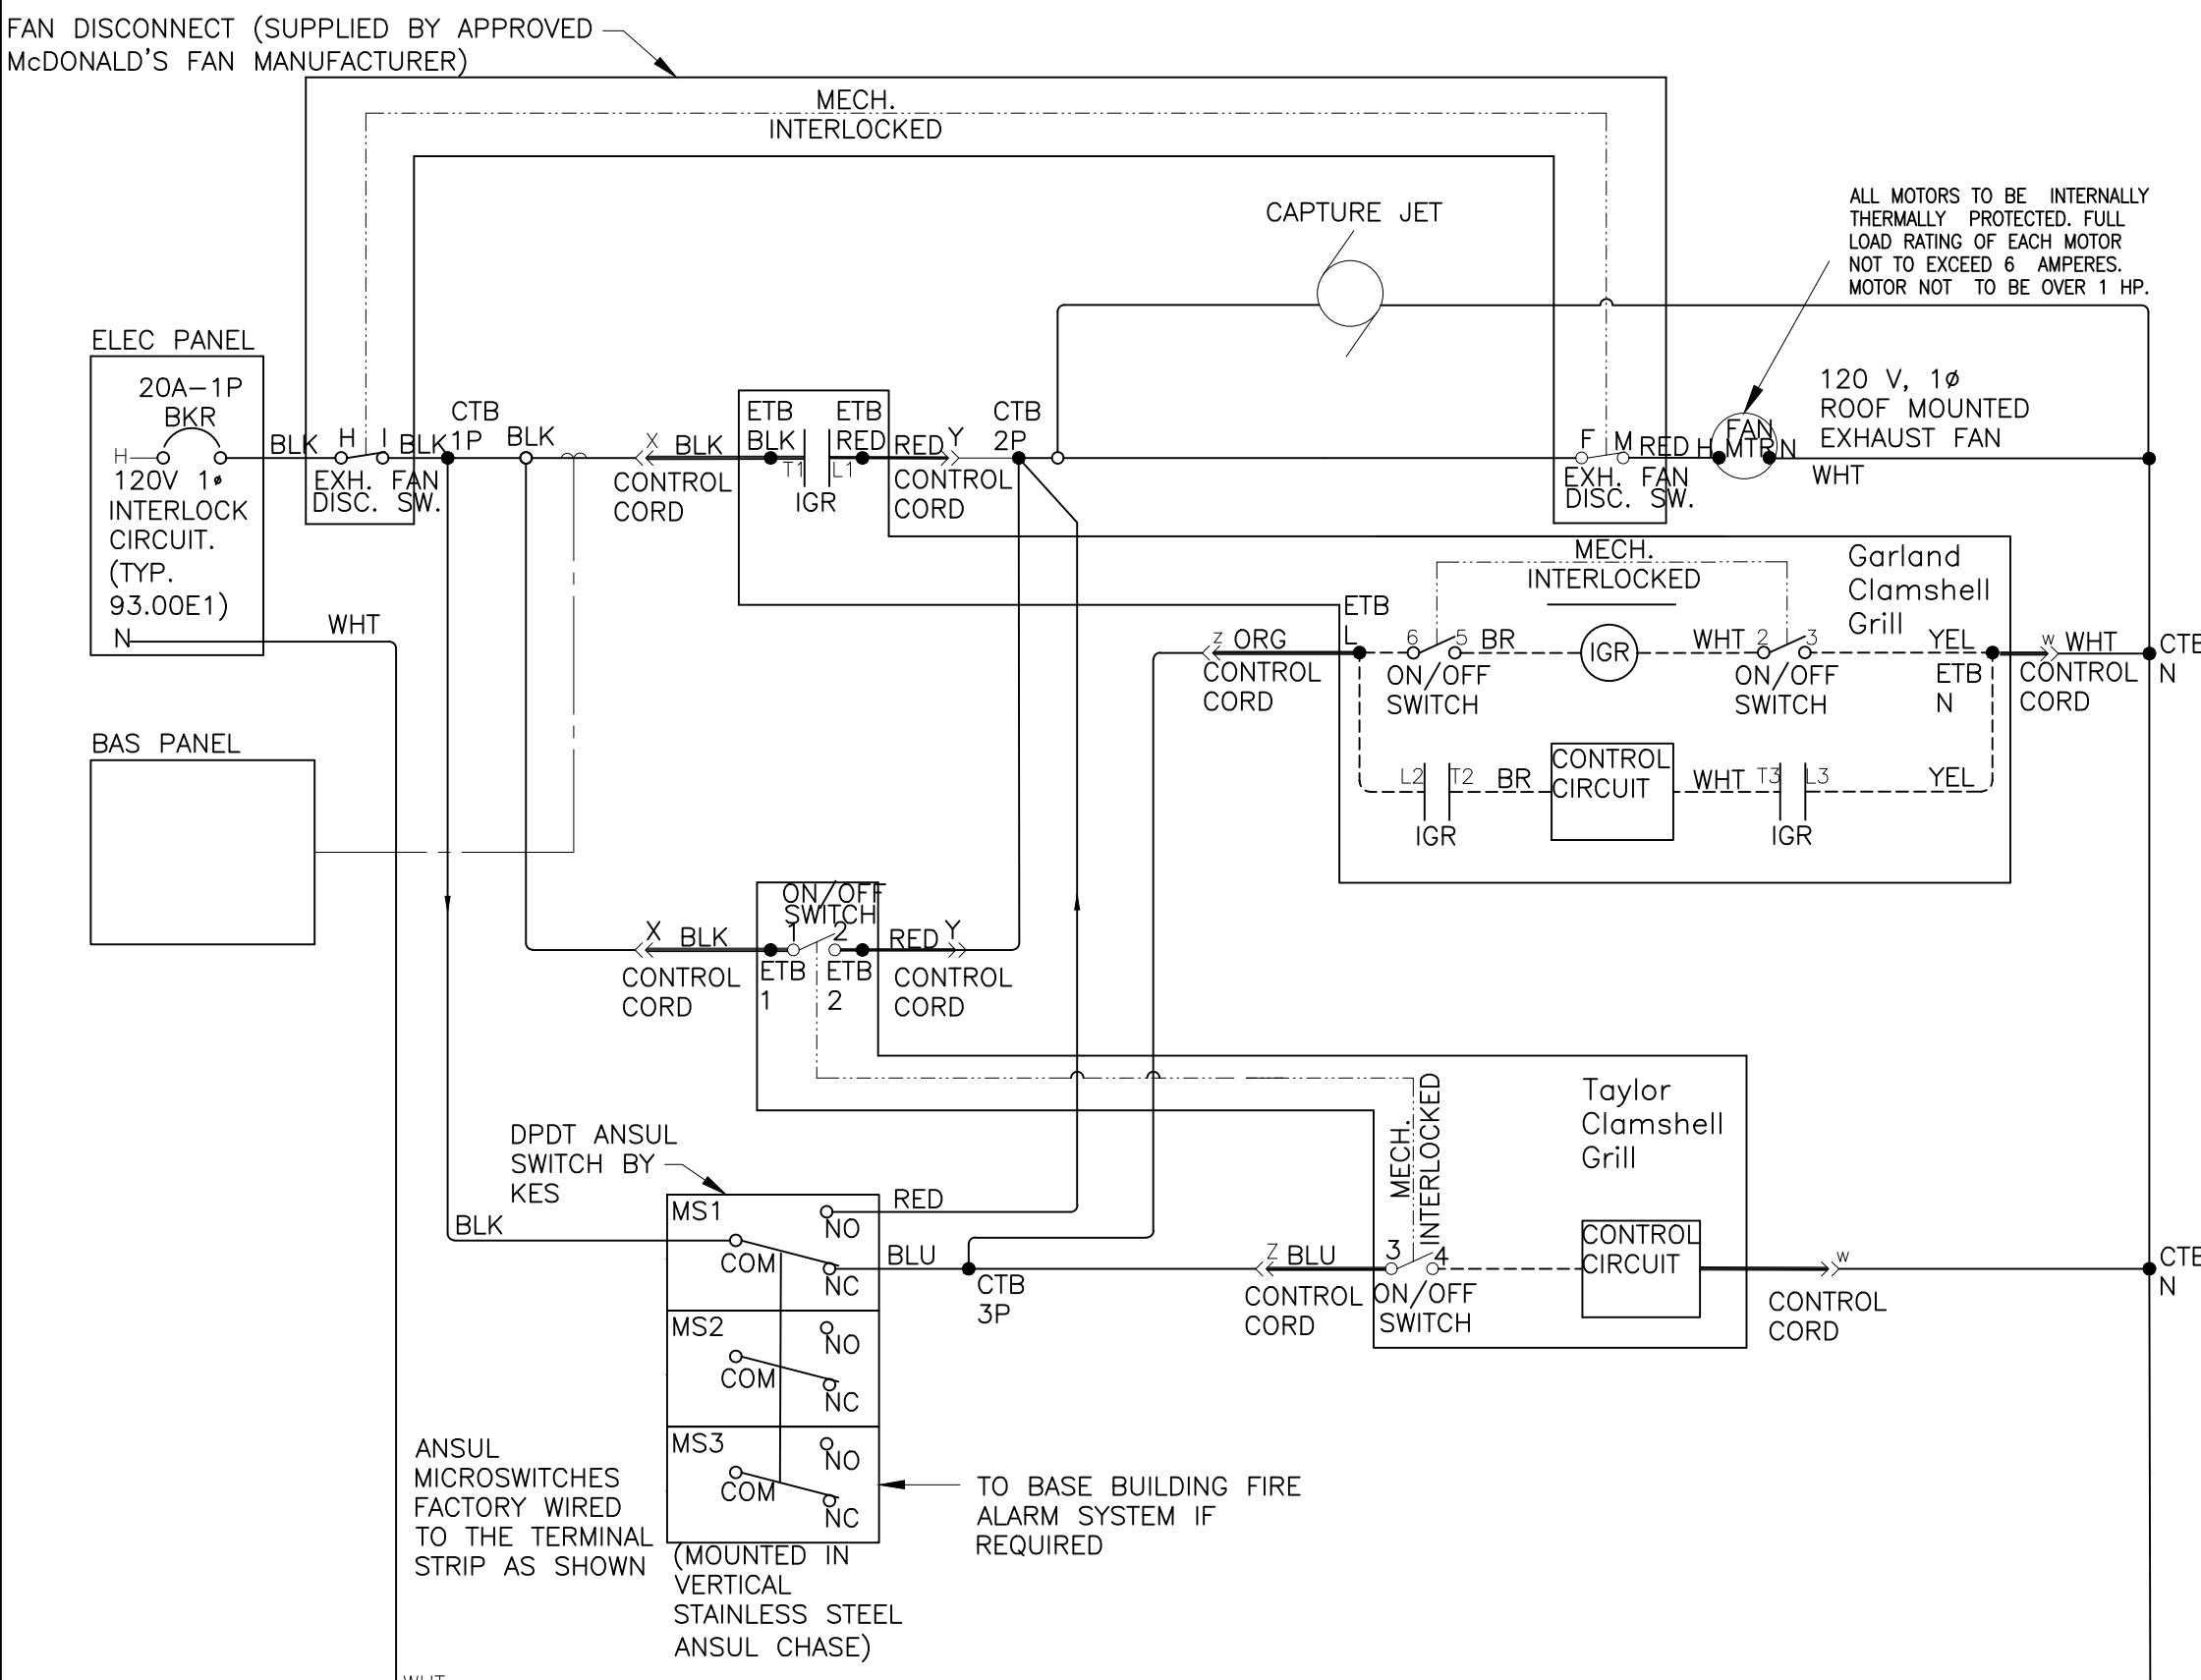

3 INTERLOCK LADDER DIAGRAM


E-3.2 FOR REFERENCE ONLY

REVISED: 6/18

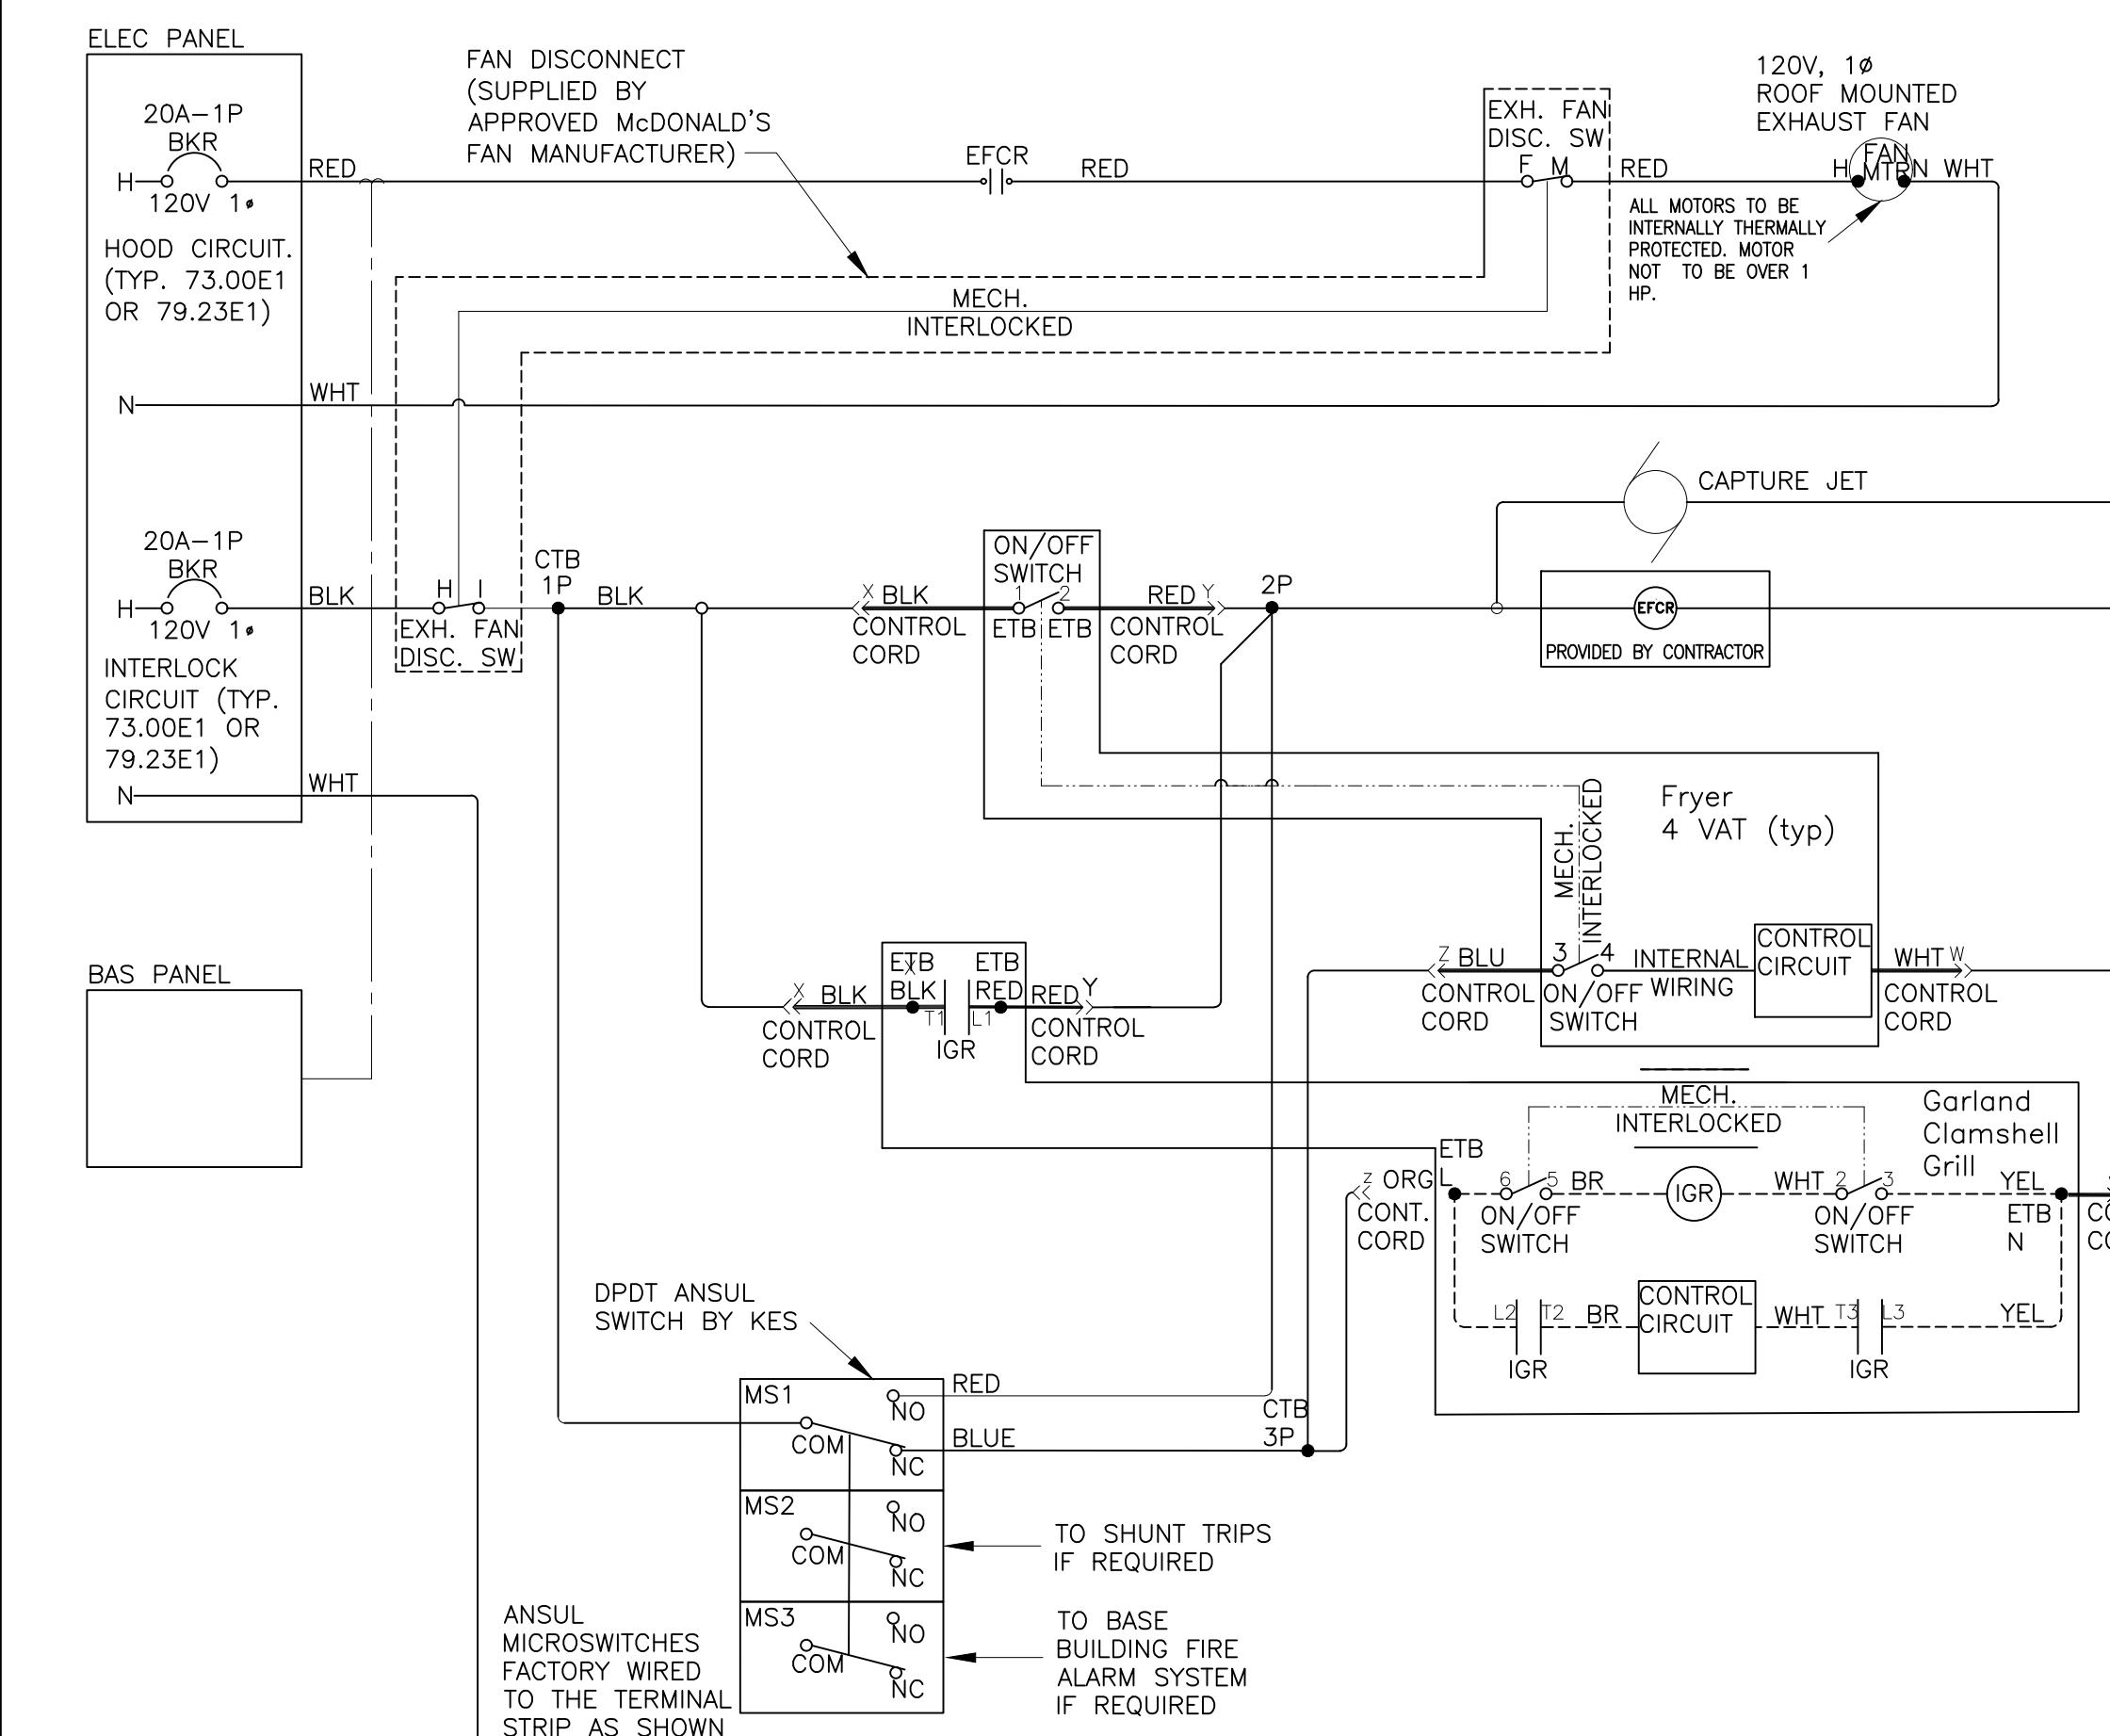

6 INTERLOCK LADDER DIAGRAM
E-3.2 FOR REFERENCE ONLY

REVISED: 6/18

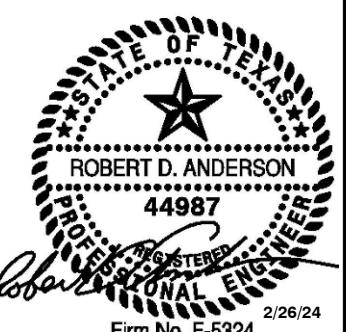

JSA, LLC confidential and proprietary documents were prepared with its issue date and a later time. Use of another project requires engineers. Reproduction - project is not authorized.

S USA, LLC

the confidential and proprietary
shall not be copied or reproduced
contract documents were prepared
in connection with its issue date and a
date or at a later time. Use of
the documents on another project requires
s and engineers. Reproduction
another project is not authorized.

MES	STD ISSUE DATE 2023	REVIEWED BY JAW	DATE ISSUED 03/08/24
BB20			FINISHES

STANDARD BUILDING
—WOOD/WOOD

EARING WALLS W/4" BRICK VENEER

OOF TRUSS FRAMING



/BATTEN/BRICK/METAL PANEL EXTERIOR

ON

SITE ADDRESS	SEC OF S.H. LOOP 288 & HUMMING
--------------	--------------------------------

2023	4597.	DESCRIPTI	WOOD B	WOOD R	STUCCO,	SITE ID
				042-327		
JAWA 24-0014						
E 3 . 2						
INTERLOCK DIAGRAMS						

LIGHTING CONTROL SYSTEM

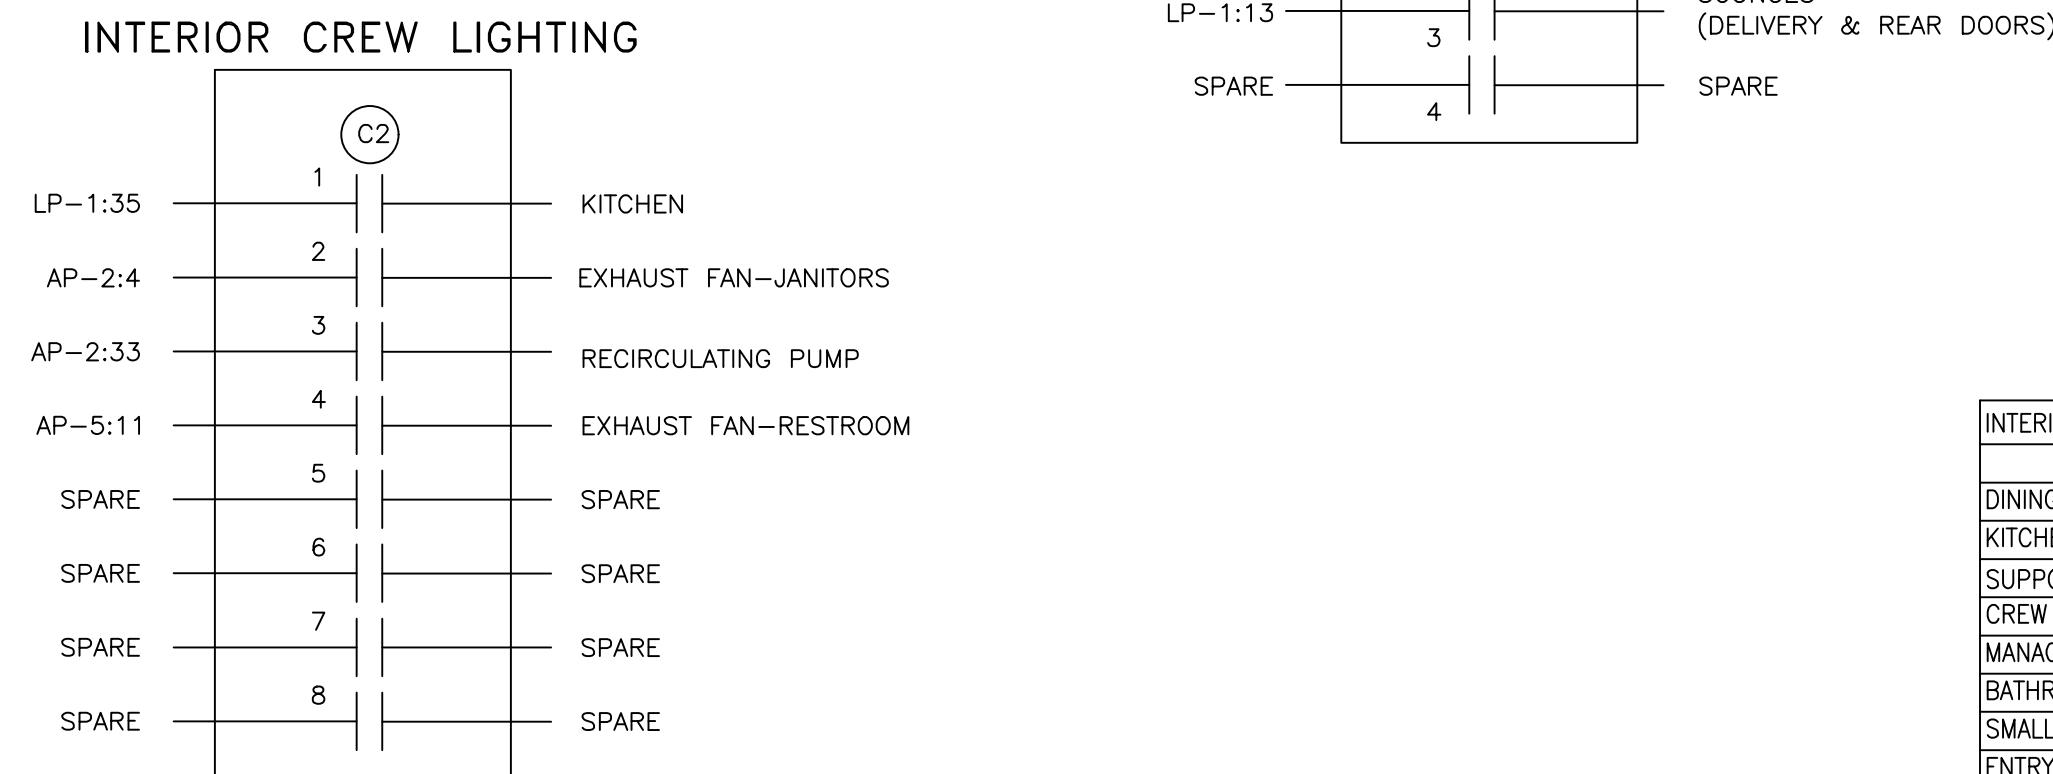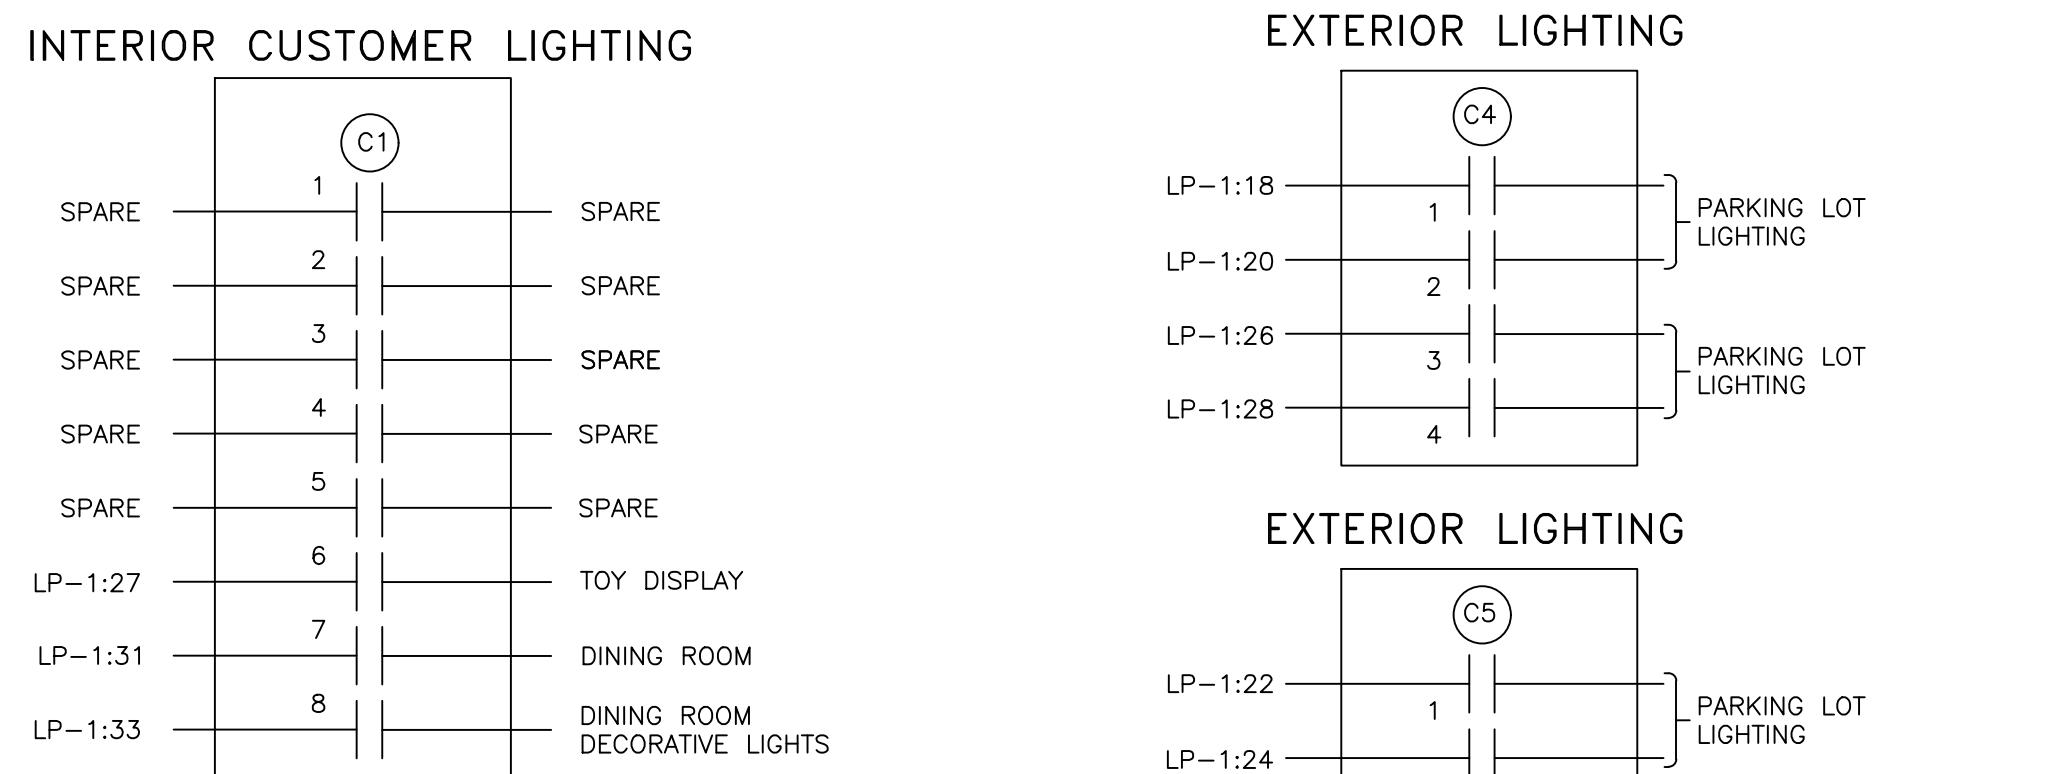

LIGHTING CONTROL NOTES:

LIGHTING CONTROL NOTES

- LC1. CONTACTOR DETAILS ARE DIAGRAMMATIC ONLY AND ARE SHOWN WITH TYPICAL LOADS AND CIRCUIT ASSIGNMENTS. LOADS, CIRCUIT ASSIGNMENTS AND NUMBER OF CONTACTORS MAY VARY BY RESTAURANT LOCATION AND PER BAS SUPPLIERS SYSTEMS. VERIFY EXACT REQUIREMENTS WITH BAS INSTALLATION DETAILS, SITE PLANS, ELECTRICAL PANEL SCHEDULES AND ACM. EC SHALL MAKE ALL MODIFICATIONS AS REQUIRED. FINAL INSTALLATION SHALL BE FULLY NEC AND ENERGY CODE COMPLIANT.
 - LC2. ELECTRICAL CONTRACTOR SHALL FURNISH AND INSTALL ALL WIRING, CONNECTIONS, TERMINATIONS, ETC. THAT ARE NOT PROVIDED BY THE BAS SUPPLIER FOR A COMPLETE, FULLY OPERATIONAL AND CODE COMPLIANT LIGHTING CONTROL SYSTEM.

- LC2. ELECTRICAL CONTRACTOR SHALL FURNISH AND INSTALL ALL WIRING, CONNECTIONS, TERMINATIONS, ETC. THAT ARE NOT PROVIDED BY THE BAS SUPPLIER FOR A COMPLETE, FULLY OPERATIONAL AND CODE COMPLIANT LIGHTING CONTROL SYSTEM.

LIGHTING CONTROL INSTALLATION OPTIONS

OPTION 1 CONTACTORS AND CONTACTOR ENCLOSURE FOR THIS LIGHTING CONTROL SYSTEM SHALL
(STANDARD) BE FURNISHED BY THE BAS SUPPLIER AND INSTALLED BY THE ELECTRICAL
CONTRACTOR ON SITE FOR A COMPLETE AND FULLY FUNCTIONAL SYSTEM.

**OPTION 2
(OPTIONAL)** LIGHTING CONTROL CAN BE ACCOMPLISHED VIA UTILIZATION OF A SMART TYPE BREAKER PANEL REPLACING STANDARD PANEL LP-1. PANEL SHALL UTILIZE AN INTEGRAL MOTOR OPERATED CIRCUIT BREAKERS OR AN INTEGRAL CIRCUIT BREAKER/CONTACTOR TYPE COMBINATION DEVICE WITH AN INTEGRAL PROGRAMMING CONTROL MODULE AND SHALL BE ORDERED THROUGH OUR ELECTRICAL EQUIPMENT NATIONAL ACCOUNT PROGRAM (SQUARE-D) THROUGH OUR CONSTRUCTION PURCHASING TEAM.

- LC3. ALL COMPONENTS FOR THIS LIGHTING CONTROL SYSTEM SHALL BE INSTALLED BY THE ELECTRICAL CONTRACTOR. SEE BOXED NOTE BELOW FOR OPTIONS.
 - LC4. ALL COMPONENTS SHALL BE UL LISTED AND LABELED AND THE SYSTEM SHALL COMPLY WITH ALL LOCAL, STATE AND FEDERAL ENERGY CODE REQUIREMENTS.
 - LC5. ALL CONTACTORS SHALL BE LOCATED IN A NEMA 1 ENCLOSURE WITH SCREW TYPE COVER MOUNTED DIRECTLY ABOVE LIGHTING PANEL OR SWITCHGEAR SO AS TO BE ACCESSIBLE.
 - LC6. ALL CONTACTORS SHALL BE RATED FOR 30 AMP LOADS UNLESS NOTED OTHERWISE AND SHALL BE HID RATED WHERE REQUIRED.
 - LC7. COIL VOLTAGES FOR ALL CONTACTORS SHALL BE 120 VOLT UNLESS NOTED OTHERWISE.
 - LC8. CONTACTOR C5 IS INTENDED TO CONTROL PARKING LOT LIGHTS NEAR TRASH CORRAL, DELIVERY DOORS, AND EMPLOYEE PARKING, THUS ALLOWING A DIFFERENT LIGHTING SCHEDULE TO BE USED IN THOSE AREAS.

BUILDING AUTOMATION SYSTEM NOTES

- BUILDING AUTOMATION SYSTEM NOTES**


BAS1. THE DIAGRAM SHOWN ABOVE IS SCHEMATIC IN NATURE AND SHOWS THE GENERAL REQUIREMENTS FOR THE INSTALLATION OF THE BUILDING AUTOMATION SYSTEM. EXACT EQUIPMENT REQUIREMENTS AND QUANTITIES WILL VARY PER SITE. G.C., M.C., T.C.C. AND E.C. SHALL COORDINATE ALL EXACT EQUIPMENT AND INSTALLATION REQUIREMENTS WITH SUPPLIER PRIOR TO SUBMITTING BID FOR A COMPLETE AND FULLY FUNCTIONAL SYSTEM.

BAS2. THE BUILDING AUTOMATION SYSTEM ALSO HAS ADDITIONAL OPTIONS AVAILABLE SUCH AS MONITORING DOOR CONTACTS (RESTROOM & COOLER FREEZER), ENERGY METER, COOLER/FREEZER TEMP. ADDITIONAL OPTIONS MAY BE SELECTED ON CENTRAL PURCHASING PROJECT DETAIL FORM. G.C., M.C., T.C.C. AND E.C. SHALL COORDINATE ALL EXACT INSTALLATION REQUIREMENTS WITH SUPPLIER PRIOR TO SUBMITTING BID FOR A COMPLETE AND FULLY FUNCTIONAL SYSTEM.

BAS3. ELECTRICAL CONTRACTOR SHALL FURNISH AND INSTALL ALL LINE AND LOW VOLTAGE WIRING AND CONNECTIONS, INCLUDING BUT NOT LIMITED TO CONTROL POWER TO ALL BAS COMPONENTS AND POWER CIRCUITRY WIRING OF ALL LIGHTING CONTACTORS. COORDINATE INSTALLATION WITH SITE SPECIFIC BAS INSTALLATION DETAILS PROVIDED BY SUPPLIER.

BUILDING AUTOMATION SYSTEM

INSTALLATION & TECHNICAL ASSISTANCE INFORMATION:
LENNOX BAS: McD@CCBAC.com

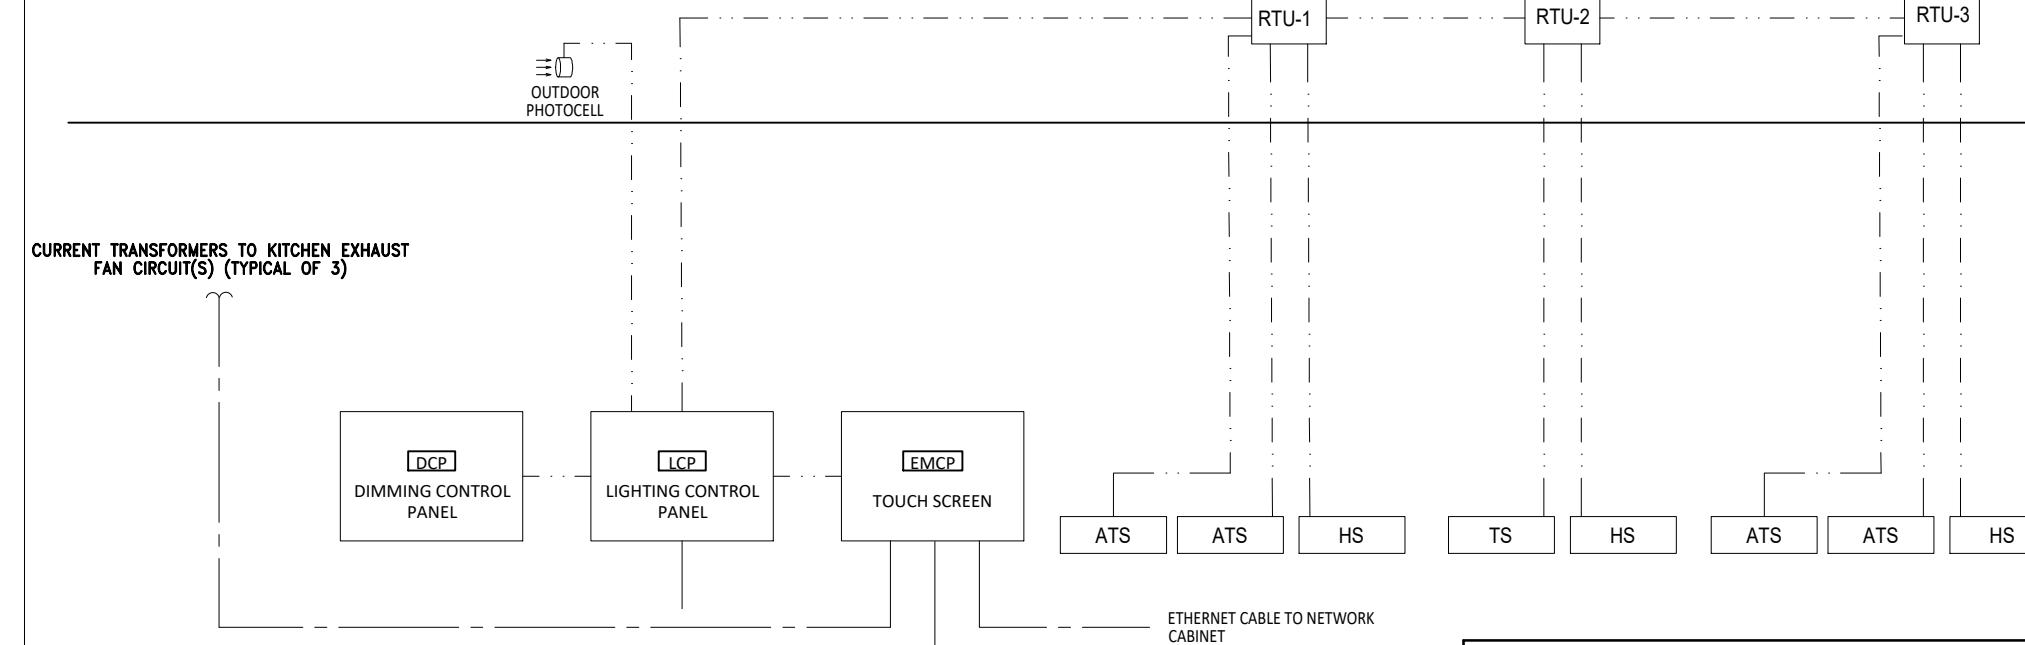

CONTROLS SCHEDULE			
MARK	DESCRIPTION	MANUFACTURER	MODEL
TS	TEMPERATURE SENSOR	*PROVIDED WITH BAS	
ATS	AVERAGING TEMPERATURE SENSOR	*PROVIDED WITH BAS	
HS	HUMIDITY SENSOR	*PROVIDED WITH BAS	

WIRE LEGEND	
MARK	WIRE/CABLE TYPE
_____ - _____	CAT 5E
_____ · · · _____	18 AWG CONDUCTORS

The logo for McDonald's USA, LLC. It features a large, stylized lowercase 'm' on the left, followed by the words 'McDonald's' in a bold, black, sans-serif font, and 'USA, LLC' in a smaller, regular black font to the right. A registered trademark symbol (®) is located at the bottom right of the 'USA, LLC' text.

SHEET NO.	TITLE		DRAWN BY MES	
	2023 STANDARD BUILDING – BB20 4597-WOOD/WOOD		STD ISSUE DATE 2023	
DESCRIPTION	WOOD BEARING WALLS W/4" BRICK VENEER WOOD ROOF TRUSS FRAMING STUCCO/BATTEN/BRICK/METAL PANEL EXTERIOR FINISHES		REVIEWED BY JAW	DATE ISSUED 03/08/24
SITE ID	SITE ADDRESS			
042-3271	SEC OF S.H. LOOP 288 & HUMMINGBIRD LANE, DENTON TEXAS			
		JAWA 24-0014		
LIGHTING CONTROLS				

MLO, AIC: NOTES D6,D7,&D8, Mounting: Surface, NEMA 1			PANEL LP-1						225A, 208Y/120 VAC, 3PH, 4W, CB TYPE: BL or BLH			
WATTS			BRKR	TRIP	CCT	CCT	TRIP	BRKR	WATTS			
A	B	C	REQ	POLES	NO.	NO.	POLES	REQ	DESCRIPTION	A	B	C
0		Spare		20A-1	1	2	20A-1	S	Flag Pole	220		
0		Spare		20A-1	3	4	20A-1		Spare		0	
0	0	Spare		20A-1	5	6	20A-1	S	Exterior Signage			294
0		Spare		20A-1	7	8	20A-1	S	Spare	0		
294		Exterior Signage	S	20A-1	9	10	20A-1	S	Exterior Wall/Soffit Lights DT		114	
	193	Flood Lights & Canopy lights	S	20A-1	11	12	20A-1	S	Exterior Wall/Soffit Lights			114
42		Back of House Sconces	S,L	20A-1	13	14	20A-1		DCO In Road Sign Base	180		
126		Linear LED Façade Lighting	S	20A-1	15	16	20A-1	L	Dr Alarm\CO2\Access Control panel		524	
	0	Space		20A-1	17	18	30A-2		Lot Lights			480
96		Directional Sign	S	20A-1	19	20	I		I		480	
96		Directional Sign	S	20A-1	21	22	30A-2		Lot Lights			240
	120	COD lighting	S	20A-1	23	24	I		I			240
0		Spare		20A-1	25	26	30A-2		Lot Lights		480	
30		Toy Display	S	20A-1	27	28	I		I			480
	0	Spare		20A-1	29	30	30A-2		Spare			0
384		Dining Area Lighting	S	20A-1	31	32	I		I		0	
293		Pendants/Cove lights	S	20A-1	33	34	20A-1	L	BAS Controller		300	
	924	Kitchen Lighting	S	20A-1	35	36	20A-1	L	Lighting Control Panel			180
154		Restroom Lighting	S	20A-1	37	38	20A-1	S,L	Night/Ltg./Emerg. LED Lighting	128		
510		Support Area Lighting	S	20A-1	39	40	60A-2	S	Mcd'S Road Sign		2496	
	0	Spare		20A-1	41	42	I	I	I			2496
									Total Connect	2164	5503	5041
									Connect Amps	35	Amps	
									Demand Amps	44	Amps	

MLO, AIC: NOTES D6,D7,&D8, Mounting: MDP, NEMA 1			PANEL AP-4						225A, 208Y/120 VAC, 3PH, 4W, CB TYPE: BL or BLH				
WATTS			BRKR	TRP	CCT	CCT	TRIP	BRKR	WATTS				
A	B	C	DESCRIPTION	REQ	PLS	NO.	NO.	PLS	REQ	DESCRIPTION	A	B	C
2604			Clamshell Grill	G	50A-3	1	2	30A-3	G	Combi Oven	1812		
	2604			I	I	3	4	I	I	I		1812	
	2604			I	I	5	6	I	I	I			1812
5196			Clamshell Grill	G	50A-3	7	8	30A-3	G	Combi Oven	1812		
	5196			I	I	9	10	I	I	I		1812	
	5196			I	I	11	12	I	I	I			1812
4668			3-Vat-Fryer-Electric-F/F/F	G	50A-3	13	14	15A-1		Combi Oven Hood	960		
	4688			I	I	15	16	15A-1		Combi Oven Hood		960	
	4668			I	I	17	18			Space			0
4668			3-Vat-Fryer-Electric-F/F/F	G	50A-3	19	20			Space	0		
	4668			I	I	21	22			Space		0	
	4668			I	I	23	24			Space			0
4668			3-Vat-Fryer-Electric-F/F/F	G	50A-3	25	26			Space	0		
	4668			I	I	27	28			Space		0	
	4668			I	I	29	30			Space			0
0			Space			31	32			Space	0		
0			Space			33	34			Space		0	
0			Space			35	36			Space			0
0			Space			37	38			Space	0		
0			Space			39	40			Space		0	
0			Space			41	42			Space			0
										Total Connect	26388	26408	2542
										Connect Amps		217	Amp
										Res. L1		111	Amp

150 MLO AIC: SEE NOTES D6, D7, & D8, Mounting: Flush				COMPUTER PANEL						150A, 208Y/120 VAC, 3PH, 4W, CB TYPE: BL or BLH					
WATTS				BRKR	TRP	CCT	CCT	TRIP-	BRKR				WATTS		
A	B	C	DESCRIPTION	REQ	PLS	NO.	NO.	PLS	REQ	DESCRIPTION	A	B	C		
1488			Pres Pos Reg/Vid Mon/Heaset/label	L	20A-1	1	2	20A-1	L	Space	0				
	1764		Kvs Mon Oat/Vid Mon/Rec/Label	G, L	20A-1	3	4	20A-1	L	Table Loc/Rev		1368			
	100		Cctv/Timer	L	20A-1	5	6	20A-1	L	Digital Merch/Media Player			43		
390			Order Pos Reg/Vid Mon Coin dispenser	L	20A-1	7	8	20A-1	G,L	Kvs Mon Kit/Labeling System	600				
	180		Vid Mon	G,L	20A-1	9	10	20A-1		Zoom Timer		720			
	600		Tech Rack	L	20A-1	11	12	20A-1	L	Tech Rack Ups			36		
0			Space	L	20A-1	13	14	20A-1	L	Cod Optical Isolator	120				
	1200		Tech Rack	L	20A-1	15	16	20A-1	L	Speker Canopy #1		120			
	1440		Tech Rack	L	20A-1	17	18	20A-1	L	Speaker Canopy #2			12		
1080			Counter Pos Reg Rec	L	20A-1	19	20	20A-1	L	Office desk Unit	1200				
	312		Table Loc	L	20A-1	21	22	20A-1	L	Office desk Unit		1200			
	720		KVS Mon/Kit/Del. Pos Reg	G,L	20A-1	23	24	20A-1	L	Order Cash Recycler			52		
1860			Exterior Menu Boards/Media Player	L	20A-1	25	26	20A-1	G,L	Kvs Mon Prep	360				
	528		Counter Cash Recycler	L	20A-1	27	28	20A-1	G,L	Time Clock		60			
	1860		Exterior Menu Boards/Meddia Player	L	20A-1	29	30	20A-1	L	Kiosk Cash Handler			52		
480			O/O Equipment Rack	L	20A-1	31	32	20A-1	L	Kiosks	1080				
	1200		BOCA	L	20A-1	33	34	20A-1	L	Kiosks		1080			

WATTS			PANEL AP-1						225A, 208Y/120 VAC, 3PH, 4W, CB TYPE: BL or BLH				
A	B	C	DESCRIPTION	REQ	PLS	CCT	CCT	TRIP	BRKR	DESCRIPTION	A	B	C
1224			Dco-manager's office (man offi)		20A-1	1	2	20A-2	G	Coffee brewer (presenter's booth)	1612		
	720		Dco-General Purpose	G	20A-1	3	4	I	I	I		1612	
	540		Dco-General Purpose	G	20A-1	5	6	20A-1	G	ABS (phase c, presenter's booth)			1788
120			Safe - (mo) DCO Gen Purp	L	20A-1	7	8	20A-1	G	Juice disp/ coffee cream disp	840		
	240		Remote Order Battery		20A-1	9	10	20A-1	G	CO2 Detector		120	
	960		Merge/audio sys/driv mon/Deliv.	G	20A-1	11	12	20A-1	G	Automated beverage sys			600
960			Washer		15A-1	13	14	20A-2	G	Coffee Brewer (front counter)	1612		
	1800		Hand Held Order		20A-1	15	16	I	I	I		1612	
	120		Computer Room (TF/1)		20A-1	17	18	30A-3	G	Heat treat combo shake			1560
2246			Espresso Brewer	G	30A-2	19	20	I	I	I		1560	
	2246			I	I	I	21	22	I	I	I		1560
	1500		3-Vat fryer hood interlock		20A-1	23	24	20A-1		3-Vat fryer hood Interlock			1176
1320			Reach in Freezer-SW	G	20A-1	25	26	20A-2	H	Ice Machine Remote Cond 1400lb	104		
	1080		Frozen fry dispenser (fry wall)	G	20A-1	27	28	I	I	I		104	
	2112		4-Vat fryer hood interlock		20A-1	29	30	20A-1	G	Reach in Freezer-SW			1320
1500			Fry Bagging Station	L,G	20A-1	31	32	15A-3	H	Ice Machine Remote Cond 1000lb	1332		
	60		Hand Wash Timers	G	20A-1	33	34	I	I	I		1332	
	1320		Reach in Freezer-SW	G	20A-1	35	36	I	I	I			1332
132			Ice mach - 1000 lb (self serve)		15A-1	37	38	15A-3	H	Ice Machine Remote Cond 1000lb	1332		
	132		Ice mach - 1000 lb (self serve)		15A-1	39	40	I	I	I		1332	
	1656		4-Vat fryer hd interlock		20A-1	41	42	I	I	I			1332
										Total Connect	15894	13950	17316
										Connect Amps	131	Amps	
										Demand Amps	89	Amps	

MLO, AIC: NOTES D6,D7,&D8, Mounting: MDP, NEMA 1			PANEL AP-5						225A, 208Y/120 VAC, 3PH, 4W, CB TYPE: BL or BLH				
WATTS			BRKR	TRP	CCT	CCT	TRIP	BRKR		WATTS			
A	B	C	DESCRIPTION	REQ	PLS	NO.	NO.	PLS	REQ	DESCRIPTION	A	B	C
600			Fridge/Freezer 2Dr Base	G	20A-1	1	2	20A-1		Spare	0		
	600		Fridge/Freezer 2Dr Base	G	20A-1	3	4	20A-2	G	Universal Holding Cabinet P&S		1581	
	600		Fridge/Freezer 2Dr Base	G	20A-1	5	6						1581
600			Fridge/Freezer 2Dr Base	G	20A-1	7	8	20A-2	G	Universal Holding Cabinet P&S	1581		
	600		Fridge/Freezer 2Dr Base	G	20A-1	9	10						1581
		864	Toilet Exhaust Fan	G	20A-1	11	12	20A-1	G	Universal Holding Cabinet Table			240
540			Roof Receptacles	G	20A-1	13	14	20A-1		DT Power Window	120		
	0		Spare		20A-1	15	16	20A-1		DT Power Window		120	
		2080	Frozen Carbonated Beverage	G	30A-2	17	18	20A-1		DT Power Window			120
2080						19	20	20A-2	G	Coffee Brewer (front counter)	1612		
	360		Delivery Tablets	G	20A-1	21	22						1612
		600	Wall Mount Frz Unit SW HC	G	20A-1	23	24	20A-1	G	Pie Display			564
828			Bulk Oil System	G	20A-1	25	26	20A-1	G	Pie Display		564	
	2620		Universal Radiant Toaster	G	30A-2	27	28	20A-1		Spare			0
		2620				29	30	20A-1		DCO-Muzak satellite system			120
0			Spare		20A-1	31	32	20A-1		Clg. Mt window recepts	900		
	1368		Warewasher	G	20A-1	33	34	20A-1		Spare			0
		946	Humidified Holding Cabinet	G	20A-2	35	36	20A-1		Spare			0
946						37	38	20A-1		Spare	0		
	0		Spare		20A-4	39	40	20A-1		Spare			0
		0	Spare		20A-1	41	42	20A-1		Spare			0
										Total Connect	10371	10442	1033

SEE POS
DETAIL SHEET
512

"AP-5"


"AP-4"

"AP-1"

ER

ER

SERIES RATED

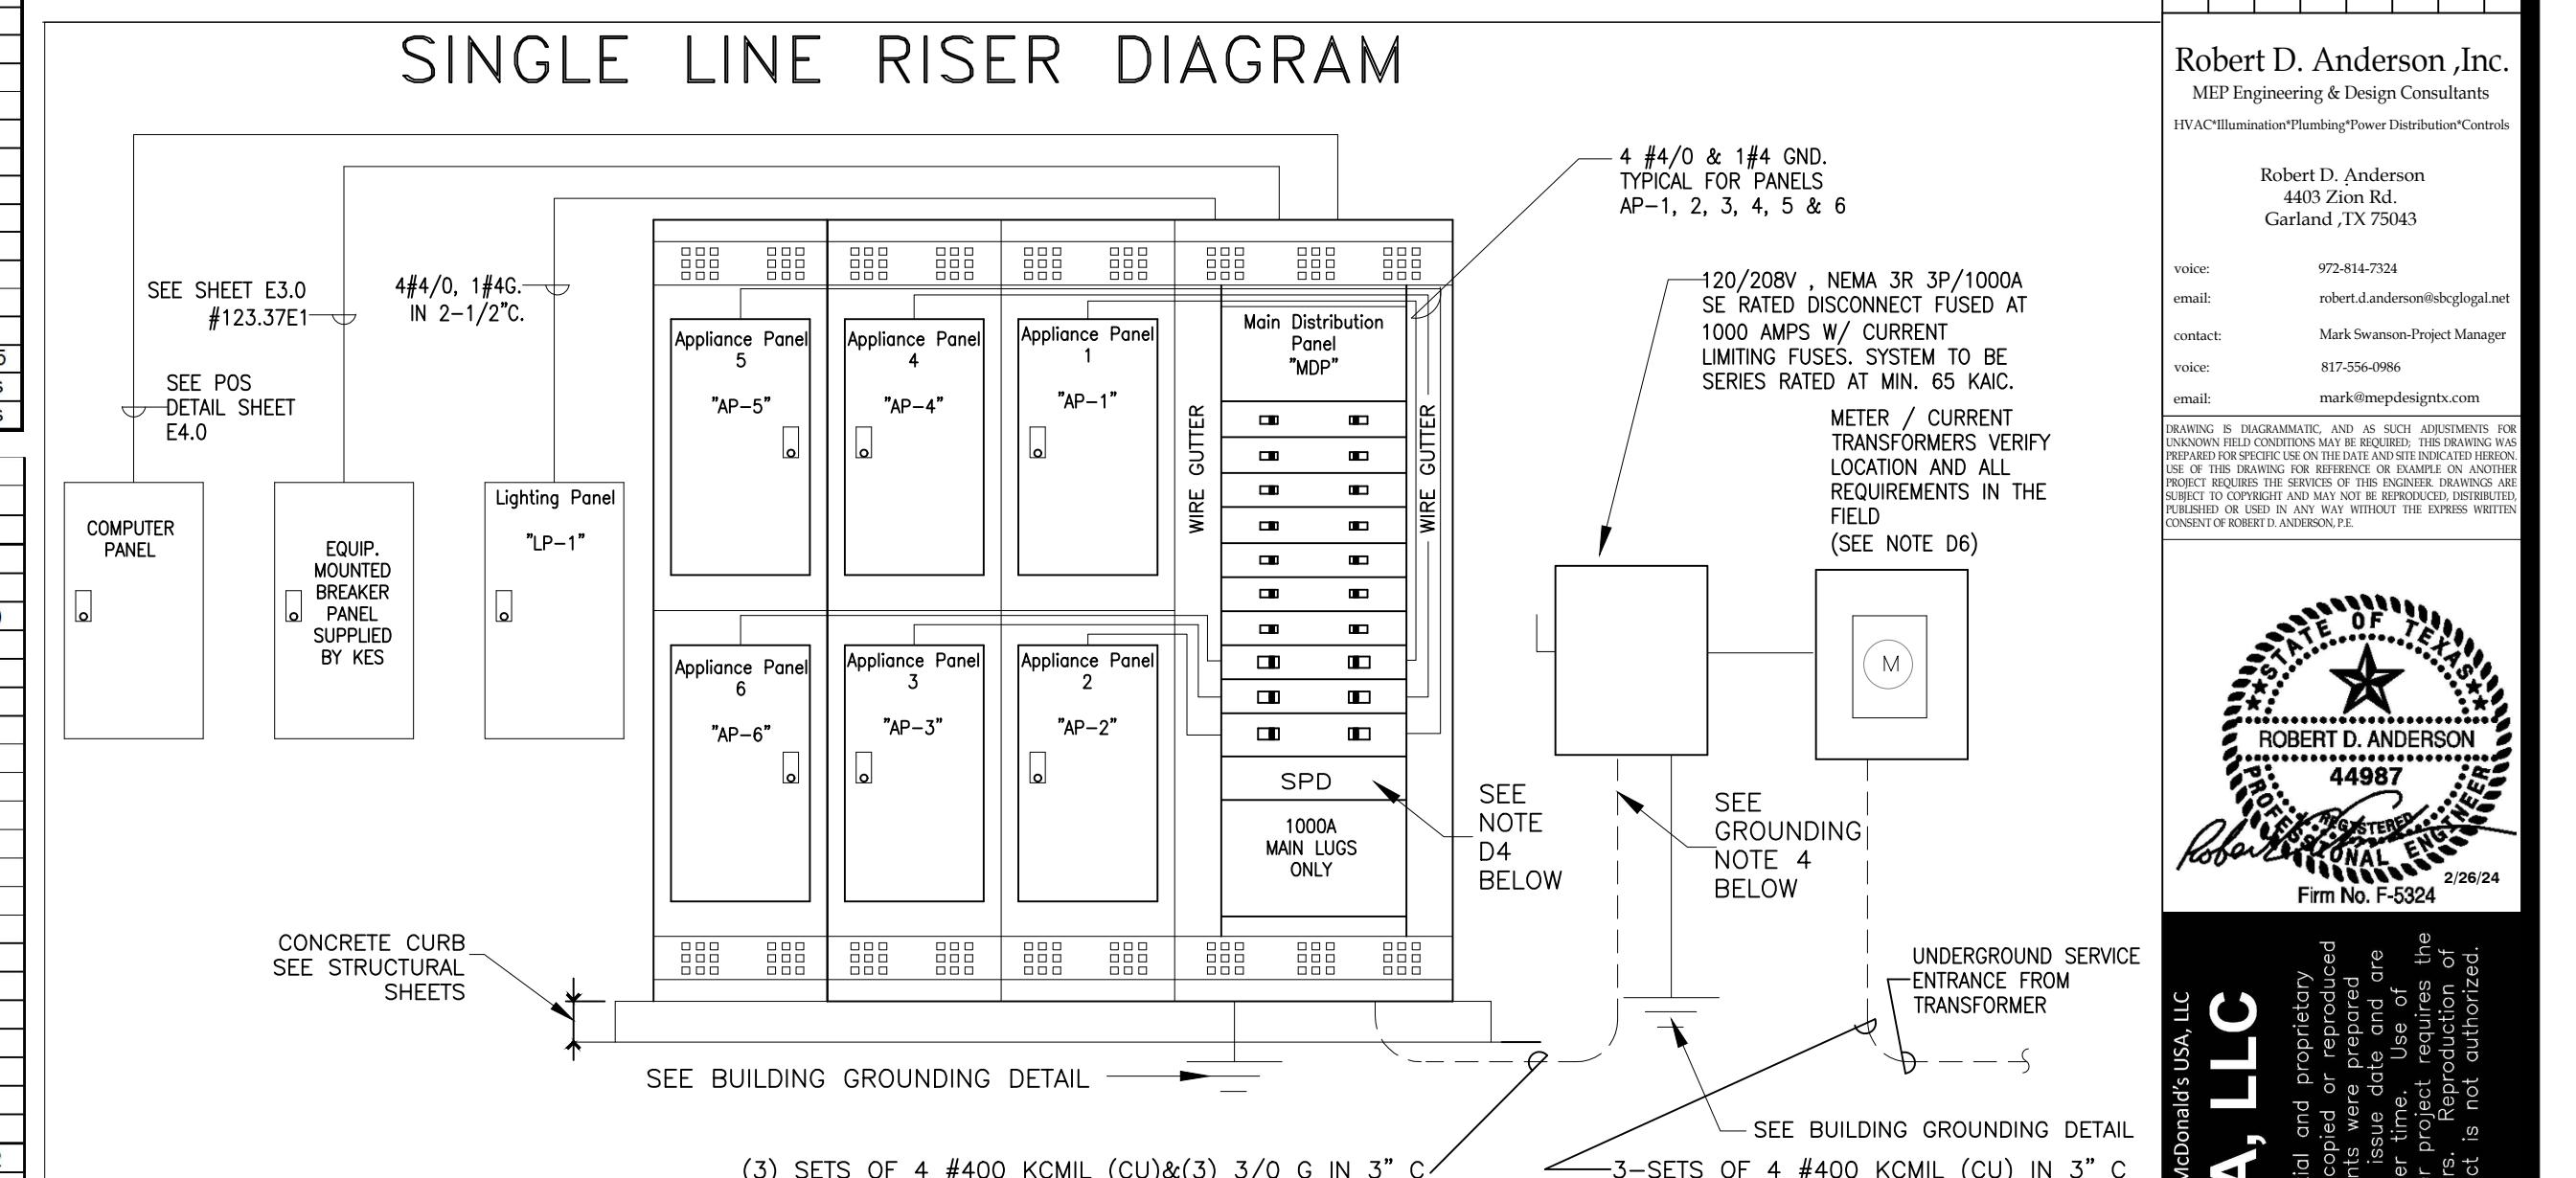

DISTRIBUTION EQUIPMENT NOTES:

- GC/AREA CONSTRUCTION MANAGER WHEN ORDERING PANELBOARDS, SHALL DETERMINE THE NUMBER OF SERVICE ENTRANCE CONDUCTORS, SIZE AND MATERIAL TYPE, AND SHALL THIS INFORMATION TO THE PANELBOARD SUPPLIER SO THAT THE APPROPRIATE LUGS CAN BE PROVIDED FROM THE FACTORY.


MAIN SERVICE ENTRANCE CONDUCTORS SHALL ONLY BE USED WHEN THEY ARE TERMINATED DIRECTLY TO THE LINE LUGS ON A C/T AND METERING CABINET, THE LINE LUGS OF A DISCONNECT SWITCH OR TO THE LINE LUGS OF A MAIN LUG ONLY (6 HANDLE RULE) SERVICE ENTRANCE PANEL. ALUMINUM SERVICE ENTRANCE CONDUCTORS SHALL NOT BE TERMINATED TO THE LINE LUGS OF ANY MAIN BREAKER SINCE DOING SO WILL VIOLATE IT'S 100% UL RATING. IF ALUMINUM CONDUCTORS ARE USED AS PREVIOUSLY INDICATED THEY SHALL BE TERMINATED AS FOLLOWS, AND THE WIRE SIZE INCREASED DUE TO LOWER AMPACITY OF ALUMINUM. EXPOSED ALUMINUM CONDUCTOR STRANDS SHALL BE COATED WITH AN INSULANT IMMEDIATELY AFTER INSULATION IS STRIPPED AWAY. A COMPRESSION LUG SHALL BE PROPERLY INSTALLED ONTO THE EXPOSED ALUMINUM CONDUCTOR STRANDS, AND THE COMPRESSION LUG SHALL THEN BE BOLTED TO THE TRANSFORMER TAPS AND SWITCHBOARD BUSS USING PROPERLY SIZED BOLTS, NUTS AND WASHERS. MERELY INSERTING ALUMINUM STRANDS UNDER A SCREW LUG SHALL NOT BE ACCEPTABLE.

**SEE SHEET E3.1 FOR GENERAL
ELECTRICAL NOTES**


SPLIT UTILITIES CALC

NEC Optional Method	(kW)	(A)
Continuous Loads:	40	110
Kitchen Loads:	309	858
HVAC Loads:	81	224
Cooling:	0	0
Total (1+2+3+4):	429	1192
Base Value (See 220.88):	325	902
Amount Over Base Value (5-6):	104	290
Demand Factor:	0.45	
Adjusted Value (8*7):	47	130
Adjusted Base Value (220.88):	262.5	729
Demand (9+10):	309	859

TOTAL BUILDING 208Y/120V, 3 PHASE,
4-WIRE GENERAL SERVICE POWER BASED
ON NEC 220.88 FOR A "NOT ALL
ELECTRIC" NEW RESTAURANT.

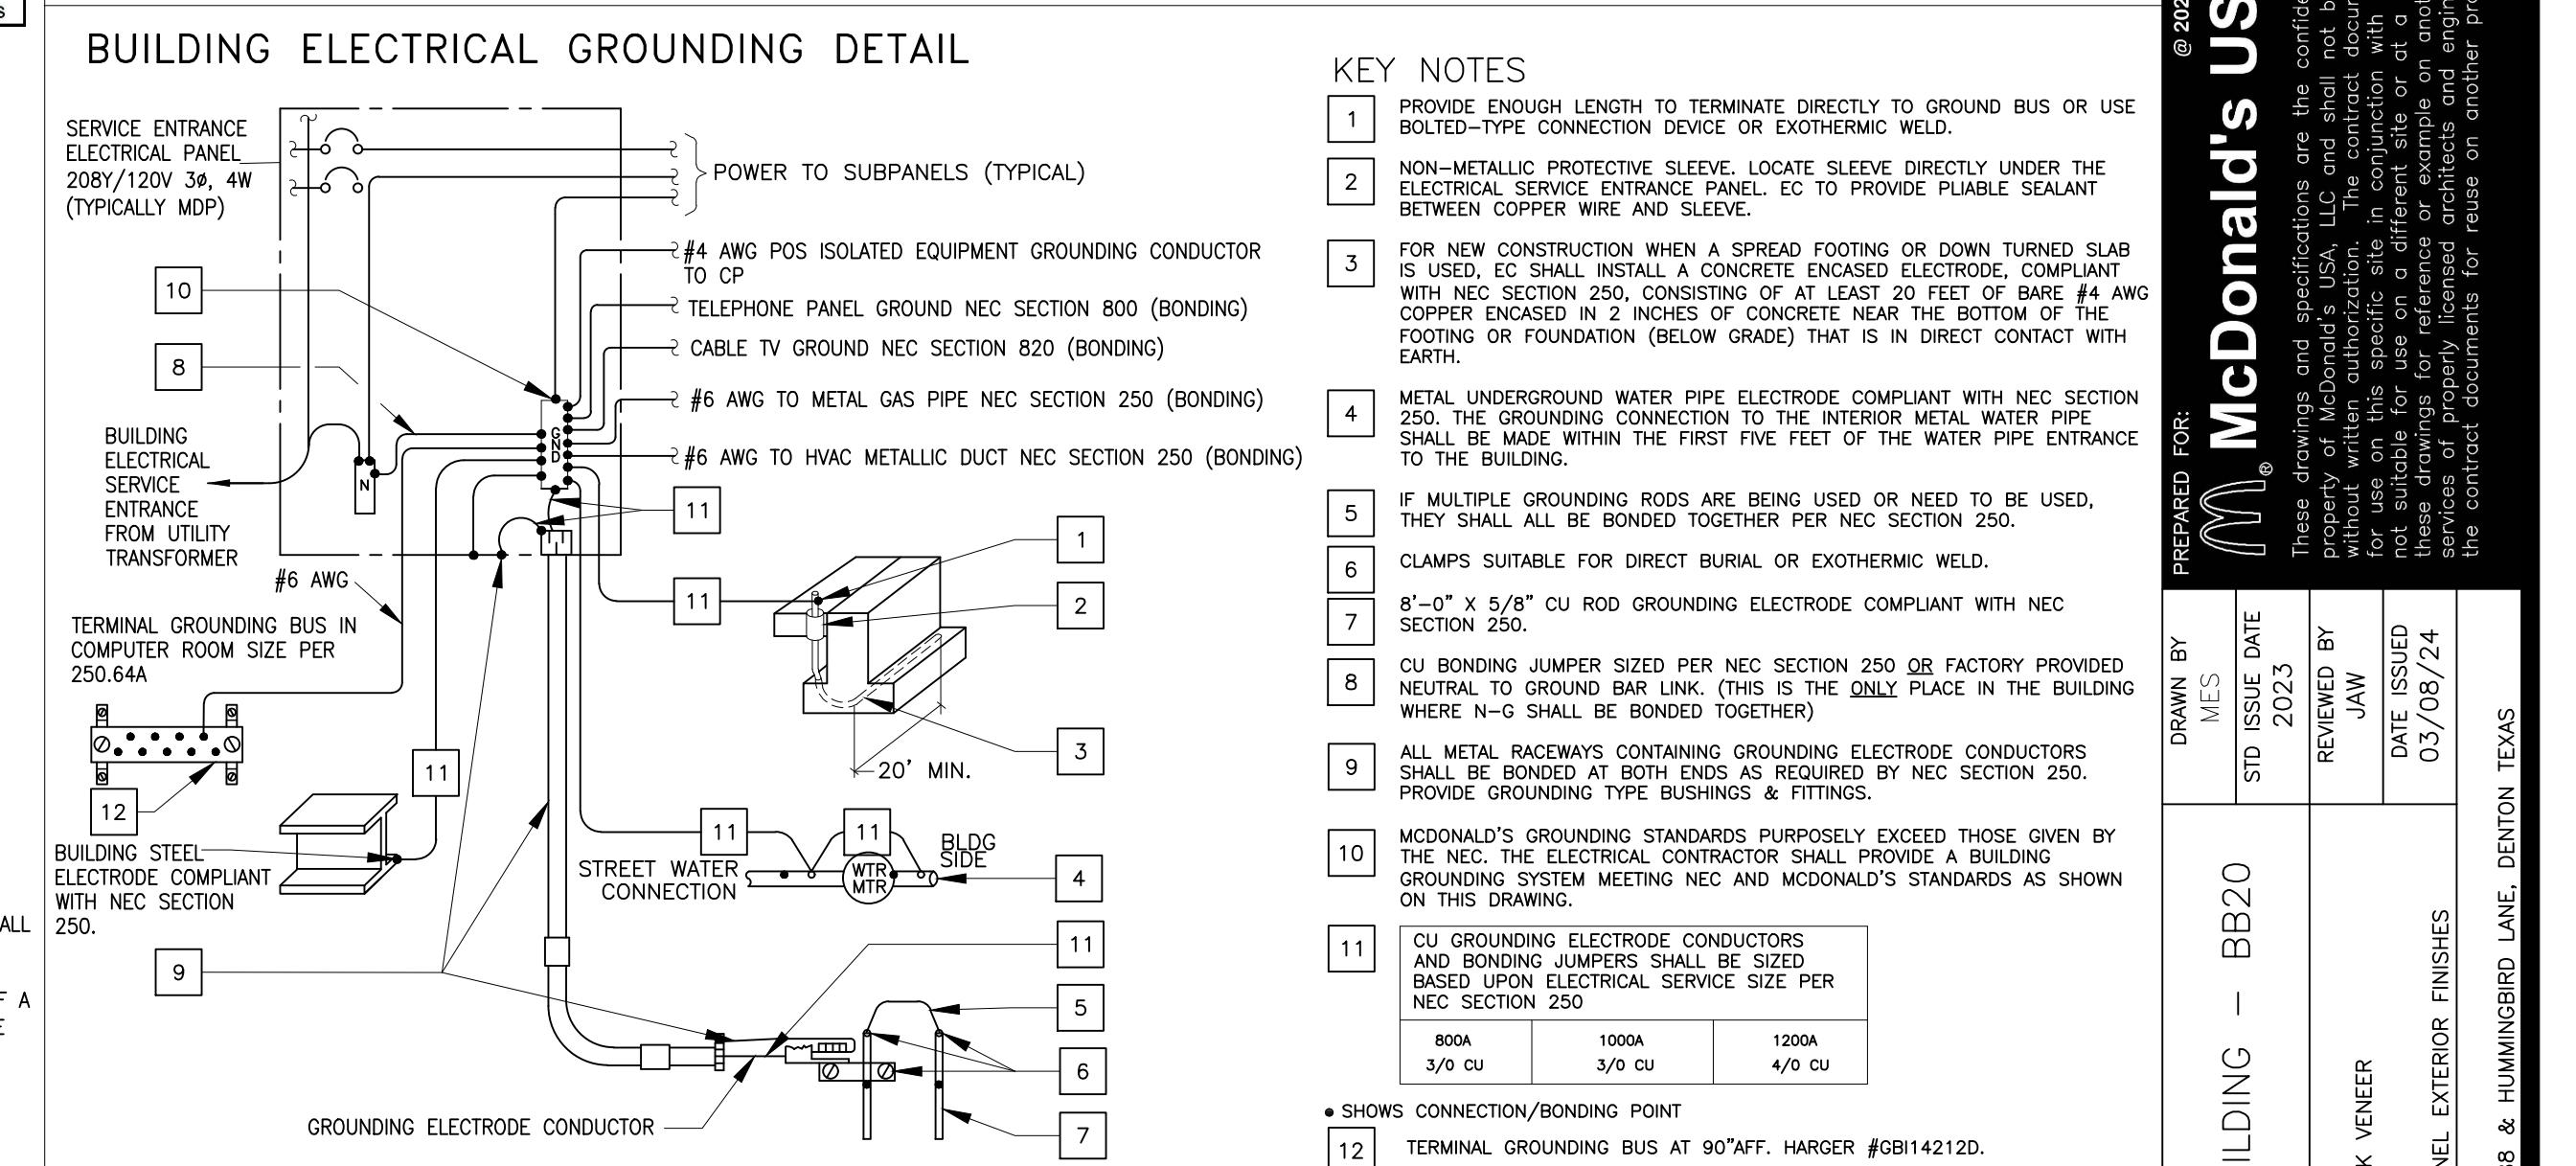


<p>D8. PANELBOARD SUPPLIER SHALL MARK CLEARLY & LEGIBLY ON THE DOORS OF ALL PANELS. DOORS OF ALL PANELS "CAUTION - SERIES RATED SYSTEM _____A AVAILABLE. IDENTIFIED REPLACEMENT COMPONENTS REQUIRED."</p> <p>D9. ALL BREAKERS SHALL BE THE BOLT-ON TYPE. ALL CIRCUIT BREAKERS SHALL BE CAPABLE OF BEING LOCKED OUT TO COMPLY WITH OSHA REGULATION 1910.147 LOCKOUT/TAGOUT PROCEDURES.</p> <p>D10. BRANCH BREAKERS OF 2P AND 3P CONFIGURATION SHALL HAVE A COMMON TRIP.</p> <p>D11. ALL CIRCUIT BREAKERS USED TO SWITCH LIGHT FIXTURES SHALL BE APPROVED FOR THE PURPOSE AND MARKED "SWD".</p> <p>D12. ALL HVAC CIRCUIT BREAKERS SHALL BE HACR TYPE. SEE TABLE ON SHEET E4.0 FOR CONDUIT AND WIRE SIZE REQUIREMENTS.</p> <p>D13. PANELBOARD SUPPLIER SHALL PROVIDE ENGRAVED PLASTIC LAMINATED LABELS TO IDENTIFY ALL PANELS. LABEL FOR COMPUTER PANEL SHALL READ "COMPUTER ONLY PANEL".</p> <p>D14. ALL PANELS SHALL BE PROVIDED WITH A KEY LOCK AND LATCH. EACH PANEL SHALL HAVE TWO KEYS WITH ALL PANELS KEYED ALIKE.</p>	<p>D15. PANELBOARD MANUFACTURER SHALL PROVIDE ARC-FLASH WARNING LABELS FOR MDP AND ALL BRANCH PANELBOARDS IN ACCORDANCE WITH NEC110.</p> <p>D16. ALL RECEPTACLES IN THE KITCHEN AREA MUST HAVE GROUND FAULT CIRCUIT-INTERRUPTER PROTECTION PER NEC 210.8 (B) (2).</p> <p>D17. ON PROJECTS RATED 1200 AMPS OR MORE, AND FOLLOWING NEC 2017 OR NEWER, ELECTRICAL CONTRACTOR IS RESPONSIBLE FOR DATA COLLECTION INCLUDING BUT NOT LIMITED TO UTILITY TRANSFORMER DATA, CABLE LENGTHS, ETC AND COORDINATING WITH THE SWITCHBOARD SUPPLIER OR ELECTRICAL ENGINEER SO THAT AN ARC FLASH STUDY CAN BE PREFORMED. SUPPLIER SHALL SHARE THE RESULTS OF THE STUDY WITH THE ENGINEER OF RECORD SO THAT THE APPROPRIATE ARC ENERGY REDUCTION METHOD MEETING THE REQUIREMENTS ON NEC 240.87 CAN BE APPLIED. CONTRACTOR SHALL ALSO BE RESPONSIBLE TO AFFIX THE LABELS ON THE DESIGNATED EQUIPMENT PROVIDED BY THE SUPPLIER.</p>
--	---

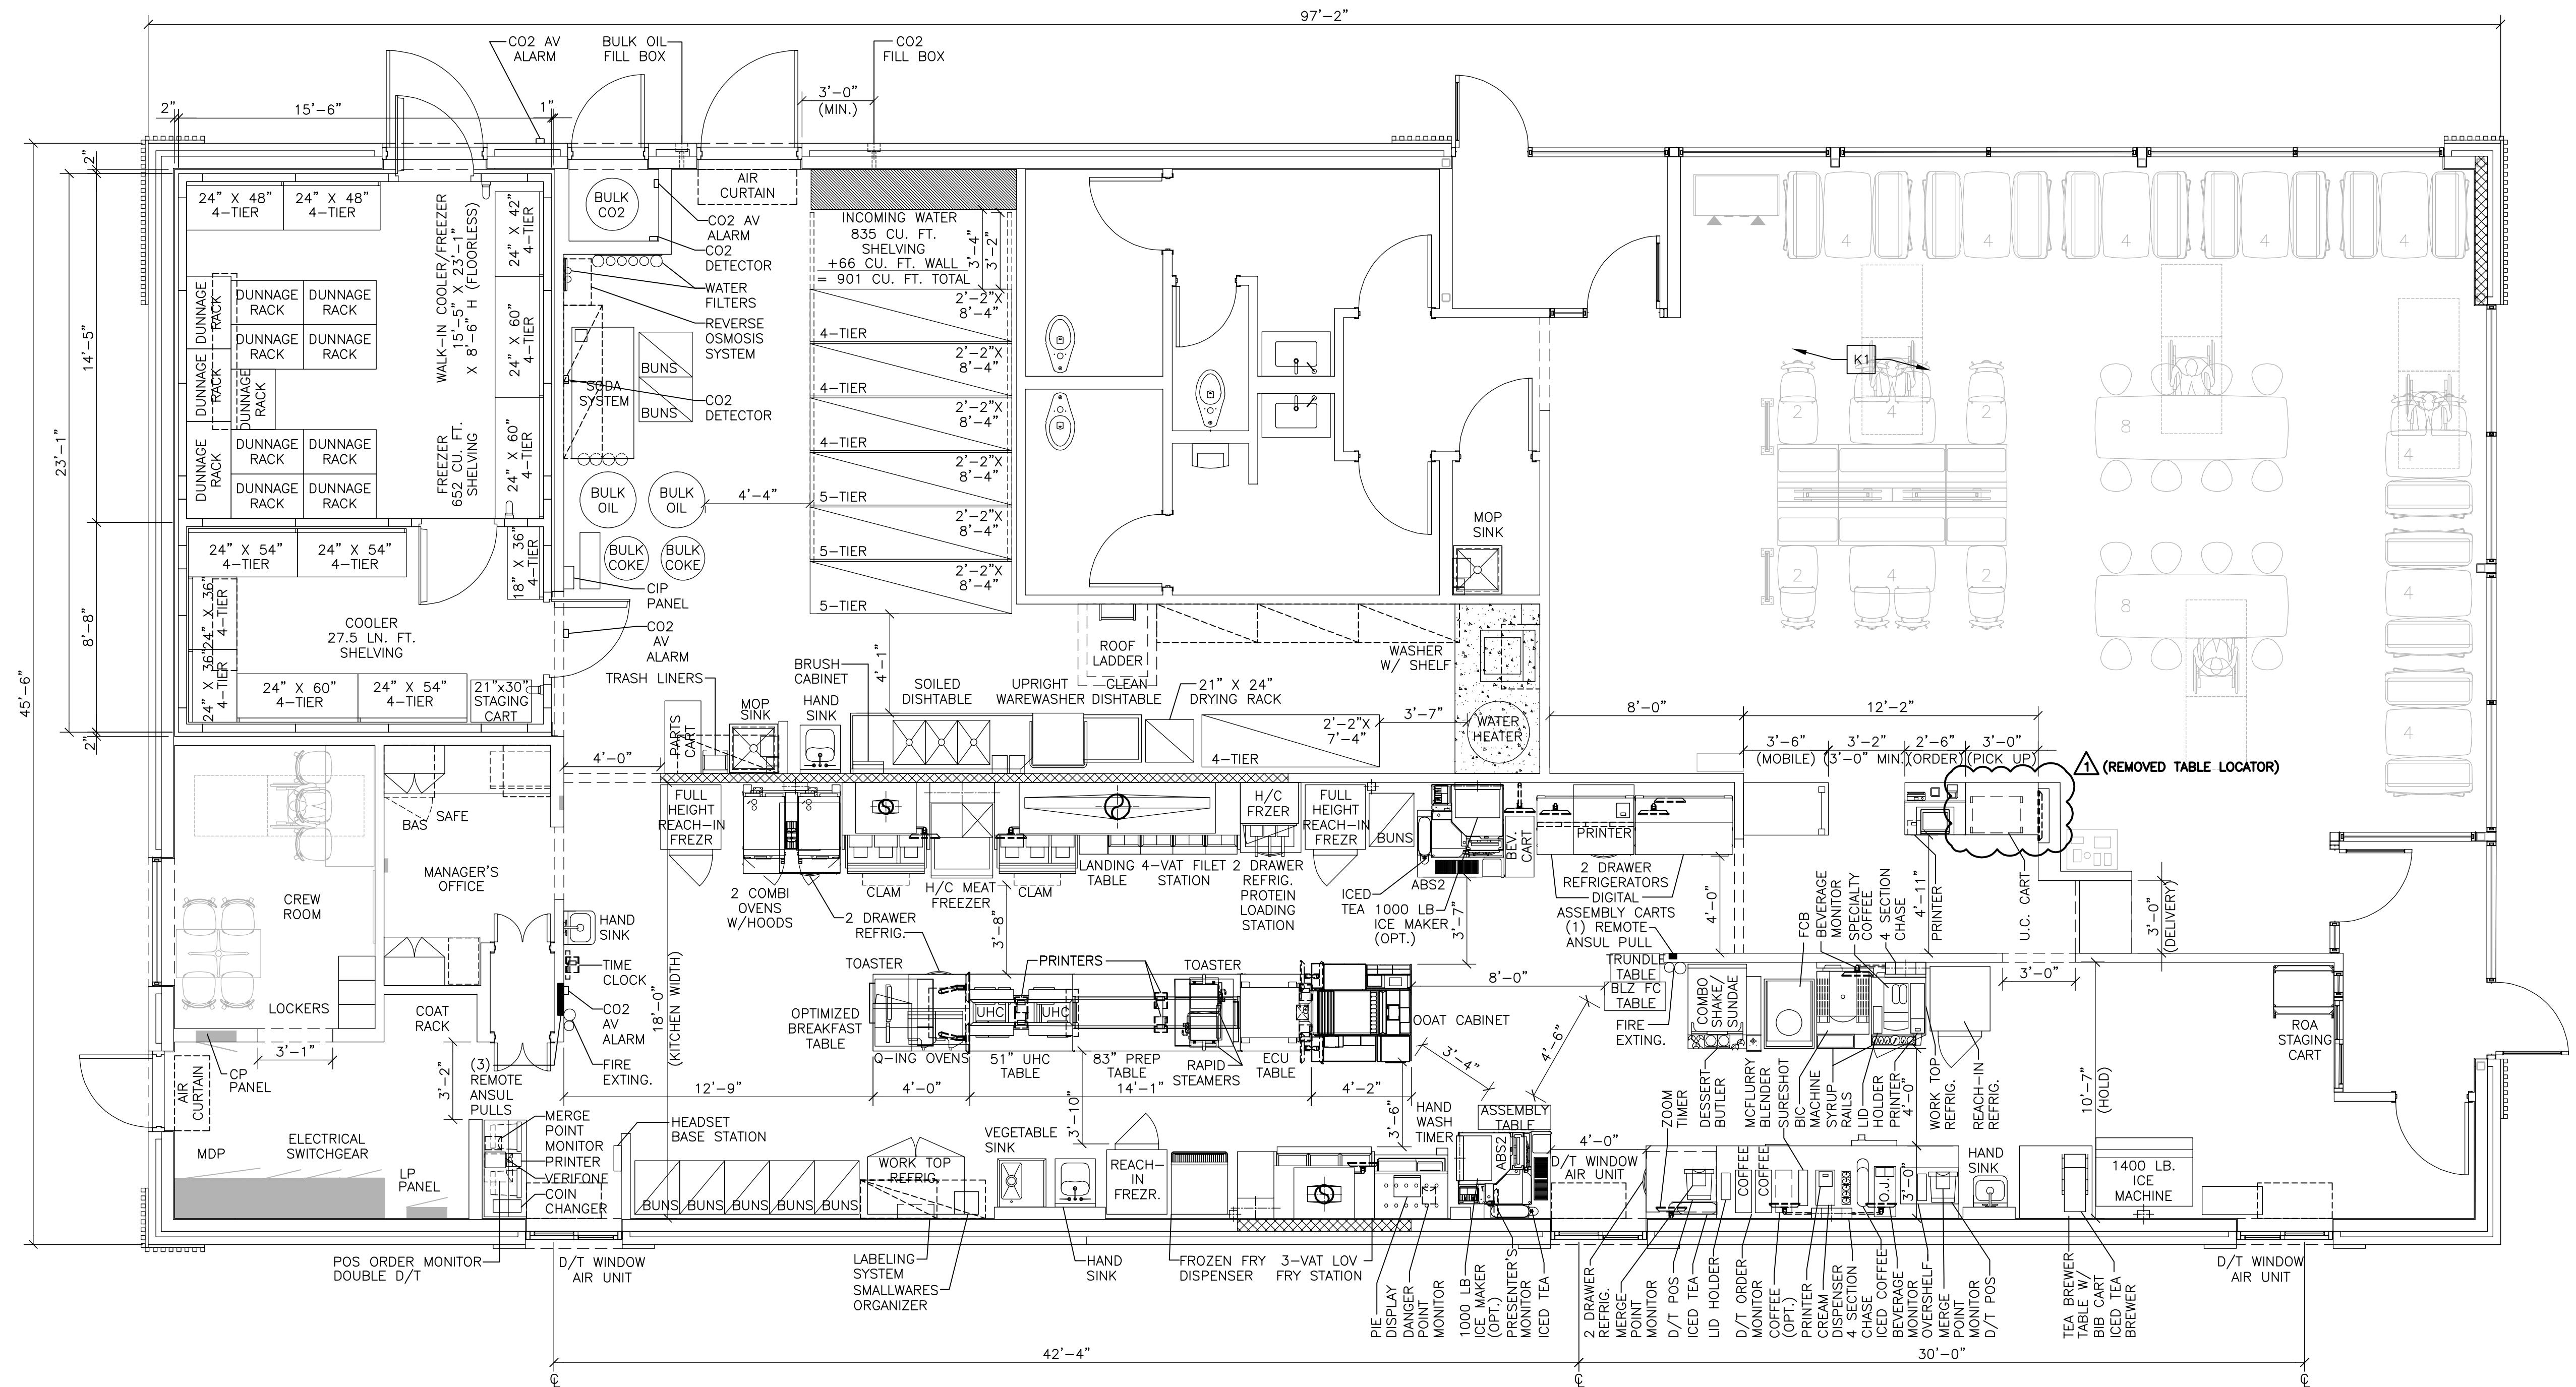

KEYED NOTES

K1 CUSTOMER KIOSK & DECOR LAYOUT FOR
REFERENCE ONLY. VERIFY KIOSK PLACEMENT PER
USRD APPROVED KIOSK REVIEW

SHEET NO.	TITLE	DRAWN BY	PREPARED BY:
	2023 STANDARD BUILDING - BB20	JAW	@ 2023 McDonald's USA, LLC
	4597-WOOD/WOOD	JAW	McDonald's USA, LLC
	WOOD BEARING WALLS W/4" BRICK VENEER	JAW	These drawings and specifications are the confidential and proprietary
	STUCCO/BATEN/BRICK/METAL PANEL EXTERIOR FINISHES	JAW	property of McDonald's USA, LLC and shall not be copied or reproduced
	04-2-3271 SEC OF S.H. LOOP 288 & HUMMINGBIRD LANE, DENTON TEXAS	JAW	without authorization. The contents of these drawings and specifications were prepared for the project identified above. They are not to be used for another project or for any other purpose without the express written consent of McDonald's USA, LLC. These drawings and specifications were prepared for the project identified above. They are not suitable for use on a different site or at a later time. Use of these drawings for reference or example on another project requires the services of properly licensed architects and engineers. Reproduction of the content documents for reuse on another project is not authorized.

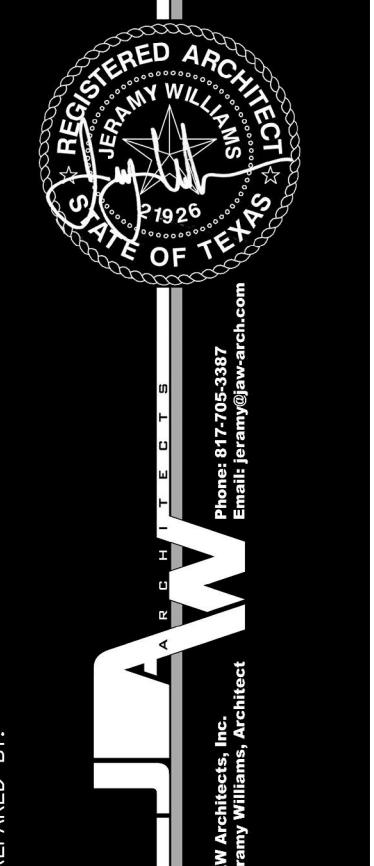



JAW

Amy Williams, Architect

REV DATE DESCRIPTION

REV	DATE	DESCRIPTION
1	1/24/01/2024	USRD QC PLAN REVIEW COMMENTS

BY

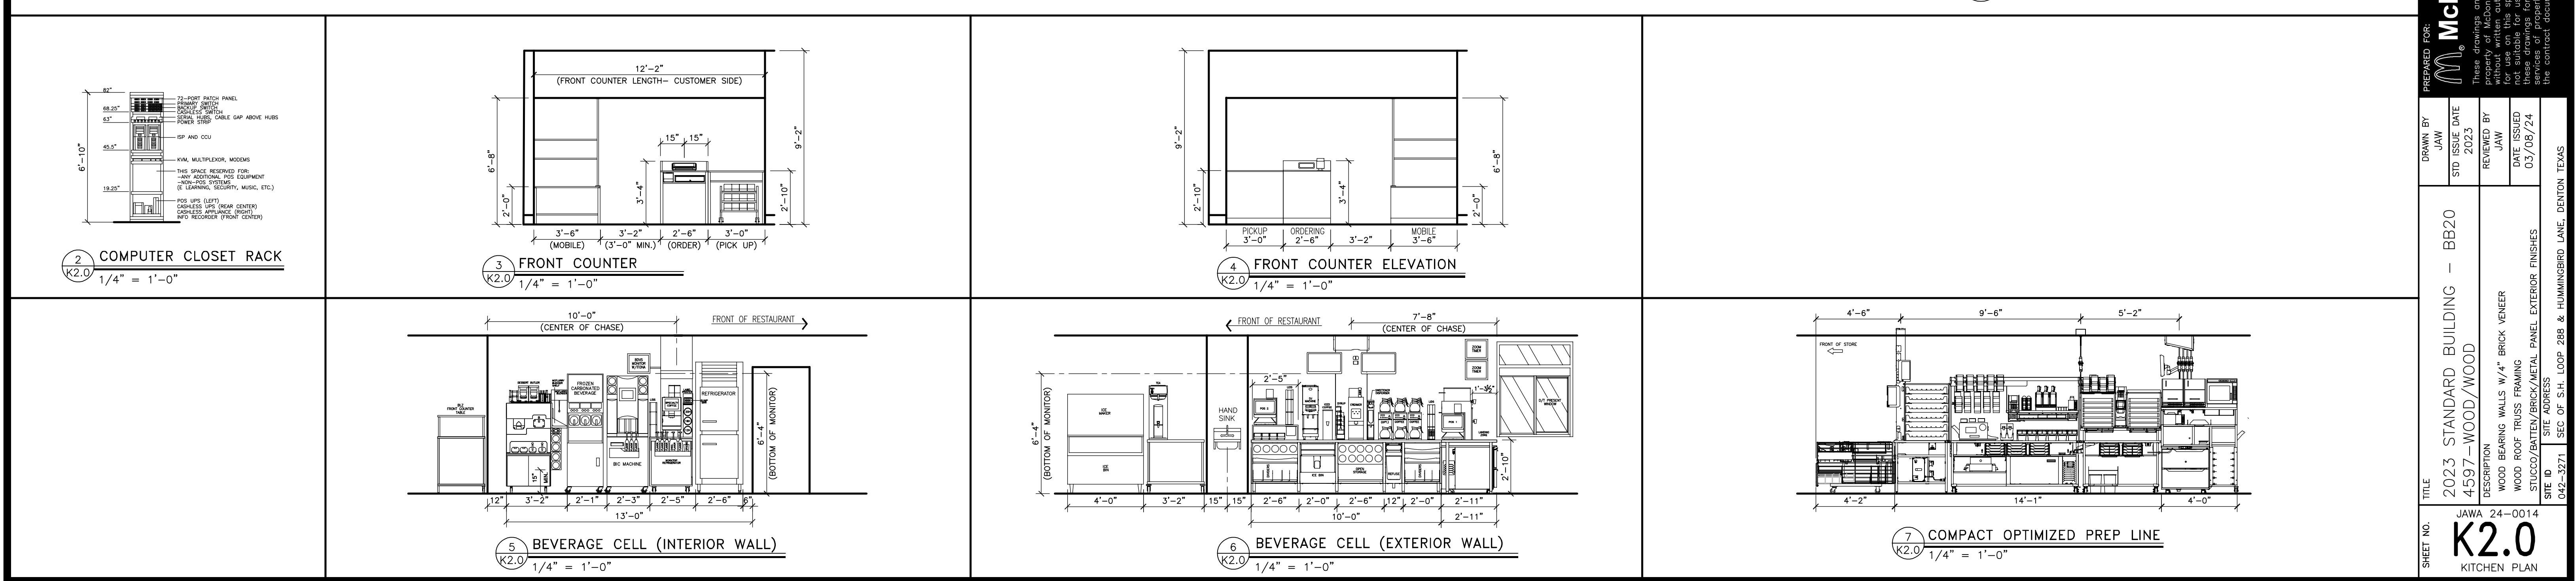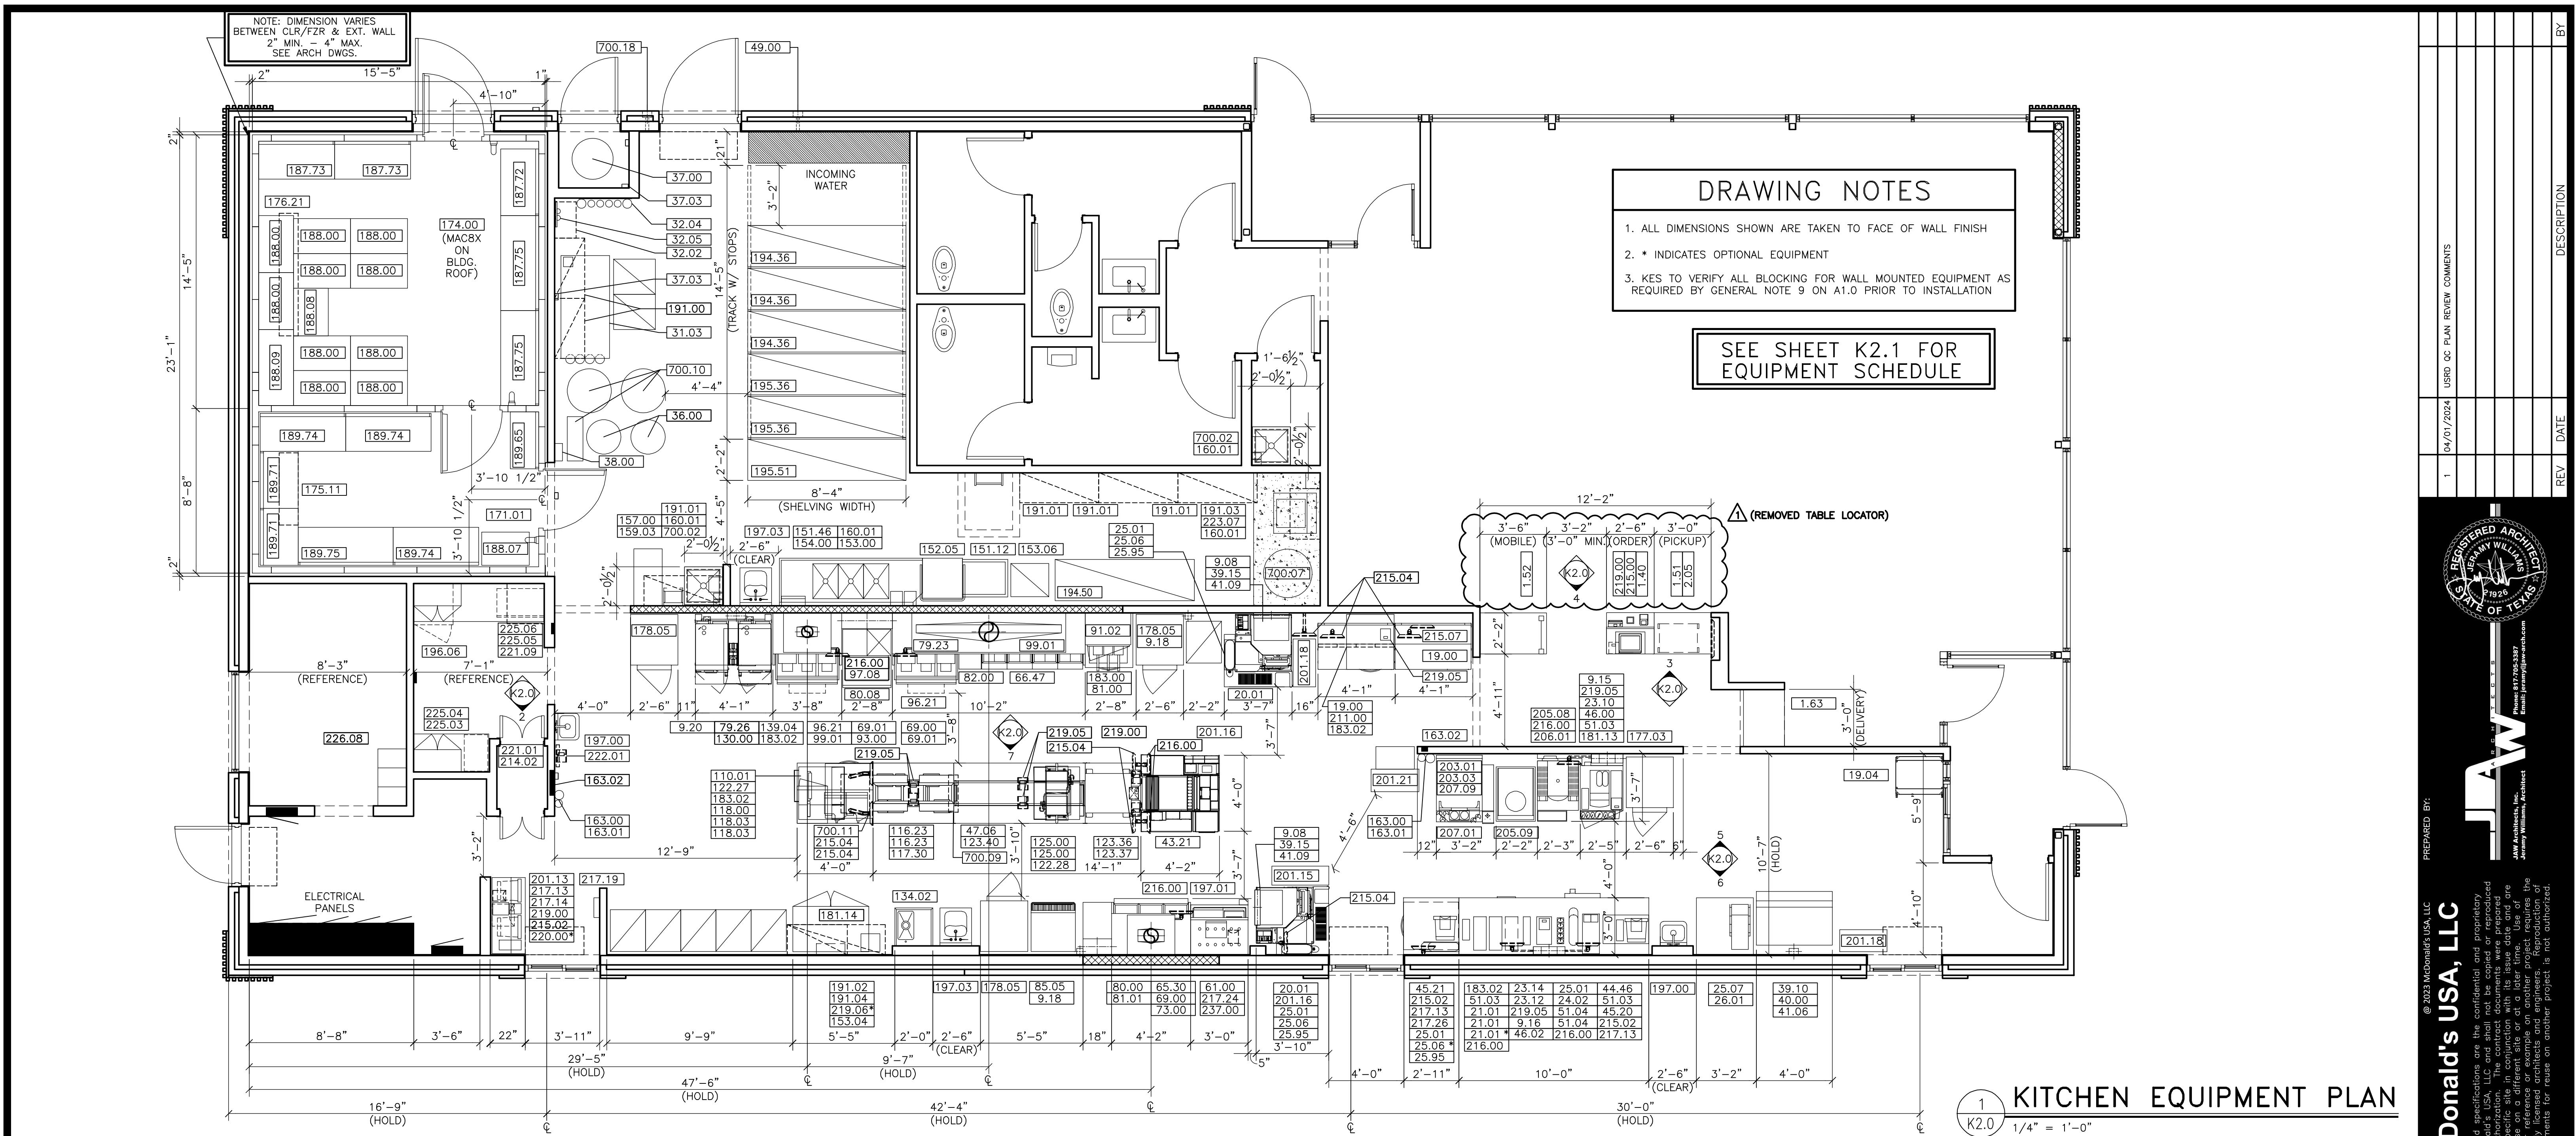

EQUIPMENT SCHEDULE												EQUIPMENT SCHEDULE												
	O	QTY	DESCRIPTION	MANUFACTURER	MODEL #	UL	NSF	FURNISHED	GENERAL REMARKS	SPECIAL REQUIREMENTS			O	QTY	DESCRIPTION	MANUFACTURER	MODEL #	UL	NSF	FURNISHED	GENERAL REMARKS	SPECIAL REQUIREMENTS		
1.40	1	1	SERVICE POD - 30"	DECOR	SEE PLAN	-	2	GC	-				187.73	2	FREEZER SHELVING 24" x 48" x 74" H. - 4-TIER	ISS SHELVING	FSMS/FSMA742448E	-	2	KES	-			
1.51	1	1	PICKUP POD - 36"	DECOR	SEE PLAN	-	2	GC	-				187.75	2	FREEZER SHELVING 24" x 60" x 74" H. - 4-TIER	ISS SHELVING	FSMS/FSMA742460E	-	2	KES	-			
1.52	1	1	PICKUP POD - 42"	DECOR	SEE PLAN	-	2	GC	-				188.00	10	DUNNAGE RACK 22" x 36"	INTERMETRO	HP2236PD	-	2	KES	-			
1.63	1	1	McDELIVERY PICKUP COUNTER	DECOR	SEE PLAN	-	2	GC	-				188.07	1	UNIVERSAL STAGING CART	ISS SHELVING	WST1384Y	-	2	KES	-			
2.05	1	1	UNDER COUNTER CART - 24" W x 18" D FRONT COUNTER	INTERMETRO	UC18-DMS	-	2	KES	-				188.08	1	DUNNAGE RACK 22" x 30"	INTERMETRO	HP2230PD	-	2	KES	-			
9.08	2	1	UTILITY CHASE - ICE MAKER ON ABS VERSION	KES	5"x8"x23"	-	2	KES	CONCEALS WATER AND CONDENSING UNIT LINES				188.09	1	DUNNAGE RACK 22" x 48"	INTERMETRO	HP2248PD	-	2	KES	-			
9.15	1	1	UTILITY CHASE - FFDT INTERIOR WALL	KES	20"x5"x76"	-	2	KES	4 SECTION CHASE FOR BUYOUT RECEPTACLES, POS, CO2 AND WATER				189.65	1	COOLER SHELVING 18" x 36" x 74" H. - 4-TIER	ISS SHELVING	FSMS/FSMA741836E	-	2	KES	-			
9.16	1	1	UTILITY CHASE - FFDT EXTERIOR WALL	KES	20"x5"x76"	-	2	KES	4 SECTION CHASE FOR BUYOUT RECEPTACLES, POS AND WATER				189.71	2	COOLER SHELVING 24" x 36" x 74" H. - 4-TIER	ISS SHELVING	FSMS/FSMA742436E	-	2	KES	-			
9.18	2	1	UTILITY CHASE - WALL VERSION	KES	4"x4"x82"	-	2	KES	CHASE FOR BULK OIL LINES, MOUNT AT 2'-0"				189.74	3	COOLER SHELVING 24" x 54" x 74" H. - 4-TIER	ISS SHELVING	FSMS/FSMA742454E	-	2	KES	-			
9.20	1	1	UTILITY CHASE - COMBI CELL	KES	4"x8"x84"	-	2	KES	CHASE FOR BUYOUT RECEPTACLES AND WATER				189.75	1	COOLER SHELVING 24" x 60" x 74" H. - 4-TIER	ISS SHELVING	FSMS/FSMA742460E	-	2	KES	-			
19.00	2	1	DIGITAL ASSEMBLY CART - 48"	INTERMETRO	MCDAAC-48	-	2	KES	-				190.04	1	VALANCE SHELVING - 18" x 36"	INTERMETRO	M1836C-MP	-	2	KES	MOUNT AT 6'-8" AFF TO SHELF BOTTOM UNLESS OTHERWISE NOTED			
19.04	1	1	ROA STAGING CART - 24"x 30"	INTERMETRO	MCDROA-2430	-	2	KES	-				191.01	4	VALANCE SHELVING - 18" x 48"	INTERMETRO	M1848C-MP	-	2	KES	MOUNT AT 6'-8" AFF TO SHELF BOTTOM UNLESS OTHERWISE NOTED			
20.01	2	1	AUTOMATED BEVERAGE SYSTEM 2.0	IMI CORNELIUS	621058590LON	-	-	KES	INSTALLATION KIT INCLUDES STAINLESS STEEL CHASE & DATA LINE				191.02	1	VALANCE SHELVING - 18" x 60"	INTERMETRO	M1860C-MP	-	2	KES	MOUNT AT 6'-8" AFF TO SHELF BOTTOM UNLESS OTHERWISE NOTED			
21.01	3	1	COFFEE BREWER (THERMAL POTS)	BUNN-O-MATIC	AXOM-POV-3	E32066	4	KES	W/ELECTRONIC CONTROLLER FOR CONVERSION TO LOW OR HIGH VOLTAGE				191.03	1	VALANCE SHELVING - 18" x 30"	INTERMETRO	M1830C-MP	-	2	KES	MOUNT AT 5'-0" AFF TO SHELF BOTTOM FOR ABOVE WASHER APPLICATION			
23.10	1	1	ESPRESSO BREWER	FRANKE	FMS850	-	4	KES	-				191.04	1	VALANCE SHELVING - 18" x 36"	INTERMETRO	M1836C-MP	-	2	KES	MOUNT AT 5'-0" AFF TO SHELF BOTTOM -W/STL LINER FOR SALAD EQUIP			
23.12	1	1	COFFEE CREAM DISPENSER	SURESHOT	AC110-PC-51	E217698	20	KES	-				194.36	3	DRY SHELVING 26" x 100" x 84" H. - 4-TIER	DENSTOR	-	-	2	KES	-			
23.14	1	1	SUGAR/SWEETENER DISPENSER	SURESHOT	AC2-GP-1-G38	E217698	18	KES	-				194.50	1	DRY SHELVING 26" x 88" x 84" H. - 4-TIER	DENSTOR	-	-	2	KES	-			
24.02	1	1	JUICE DISPENSER	BUNN-O-MATIC	JDF-2S	-	18	KES	-				194.56	2	DRY SHELVING 26" x 100" x 84" H. - 4-TIER	DENSTOR	-	-	2	KES	-			
25.01	4	1	SLIMLINE ICED BEVERAGE DISPENSER	BUNN-O-MATIC	TDO-N	E32066	4	KES	KES TO VERIFY EXACT QUANTITY PER MARKET				194.58	1	DRY SHELVING 26" x 100" x 84" H. - 4-TIER	DENSTOR	-	-	2	KES	-			
25.06	3	1	SLIMLINE ICED BEVERAGE DISPENSER - SHORT	BUNN-O-MATIC	TDO-N LP	E32066	4	KES	KES TO VERIFY EXACT QUANTITY PER MARKET				194.60	1	DRY SHELVING 26" x 100" x 84" H. - 4-TIER	DENSTOR	-	-	2	KES	-			
25.07	1	1	INFUSION TEA BREWER - MID	BUNN-O-MATIC	ITCB-DV	E32066	4	KES	PROVIDED WITH BREWER, INSTALLATION KIT AND TDO-N BOOSTER				194.62	1	DRY SHELVING 26" x 100" x 84" H. - 4-TIER	DENSTOR	-	-	2	KES	-			
25.95	3	1	SLIMLINE ICED BEVERAGE DISPENSER - 2 TIER	KES	-	-	2	KES	-				194.64	1	DRY SHELVING 26" x 88" x 84" H. - 4-TIER	DENSTOR	-	-	2	KES	-			
26.01	1	1	TEA BREWER TABLE - 36"x36"	ISS SHELVING	WST1758C	-	2	KES	-				194.66	1	DRY SHELVING 26" x 100" x 84" H. - 4-TIER	DENSTOR	-	-	2	KES	-			
31.03	1	1	SODA SYSTEM PACKAGE B.I.B. (RECIRCULATING - 3 MULTIPLEX TOWERS) - REMOTE	50GR04	S44632	18	KES	-					195.51	1	DRY SHELVING 26" x 100" x 84" H. - 5-TIER	DENSTOR	-	-	2	KES	-			
32.02	1	1	REVERSE OSMOSIS WATER FILTRATION SYSTEM - TANKLESS	EVERPURE	MRS-600HE	-	-	KES	FOR COFFEE MAKER, ESPRESSO MACHINE, AND RAPID BUN STEAMER				196.06	1	SAFE - STANDARD BLDG. - LEFT HINGE	NKL	BSD4125FGXL-MC	-	-	OWNER	-			
32.04	1	1	WATER FILTRATION SYSTEM	EVERPURE	EV9337-26	-	-	KES	-				197.00	2	STAINLESS STEEL HAND SINK	ADVANCE TABCO	7-PS-61	-	2	GC	REFER TO PLUMB. DWGS. FOR DETAILS, SOAP & TOWEL DISP. BY OTHERS	REQUIRED BY LOCAL CODE		
32.05	1	1	WATER FILTRATION SYSTEM	EVERPURE	EV92972-24	-	-	KES	FOR COMBI OVENS AND STAGING CABINET				197.01	1	HAND WASH TIMER	NATIONAL CONTROLS	TMD-T1715-120	E53595	-	KES	-			
36.00	2	1	BULK COKE	CHART INDUSTRIES	10667511	-	18	MANUFACTURER	SYRUP LINES BY CHART INDUSTRIES				197.03	2	STAINLESS STEEL HAND SINK - ADA	ADVANCE TABCO	7-PS-26	-	2	GC	REFER TO PLUMB. DWGS. FOR DETAILS, SOAP & TOWEL DISP. BY OTHERS	REQUIRED BY LOCAL CODE		
37.00	1	1	BULK CO2 - 750 LB.	CHART INDUSTRIES	CARBO-MAX 750	-	-	MANUFACTURER	-				201.13	1	DRIVE-THRU CASH STAND - 21" D x 48" W	INTERMETRO	DT48-8	-	2	KES	SOLID WORK TOP, WIRE SHELVES			
37.03	2	1	CO2 SAFETY SYSTEM	SEE RMKS	-	-	KES	SEE MECHANICAL DRAWINGS	INCLUDES DETECTOR AND (4) AV ALARMS				201.15	1	READY-NEAT DRIVE-THRU ASSEMBLY CART - 12' D x 36" W	INTERMETRO	DTPC-36	-	2	KES	-			
38.00	1	1	CLEAN PLACE PANEL	CHART INDUSTRIES	10667431	-	18	MANUFACTURER	SEE MECHANICAL DRAWINGS	INCLUDES DETECTOR AND (4) AV ALARMS			201.16	2	DRIVE-THRU ABS CART	INTERMETRO	DRIVE-THRU ABS CART	-	2	KES	ABS DRINK STAGING CART WITH TROUGH			
39.10	1	1	ICE MACHINE - 1400 LB.	MANITOWOC	IY1500N3 / B970	SA4027	12	KES	SEE HEADMASTER KIT K00221				201.18	2	CBB STAGING CART	INTERMETRO	MCD-CBB	-	2	KES	-			
39.15	2	1	ICE MACHINE - 1000 LB.	MANITOWOC	IBT1020C-161	SA4027	12	KES	CONDENSER: CVDT1200				201.21	1	BLZ FRONT COUNTER TABLE - 30" D x 14" W	INTERMETRO	MCD1430-BLZM	-	2	KES	W/ CASTERS AND OVERSHELF			
40.00	1	1	ICE MACHINE CHASE	KES	4"x6"x48"	-	2	KES	CONCEALS WATER AND CONDENSING UNIT LINES				203.01	1	HEAT TREAT COMBINATION SHAKE/SUNDAE MACHINE	CARPAGIANI	K3	SA4203	6	KES	SUPPLIED WITH CONE DISPENSER AND 7'-6" LONG CORD			
41.06	1	1	ICE MACHINE REMOTE CONDENSER - 1400 LB.	MANITOWOC	JCT-1500	SA4027	12	KES	-				203.03	1	CUP/CONE DISPENSER	KES	-	-	2	KES	-			
41.09	2	1	ICE MACHINE REMOTE CONDENSER - 1000 LB.	MANITOWOC	CVDT1200-263A	SA4027	12</td																	